


0-41-B

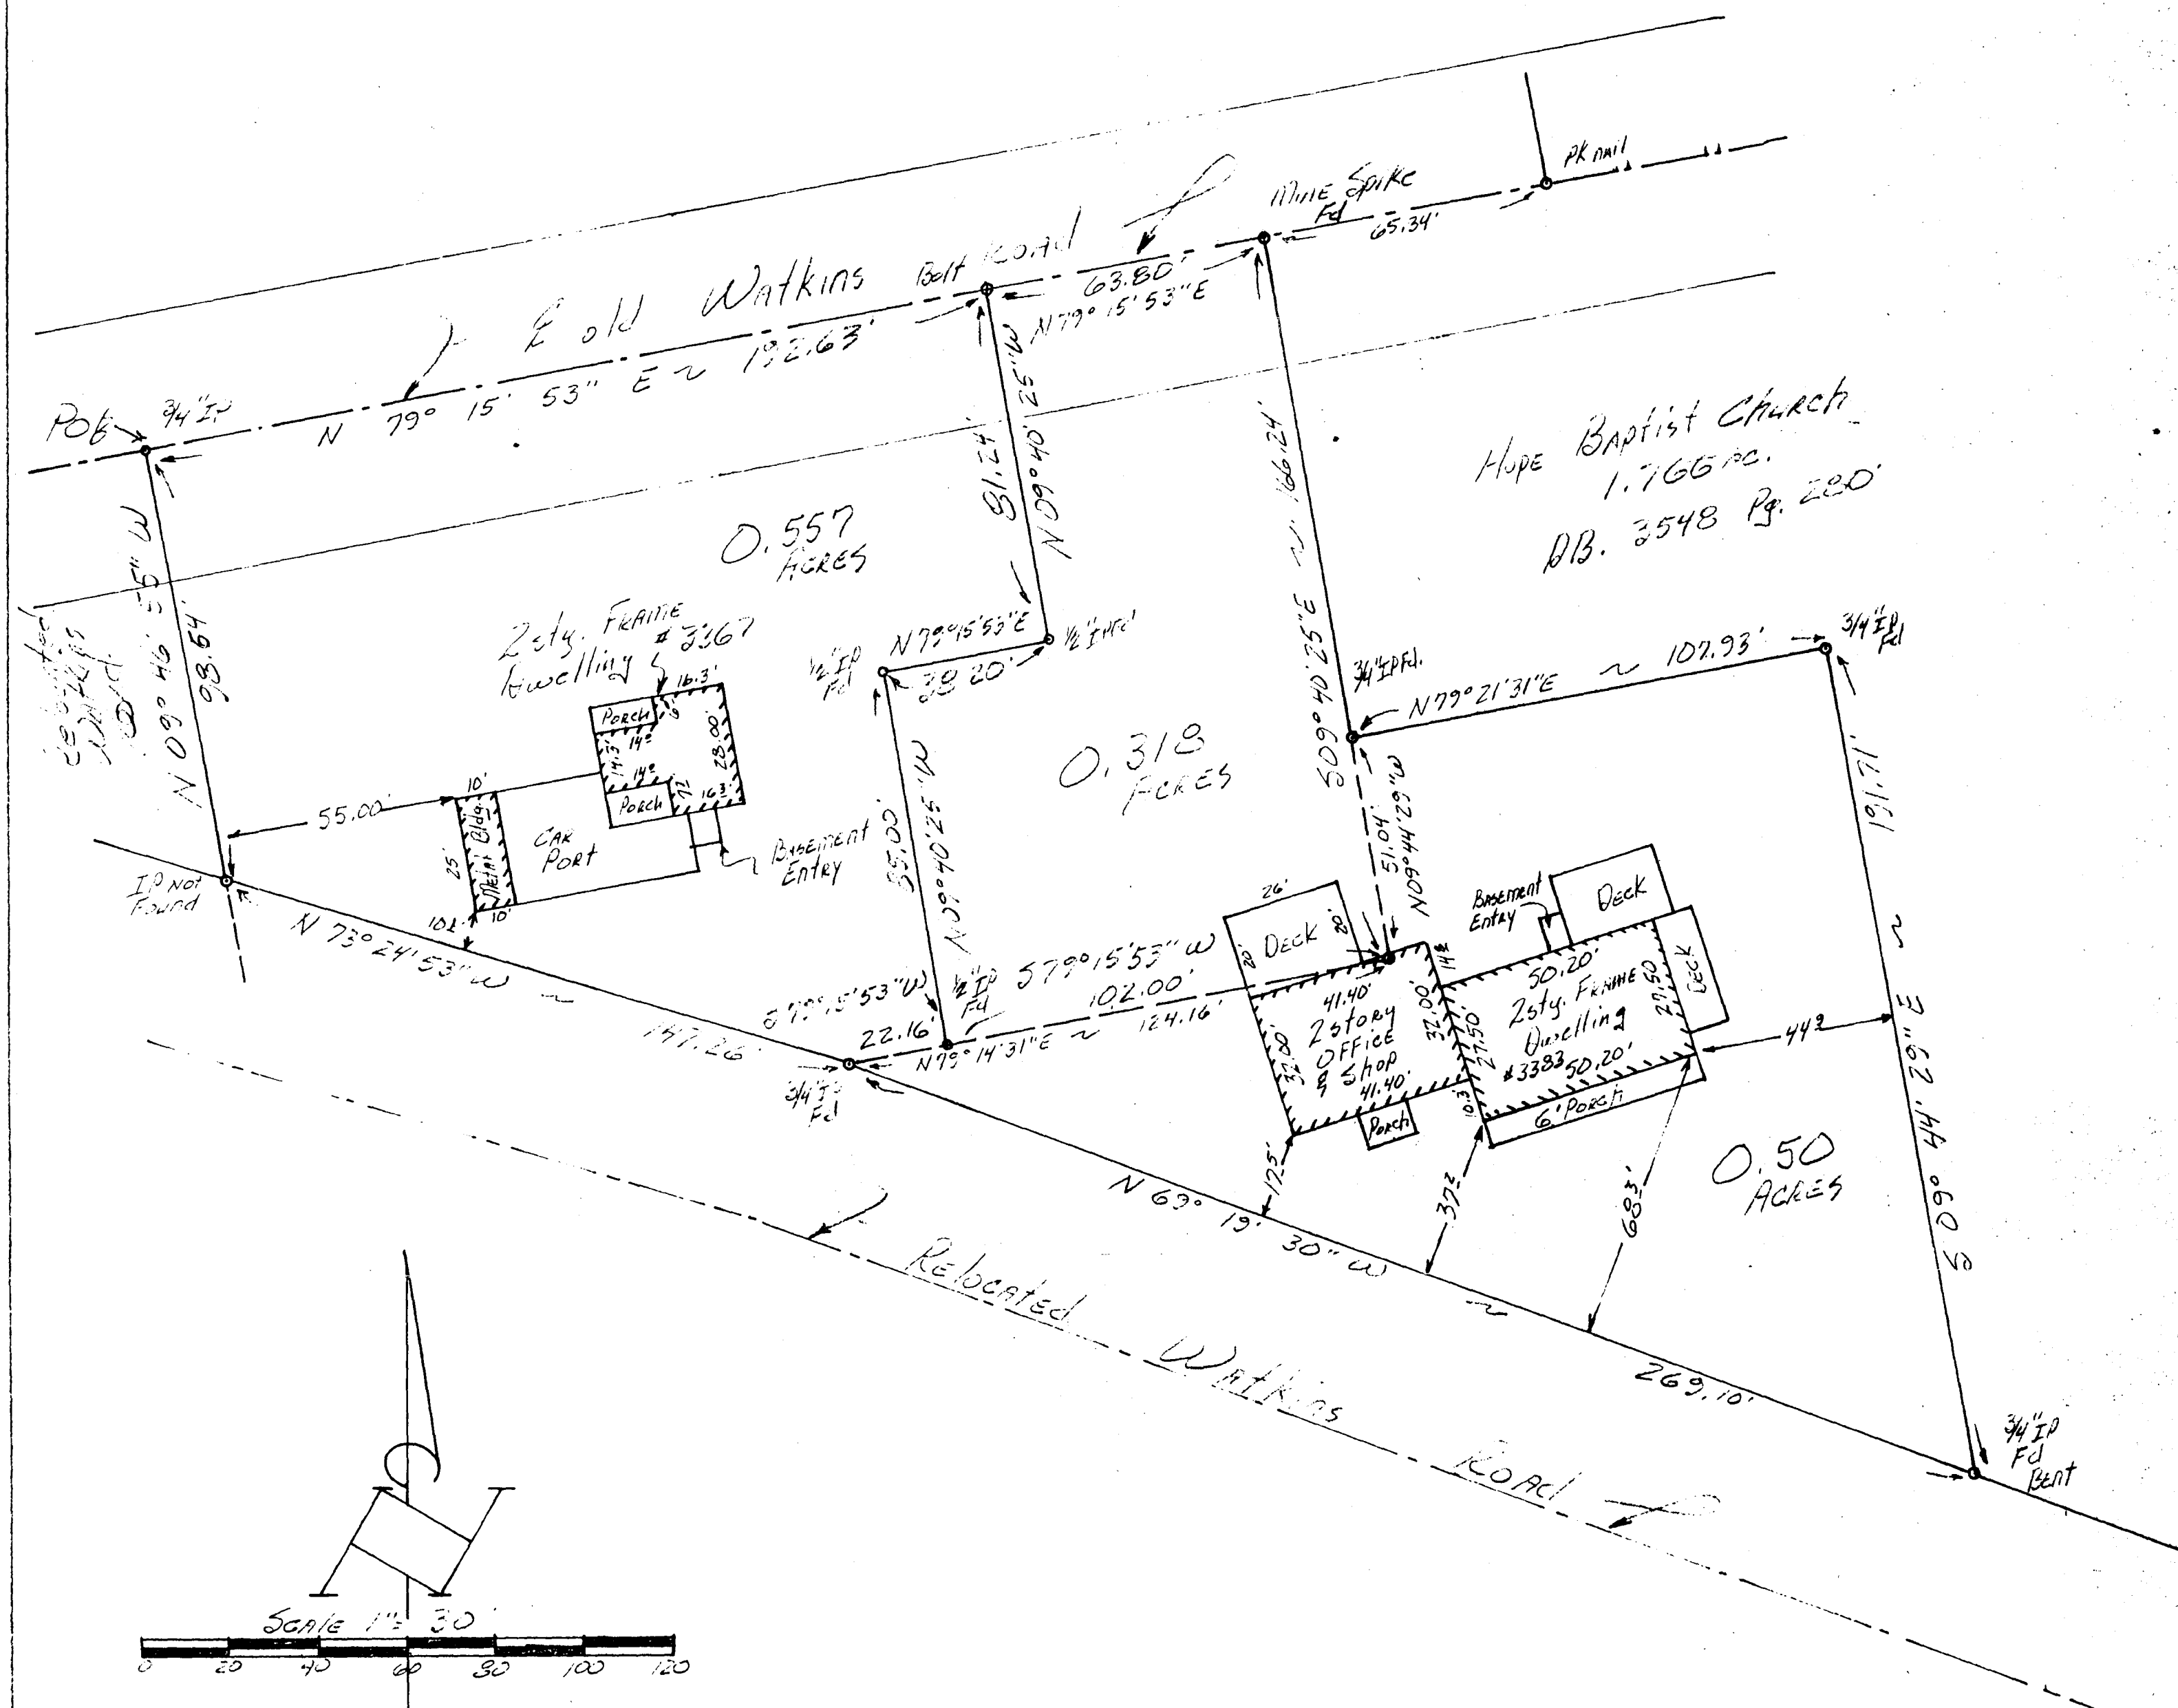

Price (Deed Ref.)
 Kim Robinson
 0.515 AC.
 OK 6926-0-19
 Kim Robinson
 0.50 AC.
 OK 7473-0-07


Flood Certification:
 This Property is in Zone
 "C" of Flood Panel
 5900170-0095-C dated
 January 16, 1987.

Building Location
 on Two Tracts in Sec. 5, Twp. 11, Rge. 21.
 City of Columbus, Franklin Co.,
 Ohio: For
 Harlen & Kim Robinson

BASIS OF BEARING USED FOR
 THIS SURVEY BASED ON THE
 PREVIOUS DEED AS REFERENCED;
 OLD WATKINS ROAD RUNS
 NORTH 79° 15' 53" EAST.



HAINES SURVEYORS
 354 Kessler Street
 Groveport, Ohio 43125
 Phone: 837-2181

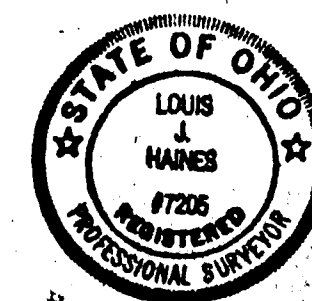

I hereby certify that the plat shown herein was performed from an actual field
 survey, under my supervision and that said plat correctly represents said survey.
 DATE 8-17-95
 Revised 9-5-95