



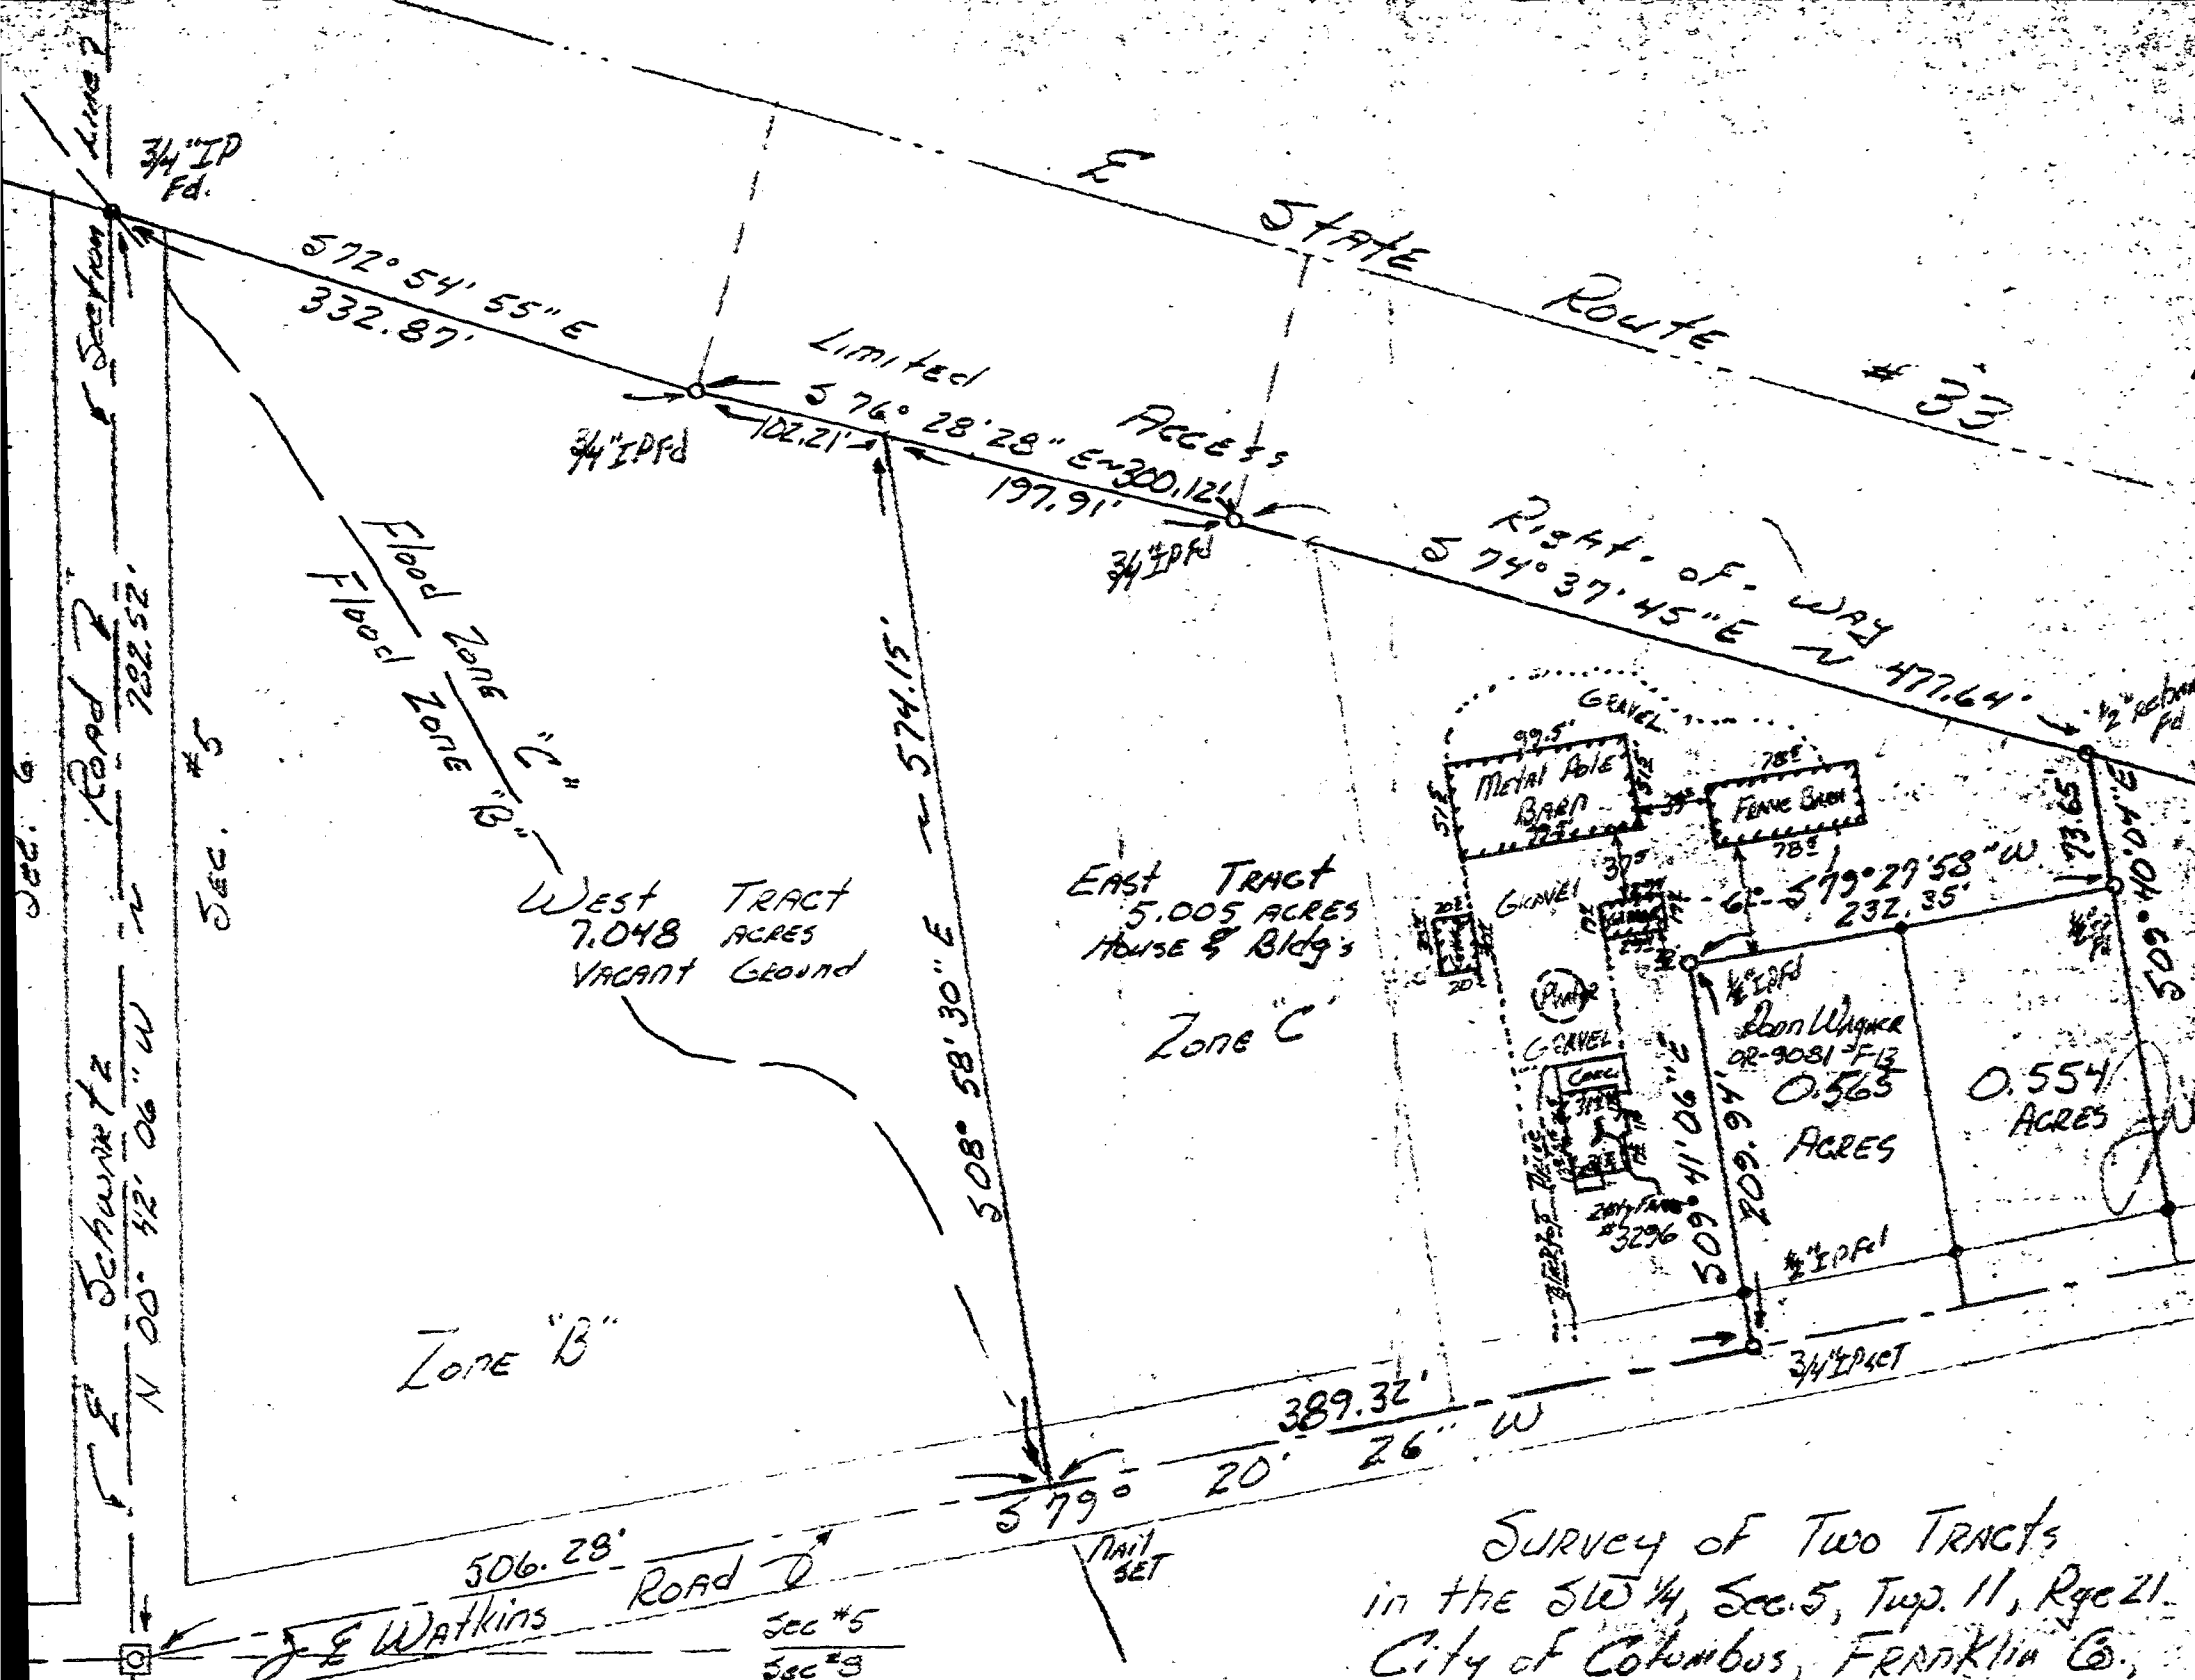

Basis of Bearings
Watkins Vel. N 79° 20' 26" E.

Flood Certification:
This property is in Zones
B & C as shown on
Firm Plan 390170-0095-C
Dated 1-16-87

DE 5-16-87
J. H. Haines

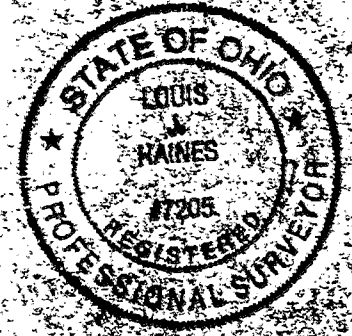

Survey of Two Tracts
in the SW 1/4, Sec. 5, Twp. 11, Rge. 21.
City of Columbus, Franklin Co.,
Ohio: For

Ronald D. Shirley Boggs



HAINES SURVEYORS
354 Kessler Street
Groveport, Ohio 43125
Phone: 837-2181

Franklin County
Monument Box
SW, Cor. #4469
SW, 1/4
Sec. #5

I hereby certify that the plat shown hereon was prepared from an actual field
survey, under my supervision and that said plat contains no errors or
omissions.
DATE 5-16-87
REV 6-6-94