


5126925

5126925

MADISON TWP.

0-41-B

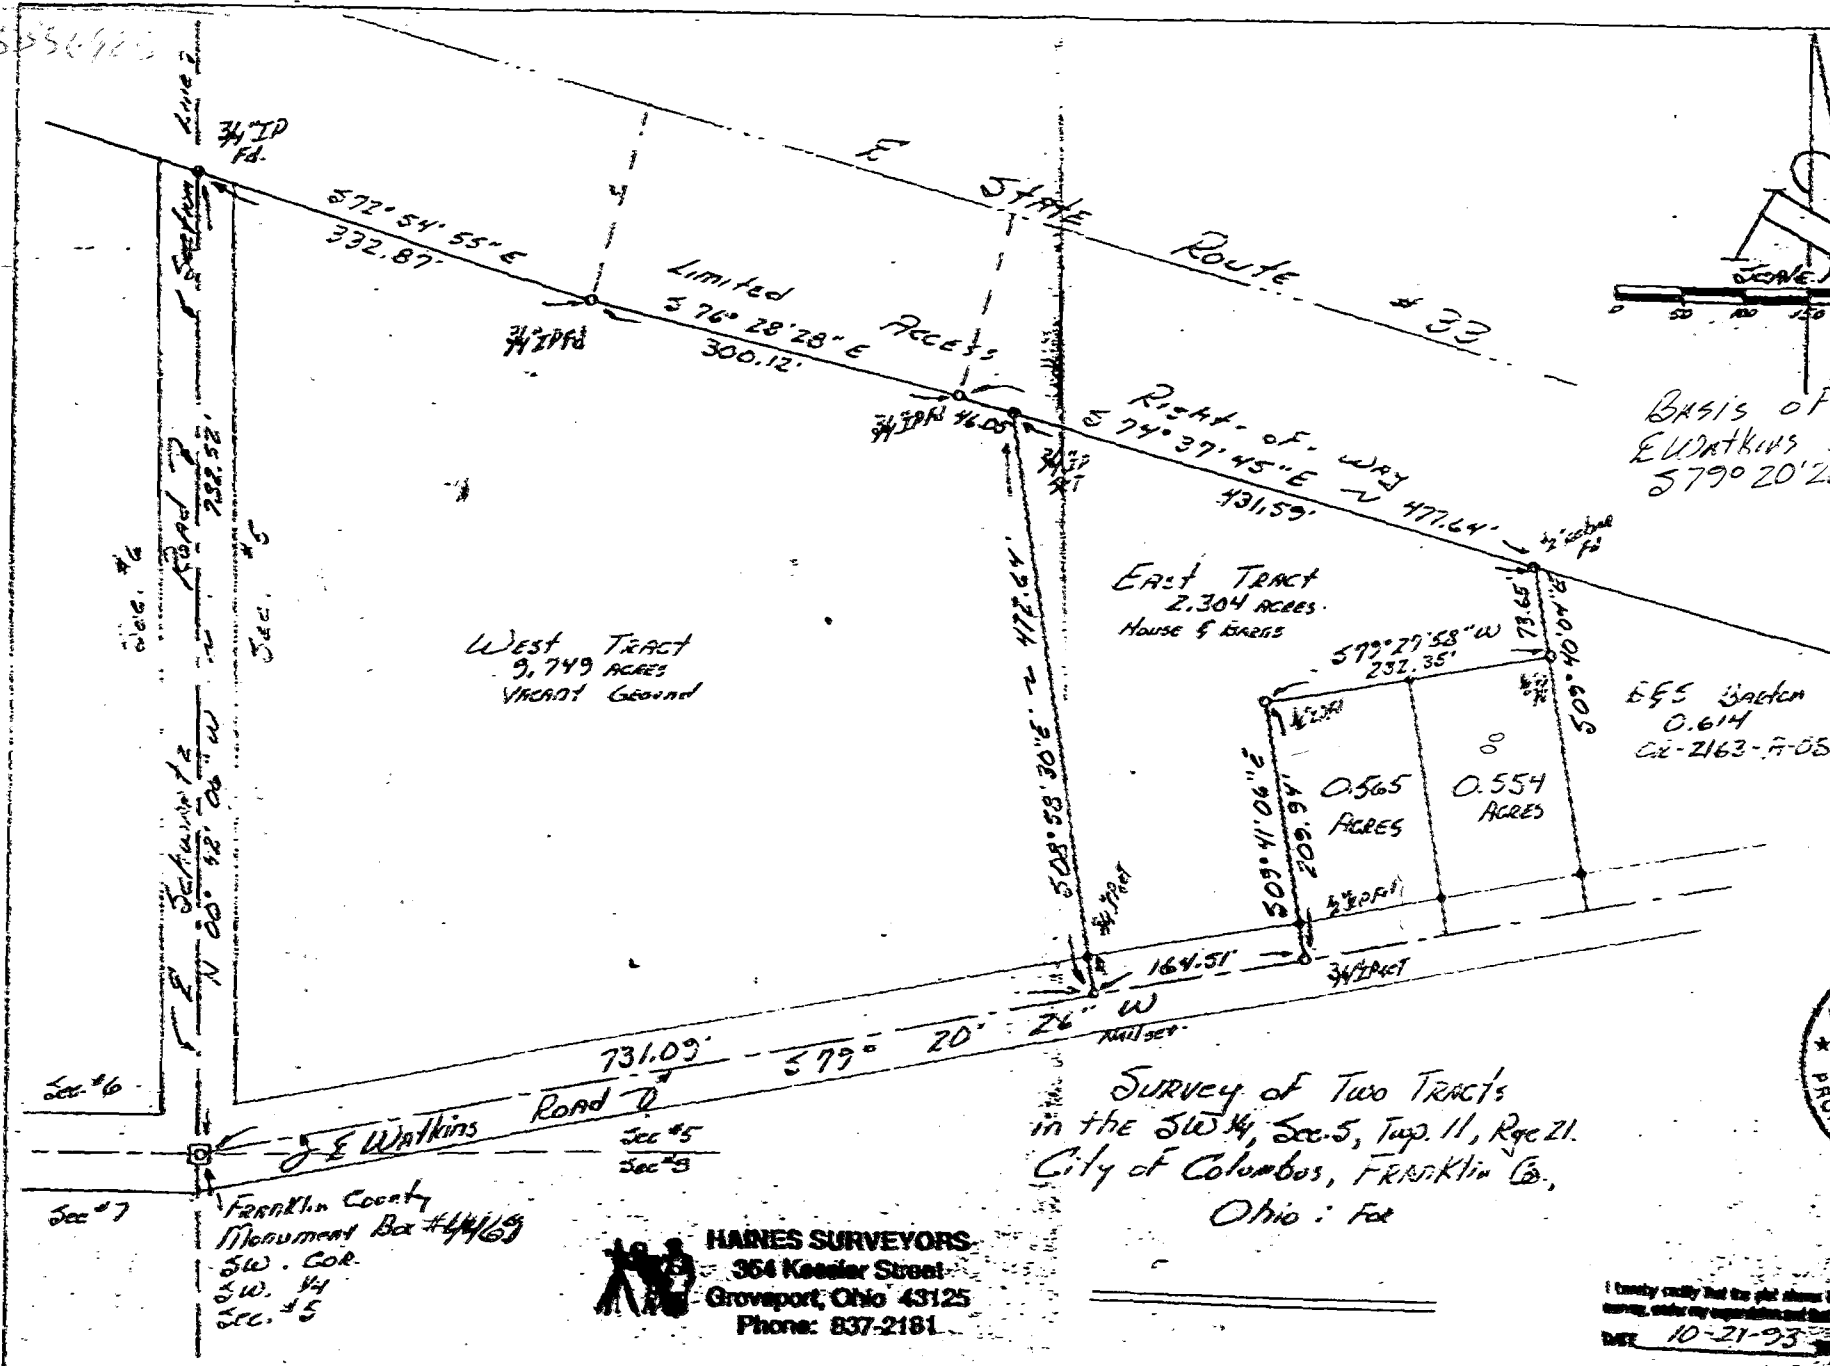

Basis of Bearings
EUDATKINS REACH
579° 20' 26" W

EAST TRACT
2.304 ACRES
House & BARN

EES Batten
0.614
CE-2163-F-05

0.565 ACRES
0.554 ACRES

Survey of Two Tracts
in the SW 1/4, Sec. 5, Twp. 11, Rge. 21.
City of Columbus, Franklin Co.,
Ohio: For



HAINES SURVEYORS
364 Keeler Street
Groveport, Ohio 43125
Phone: 837-2181

I certify that the plat shows correct and permanent lines as per the survey, under my supervision and that said plat is a true and correct copy of the original.
DATE 10-21-93