



CTY-RTE-SECTION

MODEL: Unnamed Plan-1 - Plan 2 (Sheet) PAPER SIZE: 34x22 (in.) DATE: 1/17/2024 TIME: 3:07:49 PM USER: sseeley  
J:\20230330\0001\01\_011 Pritchard Ave\_Lisbon\116200\400-Engineering\Structures\SFH\_222222\Sheets\116200\_SFH\_222222\_SA001.dgn


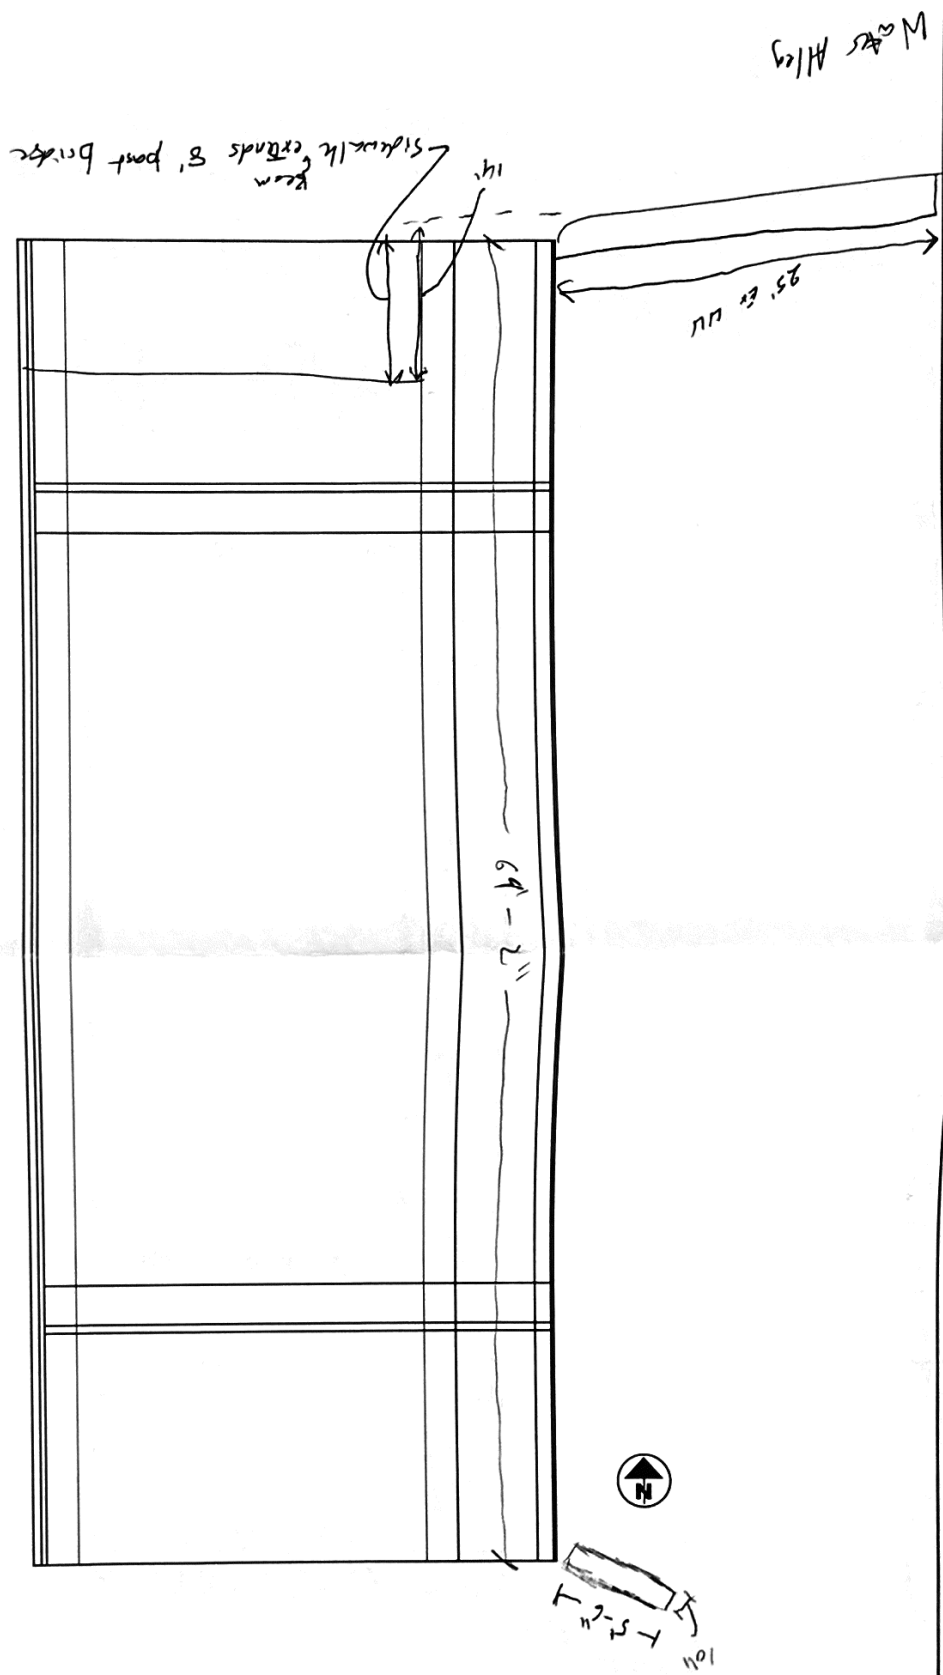


1'-5\"/>

Pritchard Ave Bridge  
bridge street

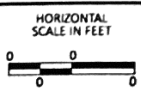

SHEET TOTAL		0
PROJECT 0		0
XXX MM DD YY		
REVISION		XXX
DESCRIPTION		

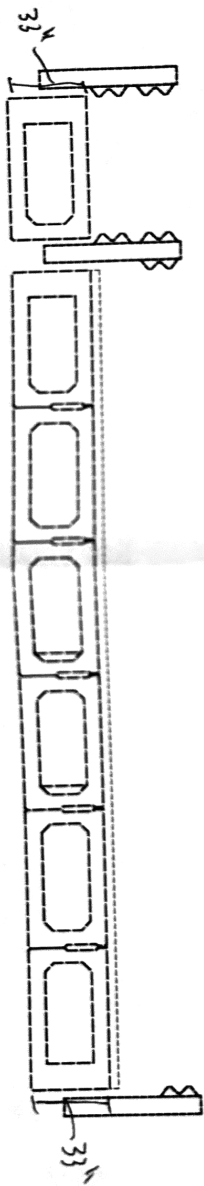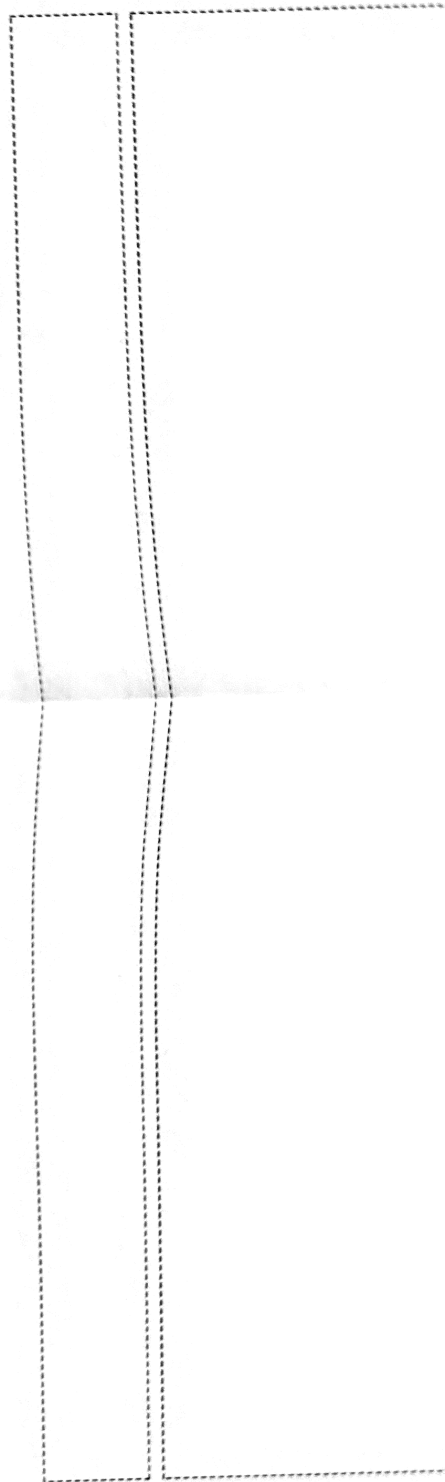

BRIDGE STREET BRIDGE

DESIGN  
PROJECT  
P.O.