GARCIA SURVEYORS INC.
P. O. Box 2628
Whitehouse, Ohio 43571
Phone: 419-877-0400
Fax: 419-877-1140
www.garciasurveyors.com
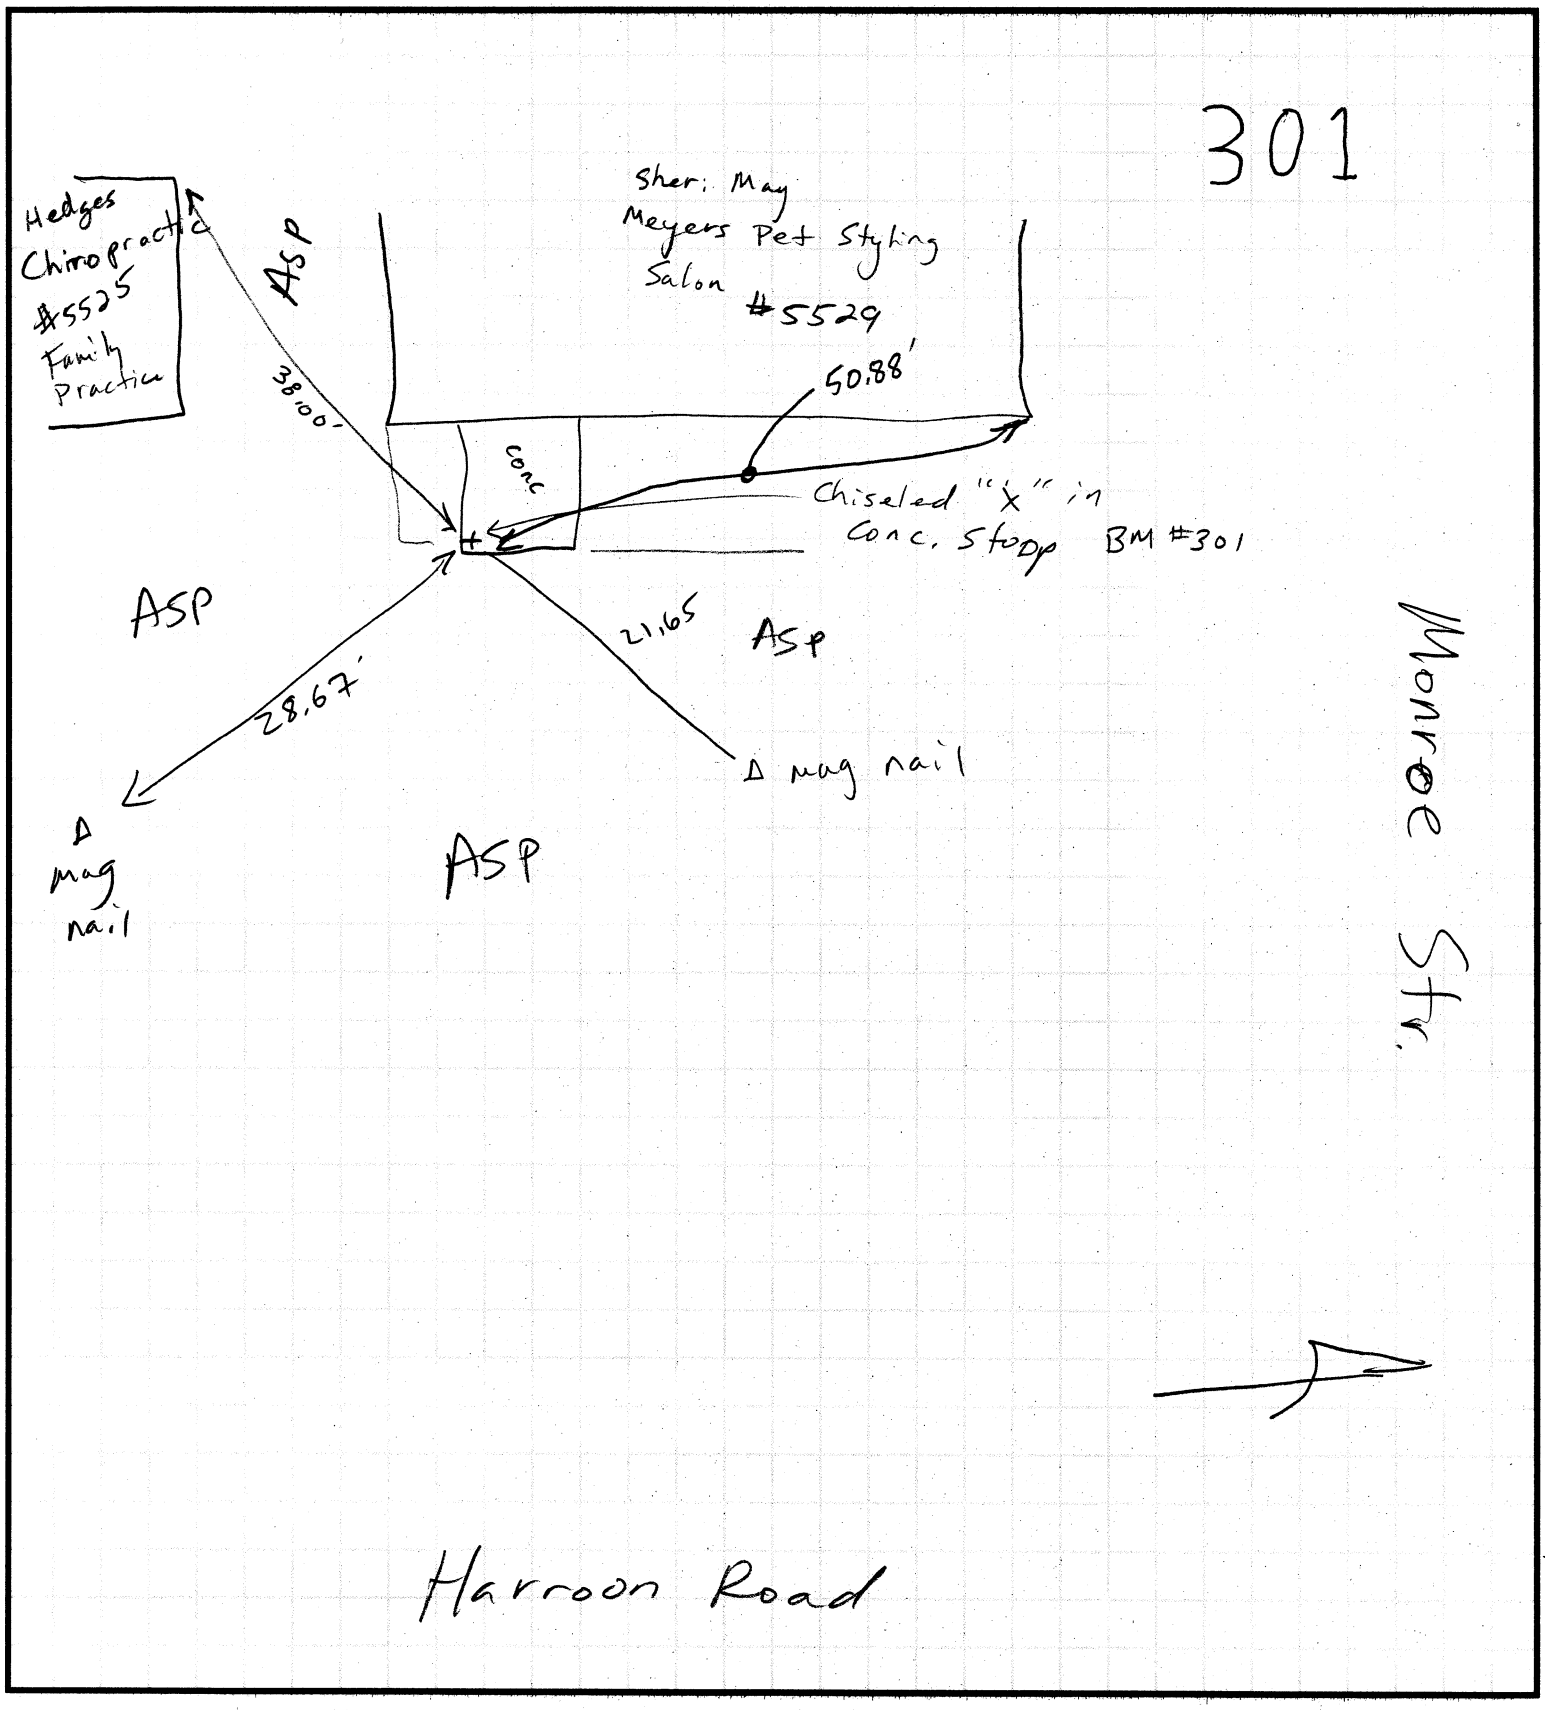
Job Name: ODOT LUC-23-11.75 PID 105889
Job Number: 214504582
Sheet No. _____ of _____ Scale _____
Calculated by: _____ Date: _____
Checked by: AB/JS/AG/TG Date: 9/18/21
Remarks: _____