

P. O. Box 2628
Whitehouse, Ohio 43571


Phone: 419-877-0400
Fax: 419-877-1140

www.garciasurveyors.com

Job Name: ODOT Loc 23-11.75
 Job Number: 214504582
 Sheet No. _____ of _____ Scale _____
 Calculated by: PB/MK Date: 10/7/2
 Checked by: _____ Date: _____
 Remarks: _____

4

313

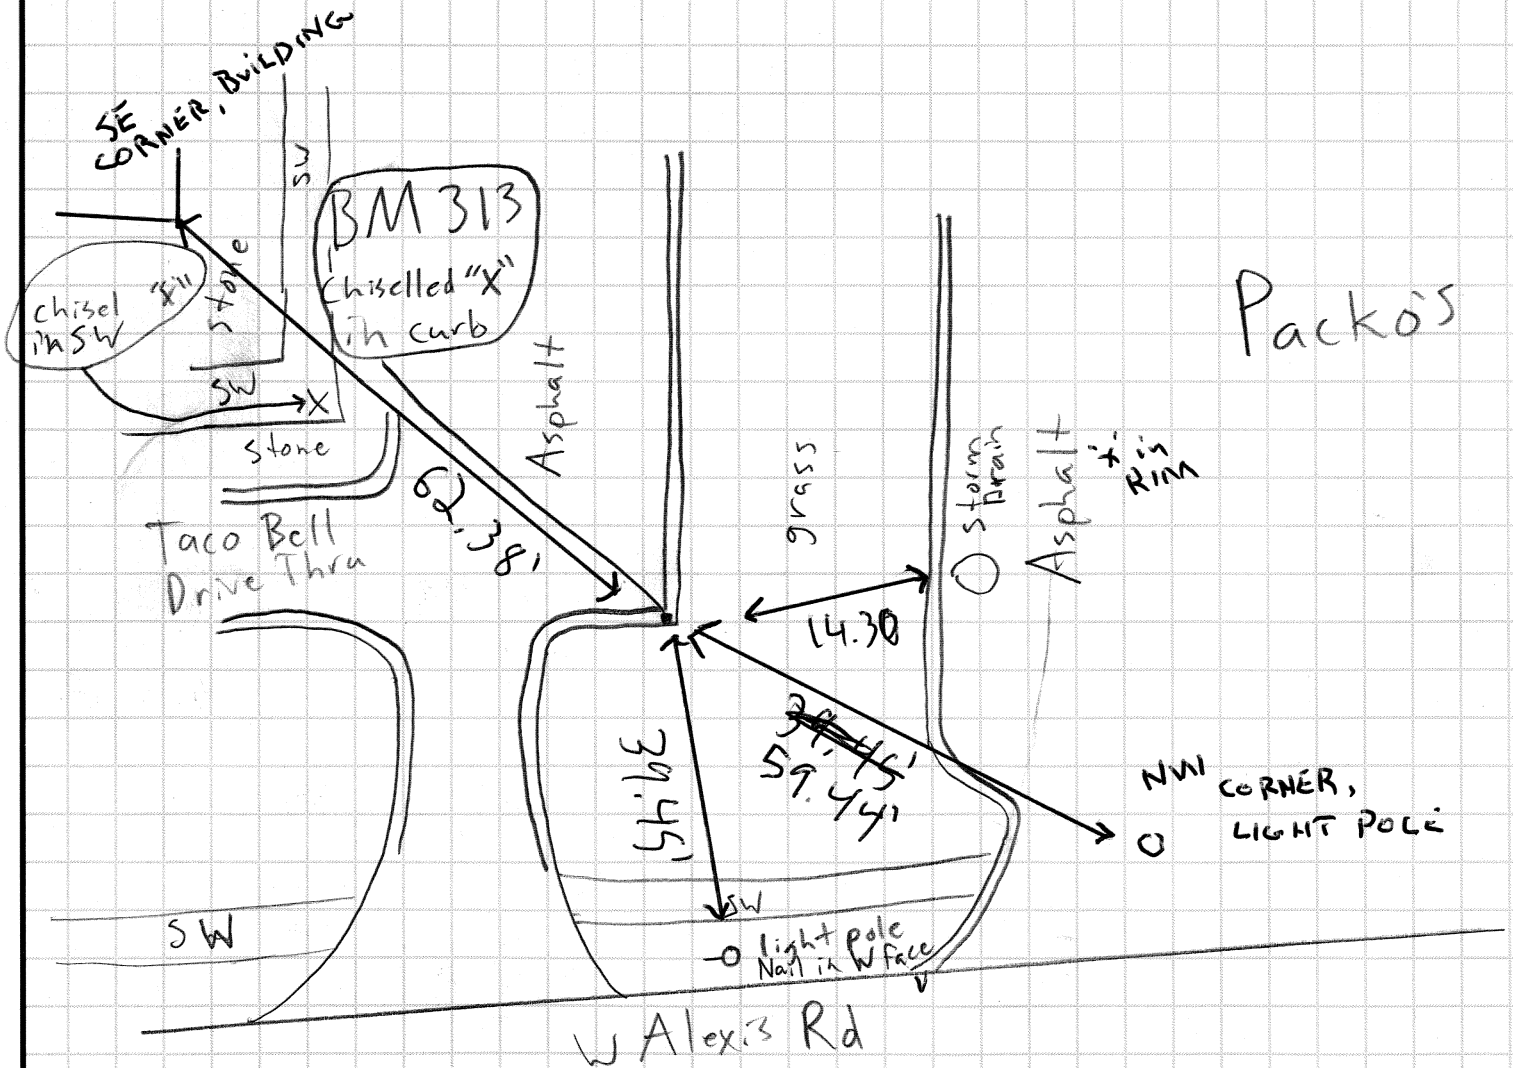

Dave White