

P. O. Box 2628
Whitehouse, Ohio 43571

Phone: 419-877-0400
Fax: 419-877-1140

www.garciasurveyors.com

Job Name: 000T Loc 23-11-75

Job Number: 214504582


Sheet No. _____ of _____ Scale _____

Calculated by: PG/HK Date: 10/7/21

Checked by: _____ Date: _____

Remarks: _____

Acres

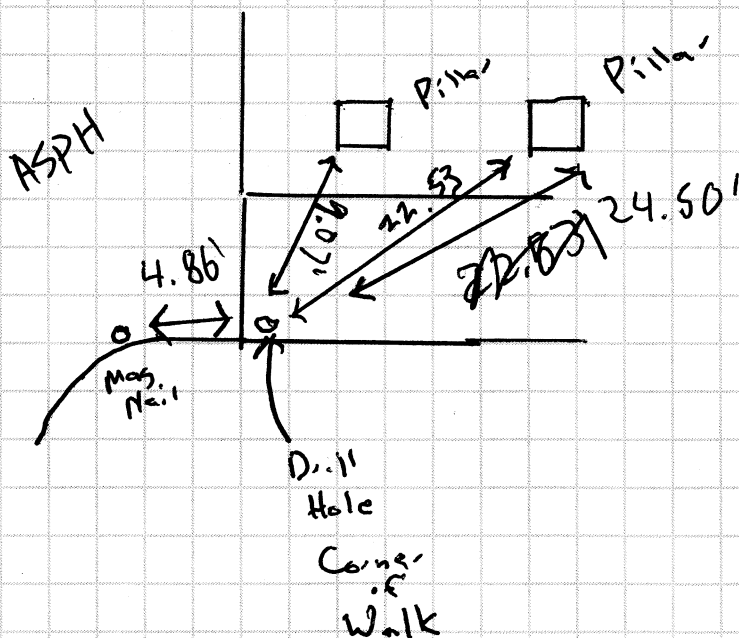

316

(Dave White

Monroe St