

P. O. Box 2628
Whitehouse, Ohio 43571

Phone: 419-877-0400
Fax: 419-877-1140

www.garciasurveyors.com

Job Name: ODOT LOC-23-11.75

Job Number: 214504582

Sheet No. _____ of _____ Scale _____

Calculated by: PG/MK Date: 10/3/25


Checked by: _____ Date: _____

Remarks: _____



Toledo Memorial
Park Cemetery

△ 57

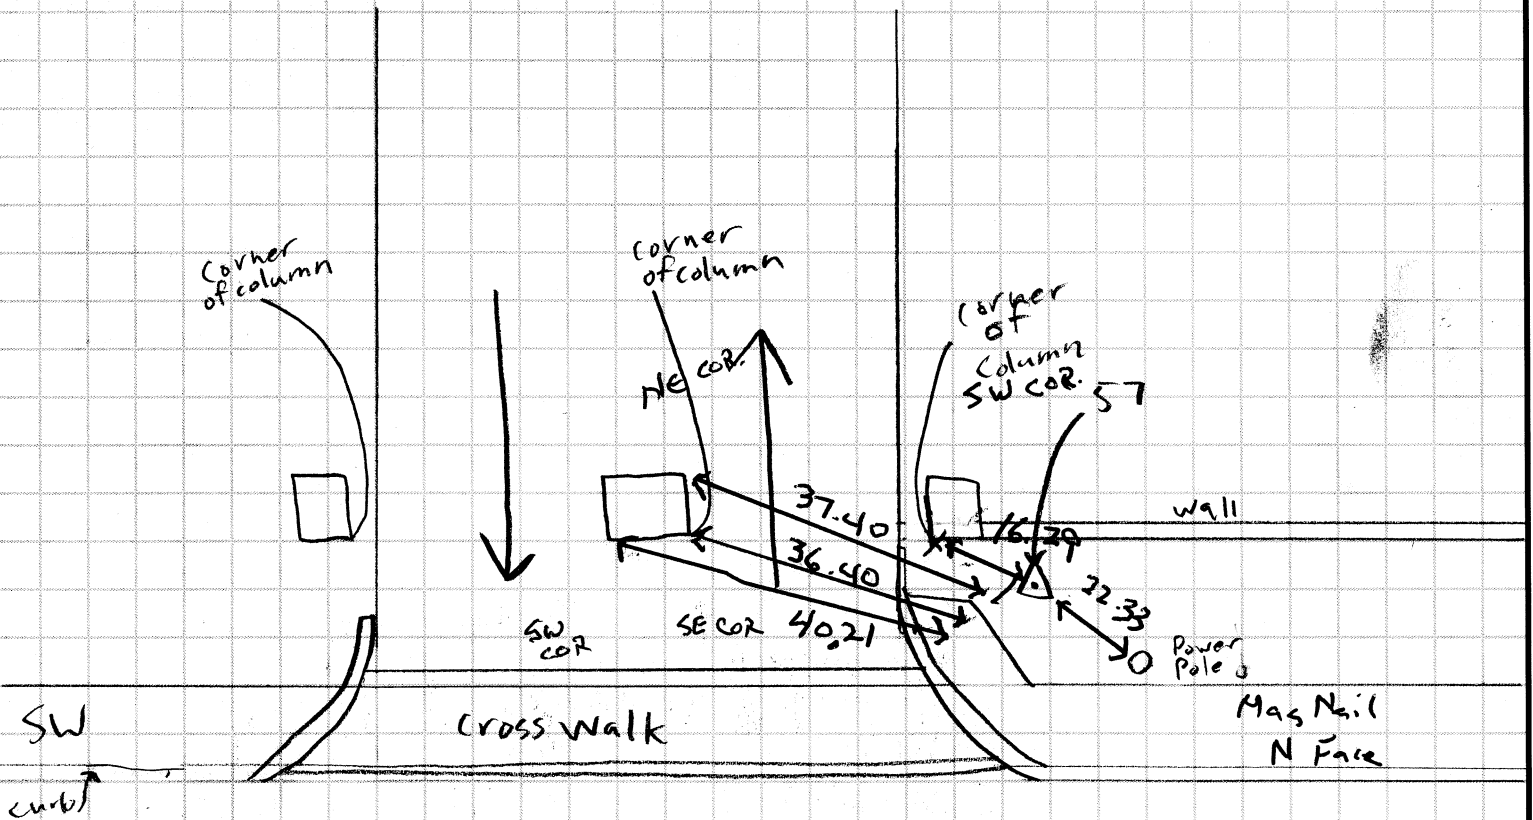

Monroe St

Kroger