

P. O. Box 2628
Whitehouse, Ohio 43571

Phone: 419-877-0400
Fax: 419-877-1140

www.garciasurveyors.com

Job Name: ODOT LUC-23-11.75 PID 105889

Job Number: 214504582


Sheet No. _____ of _____ Scale _____

Calculated by: _____ Date: _____

Checked by: RB/JS/AG/TG Date: 9/18/21

Remarks: _____

Monroe St

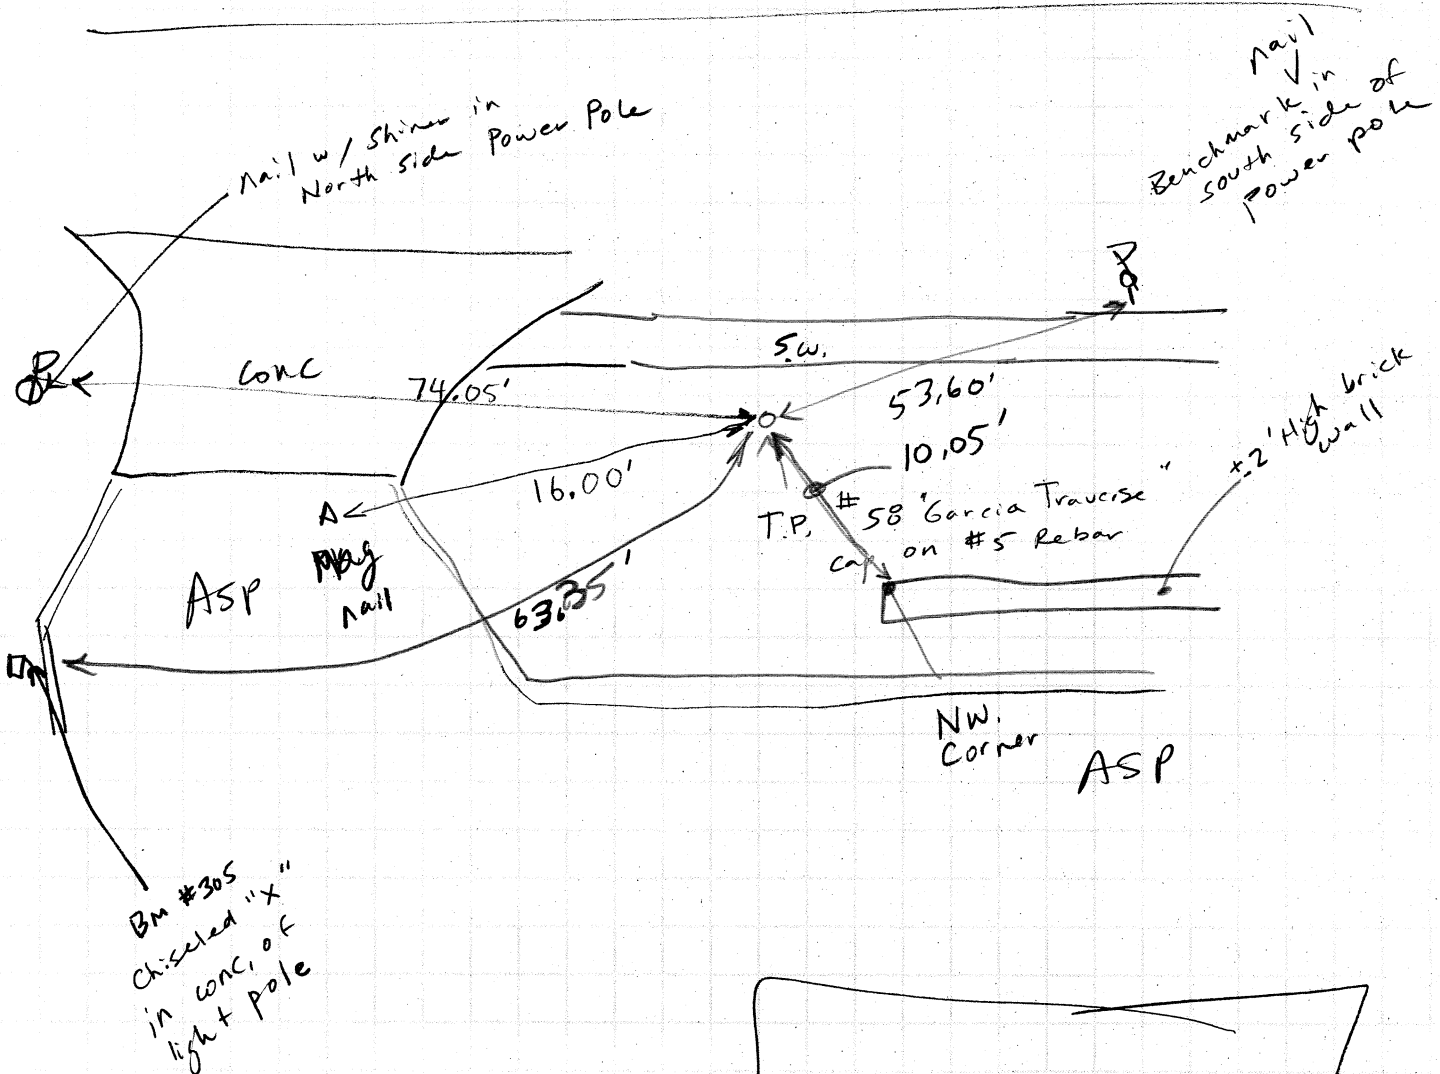

4

58

BP