

ODOT Dist 4 - Mahoning County - FINAL No Passing Zone Log (MAH)

Page: 12 of 21

Route: 0046R (SMAHSR00046**C)

From: 0.000 LEAVE COL CO

Length: 15.896 Direction: North

To: 15.896 C0178 SILICA

Length	Left	C/L	Right	Length	Control Points	Scale: 1.00 mile/page
0.163	11.000		11.000	0.163	10.953 T2550 CURTIS RT	
	10.837		10.837		10.830 C0110 HERBERT LT	
					10.830 U0062R RT	

ODOT Dist 4 - Mahoning County - FINAL No Passing Zone Log (MAH)

Page: 13 of 21

Route: 0046R (SMAHSR00046**C)

From: 0.000 LEAVE COL CO

Length: 15.896

Direction: North

To: 15.896 C0178 SILICA

Length	Left	C/L	Right	Length	Control Points	Scale: 1.00 mile/page
					11.934 Mile Post = 012	
	11.698		11.617		11.621 C0118 GIBSON LT	
					11.430 T2799 WHISPERING MEADOWS LT	
0.698				0.617	11.279 DEER SPRING RUN LT	
					11.110 T2900 REVERE RUN RT	
	11.000		11.000			

Sheet total equivalent length of solid line: 1.411

Accum. total: 12.909

© 2004 - MasterMind Systems, Inc. - Traffic Safety Suite

ODOT Dist 4 - Mahoning County - FINAL No Passing Zone Log (MAH)


Page: 14 of 21

Route: 0046R (SMAHSR00046**C)

From: 0.000 LEAVE COL CO

Length: 15.896 Direction: North

To: 15.896 C0178 SILICA

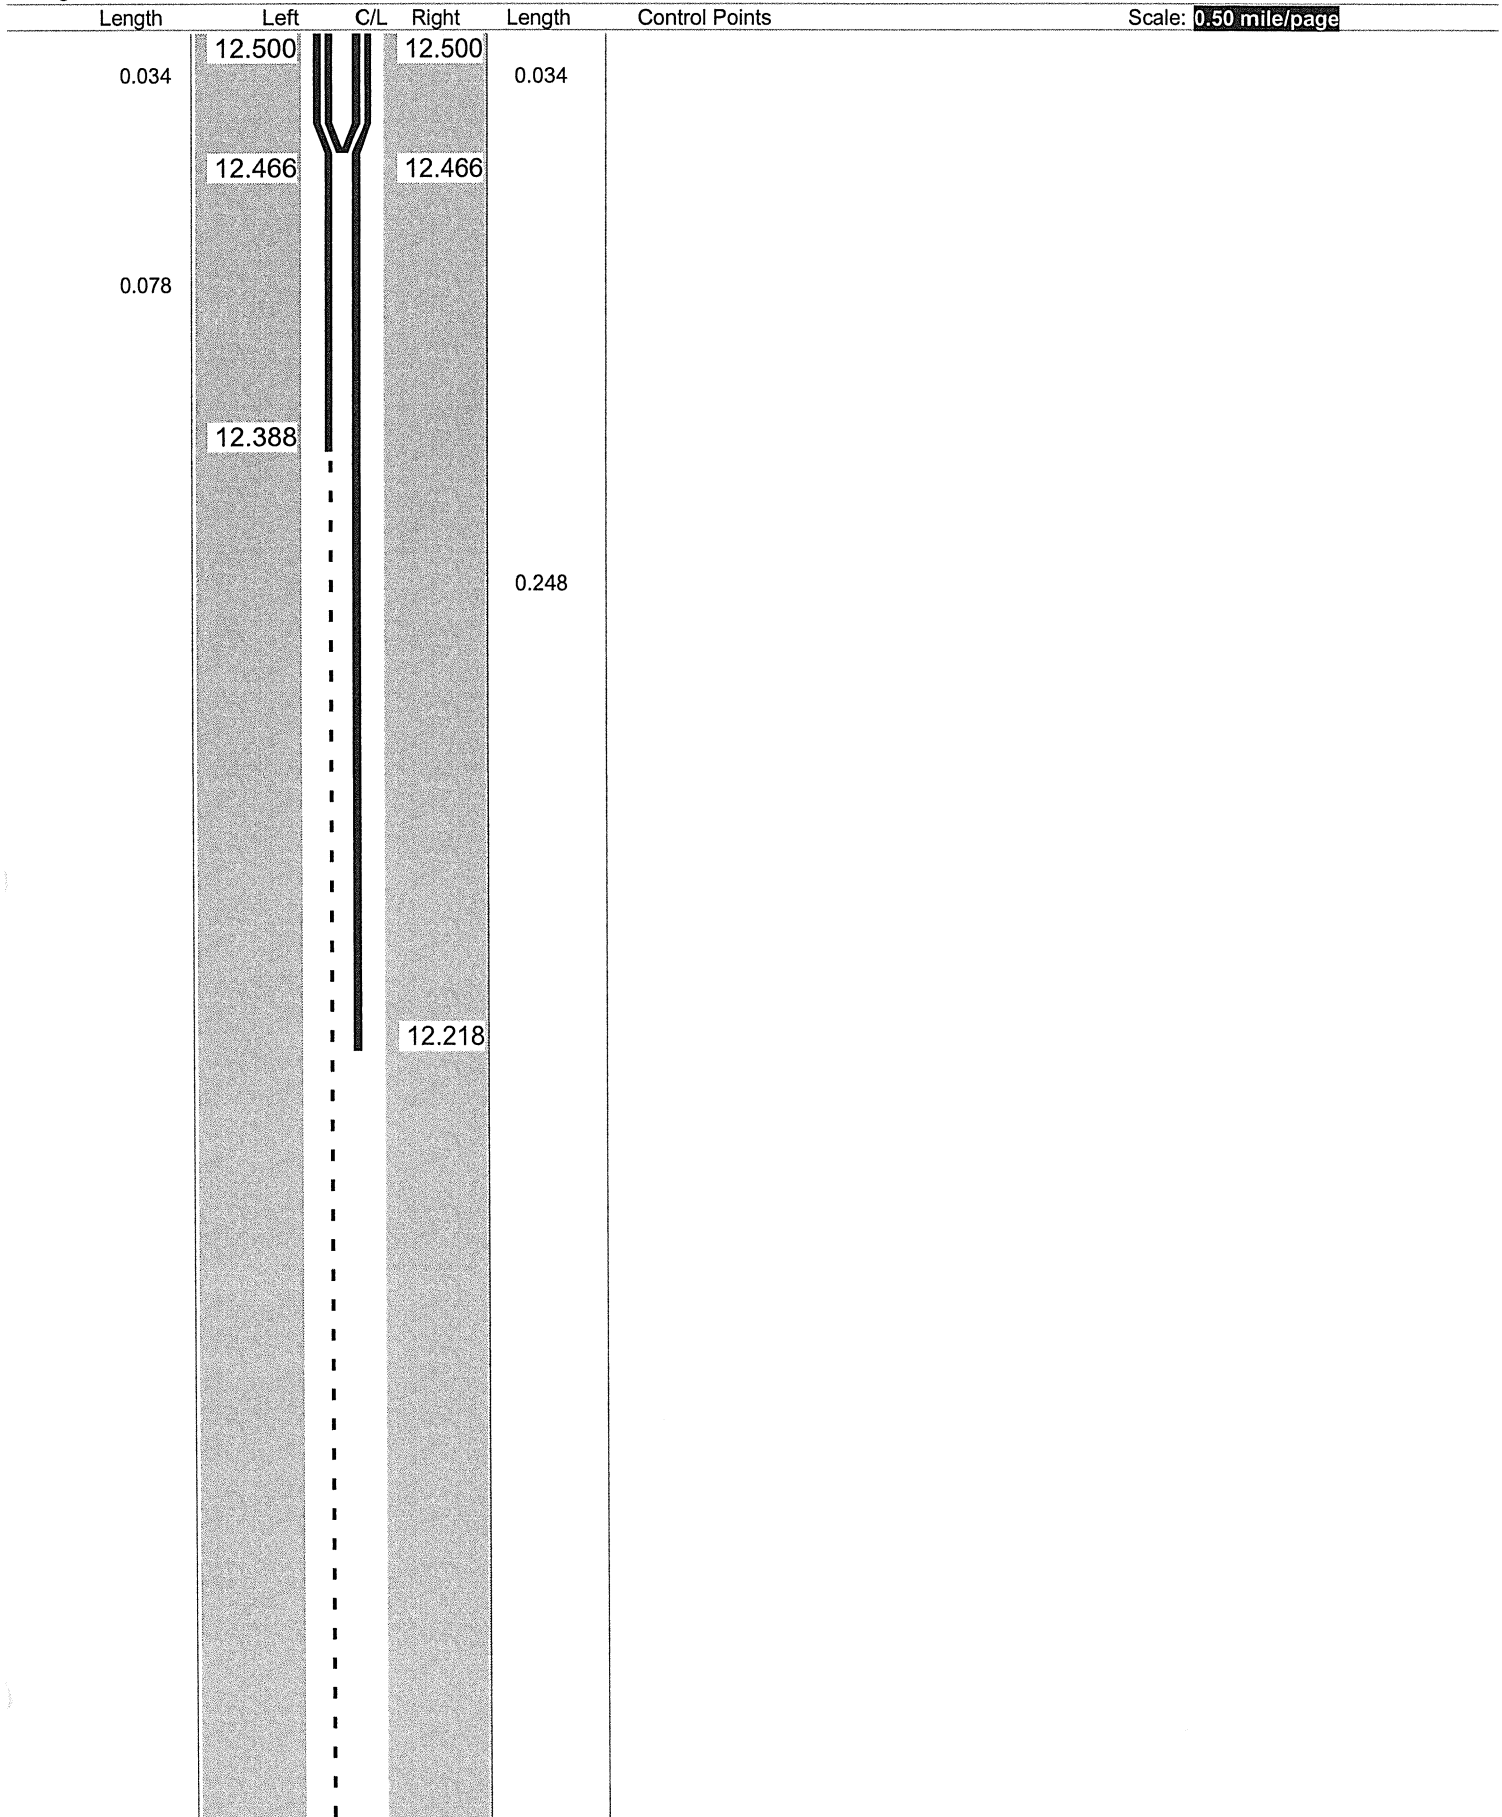

Sheet total equivalent length of solid line: 0.559

Accum. total: 13.468

© 2004 - MasterMind Systems, Inc. - Traffic Safety Suite

ODOT Dist 4 - Mahoning County - FINAL No Passing Zone Log (MAH)

Page: 15 of 21


Route: 0046R (SMAHSR00046**C)

From: 0.000 LEAVE COL CO

Length: 15.896 Direction: North

To: 15.896 C0178 SILICA

Length Left C/L Right Length Control Points Scale: 0.50 mile/page

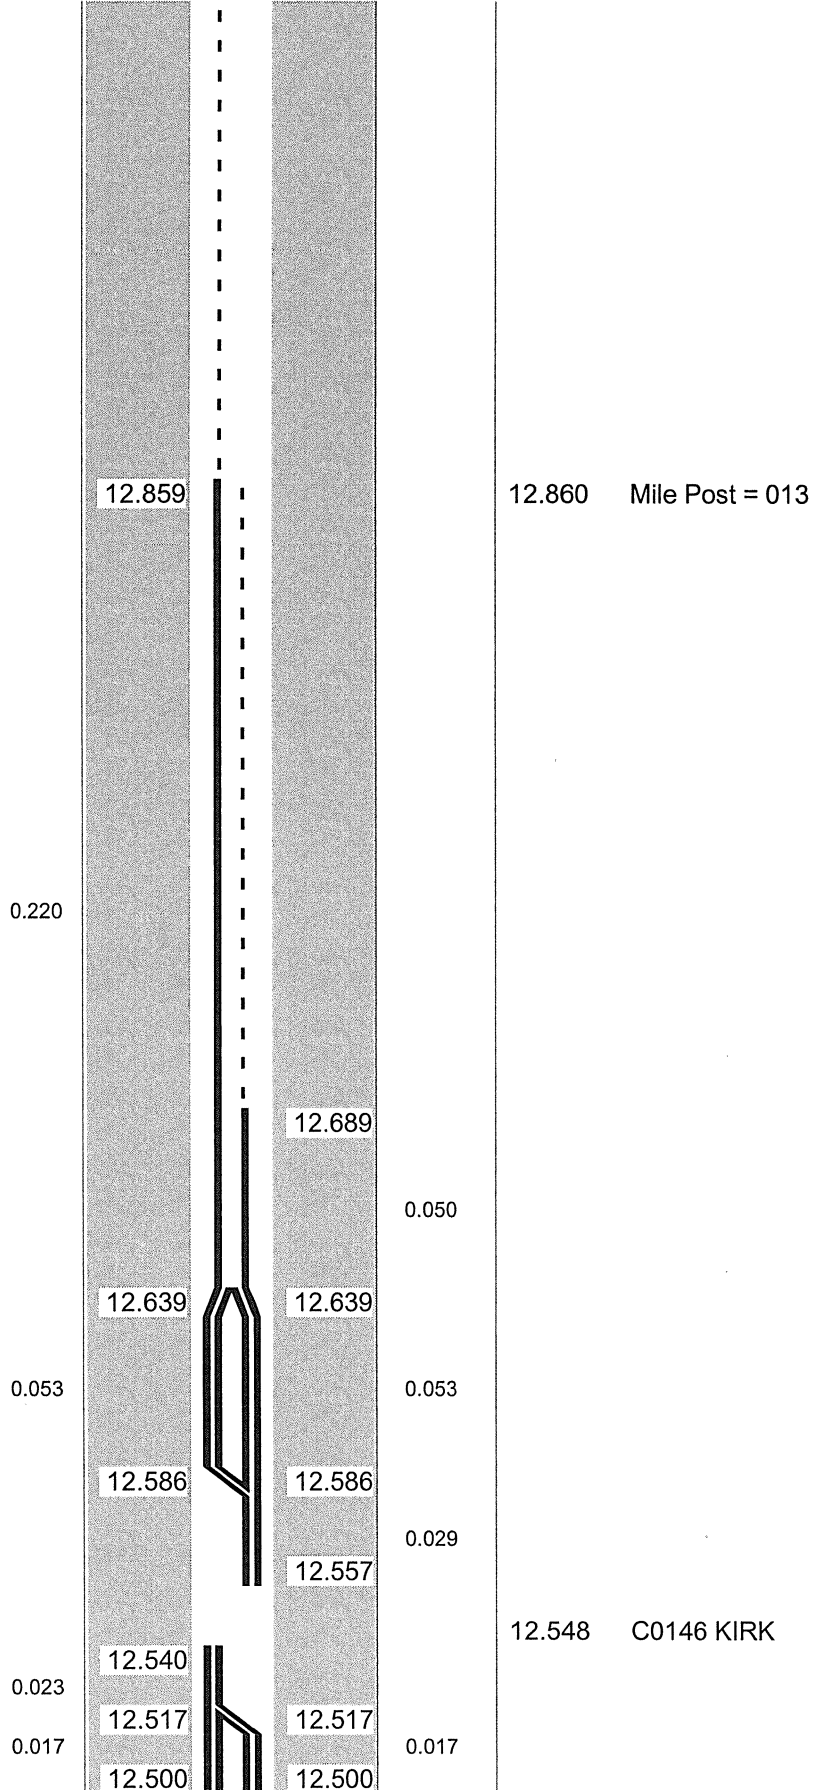

Sheet total equivalent length of solid line: 0.767

Accum. total: 14.235

© 2004 - MasterMind Systems, Inc. - Traffic Safety Suite

ODOT District 4 No Passing Zone Log (MAH)

Page: 1 of 9
10 21

Route: 0046R (SMAHSR00046**C)
Length: 4.106 Direction: North

From: 13.000 LEAVE COL CO
To: 17.106 TRUMBULL COUNTY LINE

Length	Left	C/L	Right	Length	Control Points	Scale: 0.50 mile/page
0.112	13.356		13.244	0.112		
			13.186			
			13.074			

Sheet total equivalent length of solid line: 0.349

Accum. total: 0.349

© 2011 - MasterMind Systems, Inc. - Traffic Safety Suite

ODOT District 4 No Passing Zone Log (MAH)

Page: 2 of 9

Route: 0046R (SMAHSR00046**C)

From: 13.000 LEAVE COL CO

Length: 4.106

Direction: North

To: 17.106 TRUMBULL COUNTY LINE

Length	Left	C/L	Right	Length	Control Points	Scale: 0.50 mile/page
	13.999		13.999		13.983	↑ 40mph
				0.049		
			13.950		13.944 T2267 NOTRE DAME LT	
	13.936				13.943 T2267 WILLOWCREST RT	
					13.936 Mile Post = 014	
0.035						
	13.901		13.901			
0.013				0.013		
	13.888		13.888			
0.025				0.025		
	13.863		13.863			
			13.839	0.024		
					13.831 N BEACON RT	
	13.823		13.823			
0.147				0.147		
	13.676		13.676			
			13.606	0.070		
	13.592				13.598 C0162 NEW	
0.021						
	13.571		13.571			
0.046				0.046		
	13.525		13.525			
0.015				0.015		
	13.510		13.510			

ODOT District 4
No Passing Zone Log (MAH)

Page: 3 of 9

18 21

Route: 0046R (SMAHSR00046**C)


From: 13.000 LEAVE COL CO

Length: 4.106

Direction: North

To: 17.106 TRUMBULL COUNTY LINE

Scale: 0.50 mile/page

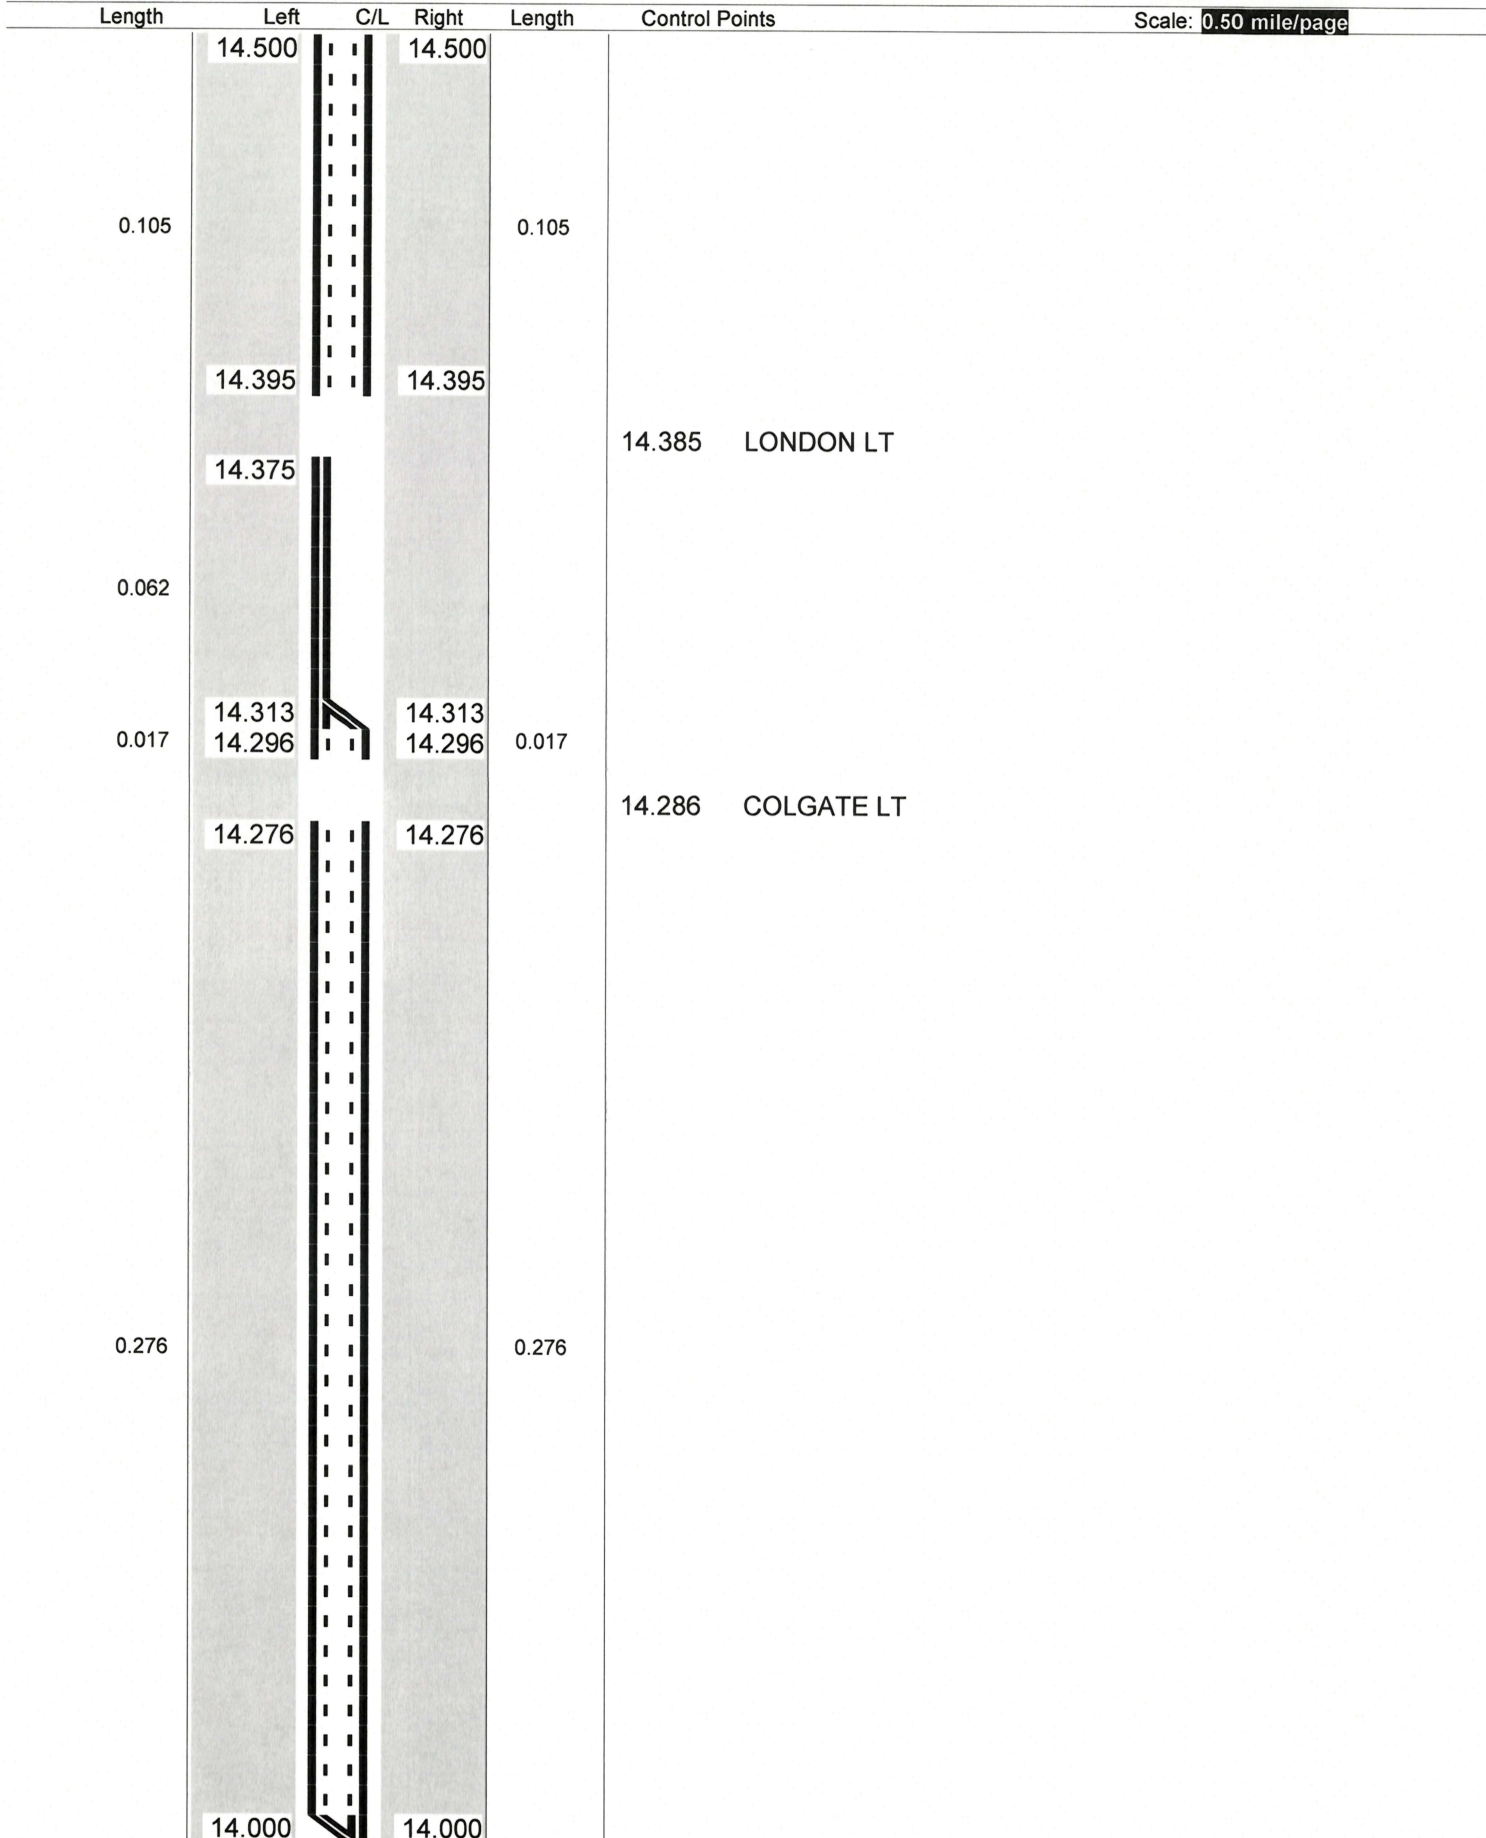

Sheet total equivalent length of solid line: 1.119

Accum. total: 2.572

© 2011 - MasterMind Systems, Inc. - Traffic Safety Suite

ODOT District 4 No Passing Zone Log (MAH)

Page: 4 of 9
19 21

Route: 0046R (SMAHSR00046**C)
Length: 4.106 Direction: North

From: 13.000 LEAVE COL CO
To: 17.106 TRUMBULL COUNTY LINE

Length	Left	C/L	Right	Length	Control Points	Scale: 0.50 mile/page
15.000			15.000			
0.195			0.195		14.935 Mile Post = 015	
14.805			14.805			
14.778			14.778		14.785 C0105 BARKLEY LT	
14.749			14.749			
0.029			0.062			
14.687			14.687		14.676 C0018 MAHONING	
14.665			14.665			
0.096			0.069			
14.569			14.569			
0.069			0.069			
14.500			14.500			

Sheet total equivalent length of solid line: 1.045

Accum. total: 3.617

© 2011 - MasterMind Systems, Inc. - Traffic Safety Suite

ODOT District 4
No Passing Zone Log (MAH)

Page: 5 of 9

Route: **0046R (SMAHSR00046**C)**
 Length: **4.106** Direction: **North**

From: **13.000 LEAVE COL CO**
 To: **17.106 TRUMBULL COUNTY LINE**

Scale: **0.50 mile/page**

Length	Left	C/L	Right	Length	Control Points
	15.500		15.500		
0.313				0.313	
					15.302 T1902 RED APPLE LT
					15.274 T1917 RADIO RT
	15.187		15.187		
	15.175		15.175		15.182 T1915 ROCKWELL RT
0.052				0.052	
	15.123		15.123	0.024	
			15.099		
	15.083				15.091 C0284 NORQUEST
0.027					
	15.056		15.056		
0.038				0.038	
	15.018		15.018		
					15.012 VIRGINIA RT
0.003	15.003		15.003	0.003	

Sheet total equivalent length of solid line: 1.096

Accum. total: 4.713

© 2011 - MasterMind Systems, Inc. - Traffic Safety Suite

Page: 6 of 9

From: 13.000 LEAVE COL CO
To: 17.106 TRUMBULL COUNTY LINE

Sheet total equivalent length of solid line: 1.066 Accum. total: 5.779 © 2011 - MasterMind Systems, Inc. - Traffic Safety Suite


ODOT District 4
No Passing Zone Log (MAH)

Page: 7 of 9

Route: **0046R (SMAHSR00046**C)**
 Length: **4.106** Direction: **North**

From: **13.000 LEAVE COL CO**
 To: **17.106 TRUMBULL COUNTY LINE**

Scale: 0.50 mile/page

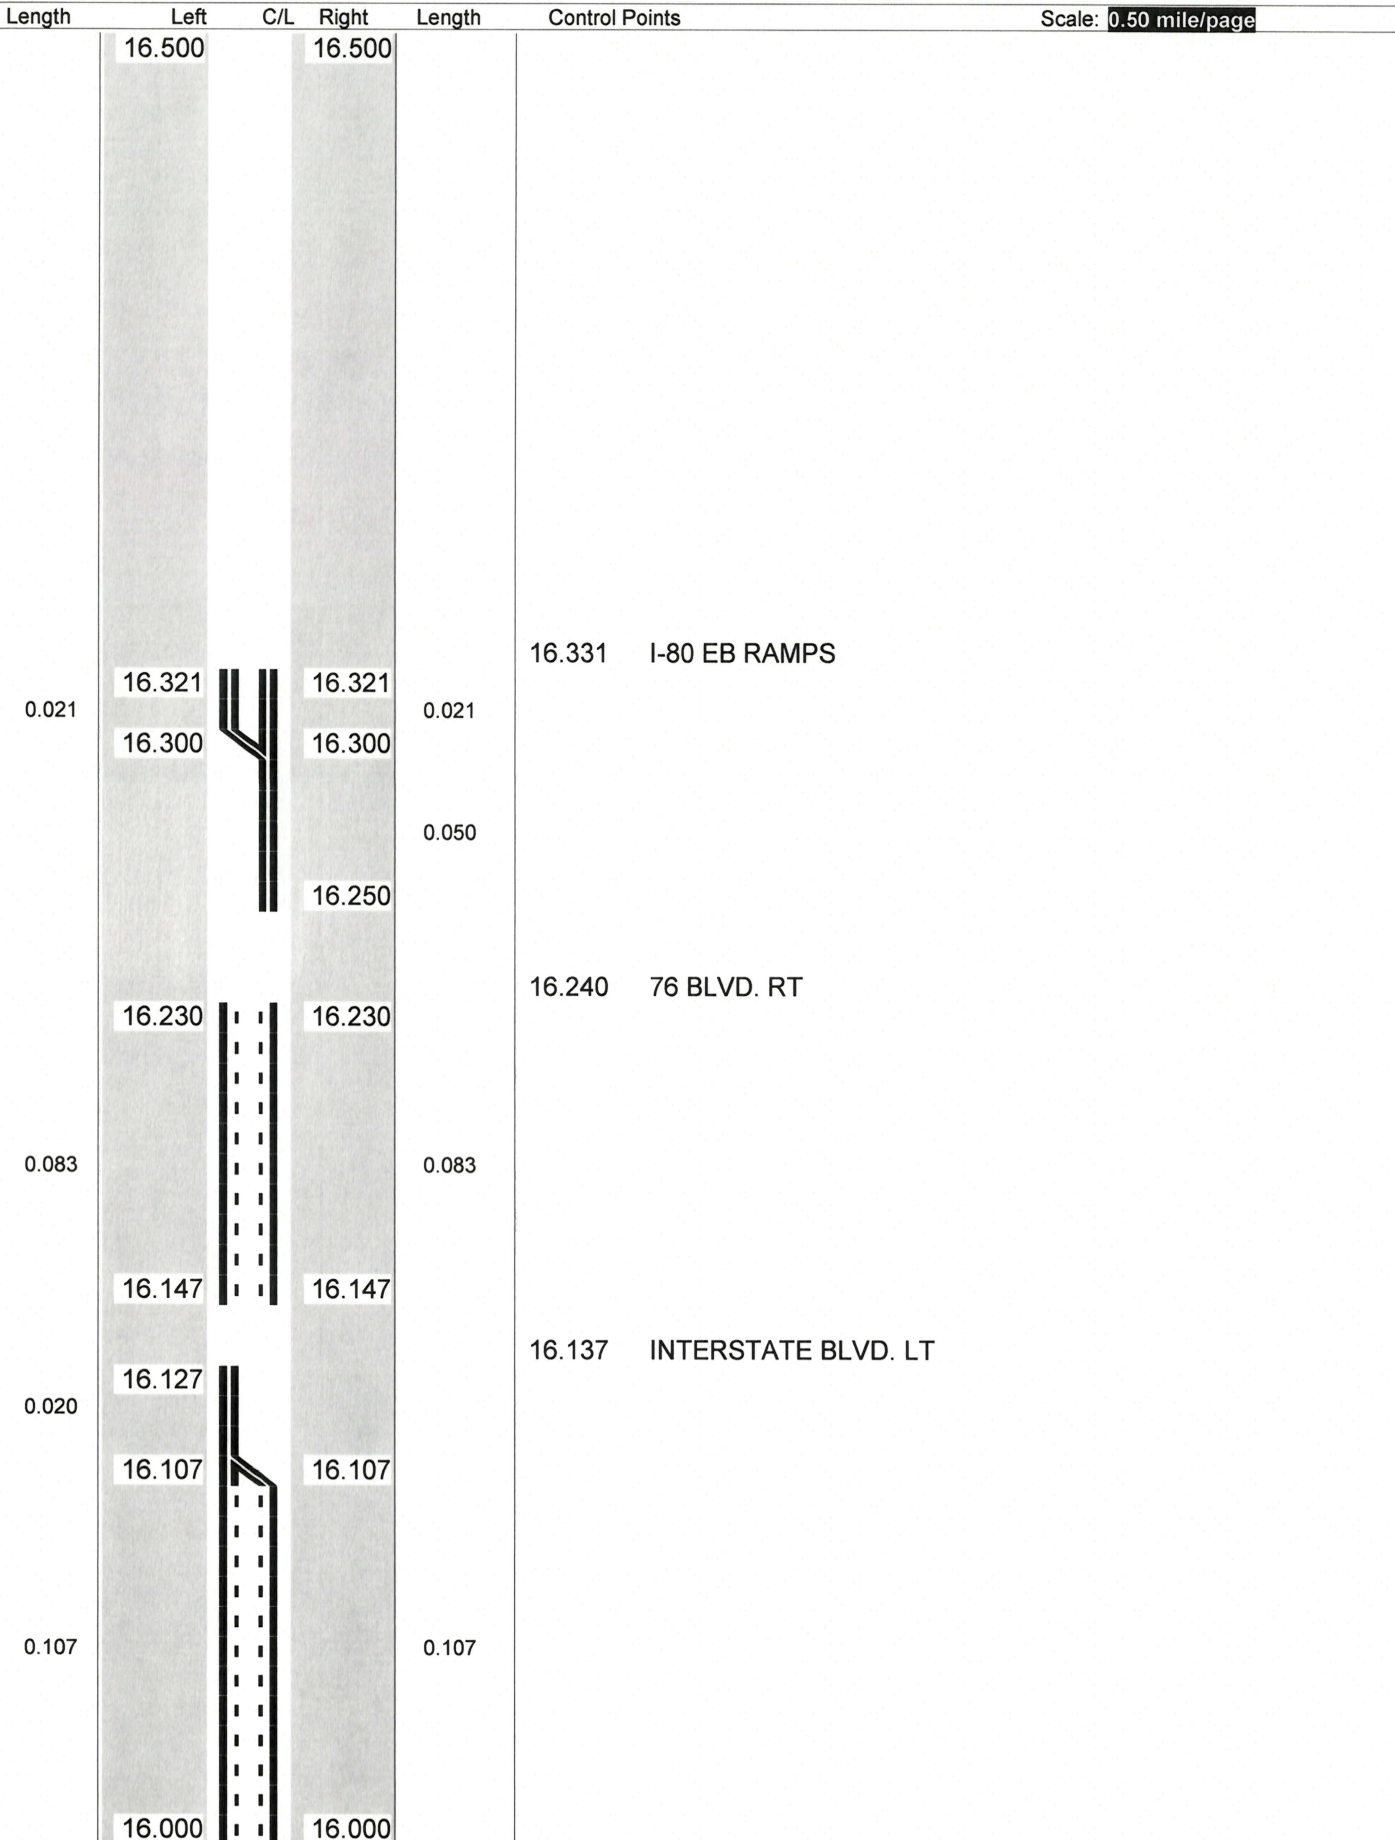

Sheet total equivalent length of solid line: 0.699

Accum. total: 6.478

© 2011 - MasterMind Systems, Inc. - Traffic Safety Suite

Page: 8 of 9

From: 13.000 LEAVE COL CO
To: 17.106 TRUMBULL COUNTY LINE

Sheet total equivalent length of solid line: 0.746 Accum. total: 7.224 © 2011 - MasterMind Systems, Inc. - Traffic Safety Suite