


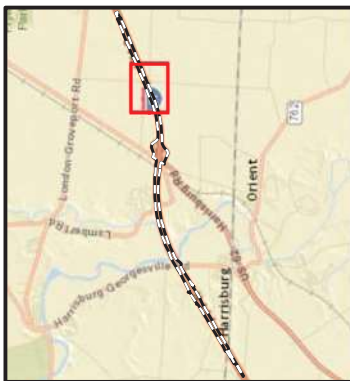

Extent Indicator Map

Legend

- Study Area
- Coordinated Construction Limits
- Revised Construction Limits
- Bat PRT
- Stream
- Culvert
- Wetland
- Sample Point



FRA-71-0.00
PID 93496

Ecological Resource Map



Date:
February 2016


Approved by:
CM

U&A No.
14-0251



Figure
3-F

File Name: 03-ECO 2016.mxd

Effect: 3/22/2016 By: dwilliams

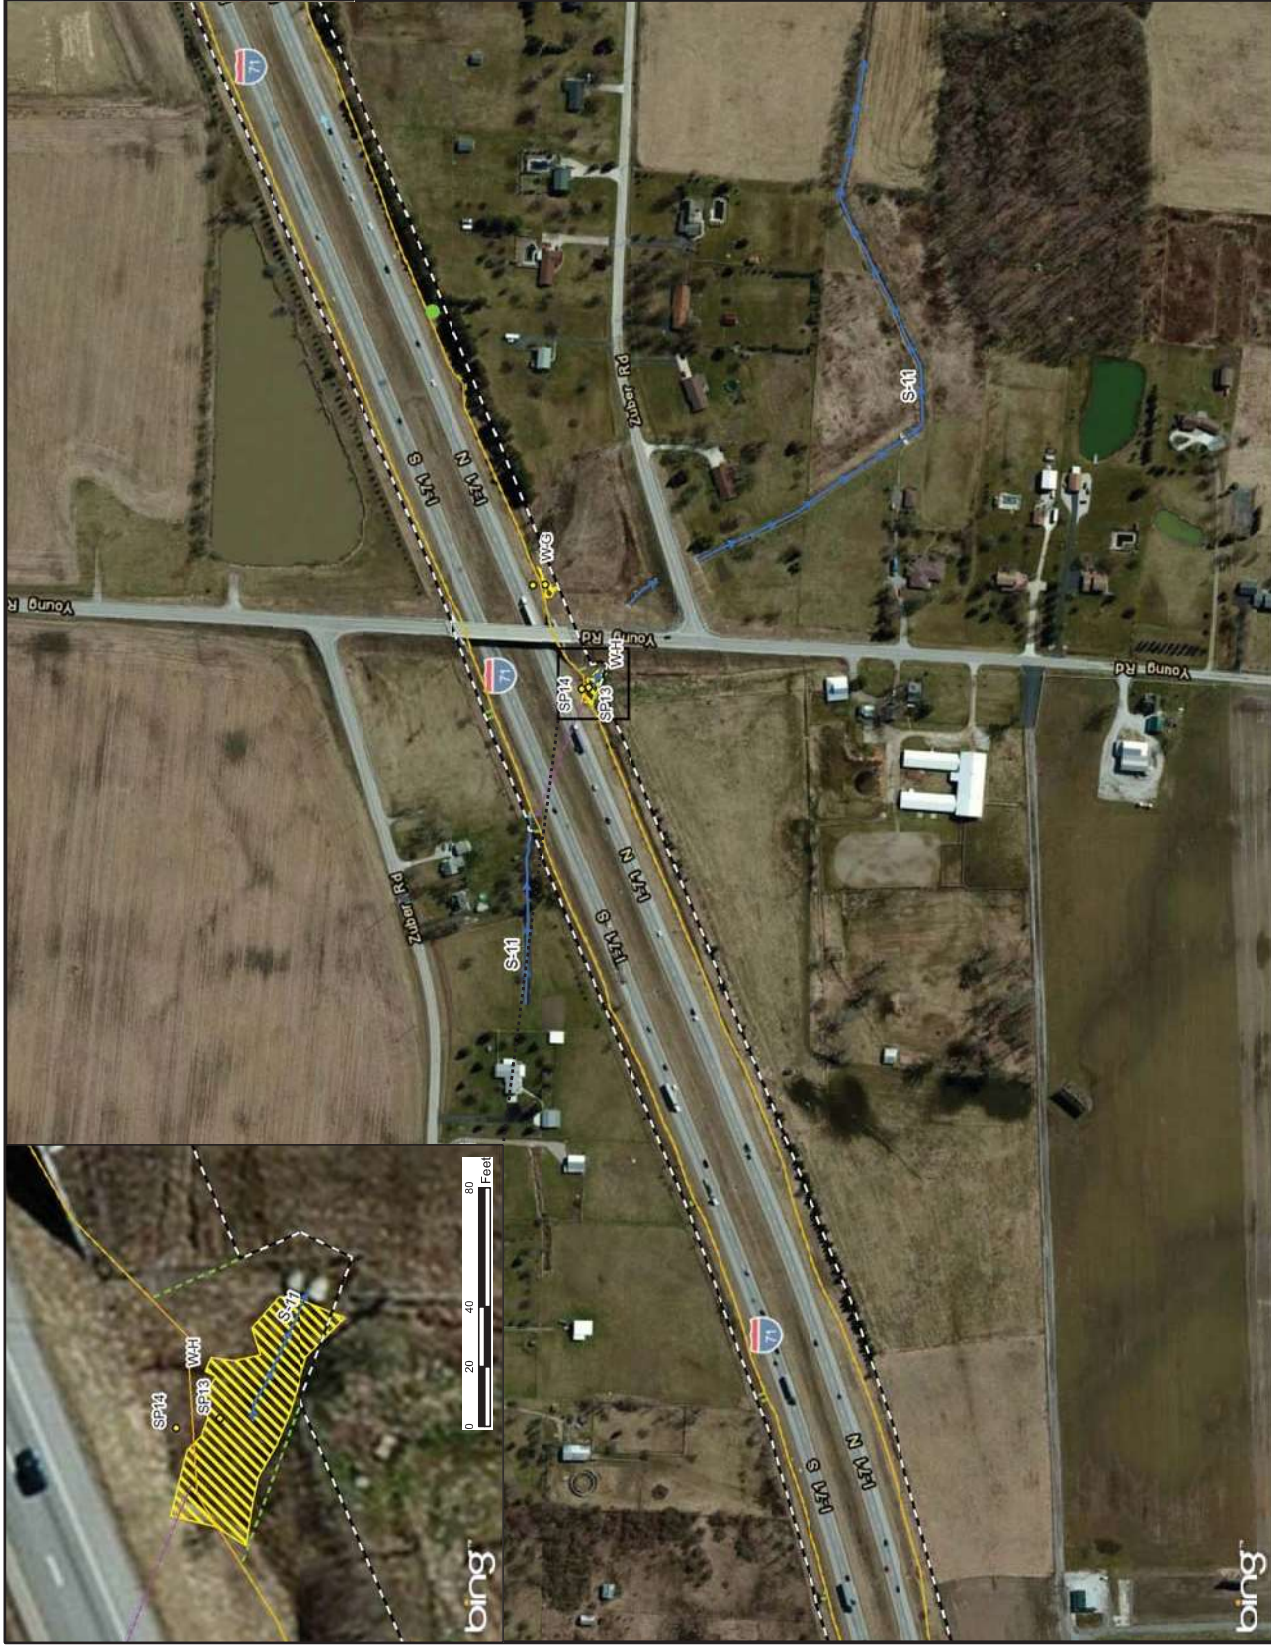

Source: Bing Maps Aerial

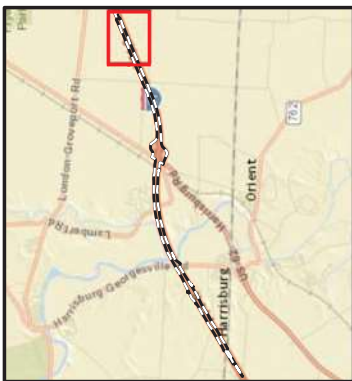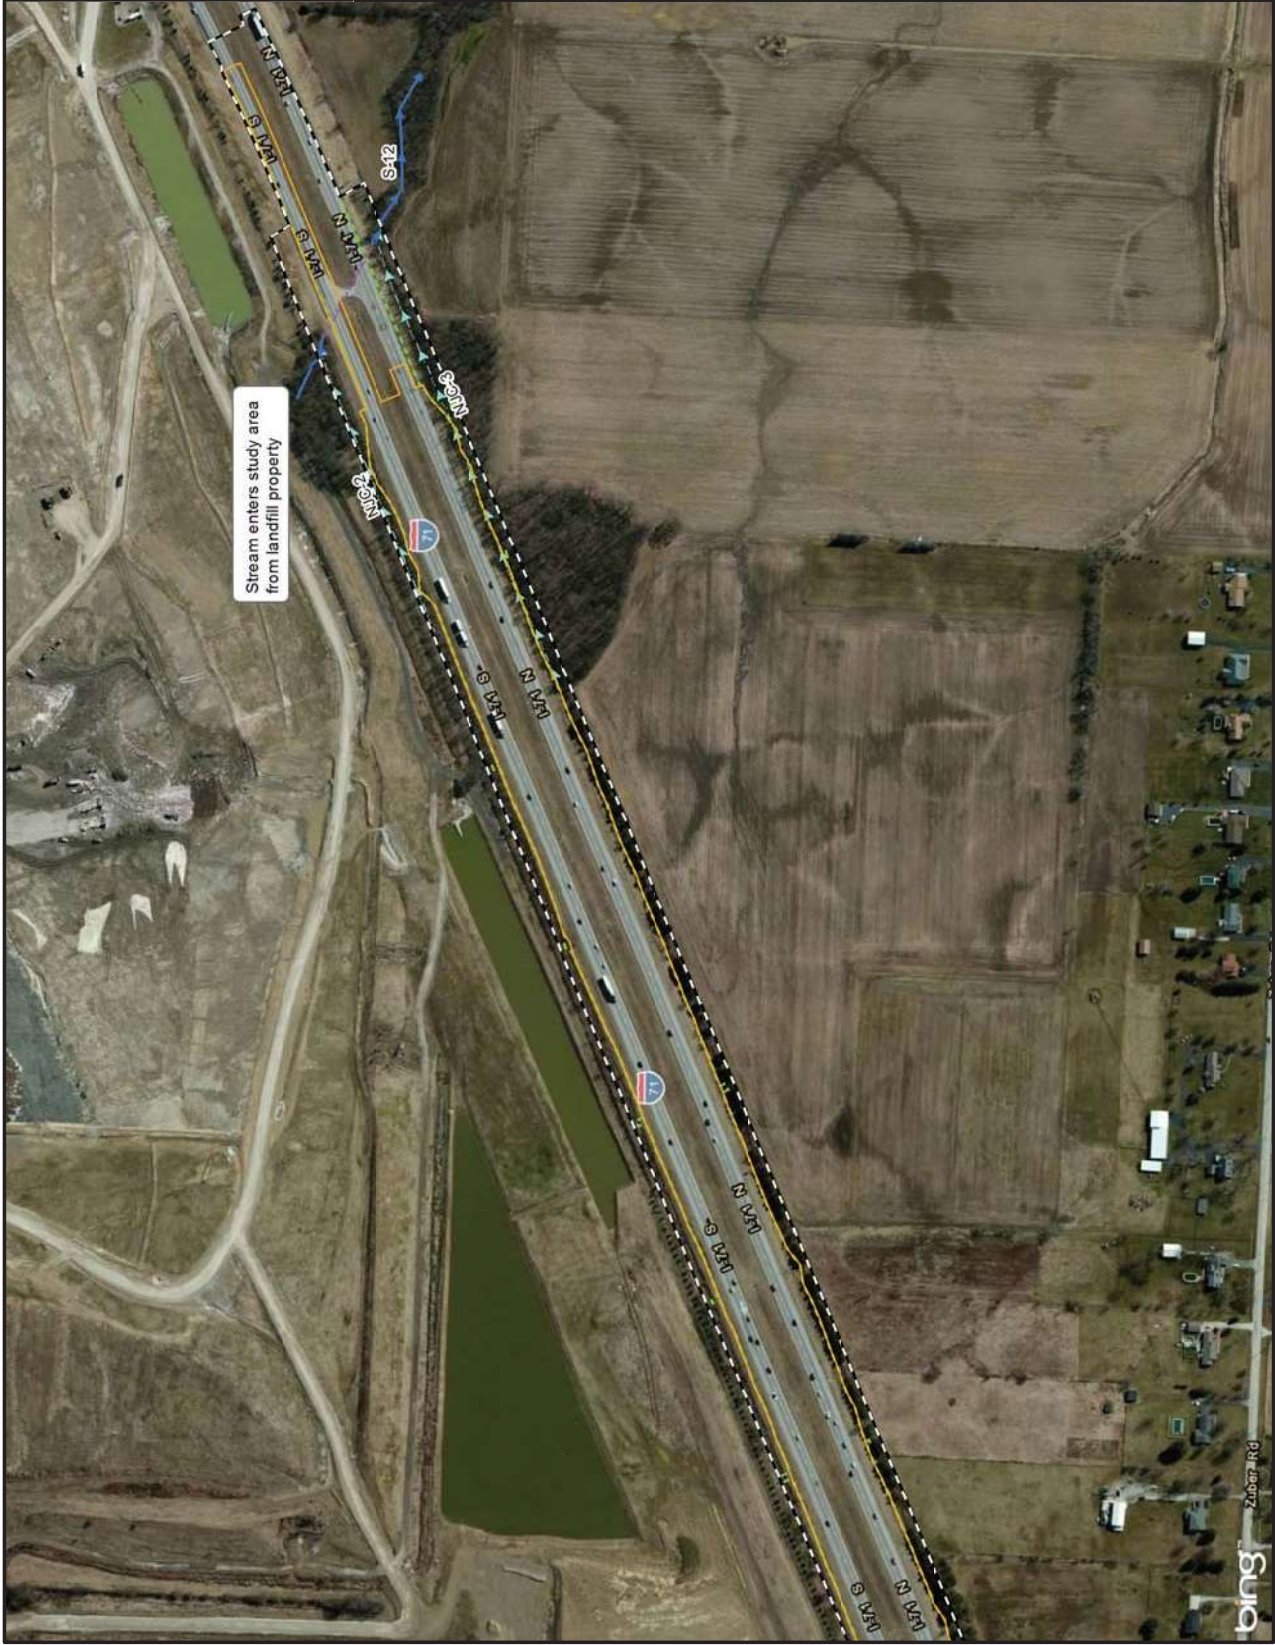

Extent Indicator Map

Legend

- Study Area
- Coordinated Construction Limits
- Revised Construction Limits
- Bat PRT
- Stream
- Non-Jurisdictional Conveyance
- Culvert

0 100 200 400 600 800 Feet

FRA-71-0.00
PID 93496

Ecological Resource Map

LA
Lawlor & Associates, Inc.

Date:	February 2016	U&A No.:	14-0251	Figure:	3-G
Approved by:	CM				

File Name: ECO 2016.mxd
Edited: 2/25/2016 By: dcllams