


Urethane formliners MUST be stored between 55° and 85° Fahrenheit. Failure to do so will result in deterioration of these formliners and will warrant them both unusable and destroyed. Additionally, if the urethane formliner is bonded to a plywood core, this will cause deformation of the holes used for bonding the plywood to the formliner and cause the holes to reflect into the finished product. Therefore, AP will NOT assume any liability for damaged formliners caused from improper storage.

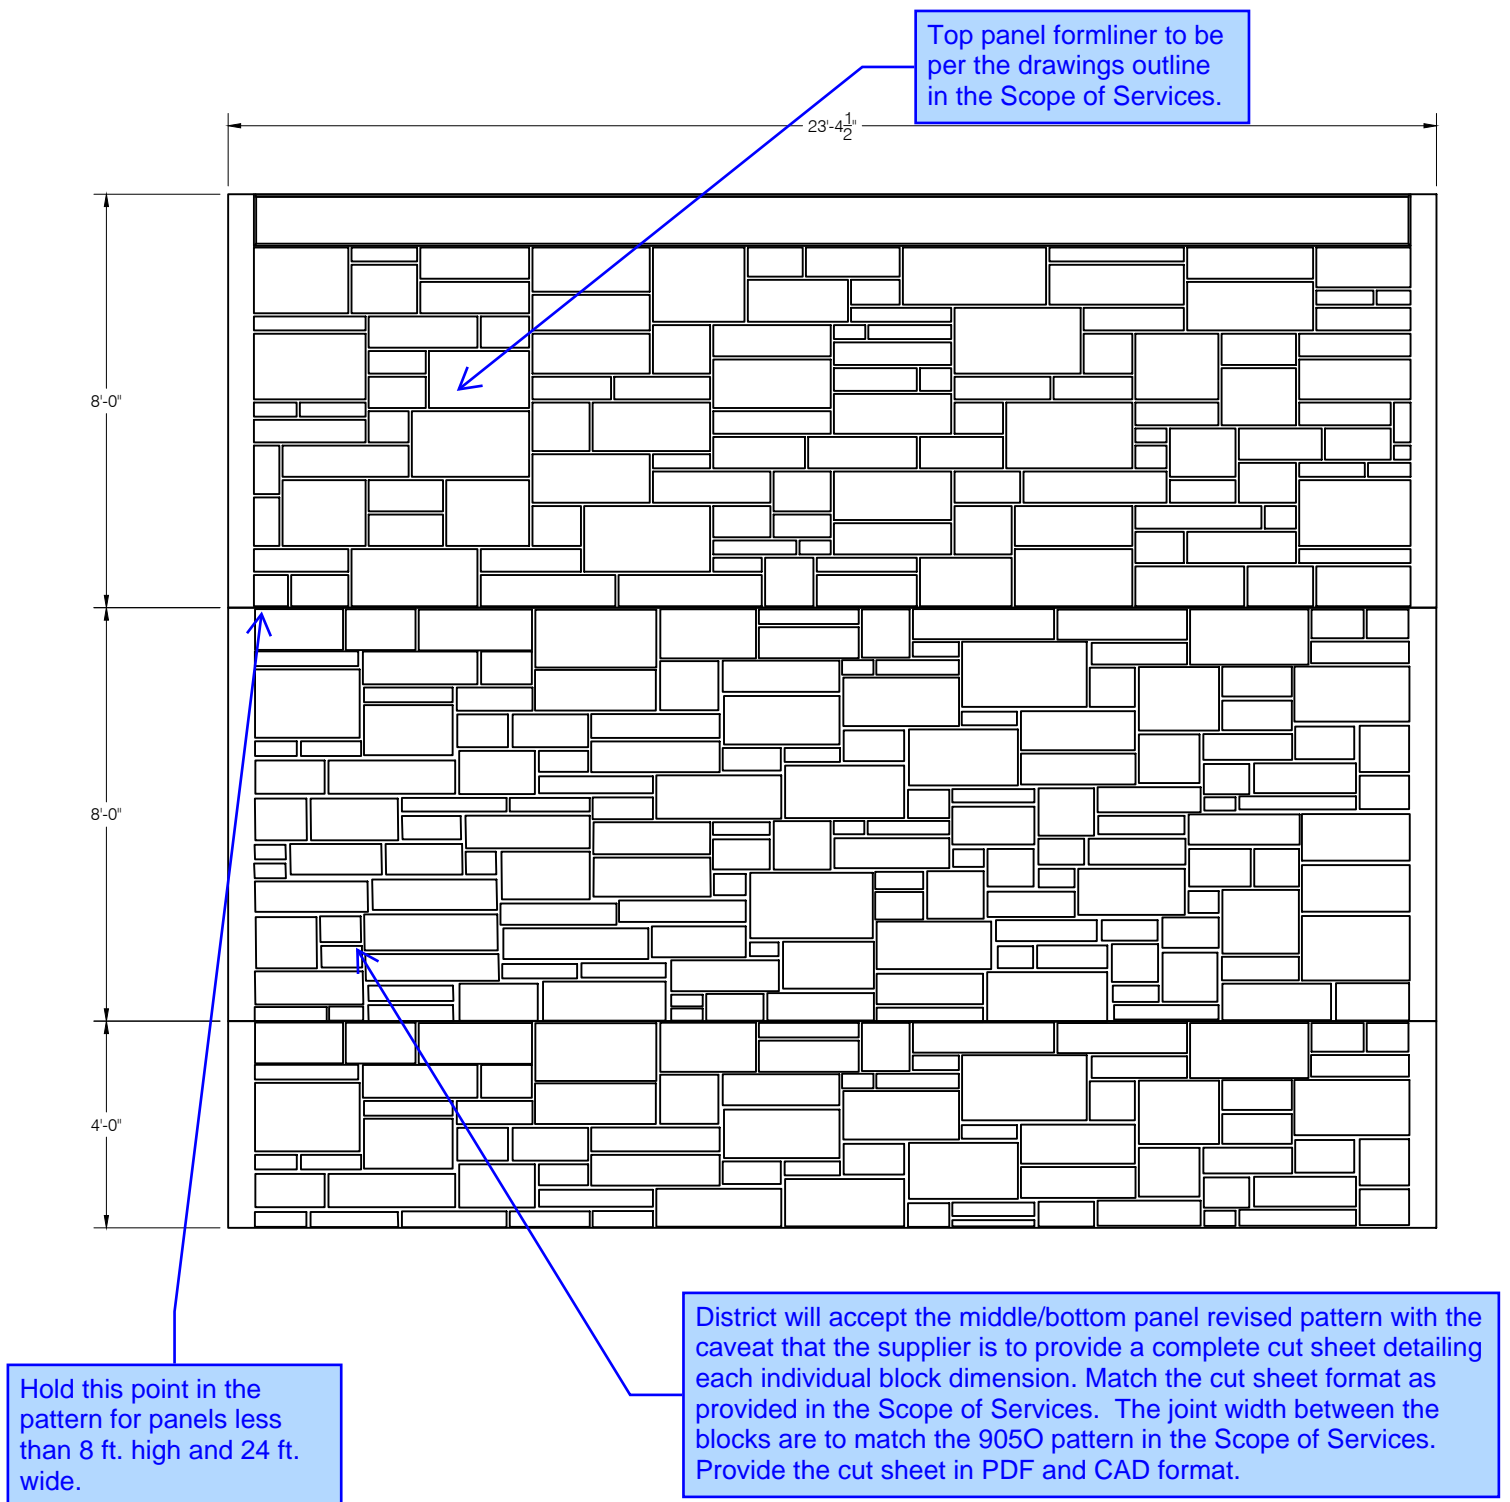

ODOT HAMILTON CO.  
104668 (20-3000)  
FADDIS CONCRETE PRODUCTS  
SAMPLE RENDERING  
4/30/2024