

ODOT Dist 4 - Mahoning County - FINAL No Passing Zone Log (MAH)


Page: 1 of 20

Route: 0224R (SMAHUS00224**C)

From: 0.000 LEAVE POR CO

Length: 25.370 Direction: East

To: 25.370 ENTER PA STATE

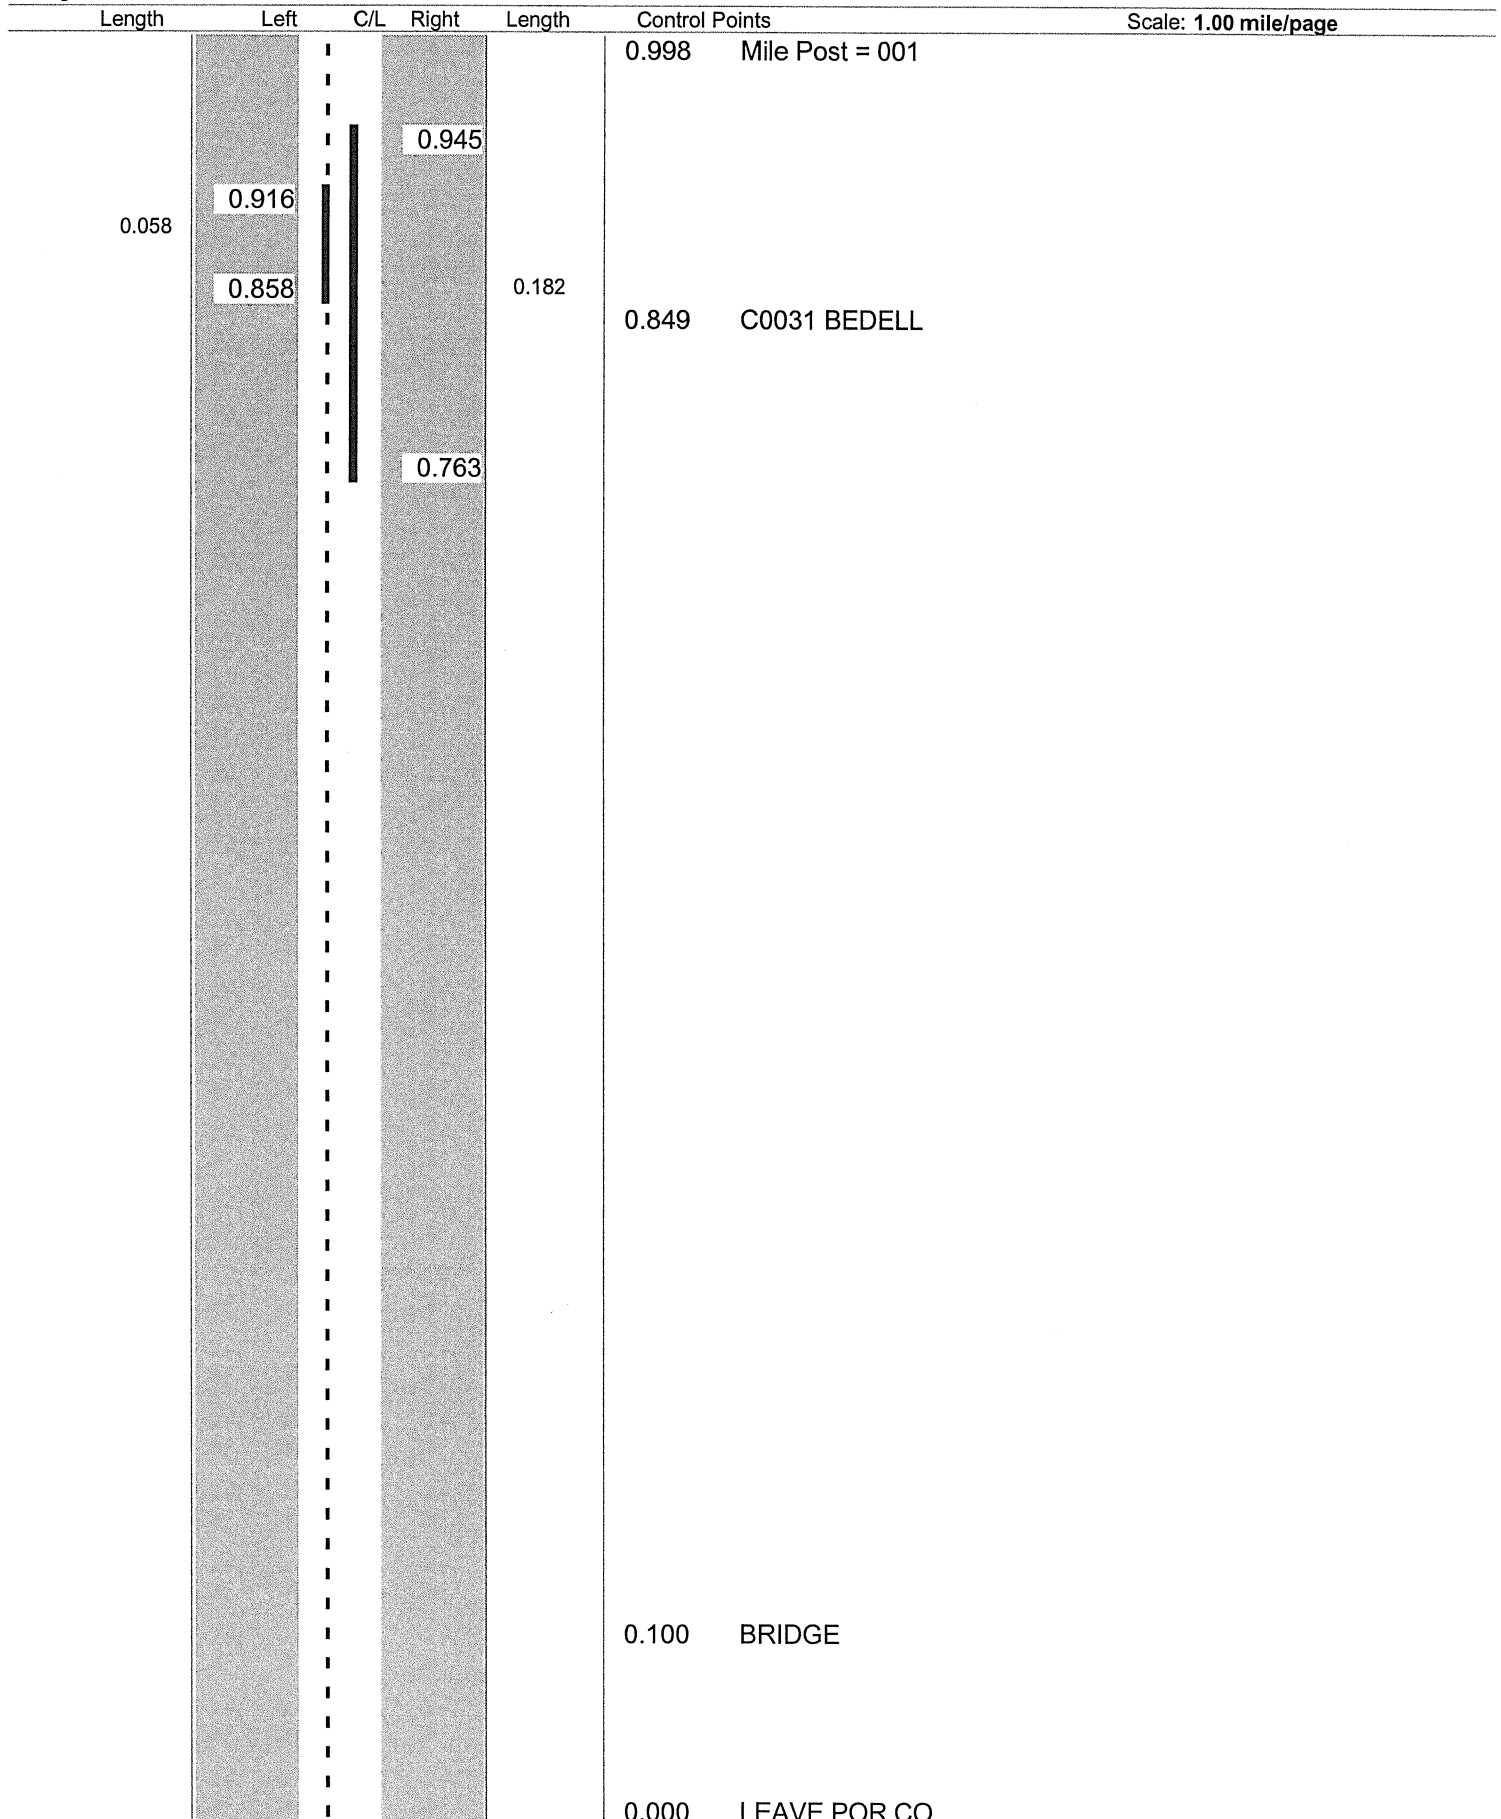

Sheet total equivalent length of solid line: 0.476

Accum. total: 0.476

© 2004 - MasterMind Systems, Inc. - Traffic Safety Suite

No Passing Zone Log (MAH)

To: **25.370 ENTER PA STATE**

Scale: 1.00 mile/page

1.077

ODOT Dist 4 - Mahoning County - FINAL
No Passing Zone Log (MAH)

Page: 3 of 20


Route: 0224R (SMAHUS00224**C)

From: 0.000 LEAVE POR CO

Length: 25.370

Direction: East

To: 25.370 ENTER PA STATE

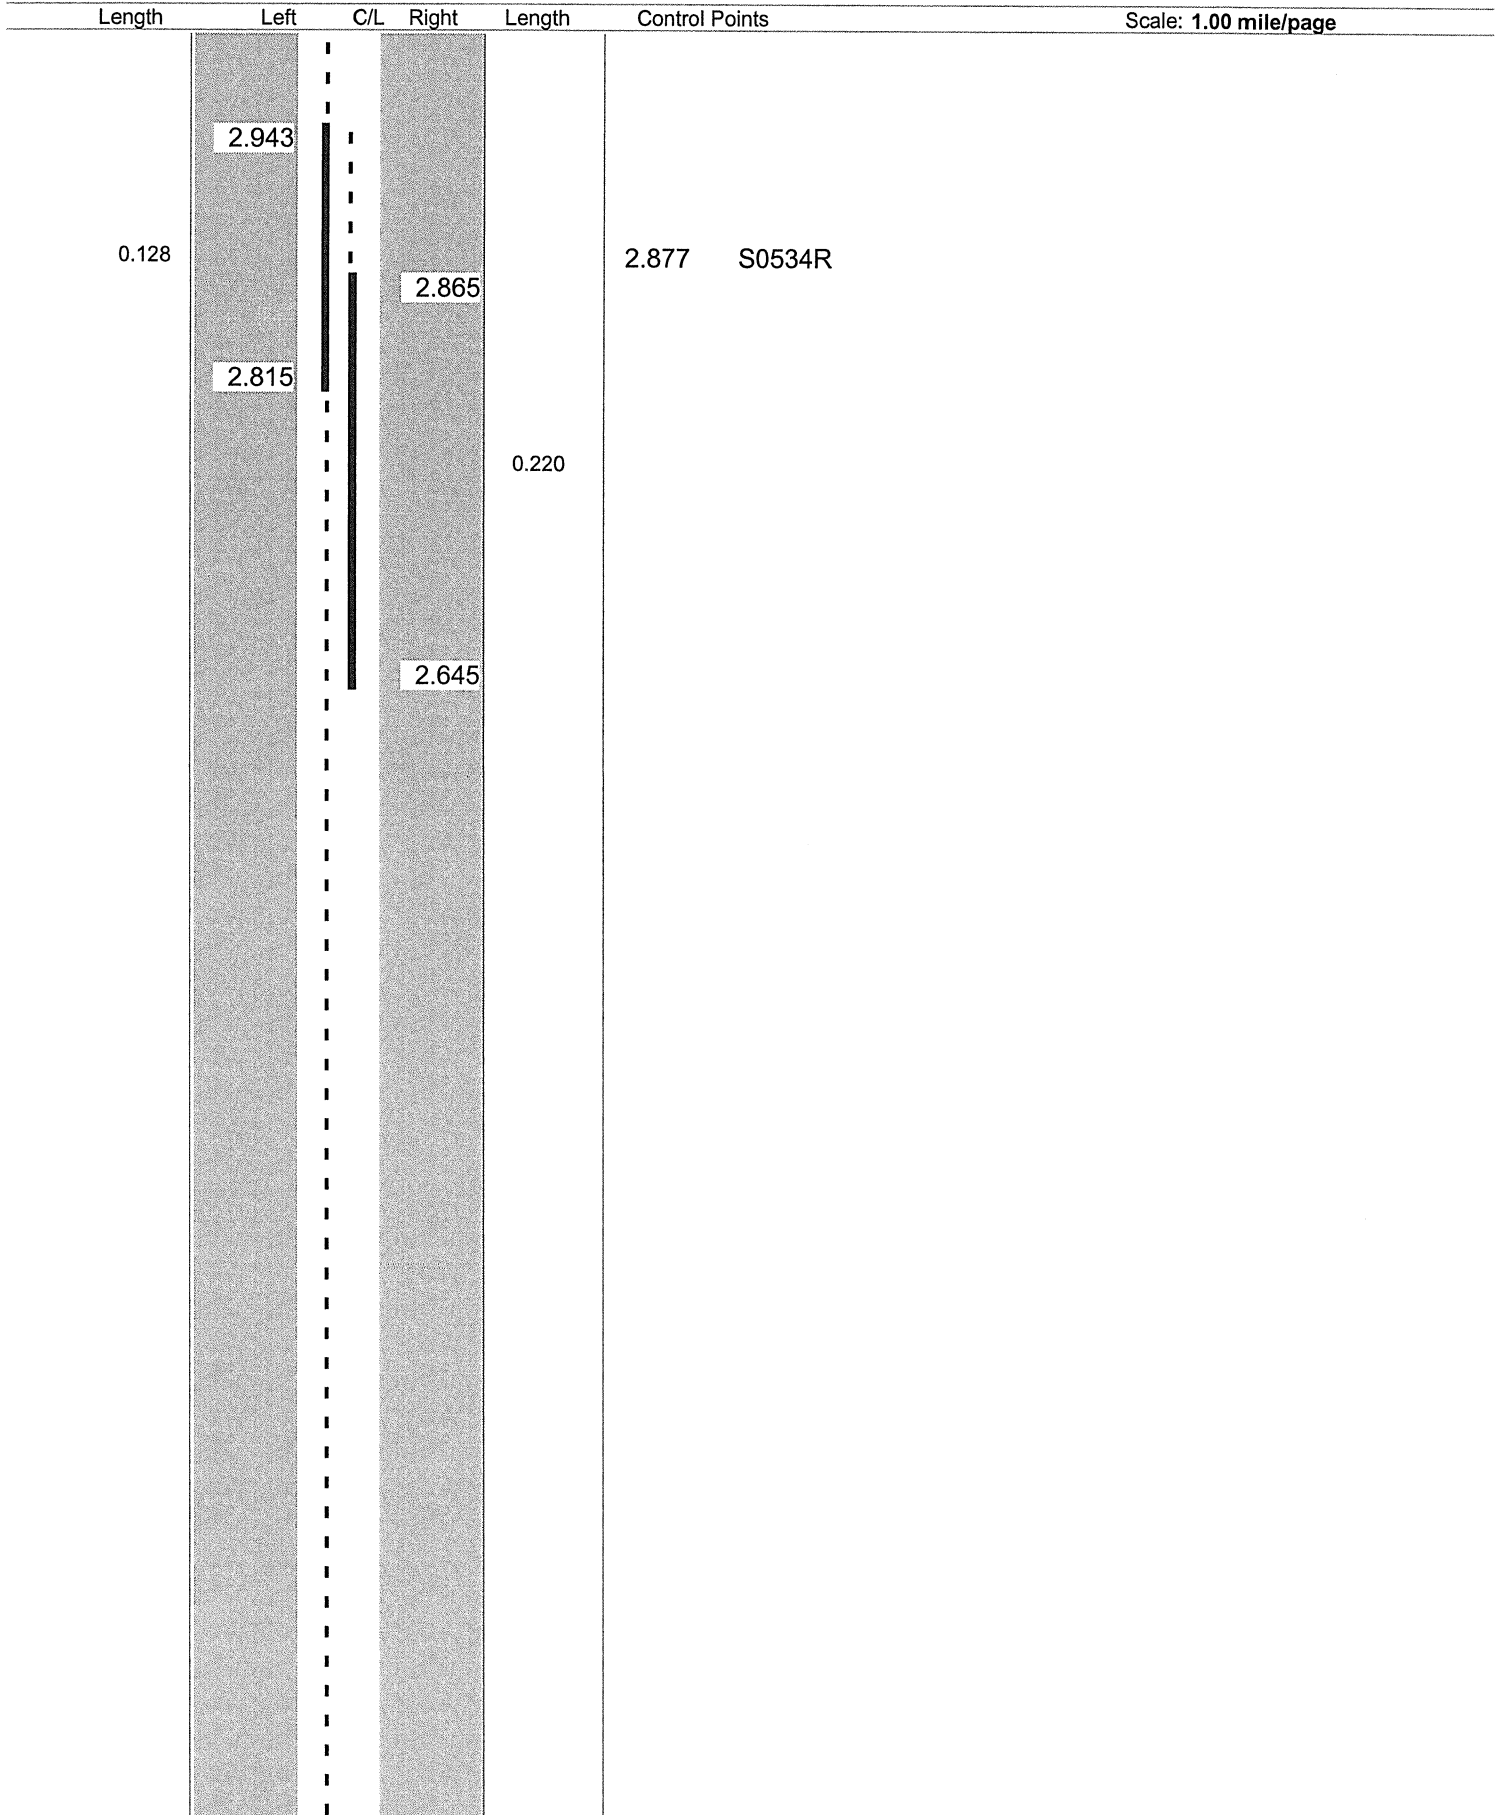

Sheet total equivalent length of solid line: 0.586

Accum. total: 1.407

© 2004 - MasterMind Systems, Inc. - Traffic Safety Suite