


S R 193

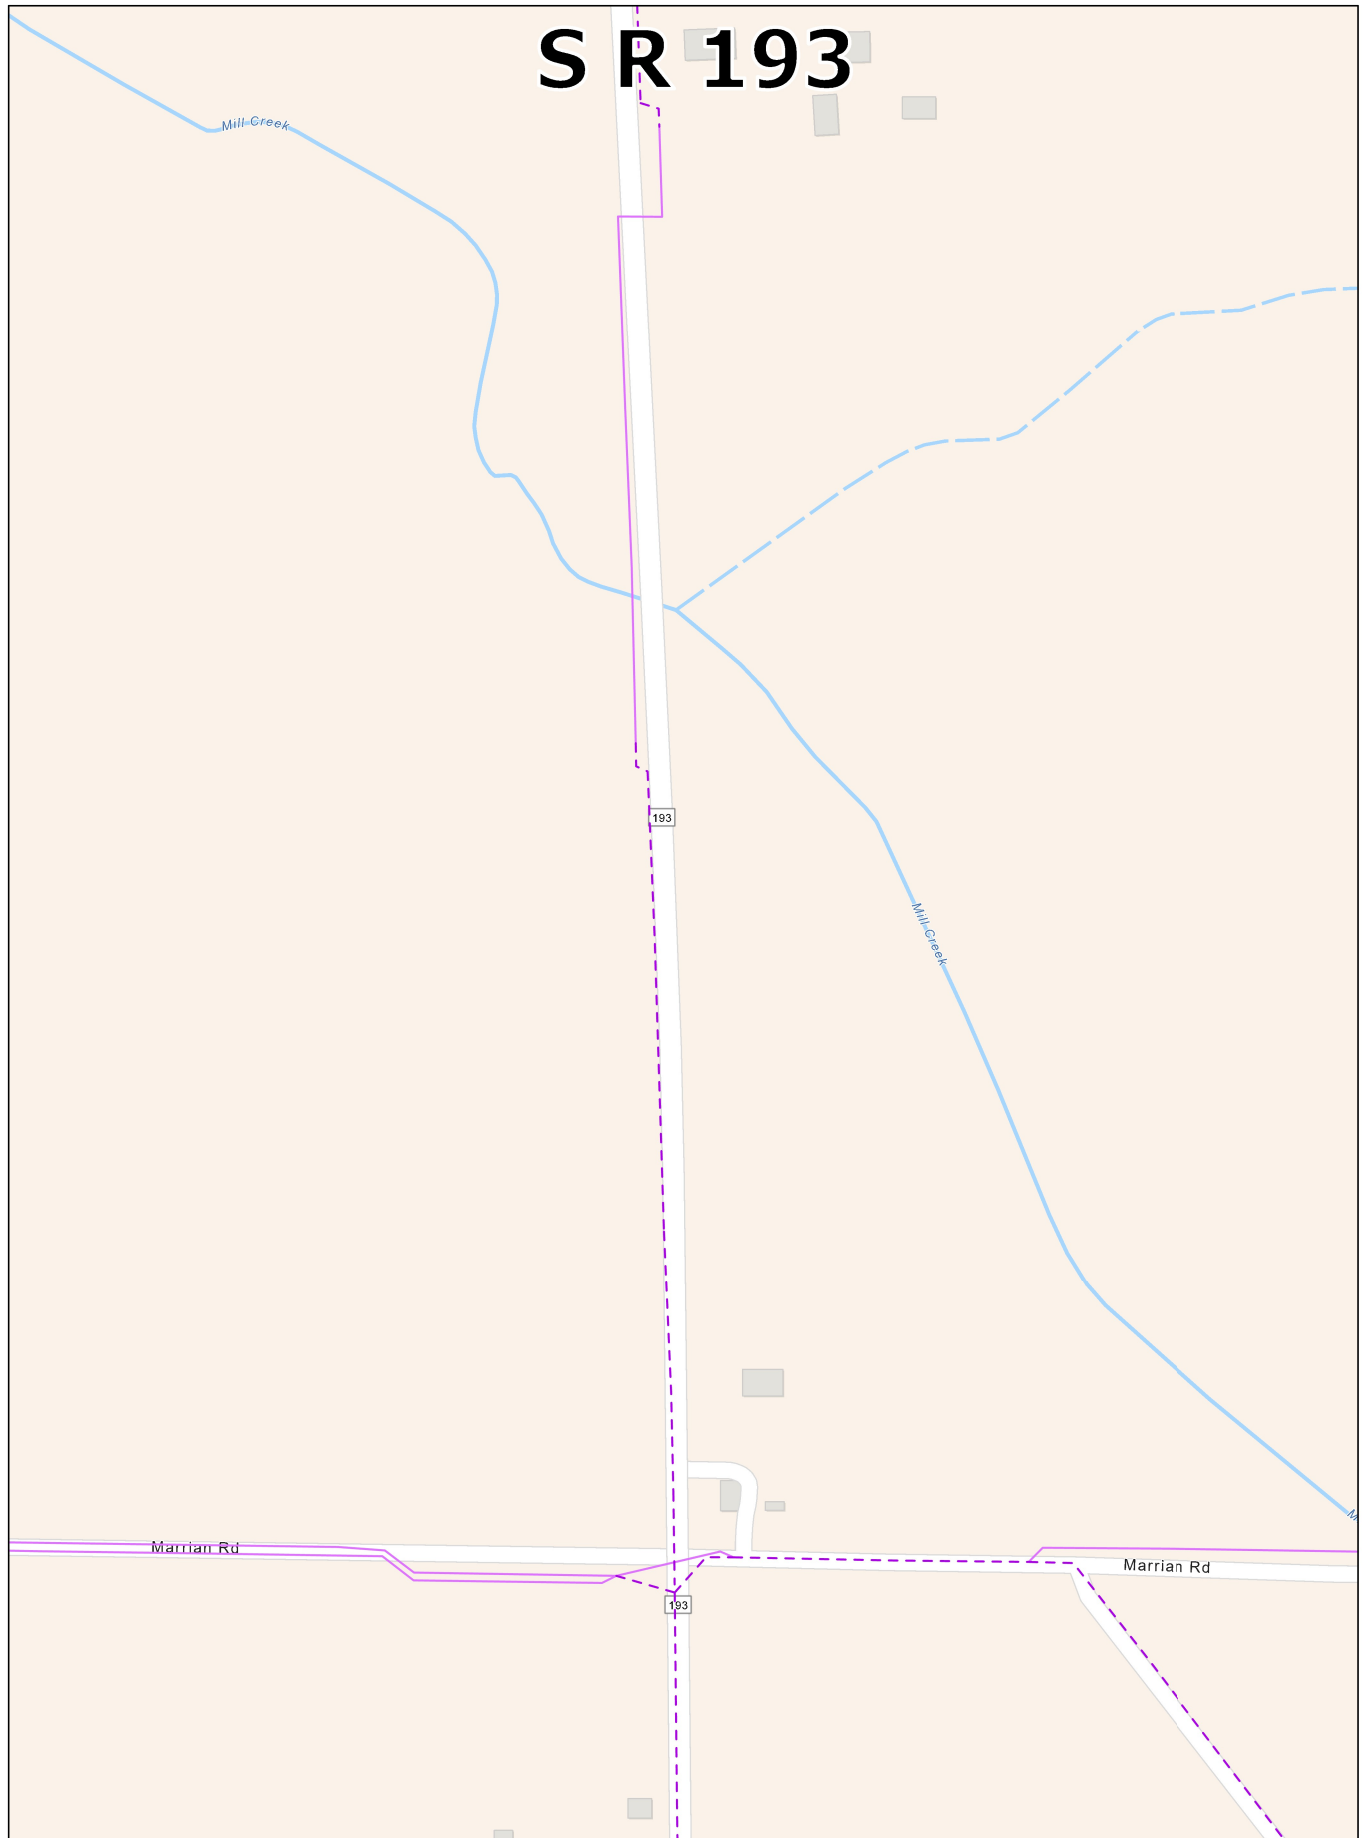

Underground Structures

Sub Type Code

- Manhole
- Handhole
- Vault
- Fiber Splices

EarthLink Fiber

symbolid

- Aerial
- Buried

Windstream CLEC Fiber

Placement Type

- Aerial
- Buried

MFS/Adesta Fiber

Placement Type

- Aerial
- Buried

Underground Structures

Sub Type Code

- Manhole

Windstream ILEC Fiber

Placement Type

- Aerial
- Buried

Windstream Copper

Placement Type

- Aerial
- Buried
- <all other values>

0 0.04 0.08 0.16 Miles

0 0.05 0.1 0.2 Kilometers