


No. 2776

N.E. 1/4 Section 23 T15 R19

Request of M H Bliggard

Dec 12<sup>th</sup> 1889

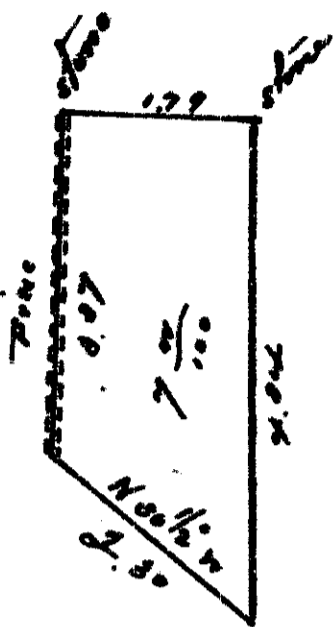

M. C. Bliggard  
Dec. 26<sup>th</sup> 1889