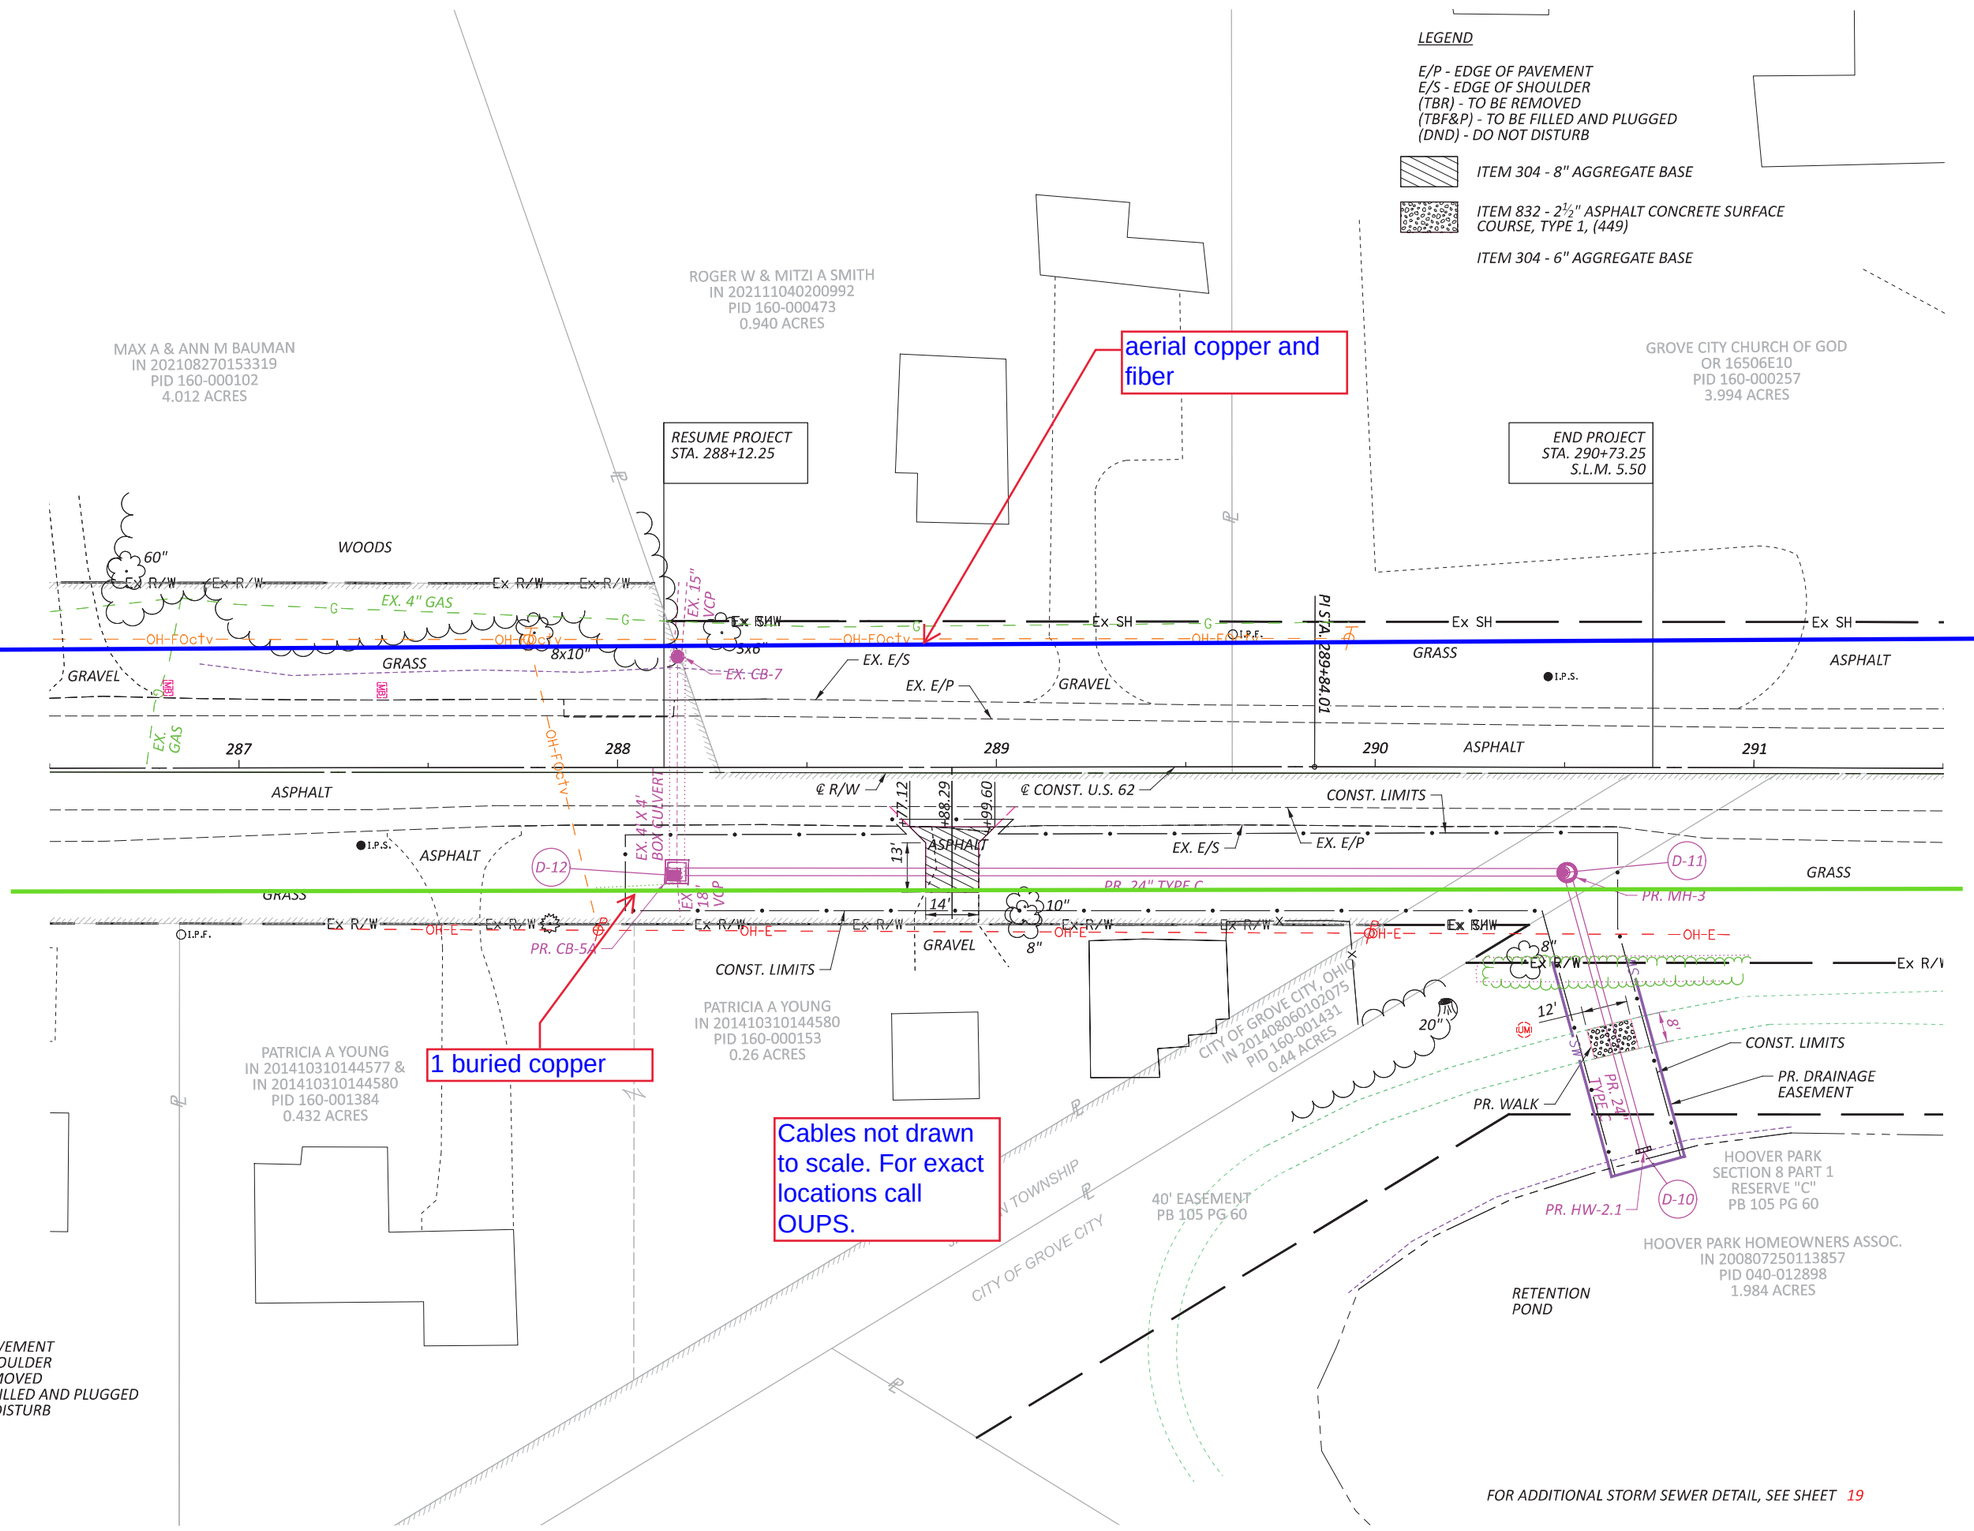

LEGEND
E/P - EDGE OF PAVEMENT
E/S - EDGE OF SHOULDER
(TBR) - TO BE REMOVED
(TBF&P) - TO BE FILLED AND PLUGGED
(DND) - DO NOT DISTURB

HORIZONTAL SCALE IN FEET 0 10 20 40

PLAN - SYSTEM C
STA. 286+50.00 TO STA. 291+50.00

DESIGN AGENCY
RESOURCE INTERNATIONAL
6350 PRESIDENTIAL GATEWAY
COLUMBUS, OHIO 43231
(614) 823-4949

DESIGNER: KSJ
REVIEWER: BBB MM-DD-YY
PROJECT ID: 119042
SHEET: P.15 TOTAL: 19

FRA-US62-4.90