

## SR 317 and Shook Rd relocate GPS – 39.830610 -82.944567

Place new 288 armored fiber areial from 39.830716 -82.946965  
To existing splice case at 39.840052 -82.943922 ( approx. 4,900')

Place new splice case at 39.830716 -82.946965

Place new strand from SCP pole at 39.830549 -82.945560

Place new strand to SCP pole at 39.830538 -82.944695

Place new 288 armored fiber to strand and go north. Then to SCP pole's to 39.832304 -82.944336

Cross Shook rd to SCP pole at 39.832366 -82.944538.

Place new ring cut splice case at 39.831046 -82.944435. Place existing 48 into new ring cut splice case.

Place 288 armored fiber to existing splice case at 39.840052 -82.943922

Place slack loop at 39.836397 -82.944211

Place anchor and down guy where needed.

Wreck out old HH at 39.830552 -82.944699

After splicing is complete wreck out old fiber and strand.

Place new 288 armored fiber to existing splice case at 39.840052 -82.943922

Place new slack loop at 39.836397 -82.944211

SP. RICHARDS COMPANY

Cross Shook Rd SCP pole at 39.832366 -82.944538

Place new splice case at 39.830716 -82.946965

Place new strand and 288 armored fiber to 39.832304 -82.944336

Place 288 armored on strand then go north.

OH-317 & Shook Rd

Google Earth





Cross Shook Rd to SCP pole  
at 39.832366 -82.944538



Place new strand and 288  
armored fiber to SCP pole at  
39.832304 -82.944336

Place new ring cut splice  
case at  
39.831046 -82.944435



Place new splice case at  
39.830716 -82.946965


Place new strand and 288  
armored fiber to SCP pole at  
39.830549 -82.945560

Place 288 armore  
then go north.

Place new strand and 288  
armored fiber to SCP pole at  
39.830538 -82.944695





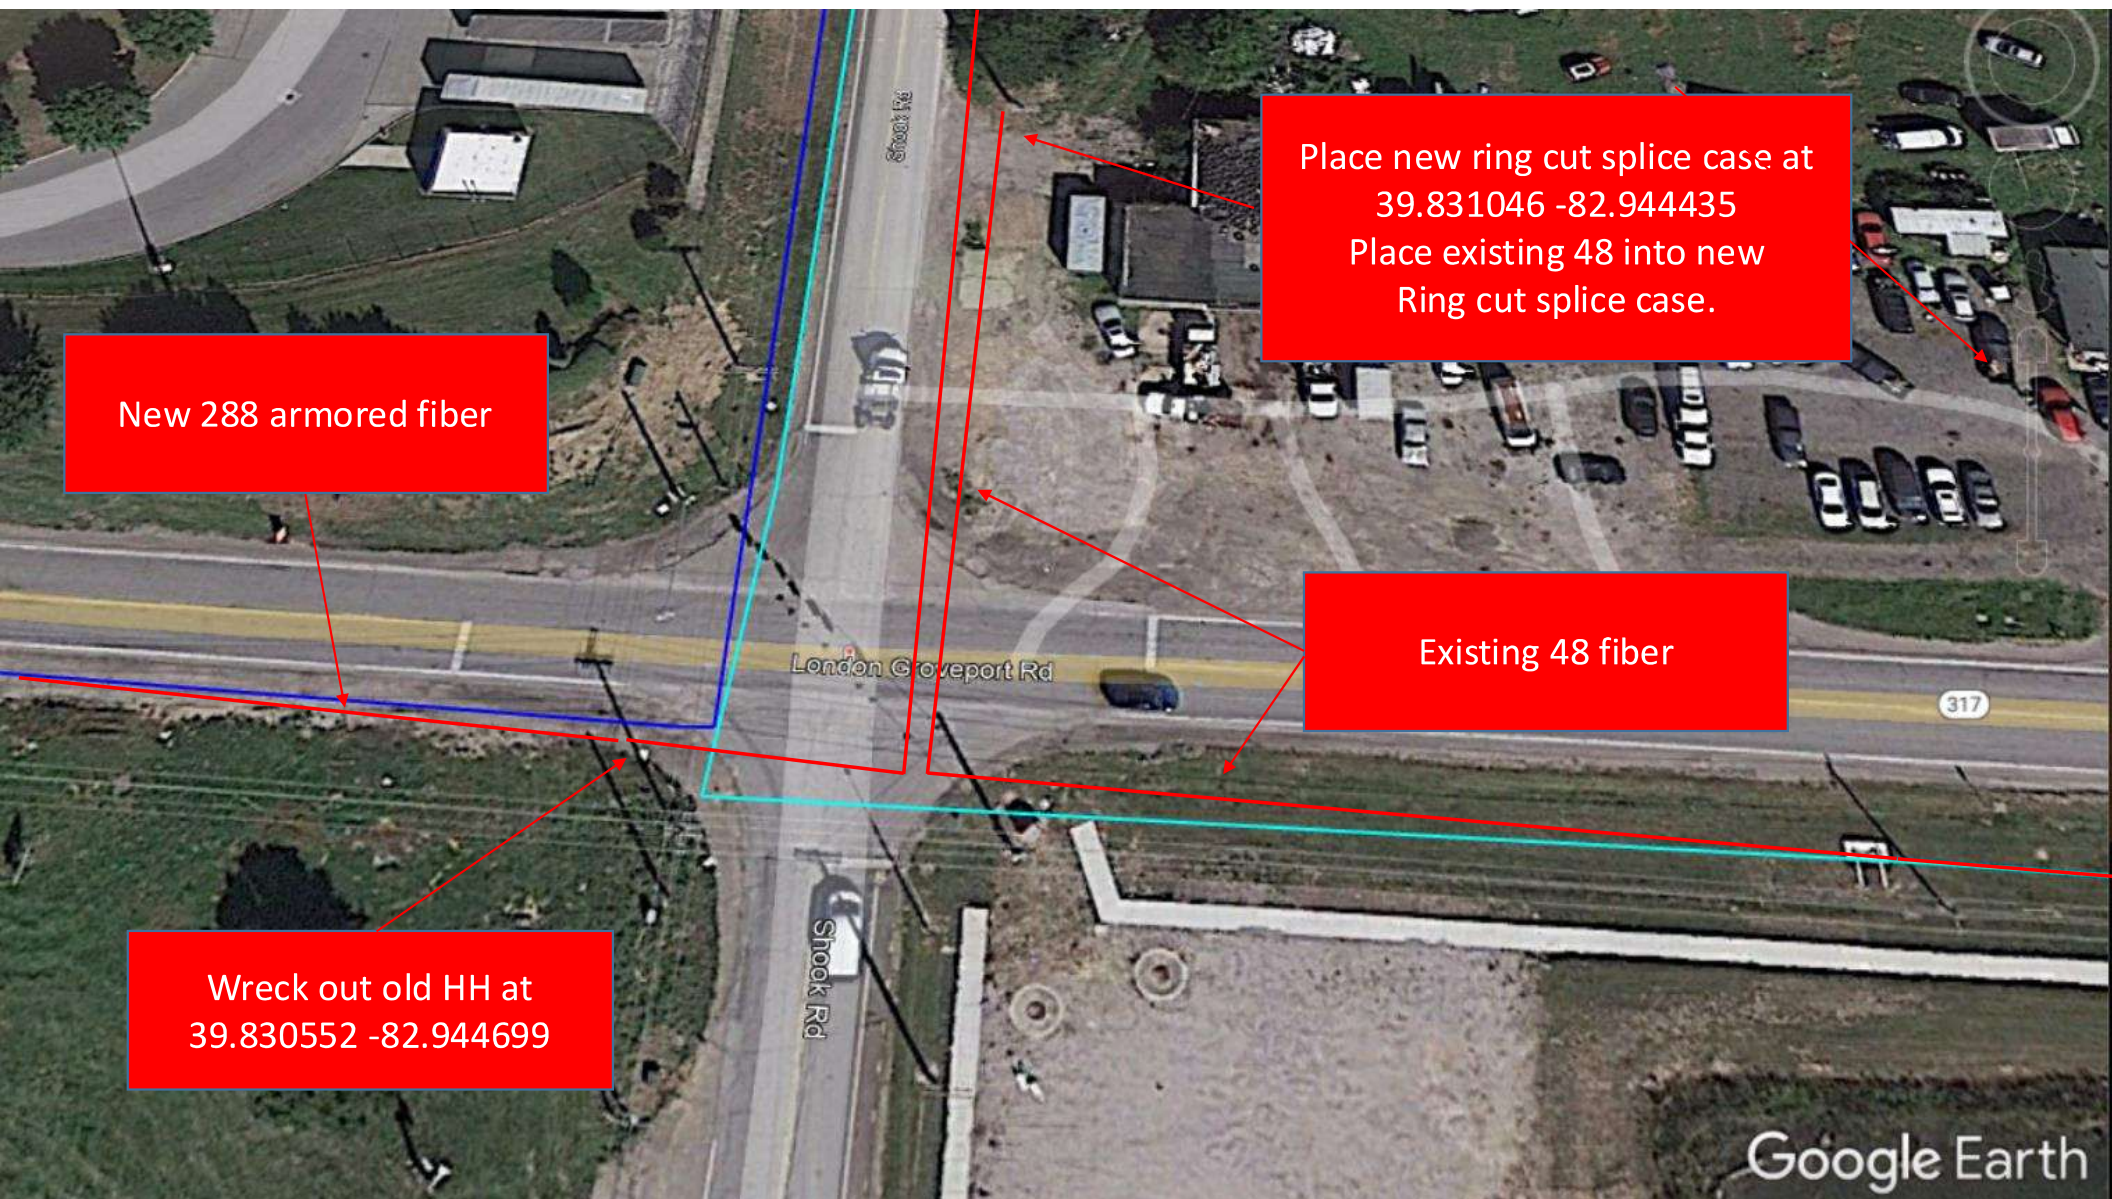

New 288 armored fiber

Place new ring cut splice case at  
39.831046 -82.944435  
Place existing 48 into new  
Ring cut splice case.

Existing 48 fiber

Wreck out old HH at  
39.830552 -82.944699

Google Earth