[illegible]

## LEGEND

FD FOUND  
STA STATION OF CENTERLINE SURVEY  
RRS RAILROAD SPIKE  
PK PARKER KAYLON NAIL  
MON BOX MONUMENT BOX ASSEMBLY / CONC. MONUMENT  
PC POINT OF CURVATURE  
PT POINT OF TANGENCY  
POT POINT ON TANGENT  
PI POINT OF INTERSECTION / ANGLE POINT  
☐ MONUMENT BOX ASSEMBLY / CONC. MONUMENT  
☐ SURVEY POINT FOUND (RRS, IP, PK, ETC.)  
☒ SURVEY POINT SET (RRS, IP, PK, ETC.)  
☐ STONE  
☐ ANGLE POINT  
P FENCE LINE  
C/L PROPERTY LINE  
CENTERLINE  
SECTION / VMS LINE  
COUNTY LINE  
TOWNSHIP LINE  
R/L RIGHT OF WAY LINE


### BASIS OF BEARINGS:

BEARINGS ARE BASED ON THE OHIO STATE PLANE COORDINATE SYSTEM, SOUTH ZONE AND NORTH AMERICAN DATUM OF 1983, (NSRS 2007), AS ESTABLISHED FROM A GPS SURVEY PERFORMED BY THE FRANKLIN COUNTY ENGINEER'S SURVEY DEPARTMENT IN 2009. ORIGINATING ON FRANKLIN COUNTY GEODETIC CONTROL MONUMENT "HAMLETONAZ".

THIS PLAT WAS PREPARED FROM AN ACTUAL FIELD SURVEY PERFORMED BY THE FRANKLIN COUNTY ENGINEER'S OFFICE, ALONG WITH PUBLIC RECORDS ON FILE IN THE FRANKLIN COUNTY RECORDER'S OFFICE AND THE FRANKLIN COUNTY ENGINEER'S OFFICE

DAVID L. PEARSON  
OHIO REGISTERED SURVEYOR NO. 7298

12/20/2011  
DATE

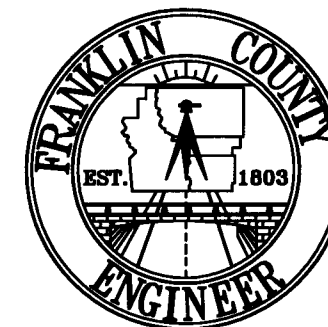

|                       |                      |                            |  |
|-----------------------|----------------------|----------------------------|--|
| <b>DATE:</b> 10-23-07 |                      | <b>DRAWING:</b> 0236-02,03 |  |
|                       |                      | <b>DRAWN BY:</b> AK        |  |
| <b>REVISIONS</b>      |                      |                            |  |
| <b>DATE</b>           | <b>DESCRIPTION</b>   | <b>BY</b>                  |  |
| 12-19                 | NSRS 2007 ADJUSTMENT | MJR                        |  |
|                       |                      |                            |  |
|                       |                      |                            |  |
|                       |                      |                            |  |
|                       |                      |                            |  |