

FUL-120-14.08

Remove this overlying text

Remove this text


INCLUDE THE ENTIRE BUSINESS NAME

LEGEND

RESURFACING AREA

D.N.D. = DO NOT DISTURB


R.B.O. = RELOCATED BY OTHERS

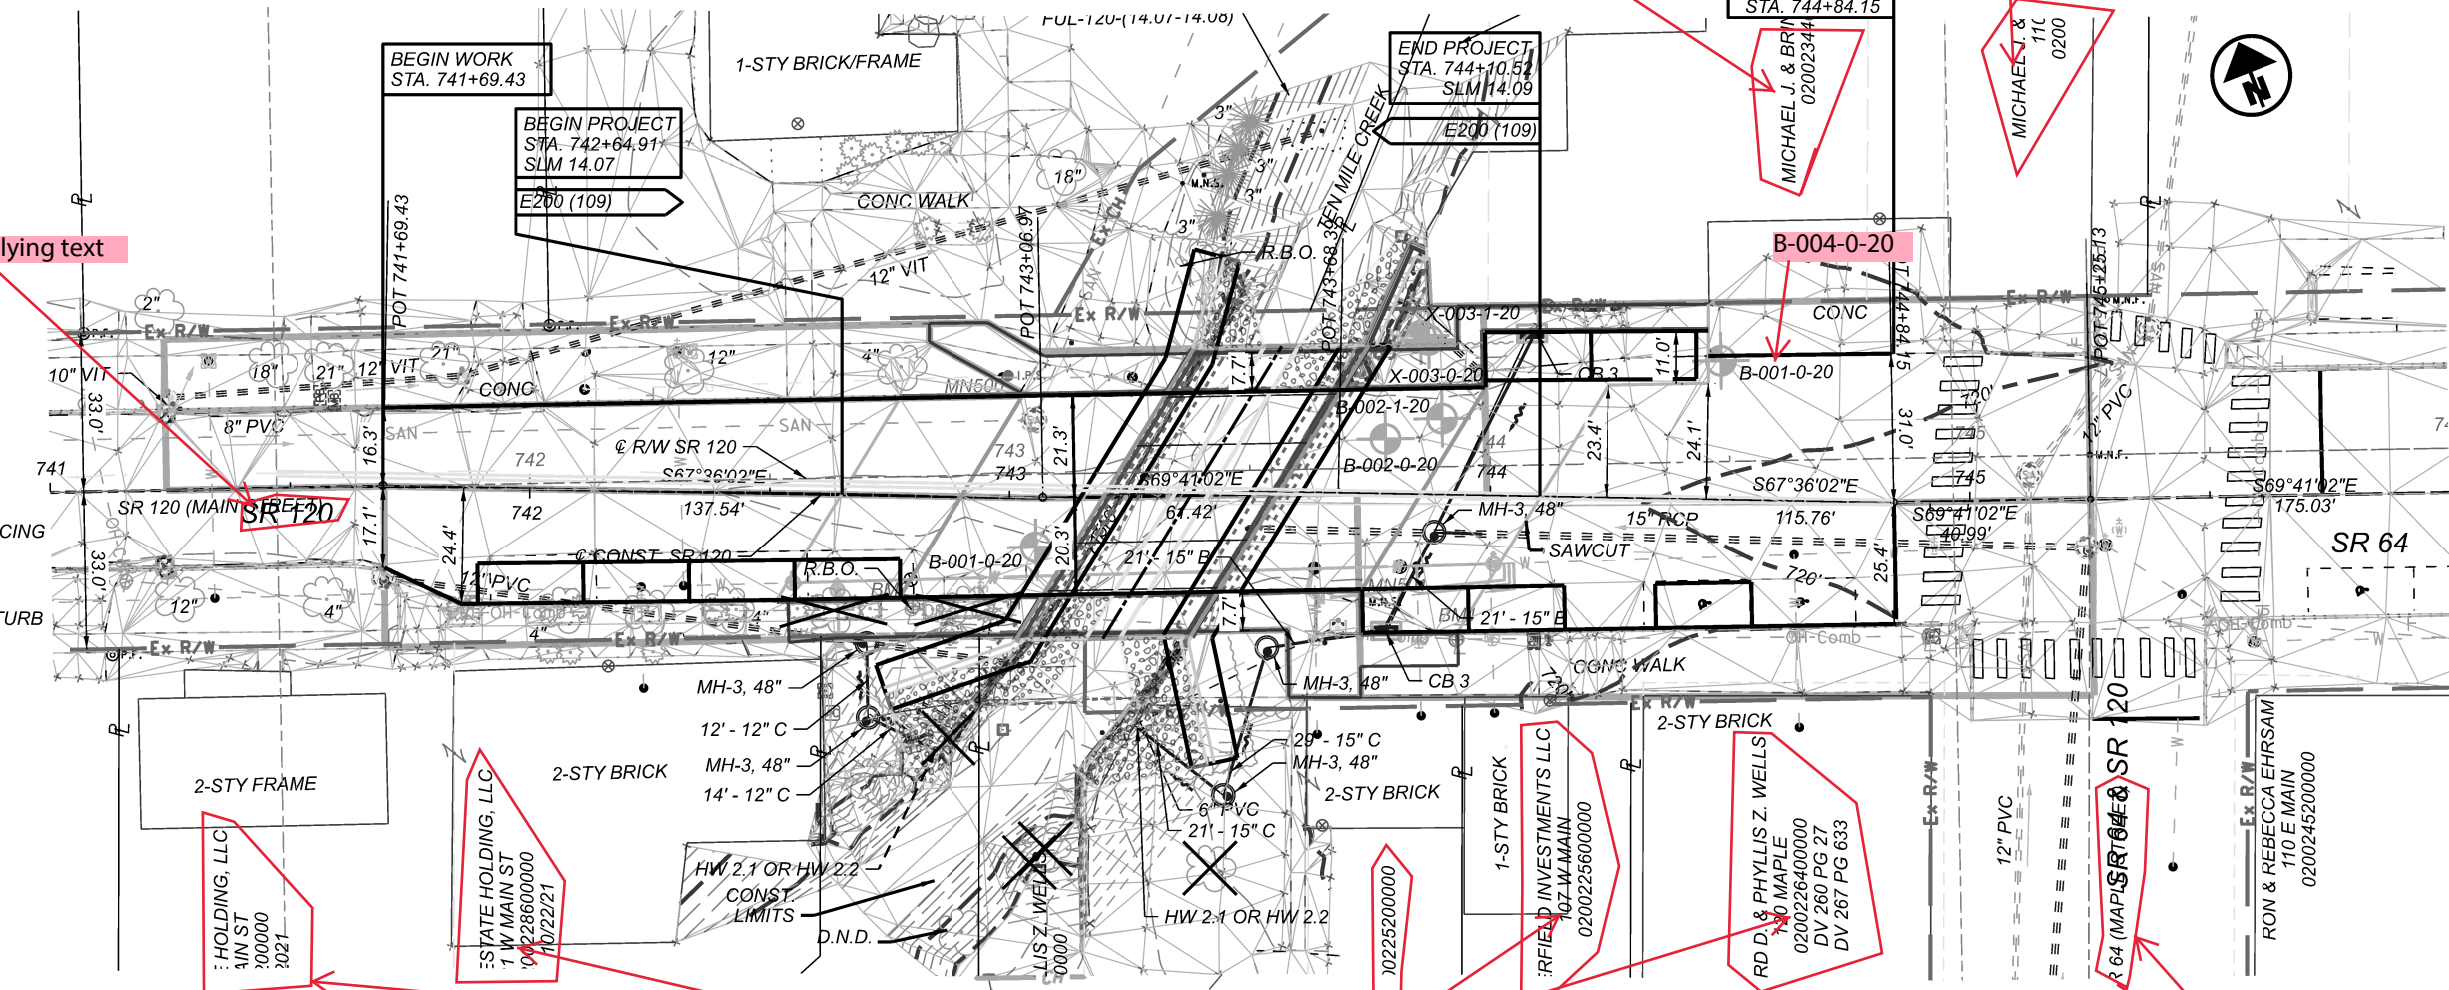

INCLUDE THE ENTIRE BUSINESS NAME

Remove this underlying text

Remove "logs"

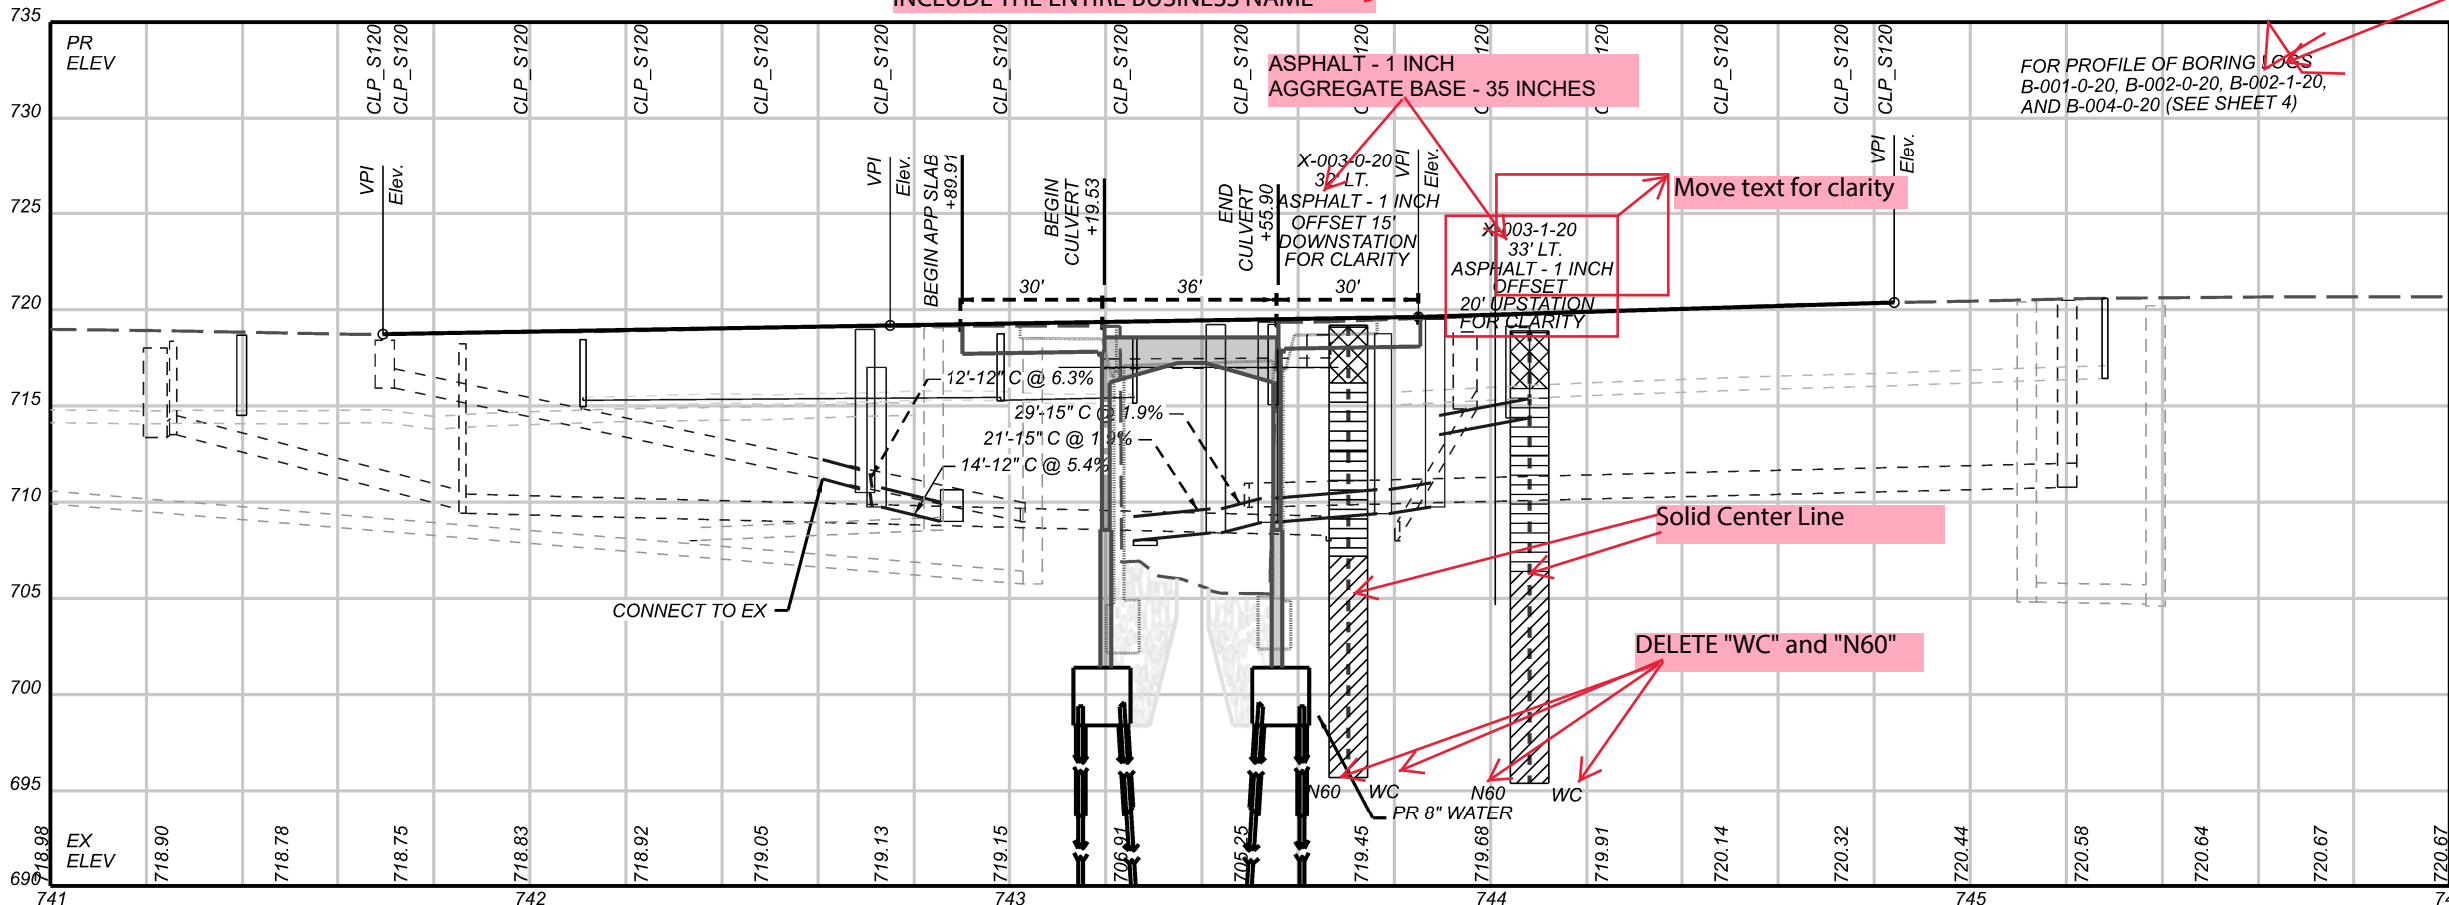

ASPHALT - 1 INCH
AGGREGATE BASE - 35 INCHES

FOR PROFILE OF BORING LOGS
B-001-0-20, B-002-0-20, B-002-1-20,
AND B-004-0-20 (SEE SHEET 4)



Move text for clarity

Solid Center Line

DELETE "WC" and "N60"

PLAN AND PROFILE - ROADWAY

STA. 742+69 TO STA. 744+10

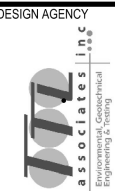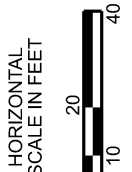

DESIGNER	TRR
REVIEWER	CPI 01/17/22
PROJECT ID	101140
SHEET	3
TOTAL	43

CPI 01/22