
LATITUDE: 39°7′44.4″ LONGITUDE: -84°36′22.1″

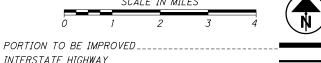

DESIGN DESIGNATION		
DESIGN DESIGNATION	8.00-10.49	10.49-12.3
CURRENT ADT (2020)	24,000	14,000
DESIGN YEAR ADT (2040)	24,000	14,000
DESIGN HOURLY VOLUME (2040)	2 <b>,</b> 200	1,300
DIRECTIONAL DISTRIBUTION	0 <b>.</b> 52	0.54
TRUCKS (24 HOUR B&C)	3%	9%
DESIGN SPEED	35	<i>35</i>
LEGAL SPEED	35	<i>35</i>
DESIGN FUNCTIONAL CLASSIFICATION:		

ENGINEER'S SEAL

RETAINING WALL

DM-1.2

DM-2.1

0M-4.3

DM-4.4

7/16/21 MT-105.10

1/18/13 MT-110.10

1/15/16

1/15/16

1/20/23

1/17/20

ADA DESIGN WAIVER NONE REQUIRED

03 PRINCIPAL ARTERIAL (URBAN)

DESIGN EXCEPTIONS
NONE REQUIRED

UNDERGROUND UTILITIES
Contact Two Working Days Before You Dig
OHIO811.org Before You Dig

NHS PROJECT ..... NO

OHIO811, 8-1-1, or 1-800-362-2764 (Non-members must be called directly)

PLAN PREPARED BY:
THE OHIO DEPARTMENT OF TRANSPORTATION
DISTRICT 8 ENGINEERING
505 S. SR 741
LEBANON, OHIO 45036

## STATE OF OHIO DEPARTMENT OF TRANSPORTATION

## HAM-SR264-10.42

### CITY OF CINCINNATI HAMILTON COUNTY

#### INDEX OF SHEETS:

TITLE SHEET	1
TYPICAL SECTIONS	2
	_
GENERAL NOTES	3 - 4
MAINTENANCE OF TRAFFIC NOTES	5 - 8
MAINTENANCE OF TRAFFIC PLAN	9 - 13
GENERAL SUMMARY	14 - 15
SUBSUMMARIES	16 - 19
PLAN AND PROFILE	20
CROSS SECTIONS	21 - 25
DRAINAGE PROFILES	26
PARKING LOT PAVEMENT DETAIL	27
TRAFFIC CONTROL PLAN	28
RETAINING WALL	29 - 32
STRUCTURE DEMOLITION PLANS	33 - 40
TEST BORING LOGS	41 - 44
RIGHT OF WAY	

#### PROJECT DESCRIPTION

REMOVAL OF BRIDGE NO. HAM-264-1044 (SFN 3111547)
OVER THE ABANDONED RAILROAD. RECONSTRUCTION
OF ROADWAY ON NEW EMBANKMENT. CONSTRUCTION
OF RETAINING WALL ON WEST SIDE OF GLENWAY
AVENUE.

#### EARTH DISTURBED AREAS

PROJECT EARTH DISTURBED AREA: 0.67 ACRES
ESTIMATED CONTRACTOR EARTH DISTURBED AREA: 0.00 ACRES
NOTICE OF INTENT EARTH DISTURBED AREA: NOI NOT
RECOURSED

#### 2023 SPECIFICATIONS

THE STANDARD SPECIFICATIONS OF THE STATE OF OHIO, DEPARTMENT OF TRANSPORTATION, INCLUDING SUPPLEMENTAL SPECIFICATIONS LISTED IN THE PLANS AND CHANGES LISTED IN THE PROPOSAL SHALL GOVERN THIS IMPROVEMENT.

I HEREBY APPROVE THESE PLANS AND DECLARE THAT THE MAKING OF THIS IMPROVEMENT WILL NOT REQUIRE THE CLOSING TO TRAFFIC OF THE HIGHWAY AND THAT PROVISIONS FOR THE MAINTENANCE AND SAFETY OF TRAFFIC WILL BE AS SET FORTH ON THE PLANS AND ESTIMATES.

DISTRICT DEPUTY DIRECTOR

APPROVED / Amela DOLLT DIRECTOR, DEPARTMENT OF TRANSPORTATION

SUPPLEMENTAL SPECIAL STANDARD CONSTRUCTION DRAWINGS SPECIFICATIONS **PROVISIONS** 1/19/24 MGS-1.1 7/19/24 800-2023 7/19/24 WATERWAY 7/16/21 TC-61.30 9/18/2024 1/19/18 TC-65.10 1/17/14 7/19/24 1/18/13 TC-65.11 MGS-4.3 1/19/24 7/19/24 RULE 513 8/18/2023 CB-2-2A,2B,2C 7/19/24 4/21/23 4/15/22 B-2-3, 2-4 7/19/24 <u>MH-3</u> 10/18/13 7/19/24 C-84.217/19/24 <u>MT-95.41</u> 7/17/20 MT-101.70 7/19/24

ENGINEER'S SEAL

ROADWAY

LUCAS
W.
BRAUN
B

ENGINEER'S SEAL

BRIDGE

CHRISTOPHER

ARON
HOWARD
E-62429
ASSONAL ENGINEERS

1 44

070 · (467

PID NO. **25349** 

ONSTRUCTION PROJECT |

NONE

RAILROAD II

-SR264-10.4

S

#### UTILITIES

LISTED BELOW ARE ALL UTILITIES LOCATED WITHIN THE PROJECT CONSTRUCTION LIMITS TOGETHER WITH THEIR RESPECTIVE OWNERS:

CINCINNATI BELL - AERIAL & PLACING 221 E. 4TH ST, BLDG. 121-900 CINCINNATI, OH 45201 513-565-6014 (ROB STROCHINSKY) ROBERT.STROCHINSKY@CINBELL.COM ROADPROJECTS@CINBELL.COM

CINCINNATI BELL - UNDERGROUND STRUCTURES
221 E 4TH STREET (BUILDING 121-900)
CINCINNATI, OH 45202
513-565-7187 - OFFICE
BRECK.COWAN@CINBELL.COM

DUKE ENERGY - ELECTRIC (DISTRIBUTION) 2010 DANA AVE CINCINNATI, OH 45207 513-508-9609 (SHANE ERHART) SHANE.ERHART@DUKE-ENERGY.COM

GREATER CINCINNATI WATER WORKS
3845 EASTERN AVE
CINCINNATI, OH 45226
513-352-3723 (DAN LOUIS)
DANIEL.LOUIS@GCWW.CINCINNATI-OH.GOV

CINCINNATI STORMWATER MANAGEMENT UTILITY
4747 SPRING GROVE AVENUE
CINCINNATI, OH 45232
513-591-7746 (ROB GOODPASTER)
ROBERT.GOODPASTER@CINCINNATI-OH.GOV
SMUPLANREVIEW@CINCINNATI-OH.GOV

CINCINNATI METROPOLITAN SEWER DISTRICT 1600 GEST STREET CINCINNATI, OH 45204 513-557-7188 (ROB FRANKLIN) MSDUTILITYREVIEW@CINCINNATI-OH.GOV

DUKE ENERGY GAS 139 EAST 4TH ST., ROOM 460A CINCINNATI, OH 45202 OH/KYHOUSEBILL@DUKE-ENERGY.COM

CITY OF CINCINNATI TRAFFIC 801 PLUM ST, ROOM 320 CINCINNATI, OH 45202 513-352-3730 (LINDA KISER) LINDA KISER@CINCINNATI-OH.GOV

#### ITEM 840 - MECHANICALLY STABILIZED EARTH WALL, AS PER PLAN

COVER THE JOINTS AND THE INTERSECTION OF THE MSE WALL AND THE EXISTING ABUTMENT WITH ITEM 204 - GEOTEXTILE FABRIC. EXTEND THE GEOTEXTILE FABRIC A MINIMUM OF 3 FT. FROM THE WALL INTERSECTION IN EACH DIRECTION. SEE SHEET 30 FOR DETAILS. ALL OTHER REQUIREMENTS OF SS 840 APPLY. THE LABOR, EQUIPMENT AND MATERIALS TO INSTALL THE GEOTEXTILE AT THE WALL INTERSECTION IS INCLUDED IN THE LUMP SUM PAY ITEM FOR SS 840 MECHANICALLY STABILIZED EARTH WALL, AS PER PLAN.

#### SURVEYING PARAMETERS

PRIMARY PROJECT CONTROL MONUMENTS GOVERN ALL POSITION-ING ON ODOT PROJECTS. SEE SHEET 3\_ OF THE PLANS FOR A TABLE CONTAINING PROJECT CONTROL INFORMATION.

USE THE FOLLOWING PROJECT CONTROL, VERTICAL POSITIONING, AND HORIZONTAL POSITIONING PARAMETERS FOR ALL SURVEYING:

PROJECT CONTROL

POSITIONING METHOD: STATIC OPUS SOLUTION AND VRS MONUMENT TYPE: IRON PINS

VERTICAL POSITIONING

ORTHOMETRIC HEIGHT DATUM: NAVD88 GEOID: GEOID12A MOUNT POINT 2011

HORIZONTAL POSITIONING

REFERENCE FRAME: NAD83 (NSR2011)
ELLIPSOID: GRS80
MAP PROJECTION: LAMBERT CONFORMAL CONIC
COORDINATE SYSTEM: OHIO STATE PLANE SOUTH ZONE (SPC 3402)
COMBINED SCALE FACTOR: 1.000000 (GROUND TO GRID)
ORIGIN OF COORDINATE
SYSTEM: 0,0

USE THE POSITIONING METHODS AND MONUMENT TYPE USED IN THE ORIGINAL SURVEY TO RESTORE ALL MONUMENTS RELATED TO PRIMARY PROJECT CONTROL THAT ARE DAMAGED OR DESTROYED BY CONSTRUCTION ACTIVITIES. RESTORE THE DAMAGED OR DESTROYED MONUMENTS IN ACCORDANCE WITH CMS 623.

UNITS ARE IN U.S. SURVEY FEET. USE THE FOLLOWING CONVERSION FACTOR: 1 METER = 3.2808333333 U.S. SURVEY FEET.

#### **WORK LIMITS**

THE WORK LIMITS SHOWN ON THESE PLANS ARE FOR PHYSICAL CONSTRUCTION ONLY. PROVIDE THE INSTALLATION AND OPERATION OF ALL WORK ZONE TRAFFIC CONTROL AND WORK ZONE TRAFFIC CONTROL DEVICES REQUIRED BY THESE PLANS WHETHER INSIDE OR OUTSIDE THESE WORK LIMITS.

#### CLEARING AND GRUBBING

ALTHOUGH THERE ARE NO TREES OR STUMPS SPECIFICALLY MARKED FOR REMOVAL WITHIN THE LIMITS OF THE PROJECT, A LUMP SUM QUANTITY IS INCLUDED IN THE GENERAL SUMMARY FOR ITEM 201, CLEARING AND GRUBBING. ALL PROVISIONS AS SET FORTH IN THE SPECIFICATIONS UNDER THIS ITEM ARE INCLUDED IN THE LUMP SUM PRICE BID FOR ITEM 201, CLEARING AND GRUBBING.

MANAMANA

#### CONSTRUCTION ACTIVITY RESTRICTIONS

THE CONDITION OF THE EXISTING 36" STORM SEWER UNDER THE BRIDGE IS UNKNOWN. TO AVOID DAMAGE THE SEWER PIPE, THE CONTRACTOR SHALL AVOID PLACEMENT OF EQUIPMENT, MATERIALS OR DEMOLITION DEBRIS WITHIN FOUR FEET OF EITHER SIDE OF THE STORM SEWER. ANY DAMAGE TO THE STORM SEWER SHALL BE REPAIRED AT THE CONTRACTOR'S COST.

#### SEEDING AND MULCHING

THE FOLLOWING QUANTITIES ARE PROVIDED TO PROMOTE GROWTH AND CARE OF PERMANENT SEEDED AREAS:

- 659, TOPSOIL 109 CU. YD.
- 659, SEEDING AND MULCHING 980 SQ. YD.
- 659, REPAIR SEEDING AND MULCHING 49 SQ. YD
- 659, COMMERCIAL FERTILIZER 0.13 TON
- 659. LIME 0.20 ACRES
- 659, WATER 5.4 M. GAL.

SEEDING AND MULCHING SHALL BE APPLIED TO ALL AREAS OF EXPOSED SOIL BETWEEN THE RIGHT-OF-WAY LINES, AND WITHIN THE CONSTRUCTION LIMITS FOR AREAS OUTSIDE THE RIGHT-OF-WAY LINES COVERED BY WORK AGREEMENT OR SLOPE EASEMENT. QUANTITY CALCULATIONS FOR SEEDING AND MULCHING ARE BASED ON THESE LIMITS.

#### ROUNDING

THE ROUNDING AT SLOPE BREAKPOINTS SHOWN ON THE TYPICAL SECTIONS APPLIES TO ALL CROSS-SECTIONS EVEN THOUGH OTHERWISE SHOWN.

#### ITEM 203 - EMBANKMENT, AS PER PLAN

PROVIDE SELECT GRANULAR BACKFILL MEETING THE REQUIREMENT OF SS 840 FOR ALL EMBANKMENT PLACED FROM THE REAR OF THE MSE WALL PANELS TO THE PHASE I BRIDGE REMOVAL LIMITS. PLACE THE SELECT GRANULAR BACKFILL PER ITEM 203. THE CROSS-SECTIONS ILLUSTRATE THE LIMITS OF THE SELECT GRANULAR BACKFILL INCLUDED WITH THIS PAY ITEM.

#### ITEM 867 - TEMPORARY WIRE FACED MECHANICALLY STABILIZED EARTH WALL. AS PER PLAN

COVER THE JOINTS AND THE INTERSECTION OF THE TEMPORARY MSE WALL AND THE EXISTING ABUTMENT WITH ITEM 204 - GEOTEXTILE FABRIC. ATTACH THE GEOTEXTILE FABRIC TO THE EXISTING ABUTMENT WITH ADHESIVE THAT SECURES THE GEOTEXTILE IN PLACE DURING CONSTRUCTION. EXTEND THE GEOTEXTILE FABRIC A MINIMUM OF 3 FT. FROM THE WALL INTERSECTION IN EACH DIRECTION SEE SHEET 32 FOR DETAILS. ALL OTHER REQUIREMENTS OF SS 867 APPLY. THE LABOR, EQUIPMENT AND MATERIALS TO INSTALL THE GEOTEXTILE AT THE WALL INTERSECTION IS INCLUDED IN THE LUMP SUM PAY ITEM FOR SS 867 TEMPORARY WIRE FACED MECHANICALLY STABILIZED EARTH WALL, AS PER PLAN.

#### MONUMENT ASSEMBLIES

CONSTRUCT MONUMENT ASSEMBLIES IN ACCORDANCE WITH THE DETAILS SHOWN ON THE STANDARD CONSTRUCTION DRAWINGS AND AT THE LOCATIONS SHOWN ON THE RIGHT OF WAY PLANS. THE FOLLOWING QUANTITIES ARE CARRIED TO THE GENERAL SUMMARY.

ITEM 623 - MOMUMENT ASSEMBLY, TYPE C

#### CONNECTION BETWEEN EXISTING AND PROPOSED GUARDRAIL

WHEN IT IS NECESSARY TO SPLICE PROPOSED GUARDRAIL TO EXISTING GUARDRAIL, ONLY THE EXISTING GUARDRAIL SHALL BE CUT, DRILLED, OR PUNCHED. THE CONNECTION SHALL BE MADE USING A W-BEAM, BEAM SPLICE AS SHOWN IN AASHTO M 180-12, EXCEPT THE BEAM WASHERS ARE NOT TO BE USED. PAYMENT SHALL BE INCLUDED IN THE CONTRACT PRICE FOR THE RESPECTIVE GUARDRAIL ITEMS.

#### ITEM 611 - CATCH BASIN GRATE

NEW GRATE PER SCD CB-3A SHALL BE ADDED TO CATCH BASIN AT STA. 52+09.40, 84.8' RT.

#### ITEM 204 - SUBGRADE COMPACTION AND PROOF ROLLING

CONSTRUCT THE SUBGRADE AS FOLLOWS AND IN THE FOLLOWING SEQUENCE:

- 1. SHAPE THE SUBGRADE TO WITHIN 0.2 FEET OF THE PLAN SUBGRADE ELEVATION.
- 2. EXCAVATE AND REPLACE UNSUITABLE SUBGRADE BEFORE PROOF ROLLING. THE EXCAVATION LIMITS ARE SHOWN AND LABELED ON THE CROSS SECTIONS AS UNSUITABLE SUBGRADE. UNSUITABLE SUBGRADE INCLUDES UNSUITABLE SOIL (A-4B, A-2-5, A-5, A-7-5, AND SOIL WITH A LIQUID LIMIT GREATER THAN 65) AND ANY COAL, SHALE, OR ROCK WHICH NEEDS TO BE REMOVED ACCORDING TO SECTION 204.05 OF THE CONSTRUCTION AND MATERIAL SPECIFICATIONS (C&MS).

IF THERE IS UNSUITABLE SUBGRADE IN A SHALLOW FILL LOCATION, EXCAVATE AND REPLACE THE UNSUITABLE SUBGRADE BEFORE CONSTRUCTING THE SHALLOW FILL AND SHAPING THE SUBGRADE.

- 3. COMPACT THE SUBGRADE ACCORDING TO C&MS 204.03.
- 4. APPROXIMATE LIMITS FOR EXCAVATION OF UNSTABLE SUBGRADE ARE SHOWN AND LABELED ON THE CROSS SECTIONS AS UNSTABLE SUBGRADE. THE ENGINEER WILL IDENTIFY THE ACTUAL LIMITS OF EXCAVATION FOR UNSTABLE SUBGRADE BASED ON THE PROOF ROLLING RESULTS AND VISUAL OBSERVATIONS.

PROOF ROLL THE COMPACTED SUBGRADE ACCORDING TO C&MS 204.06.

- 5. EXCAVATE UNSTABLE SUBGRADE AS DIRECTED BY THE ENGINEER AND STABILIZE BY REPLACING WITH THE SPECIFIED MATERIALS ACCORDING TO C&MS 204.07. EXCAVATIONS WILL EXTEND 18 INCHES BEYOND THE EDGE OF THE SURFACE OF THE PAVEMENT, PAVED SHOULDERS, OR PAVED MEDIANS.
- 6. PROOF ROLL THE STABILIZED AREAS ACCORDING TO C&MS 204.06 TO VERIFY STABILITY.
- 7. FINE GRADE THE SUBGRADE TO THE SPECIFIED GRADE.

THE QUANTITIES FOR EXCAVATING THE UNSUITABLE SUBGRADE AND UNSTABLE SUBGRADE ARE BOTH PAID UNDER ITEM 204, EXCAVATION OF SUBGRADE.

#### PROJECT CONTROL

Point	North	East	Elevation	Station	Offset	Feature
SV2	418052.64	1371056.59	864.77	551+84.84	79.07	CUTS
SV3	417962.70	1371124.86	890.76	552+88.28	34.48	CUTS
SV4	418240.68	1371129.83	<i>887.25</i>	550+30.03	-50.47	CUTS

5 EACH

I

ш

⋖

 $\alpha$ 

0

Z

⋖

Z

Ш

 $\vdash$ 

NA

Σ

# I

PHASE 1

SEQUENCE OF CONSTRUCTION

CONTRACTOR SHALL PERFORM ALL WORK ON THE WEST SIDE OF SR 264. CONSTRUCT TEMPORARY WALL AT BRIDGE SAWCUT LINE. REPLACE EXISITNG SIDEWALK ON WEST SIDE OF SR 264 WITH ITEM 615 - PAVEMENT FOR MAINTAINING TRAFFIC, CLASS B FOR PHASE 2 CONSTRUCTION. CONTRACTOR SHALL MAINTAIN ONE LANE OF TRAFFIC IN EACH DIRECTION AT ALL TIMES. LANES SHALL BE A MINIMUM OF 11 FEET WIDTH WITH A 2' SHOULDER ON EACH SIDE WITH PORTABLE CONCRETE BARRIER PER SCD MT-101.90. SIGNAL HEADS TO BE MOVED TO LINE UP WITH NEW LANE CONFIGURATION.

#### PHASE 2

 $\bigcirc$ 

 $\bigcirc$ 

 $\bigcirc$ 

CONTRACTOR SHALL PERFORM ALL WORK ON THE EAST SIDE OF SR 264. TEMPORARY WALL CONSTRUCTED IN PHASE 1 TO REMAIN IN PLACE AT BRIDGE SAWCUT LINE. REMOVE PORTIONS OF THE WIRE WALL THAT CONFLICT WITH PERMANENT ITEMS AS NECESSARY. CONTRACTOR SHALL MAINTAIN ONE LANE OF TRAFFIC IN EACH DIRECTION AT ALL TIMES. LANES SHALL BE A MINIMUM OF 11 FEET WIDTH WITH A 1' SHOULDER ON EACH SIDE WITH PORTABLE CONCRETE BARRIER PER SCD MT-101.90. SIGNAL HEADS TO BE MOVED TO LINE UP WITH NEW LANE CONFIGURATION.

#### PHASE 3

TRAFFIC SHALL SWITCH BACK TO PHASE 1 TRAFFIC PATTERN. CONTRACTOR SHALL CONSTRUCT SIDEWALK AND GUARDRAIL ON THE WEST SIDE OF SR 264. CONTRACTOR SHALL MAINTAIN ONE LANE OF TRAFFIC IN EACH DIRECTION AT ALL TIMES. LANES SHALL BE A MINIMUM OF 11 FEET WIDTH WITH A 2' SHOULDER ON EACH SIDE WITH PORTABLE CONCRETE BARRIER PER SCD MT-101.90. SIGNAL HEADS TO BE MOVED TO LINE UP WITH NEW LANE CONFIGURATION.

#### PHASE 4

CONTRACTOR SHALL COMPLETE ALL STRIPING AND SIGNAGE. SIGNAL HEADS TO BE MOVED TO ORIGINAL CONFIGURATION.

#### WORK ZONE MARKINGS AND SIGNS

THE FOLLOWING ESTIMATED QUANTITIES HAVE BEEN CARRIED TO THE GENERAL SUMMARY FOR USE AT LOCATIONS IDENTIFIED BY THE ENGINEER FOR WORK ZONE PAVEMENT MARKINGS AND SIGNS PER THE REQUIREMENTS OF C&MS 614.04 AND 614.11.

#### PHASE 4 (PROPOSED CONFIGURATION)

17	EM 614,	WORK ZONE	LANE LINE, CL.	ASS III 4",	642	.0.27 MILE
17	EM 614,	WORK ZONE	CENTER LINE,	CLASS III,	642	.0.17 MILE
17	EM 614,	WORK ZONE	DOTTED LINE,	CLASS III,	4", 642	319 FT
17	EM 614,	WORK ZONE	STOP LINE, CL	ASS III, 64	12	110 FT
17	EM 614.	WORK ZONE	CHANNELIZING	LINE. CLAS	S III. 12". 642	120 FT

#### ITEM 614, MAINTAINING TRAFFIC

A MINIMUM OF 1 LANE OF TRAFFIC IN EACH DIRECTION SHALL BE MAINTAINED AT ALL TIMES BY USE OF THE EXISTING PAVEMENT, THE COMPLETED PAVEMENT, AND ITEM 615 PAVEMENT FOR MAINTAINING TRAFFIC. SHORT TERM LANE CLOSURE DURING PRE-PHASE 1 AND PHASE 4 SHALL FOLLOW UNAUTHORIZED LANE USE TABLE ON THIS SHEET.

ALL EXISTING LANES SHALL BE OPEN TO TRAFFIC IN ORIGINAL OR PROPOSED FINAL ALIGNMENT BETWEEN NOVEMBER 1 AND APRIL 1. SHOULD THE CONTRACTOR FAIL TO MEET THESE REQUIREMENTS, A DISINCENTIVE SHALL BE ASSESSED IN THE AMOUNT OF \$35,000 PER CALENDAR DAY.

NO WORK SHALL BE PERFORMED AND ALL EXISTING LANES SHALL BE OPEN TO TRAFFIC DURING THE FOLLOWING DESIGNATED HOLIDAYS OR EVENTS:

FOURTH OF JULY CHRISTMAS NEW YEAR'S LABOR DAY MEMORIAL DAY THANKSGIVING

THE PERIOD OF TIME THAT THE LANES ARE TO BE OPEN DEPENDS ON THE DAY OF THE WEEK ON WHICH THE HOLIDAY OR EVENT FALLS. THE FOLLOWING SCHEDULE SHALL BE USED TO DETERMINE THIS PERIOD:

DAY OF HOLIDAY TIME ALL LANES MUST BE OPEN TO TRAFFIC OR EVENT

12:00N FRIDAY THROUGH 6:00AM MONDAY SUNDAY 12:00N FRIDAY THROUGH 6:00AM TUESDAY MONDAY TUESDAY 12:00N MONDAY THROUGH 6:00AM WEDNESDAY WEDNESDAY 12:00N TUESDAY THROUGH 6:00AM THURSDAY THURSDAY 12:00N WEDNESDAY THROUGH 6:00AM FRIDAY THURSDAY (THANKSGIVING ONLY)

6:00AM WEDNESDAY THROUGH 6:00AM MONDAY FRIDAY 12:00N THURSDAY THROUGH 6:00AM MONDAY SATURDAY 12:00N FRIDAY THROUGH 6:00AM MONDAY

SHOULD THE CONTRACTOR FAIL TO MEET ANY OF THESE REQUIREMENTS, THE CONTRACTOR SHALL BE ASSESSED A DISINCENTIVE PER THE LANE VALUE CONTRACT (PN 127).

LENGTH AND DURATION OF LANE CLOSURES AND RESTRICTIONS SHALL BE AT THE APPROVAL OF THE ENGINEER. IT IS THE INTENT TO MINIMIZE THE IMPACT TO THE TRAVELING PUBLIC. LANE CLOSURES OR RESTRICTIONS OVER SEGMENTS OF THE PROJECT IN WHICH NO WORK IS ANTICIPATED WITHIN A REASONABLE TIME FRAME, AS DETERMINED BY THE ENGINEER, SHALL NOT BE PERMITTED. THE LEVEL OF UTILIZATION OF MAINTENANCE OF TRAFFIC DEVICES SHALL BE COMMENSURATE WITH THE WORK IN PROGRESS.

PEDESTRIAN TRAFFIC TO BE DETOURED PER SCD MT-110.10. ADD M4-9B-30 SIGNAGE PER DETOUR TO ANOTHER FACILITY PER SCD MT-110.10. DETOUR SHALL FOLLOW GLENWAY AVENUE AND CROSS AT CROSSWALK AT INTERSECTION OF NOVA AVE. DETOUR TO THEN FOLLOW THE EAST SIDE OF GLENWAY AVE. TO GLENHILLS WAY AND CROSS AT THE CROSSWALK AT GLENHILLS WAY AND BOUDINOT AVE. DETOUR THEN FOLLOWS BOUDINOT AVE. AND CROSSES AT THE CROSSWALK AT BOUDINOT/CROOKSHANK AT GLENWAY. REVERSE DIRECTION FOR OPPOSITE SIDE OF CLOSURE. ALL WORK AND TRAFFIC CONTROL DEVICES SHALL BE IN ACCORDANCE WITH C&MS 614 AND OTHER APPLICABLE PORTIONS OF THE SPECIFICATIONS, AS WELL AS THE OHIO MANUAL OF UNIFORM TRAFFIC CONTROL DEVICES, PAYMENT FOR ALL LABOR, EQUIPMENT AND MATERIALS SHALL BE INCLUDED IN THE LUMP SUM CONTRACT PRICE FOR ITEM 614. MAINTAINING TRAFFIC, UNLESS SEPARATELY ITEMIZED IN THE PLAN.

#### PERMITTED LANE CLOSURE TIMES

SHORT TERM LANE CLOSURES ARE THOSE WHICH ARE PERMITTED BY THE PERMITTED LANE CLOSURE NOTE. THESE TIMES SHALL NOT BE REVISED WITHOUT PRIOR APPROVAL FROM THE DISTRICT 8 WORK ZONE TRAFFIC CONTROL MANAGER. SHORT TERM LANE CLOSURES SHALL ONLY BE IMPLEMENTED WHEN WORK IS BEING CONTINUOUSLY PERFORMED IN THE LANE. THE CLOSURE SHALL BE REMOVED AS SOON AS POSSIBLE AFTER WORK HAS STOPPED. PERMITTED LANE CLOSURES SHALL ONLY BE ALLOWED DURING THE TIMES SPECIFIED IN THE UNAUTHORIZED LANE USE TABLE INCLUDED IN THESE PLANS. NO LANE OR SHOULDER CLOSURE SHALL BE IN PLACE WHEN NO WORK IS BEING PERFORMED.

LALALIT		CE TABLE	
UNAUT	HORIZED LANE U	SE TABLE	
DESCRIPTION OF CRITICAL LANE/RAMP TO BE MAINTAINED	PERMITTED TIME PERIOD	TIME UNIT	DISINCENTIVE \$ PER TIME UNIT
SR 264 EB:			
MAINTAIN ONE LANE OF TRAFFIC IN EACH DIRECTION	ALL TIMES	1 MINUTE PERIOD	<b>\$</b> 105
SR 264 WB:			
MAINTAIN ONE LANE OF TRAFFIC IN EACH DIRECTION	6 PM to 12 PM	1 MINUTE PERIOD	<b>\$</b> 105
SR264 <b>:</b>			
MAINTAIN ONE LANE OF TWO-WAY TRAFFIC USING A FLAGGER.	10 PM to 6 AM	1 MINUTE PERIOD	<b>#</b> 210

#### TRENCH FOR WIDENING

TRENCH EXCAVATION FOR BASE WIDENING SHALL BE ONLY ON ONE SIDE OF THE PAVEMENT AT A TIME. THE OPEN TRENCH SHALL BE ADEQUATELY MAINTAINED AND PROTECTED WITH DRUMS OR BARRICADES AT ALL TIMES. PLACEMENT OF PROPOSED SUBBASE AND BASE MATERIAL SHALL FOLLOW AS CLOSELY AS POSSIBLE BEHIND EXCAVATION OPERATIONS. THE LENGTH OF WIDENING TRENCH WHICH IS OPEN AT ANY ONE TIME SHALL BE HELD TO A MINIMUM AND SHALL AT ALL TIMES BE SUBJECT TO APPROVAL OF THE ENGINEER.

#### OVERNIGHT TRENCH CLOSING

THE BASE WIDENING SHALL BE COMPLETED TO A DEPTH OF NO MORE THAN 12 INCHES BELOW THE EXISTING PAVEMENT BY THE END OF EACH WORK DAY. NO TRENCH SHALL BE LEFT OPEN OVERNIGHT EXCEPT FOR A SHORT LENGTH (25 FEET OR LESS) OF A WORK SECTION AT THE END OF THE TRENCH. IN CASE WORK MUST BE SUSPENDED BECAUSE OF INCLEMENT WEATHER OR OTHER REASONS, THE TRENCH FOR THE UN-COMPLETED BASE WIDENING SHALL BE BACK-FILLED AT THE DIRECTION OF THE ENGINEER. TRENCHES WITHIN THE TRAVELED LANE SHALL BE COMPLETED FLUSH TO THE ADJACENT PAVEMENT.

#### DUST CONTROL

THE CONTRACTOR SHALL FURNISH AND APPLY WATER FOR DUST CONTROL AS DIRECTED BY THE ENGINEER. THE FOLLOWING ESTIMATED QUANTITIES HAVE BEEN INCLUDED FOR DUST CONTROL PURPOSES:

ITEM 616, WATER 41 M. GAL.

#### FLOODLIGHTING

FLOODLIGHTING OF THE WORK SITE FOR OPERATIONS CONDUCTED DURING NIGHTTIME PERIODS SHALL BE ACCOMPLISHED SO THAT THE LIGHTS DO NOT CAUSE GLARE TO THE DRIVERS ON THE ROADWAY. TO ENSURE THE ADEQUACY OF THE FLOODLIGHT PLACEMENT, THE CONTRACTOR AND THE ENGINEER SHALL DRIVE THROUGH THE WORK SITE EACH NIGHT WHEN THE LIGHTING IS IN PLACE AND OPERATIVE PRIOR TO COMMENCING ANY WORK. IF GLARE IS DETECTED, THE LIGHT PLACEMENT AND SHIELDING SHALL BE ADJUSTED TO THE SATISFACTION OF THE ENGINEER BEFORE WORK PROCEEDS.

PAYMENT FOR ALL LABOR, EQUIPMENT AND MATERIALS SHALL BE INCLUDED IN THE LUMP SUM CONTRACT PRICE FOR ITEM 614, MAINTAINING TRAFFIC.

#### ITEM 614, WORK ZONE IMPACT ATTENUATOR FOR 24" WIDE HAZARDS (UNIDIRECTIONAL OR BIDIRECTIONAL)

THIS ITEM SHALL CONSIST OF FURNISHING AND INSTALLING A NONGATING IMPACT ATTENUATOR. FURNISH AN IMPACT ATTENUATOR FROM THE OFFICE OF ROADWAY ENGINEERING'S APPROVED LIST FOR WORK ZONE IMPACT ATTENUATORS, FROM THE ROADWAY STANDARDS APPROVED PRODUCTS WEB PAGE.

INSTALLATION SHALL BE AT THE LOCATIONS SPECIFIED IN THE PLANS IN ACCORDANCE WITH THE MANUFACTURER'S SPECIFICATIONS.

THE CONTRACTOR SHALL REPAIR OR REPLACE A DAMAGED UNIT WITHIN 24 HOURS OF A DAMAGING IMPACT.

WHEN BIDIRECTIONAL DESIGNS ARE SPECIFIED, THE CONTRACTOR SHALL SUPPLY APPROPRIATE TRANSITIONS.

WHEN GATING IMPACT ATTENUATORS ARE DESIRED, THE CONTRACTOR SHALL SUBMIT DOCUMENTATION TO THE ENGINEER FOR ACCEPTANCE.

THE COST FOR THE ADDITIONAL BARRIER REQUIRED FOR A GATING IMPACT ATTENUATOR SHALL BE INCLUDED IN THE COST OF THE GATING IMPACT ATTENUATOR.

PAYMENT FOR THE ABOVE WORK SHALL BE MADE AT THE UNIT PRICE BID AND SHALL INCLUDE ALL LABOR, TOOLS, EQUIPMENT AND MATERIALS NECESSARY TO CONSTRUCT AND MAINTAIN A COMPLETE AND FUNCTIONAL IMPACT ATTENUATOR SYSTEM, INCLUDING ALL RELATED BACKUPS, TRANSITIONS, LEVELING PADS, HARDWARE AND GRADING, NOT SEPARATELY SPECIFIED, AS REQUIRED BY THE MANUFACTURER.

3	6	16	17	18	19	25	I	1			PART.	ITEM		1	UNIT	DESCRIPTION	
					/0	23					01/5>2/4	) - 1 - 111	EXT	TOTAL	01111	DESCRIPTION	SHEET NO.
											10	201				ROADWAY	
		2									LS	201 202	11000 20010	LS 2	EACH	CLEARING AND GRUBBING HEADWALL REMOVED	
		53					+				<i>2</i> 53	202	23000	53		PAVEMENT REMOVED	
		2,166									2,166	202	30000	2,166		WALK REMOVED	
		399									399	202	32000	399		CURB REMOVED	
		56									56	202	35100	56		PIPE REMOVED, 24" AND UNDER	
		58									58	202	35200	58		PIPE REMOVED, OVER 24"	
-		301									301	202	38000	301	FT	GUARDRAIL REMOVED	
-		2									2	202 202	42040 47000	2		ANCHOR ASSEMBLY REMOVED, TYPE T BRIDGE TERMINAL ASSEMBLY REMOVED	
		7									<del>-  </del>	202	47000	7	LACIT	DITUDE TENMINAL ASSEMBLT NEMOVED	
		4									4	202	58100	4	EACH	CATCH BASIN REMOVED	
		136									136	202	75000	136	FT	FENCE REMOVED	
		LS									LS	202	98000	LS		REMOVAL MISC.: ROCK CHANNEL PROTECTION	4
						271					271	203	10000	271		EXCAVATION	
						3,885					3,885	203	20000	3,885	CY	EMBANKMENT	
-						6,124					6,124	203	20001	6,124	CY	EMBANKMENT, AS PER PLAN	3
			1,435			0,124					1,435	204	10000	1,435	SY	SUBGRADE COMPACTION	3
			180								180	204	13000	180		EXCAVATION OF SUBGRADE	
			558								558	204	30020	558		GRANULAR MATERIAL, TYPE C	
			1								1	204	45000	1	HOUR	PROOF ROLLING	3
													1				
		200	1,435								1,435	204	50000 15100	1,435	SY FT	GEOTEXTILE FABRIC	
		288 2,166									288 2,166	606 608	12000	288 2,166		GUARDRAIL, TYPE MGS WITH LONG POSTS  5" CONCRETE WALK	
5		2,100									5	623	38500	5		MONUMENT ASSEMBLY, TYPE C	
											LS	SPECIAL	69098400	LS	2,1011	SPECIAL - CONSULTANT FOR CONCRETE QUALITY CONTROL INCLUDING TESTING AND INSPECTION	4
											LS	878	25000	LS		INSPECTION AND COMPACTION TESTING OF UNBOUND MATERIALS	
											LS	SPECIAL	69098400	LS		ENVIRONMENTAL / REMEDIATION  SPECIAL - MISC.: WORK INVLOVING ASBESTOS CONTAINING MATERIALS	4
											LS	SPECIAL	69096400	LS		SPECIAL - MISC. WORK INVLOVING ASDESTOS CONTAINING MATERIALS	4
																EROSION CONTROL	
	41										41	616	10000	41	MGAL	WATER	
09											109	659	00300	109	CY	TOPSOIL	
						980					980	659	10000	980		SEEDING AND MULCHING	
49											49	659	14000	49		REPAIR SEEDING AND MULCHING  COMMERCIAL FERTILIZER	
0.13											0.13	659	20000	0.13	TON	COMMERCIAL FERTILIZER	
).2											0.2	659	31000	0.2	ACRE	LIME	
5.4											5.4	659	35000	5.4		WATER	
											10,000	832	30000	10,000		EROSION CONTROL	
											113		77500	117	C.T.	DRAINAGE	
				113								601 601	37500 37501	113 35		PAVED GUTTER, TYPE 1-2 PAVED GUTTER, TYPE 1-2, AS PER PLAN	4
				35 285							35 285	605	06000	285		4" BASE PIPE UNDERDRAINS	7
				48							490	611	00410	40		4" CONDUIT, TYPE F FOR UNDERDRAIN OUTLET	
				191							191	611	04400	191		12" CONDUIT, TYPE B	
				28							52 52	611	04400	20		12" CONDUIT, TYPE B WITH STEEL PIPE ENCASEMENT (748.06)	
				52							52	611	16400	52		36" CONDUIT, TYPE B	
												611	16400	44		36" CONDUIT, TYPE B WITH STEEL PIPE ENCASEMENT (748.06)	
				<i>2 5</i>							2 	611 611	99574 98180	5		MANHOLE, NO. 3  CATCH BASIN, NO. 3A	
											—	011	30100	3	LACIT	The state of the s	
				3							3	611	98470	3	EACH	CATCH BASIN, NO. 2-2B	
				1							1	611	98540	1		CATCH BASIN, NO. 2-4	
				1							1	611	98644	1		CATCH BASIN GRATE	
$\!$			705			<del>                                     </del>		_	1		7.5	70.	50000	7.00	01/	PAVEMENT	
			305 250			+					305	301	56000	305 250		ASPHALT CONCRETE BASE, PG64-22, (449)	
-	-		250 254			<del>                                     </del>					250 254	304 407	20000 20000	250 254		AGGREGATE BASE NON-TRACKING TACK COAT	
-+			61			<del>                                     </del>					61	441	50000	61		ASPHALT CONCRETE SURFACE COURSE, TYPE 1, (448), PG64-22	
			67							1	67	441	50300	67		ASPHALT CONCRETE INTERMEDIATE COURSE, TYPE 2, (448)	

 $\bigcirc$ 

 $\bigcirc$ 

 $\bigcirc$ 

 $\bigcirc$ 

					5	SHEET NUM	И. I					PART.	ITEM	ITEM	GRAND	UNIT	DESCRIPTION	SEE SHEET
5	6	7	16	17	19	29					Y	01/5>2/40	\ \ \ \ \ \ \ \ \ \ \ \ \ \ \ \ \ \ \	EXT	TOTAL			NO.
												$\sim$					PAVEMENT (CONT.)	
				591								591	609	26000	591	FT	CURB, TYPE 6	
																	TRAFFIC CONTROL	
					47							47	621	00100	47	EACH	RPM	
					47							47	621	54000	47	EACH	RAISED PAVEMENT MARKER REMOVED	
			1		-							1	625	75400	1	EACH	LIGHT POLE REMOVED	
					3 0.27							3 0.27	626 644	00110 00200	3 0.27	EACH MILE	BARRIER REFLECTOR, TYPE 2, (ONE-WAY)  LANE LINE, 4"	
					0.27							0.27	044	00200	0.27	IWILL	LANE LINE, 4	
					0.17							0.17	644	00300	0.17	MILE	CENTER LINE	
					110							110	644	00500	110	FT	STOP LINE	
					228							228	644	01500	228	FT	DOTTED LINE, 4"	4
					91							91	644 644	01501 01300	91 2	F T EACH	DOTTED LINE, 4", AS PER PLAN  LANE ARROW	4
					-								011	0.000		EAGIT	EATE AUTOIL	
					227							227	644	00400	227	FT	CHANNELIZING LINE, 8"	
																	DETAINING MALL C (DM)	
						720						72	204	5000	~~~		RETAINING WALLS (RWI)	29
						15						1.5	50.3	50001 11100	. LS .	( Y 3/Y )	GEOTEXTILE FARRIS AS PER PLAN COFFERDANS AND EXCAVATION GRAINING SEALING OF CONCRETE SURFACES (EPOXY-URETHANE), AS PER PLAN	23
						3,28		V V			$\mathcal{L}$	3,988	503	10101	3,988		SEALING OF CONCRETE SURFACES (EPOXY-URETHANE), AS PER PLAN	29
						159						159	607	39900	159	FT	VANDAL PROTECTION FENCE, 6 STRAIGHT, CONTED FABRIC	
						3,988						3,988	840	20001	3,988	SF	MECHANICALLY STABILIZED EARTH WALL, AS PER PLAN	3
						652						652	840	21000	652	CY	WALL EXCAVATION	
						336						336	840	22001	336	SY	FOUNDATION PREPARATION, AS PER PLAN	29
						323						323	840	25010	323	FT	6" DRAINAGE PIPE, PERFORATED	
						2.5						2.5	840	25020	2.5	FT	6" DRAINAGE PIPE, NON-PERFORATED	
						159						159	840	26000	159	FT	CONCRETE COPING	
						3,988						3,988	840	26050	3,988	SF	AESTHETIC SURFACE TREATMENT	
						5						5	840	27000	5	DAY	ON-SITE ASSISTANCE	
						LS						LS	867	00101	LS		TEMPORARY WIRE FACED MECHANICALLY STABILIZED EARTH WALL, AS PER PLAN	3
																	STRUCTURE REPAIR (HAM-SR264-10.42)	36
																	WINTENANCE OF TOLETO	
		160										160	614	11110	160	HOUR	MAINTENANCE OF TRAFFIC  LAW ENFORCEMENT OFFICER WITH PATROL CAR FOR ASSISTANCE	
7												7	614	12384	7		WORK ZONE IMPACT ATTENUATOR, 24" WIDE HAZARDS, (BIDIRECTIONAL)	
18												18	614	13310	18	EACH	BARRIER REFLECTOR, TYPE 1, (BI-DIRECTIONAL)	
18	0.07											18	614	13350	18	EACH	OBJECT MARKER, ONE WAY	
	0.27											0.27	614	20550	0.27	MILE	WORK ZONE LANE LINE, CLASS III, 4", 642 PAINT	
0.19												0.19	614	21200	0.19	MILE	WORK ZONE CENTER LINE, CLASS I, 740.06, TYPE I	
	0.17											0.17	614	21550	0.17	MILE	WORK ZONE CENTER LINE, CLASS III, 642 PAINT	
0.42												0.42	614	22200	0.42	MILE	WORK ZONE EDGE LINE, CLASS I, 4", 740.06, TYPE I	
607	319											607 319	614 614	24400 24610	607 319	FT FT	WORK ZONE DOTTED LINE, CLASS I, 4", 740.06, TYPE I  WORK ZONE DOTTED LINE, CLASS III, 4", 642 PAINT	
	313											313	014	24010	313	1 1	NOTE DOTTED LINE, CLASS III, 4, 042 TAINT	
22												22	614	26400	22	FT	WORK ZONE STOP LINE, CLASS I, 740.06, TYPE I	
	110											110	614	26610	110	FT	WORK ZONE STOP LINE, CLASS III, 642 PAINT	
259	120											259 120	614 614	23010 23690	259 120	FT FT	WORK ZONE CHANNELIZING LINE, CLASS I, 12"  WORK ZONE CHANNELIZING LINE, CLASS III, 12", 642 PAINT	
255	120											255	615	25000	255	SY	PAVEMENT FOR MAINTAINING TRAFFIC, CLASS B	
200													0.0		200	, , , , , , , , , , , , , , , , , , ,	THE BEAT FOR MAINTENE WAY TO GET SO D	
779												779	622	41100	779	FT	PORTABLE BARRIER, UNANCHORED	
												LS	614	11000	LS		INCIDENTALS  MAINTAINING TRAFFIC	
												LS	623	10000	LS		CONSTRUCTION LAYOUT STAKES AND SURVEYING	
												LS	624	10000	LS		MOBILIZATION	
					-											-		
					1											1		
					1				I	I		I						

O 4/14/2025 4:26:48 PM gtout	0-1 0-2	00 SHEET NO		RANGE 550+62.35 552+22.50	SIDE RT RT	≈ CADD GENERATED AREA	13 PAVED GUTTER, TYPE 1-2	PAVED GUTTER, TYPE 1-2, AS PER 9	4" BASE PIPE UNDERDRAINS	4* CONDUIT, TYPE F FOR UNDERDRAIN OUTLET		68 68	36" CONDUIT, TYPE B	MANHOLE, NO. 3	CATCH BASIN, NO. 34	- CATCH BASIN, NO. 2-28	HODE CATCH BASIN, NO. 2-4	PIPE ENCASEMENT (748.06)	36" CONDUIT, TYPE B, WITH STEEL PIPE ENCASEMENT (748.06) ≅	CATCH BASIN GRATE			
Ogdwgv\Sheets\25349_GS003.dan Sheet	D-3 D-4 D-5 D-6 D-7 D-8 D-9 D-10 D-11 D-12 D-13 D-14 D-15 U-1 U-2	20 20 20 20 20 20 20 20 20 20 20 20 20 2	550+80.45 TO 551+32.12 TO 551+38.23 TO 551+93.73 TO 551+93.73 TO 552+00.45 TO 552+09.31 TO 552+09.31 TO 552+17.92 TO 552+17.92 TO 552+24.32 TO 552+39.31 TO 550+65.75 TO 550+94.45 TO 551+48.23 TO	550+84.45 551+36.12 552+00.45 552+03.22 552+03.22 552+00.45 552+25.64 552+17.92 552+27.94 552+43.31 352+70.68 551+00.75 552+29.31 552+29.31 552+56.18	RT LT RT  RT RT RT RT LT RT			35	175			4 4 66 26 4 4	22 6 6	1	1 1 1	1	,	20	24 20	1			SUBSUMMARY
08\Hamilton\25349\400-Enaineerina\R	U-3 U-4 U-5 U-6	20 20 20 20	552+29.31 TO 551+38.23 TO	550+94.45 552+39.31 551+48.23 552+66.18	RT RT LT LT					10 10 10													DRAINAGE
O  Uments/01Active Projects/District																							
Onliodot-pw.bentlev.com.ohlodot-pw-02\Doc		TC	TALS CARRIED TO	I O GENERAL SUM	MMARY			35	285	40		191		2	5	2	ı	20	44	ı			HAM-SR264-10,42

						_	621	621	621	626	644	644	644	644	644	644	644			
REF NO.	SHEET NO	STAT	ION F	RANGE	SIDE	CADD GENERATED AREA	HOW (YELLOW/YELLOW)	RPM (WHITE/RED)	RAISED PAVEMENT MARKER REMOVED	BARRIER REFLECTOR, TYPE 2,	LANE LINE, 4"	CENTER LINE	STOP LINE	DOTTED LINE, 4"	HOW LANE ARROW	CHANNELIZING LINE, 8"	DOTTED LINE, 4", AS PER PLAN			
24 1		547.00.00	7.0	550 10 00	21	31		EAGIT		LACIT	MILL			, ,	EAGII	, ,	, ,			
CL -1 LL -1	28 28	547+08.66 547+08.66	<i>TO</i>		CL RT		6	6	6 6		0.06	0.06								
SL-1 .L-2	28 28	547+08.66 547+08.66	TO	549+74.74	RT/LT LT			5	5		0.05		24							
A-1	28	549+10.00	,,,	0.10 - 1.11	RT				Ü		0.00				1					
A-2	28	550+10.00			RT										1					
DL -1 DA -1	28 28	550+18.60 550+18.60	TO		RT CL									67			91.00			
DL -3 L -3	28 28	549+74.74 550+90.21	<i>TO</i>	551+33.49	LT RT			7	7		0.07			161						
								/			0.07									
CL-2 CL-3	28 28	551+02.79 551+10.83	TO TO	551+66.04 554+62.60	RT CL		6		3 6			0.01								
CL-4 GL-2	28 28	552+77.29 551+33.49	TO		CL L T		4		4			0.04	25							
5L-2 5L-3	28	550+18.60			RT								37							
L-4	28	550+90.21	TO	554+62.60	LT			6	6		0.06									
GR-1 .L-5	28 28	550+18.60	TO NHILLS	553+10.50	RT			4	4	3	0.03									
CH-1	28	549+10.00	TO		RT			7	7		0.03					120				
SL-4	28	554+62.60			RT								24							
CH-2	28	553+55.51	TO	554+62.60												107				
1				) GENERAL SU.				<u> </u> 47	47	3.00	0.27	0.17	110	228	2.00	227	91			

 $\bigcirc$ 

THE CONTRACTOR SHALL REMOVE THE EXISTING METAL BRIDGE RAILING AND STORE IT FOR PICKUP BY THE STATE.

#### EXISTING STRUCTURE VERIFICATION

EXISTING STRUCTURE VERIFICATION: DETAILS AND DIMENSIONS SHOWN ON THESE PLANS PERTAINING TO THE EXISTING STRUCTURE HAVE BEEN OBTAINED FROM PLANS OF THE EXISTING STRUCTURE AND FROM FIELD OBSERVATIONS AND MEASUREMENTS. CONSEQUENTLY, THEY ARE INDICATIVE OF THE EXISTING STRUCTURE AND THE PROPOSED WORK BUT THEY SHALL BE CONSIDERED TENTATIVE AND APPROXIMATE. THE CONTRACTOR IS REFERRED TO CMS SECTIONS 102.05 AND 105.02.

BASE CONTRACT BID PRICES UPON A RECOGNITION OF THE UNCERTAINTIES DESCRIBED ABOVE AND UPON A PREBID EXAMINATION OF THE EXISTING STRUCTURE. HOWEVER, THE DEPARTMENT WILL PAY FOR ALL PROJECT WORK BASED UPON ACTUAL DETAILS AND DIMENSIONS WHICH HAVE BEEN VERIFIED IN THE FIELD.

#### ITEM 503, COFFERDAMS AND EXCAVATION BRACING, AS PER PLAN

THE DESIGN SHOWN ON THE PLANS FOR TEMPORARY SUPPORT OF EXCAVATION IS ONE REPRESENTATIVE DESIGN THAT MAY BE USED TO CONSTRUCT THE PROJECT. THE CONTRACTOR MAY CONSTRUCT THE DESIGN SHOWN ON THE PLANS OR PREPARE AN ALTERNATE DESIGN TO SUPPORT THE SIDES OF EXCAVATIONS. IF CONSTRUCTING AN ALTERNATE DESIGN FOR TEMPORARY SUPPORT OF EXCAVATION, PREPARE AND PROVIDE PLANS IN ACCORDANCE WITH C&MS 501.05. THE DEPARTMENT WILL PAY FOR THE TEMPORARY SUPPORT OF EXCAVATION AT THE CONTRACT LUMP SUM PRICE FOR COFFERDAMS AND EXCAVATION BRACING. NO ADDITIONAL PAYMENT WILL BE MADE FOR PROVIDING AN ALTERNATE DESIGN.

#### ITEM 516, JACKING AND TEMPORARY SUPPORT OF SUPER-STRUCTURE. AS PER PLAN

THIS WORK CONSISTS OF PROVIDING TEMPORARY DECK EDGE SUPPORT DURING PHASED DEMOLITION OF THE BRIDGE AS SHOWN IN THE PROJECT PLANS. PROVIDE SHORING AS NEEDED ALONG PHASED CONSTRUCTION LINE TO SUPPORT APPROACH SLABS AND ACCOMODATE REMOVAL OF ABUTMENT BACKWALLS.

SUBMIT CONSTRUCTION/DEMOLITION PLANS IN ACCORDANCE WITH CMS 501.05.

IF. DURING THE JACKING OPERATIONS, CRACKING OF THE CON-CRETE SUPERSTRUCTURE. SEPARATION OF THE CONCRETE DECK FROM THE STEEL STRINGERS, OR OTHER DAMAGE TO THE STRUCTURE IS VISUALLY OBSERVED, IMMEDIATELY CEASE THE JACKING OPERATION AND INSTALL SUPPORTS TO THE SATIS-FACTION OF THE ENGINEER. ANALYZE THE DAMAGE AND SUB-MIT A METHOD OF CORRECTION TO THE ENGINEER FOR APPROVAL. EPOXY INJECT ALL BEAMS THAT SEPARATE FROM THE DECK FOR THE DISTANCE OF THE SEPARATION IN ACCORDANCE WITH CMS 512.07. THE DEPARTMENT WILL NOT PAY FOR THE COST OF THIS EPOXY INJECTION OR OTHER REQUIRED REPAIRS. THE BRIDGE BEARINGS SHALL BE FULLY SEATED AT ALL CON-TACT AREAS. IF FULL SEATING IS NOT ATTAINED. SUBMIT A REPAIR PLAN TO THE ENGINEER. THE DEPARTMENT WILL NOT PAY FOR THE REPAIR COSTS TO ENSURE FULL SEATING ON BEARINGS.

THE DEPARTMENT WILL MEASURE THIS WORK ON A LUMP SUM BASIS.

THE DEPARTMENT WILL PAY FOR THE ACCEPTED QUANTITIES AT THE CONTRACT PRICE FOR ITEM 516, JACKING AND TEMPORARY SUPPORT OF SUPERSTRUCTURE, AS PER PLAN.

#### PROPOSED WORK

REMOVE BRIDGE HAM-264-1046 (SFN 3111547) WHICH CARRIES SR 264 OVER AN ABANDONED RAIL LINE:

- 1. REMOVE THE EXISTING SUPERSTRUCTURE,
  APPROACH SLABS, AND BEARINGS IN ACCORDANCE
  WITH THE MAINTENANCE OF TRAFFIC PHASES.
  ERECT TEMPORARY DECK BRACES AS NEEDED
  ALONG THE PHASE CONSTRUCTION LINE TO
  SUPPORT THE PHASE TWO INTERIOR DECK EDGE.
- 2. REMOVE PORTIONS OF THE EXISTING ABUTMENT BACKWALLS DOWN TO THE BEAM SEAT. REMOVE THE PIER DOWN TO THE STEM WALL TO ACCOMMODATE FUTURE UTILITIES. REMOVE A PORTION OF THE PIER STEM WALL IF NEEDED TO CONSTRUCT THE TEMPORARY MSE WALL. REMOVALS SHALL PROCESS IN ACCORDANCE WITH THE MAINTENANCE OF TRAFFIC PHASES. REMOVE THE TOPS OF WING WALLS #2 AND #3 DOWN TO 12" BELOW FINISHED GRADE. WING WALLS #1 AND #4 SHALL NOT BE DISTURBED.
- 3. REPLACE THE CONDUITS UNDER THE BRIDGE WITH NEW CONDUITS WITH SUFFICIENT STRUCTURAL CAPACITY FOR THE PROPOSED DEPTH.
- 4. CONSTRUCT THE NEW RETAINING WALL AT THE APPROXIMATE BACK OF THE OF THE EXISTING PARKING LOT. THIS WILL ELIMINATE THE EASTERN MOST PARKING SPACES AND LIGHT POLE, BUT OTHERWISE MINIMIZES THE HEIGHT OF THE PROPOSED WALL, IMPACT TO THE REST OF THE BACK PARKING AREA, UTILITIES, AND BUILDING/SITE FUNCTIONALITY. GRADE AREA IN FRONT OF WALL TO DRAIN.
- 5. MINIMIZE IMPACTS TO THE EXISTING BILLBOARDS.
- 6. REPLACE THE EXISTING SUPERSTRUCTURE AND AREA UNDER THE BRIDGE WITH NEW EMBANKMENT AND NEW FULL DEPTH PAVEMENT. MATCH THE APPROACH ROADWAY WIDTH, EXCEPT THAT THE NEW SIDEWALK SHALL BE EIGHT FEET WIDE ON THE WEST SIDE.
- 7. PROVIDE NEW ROADWAY AND RETAINING WALL DRAINAGE AS NECESSARY.
- 8. PROVIDE NEW GUARDRAIL OR BARRIER AS NEEDED.
- 9. SEAL THE WALL AND EXPOSED BRIDGE CONCRETE WITH A CLEAR, NON-EPOXY, SILANE SEALER.

#### ITEM 202, PORTIONS OF STRUCTURE REMOVED, AS PER PLAN

THIS ITEM SHALL INCLUDE THE ELEMENTS INDICATED IN THE PLANS AND GENERAL NOTES AND THAT ARE NOT SEPARATELY LISTED FOR PAYMENT, EXCEPT FOR WEARING COURSE REMOVAL. ITEMS TO BE REMOVED INCLUDE ALL EXISTING MATERIALS BEING REPLACED BY NEW CONSTRUCTION AND MISCELLANEOUS ITEMS THAT ARE NOT SHOWN TO BE INCORPORATED INTO THE FINAL CONSTRUCTION AND ARE DIRECTED TO BE REMOVED BY THE ENGINEER. THE USE OF EXPLOSIVES, HEADACHE BALLS AND/OR HOE-RAMS WILL NOT BE PERMITTED. THE METHOD OF REMOVAL AND THE WEIGHT OF HAMMER SHALL BE APPROVED BY THE ENGINEER. PERFORM ALL WORK IN A MANNER THAT WILL NOT CUT, ELONGATE OR DAMAGE THE EXISTING REINFORCING STEEL TO BE PRESERVED. CHIPPING HAMMERS SHALL NOT BE HEAVIER THAN THE NOMINAL 90-POUND CLASS, PNEUMATIC HAMMERS SHALL NOT BE PLACED IN DIRECT CONTACT WITH REINFORCING STEEL THAT IS TO BE RETAINED IN THE REBUILT STRUCTURE. SUBMIT CONSTRUCTION PLANS ACCORDING TO C&MS 501.05

#### CUT LINE CONSTRUCTION JOINT PREPARATION

SAW CUT BOUNDARIES OF PROPOSED CONCRETE REMOVALS 1 INCH DEEP. REMOVE CONCRETE TO A ROUGH SURFACE. LEAVE THE EXISTING REINFORCING STEEL, IF REQUIRED IN THE PLANS, IN PLACE.

#### SUBSTRUCTURE CONCRETE REMOVAL

REMOVE CONCRETE BY MEANS OF APPROVED PNEUMATIC
HAMMERS EMPLOYING POINTED AND BLUNT CHISEL TOOLS.
HYDRAULIC HOE-RAM TYPE HAMMERS WILL ONLY BE
PERMITTED FOR DEMOLITION OF THE PIER ONCE ALL PHASE LINE
CUTS ARE COMPLETED. THE WEIGHT OF THE HAMMER SHALL NOT BE
MORE THAN 35 POUNDS FOR REMOVAL WITHIN 18 INCHES
OF PORTIONS TO BE PRESERVED. OUTSIDE THE 18 INCH LIMIT.
THE CONTRACTOR MAY USE HOE RAMS AS SPECIFIED OR HAMMERS
NOT EXCEEDING 90 POUNDS UPON THE APPROVAL OF THE
ENGINEER. DO NOT PLACE PNEUMATIC HAMMERS IN DIRECT
CONTACT WITH REINFORCING STEEL, PIPES, ETC. THAT ARE TO BE
RETAINED OR RE-USED IN THE REBUILT STRUCTURE OR ROADWAY.

REMOVALS SHALL PROCEED IN ACCORDANCE WITH SS 840 AND SS 867. ADDITIONAL REMOVALS MAY BE NEEDED TO MEET THE REQUIREMENTS OF SS 840 AND SS 867. CONTRACTOR SHALL COORDINATE WITH TEMPORARY AND PERMANENT RETAINING WALL MANUFACTURER TO ENSURE PROPER WALL INSTALLATIONS.

STRIICTIIRE NOTES	DESIGNED	DRAWN	DESIGNED DRAWN REVIEWED DATE	DESIGN AGENCY
	CAH	CAH	XXX MM/DD/YY	CAH XXX MM/DD/YYOHIO DEPT, OF TRANSPOR
BKIDGE NO: HAM-264-1042	CHECKED	REVISED	CHECKED REVISED STRUCTURE FILE NUMBER	
LENWAY AVE.) OVER ABANDONED RAILROAD	GTF	××	3111547	DISTRICT & BRIDGE OFF

HAM-SR264-10 PID No. 25349

42

34 44