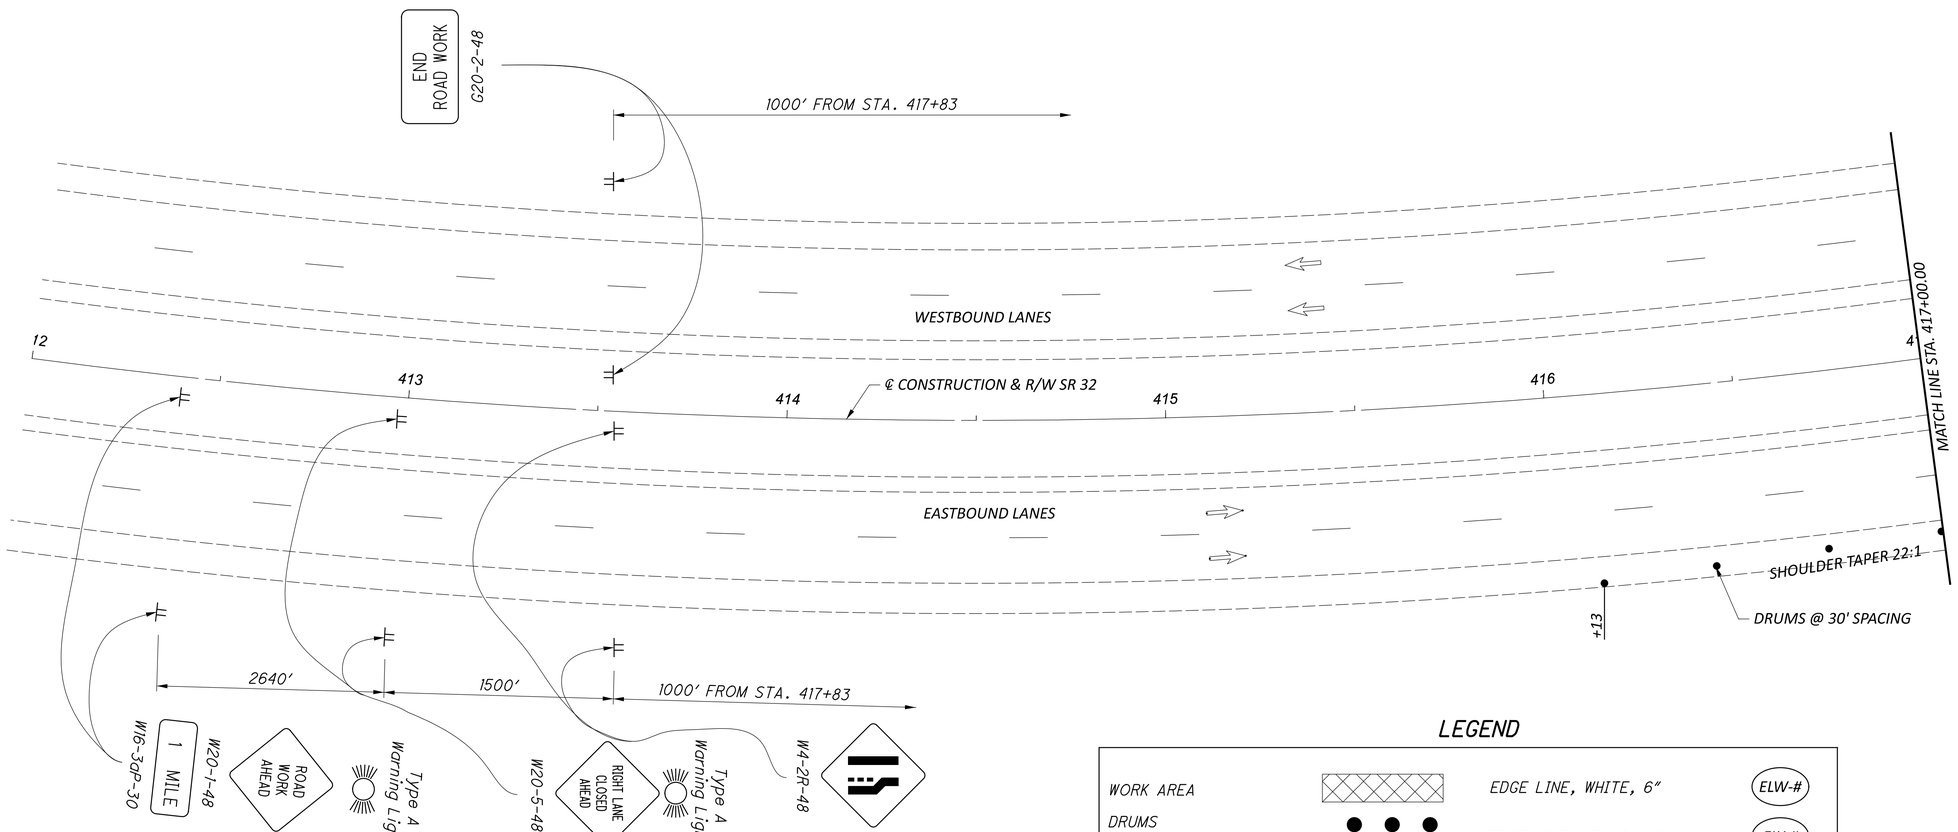

LEGEND

WORK AREA		EDGE LINE, WHITE, 6"	ELW-#
DRUMS		EDGE LINE, YELLOW, 6"	ELY-#
PORTABLE BARRIER (PB)			
ATTENUATOR		DOTTED LINE, WHITE, 6"	DLW-#
DIRECTION OF TRAVEL		CENTER LINE, DOUBLE YELLOW, 6"	CL-#
YIELD LINE, WHITE	YL-#	WORK ZONE ARROW	WA-#
CHANNELIZING LINE, WHITE, 12"	CH-#		

ALL MOT MARKINGS SHALL BE ITEM 614 - CLASS I, PAINT

HORIZONTAL SCALE IN FEET
0 10 20 40

MOT PLAN - PHASE 1
BEGIN TO STA. 417+00.00

DESIGN AGENCY
2LMN

DESIGNER
MAK

REVIEWER
EMW 08/23/23

PROJECT ID
116415

SHEET P10 TOTAL P113

JAC-32-8.43

MODEL: CLX_SR32 - Plan 1A PAPERSIZE: 34x22 (in.) DATE: 2/5/2024 TIME: 11:00:37 AM USER: Josh_Rognon
V:\Projects\B&NI_116415_JAC_32_8.43\400-Engineering\MOT\Sheets\116415_MP101.dgn