


MATCH LINE STA. 946+00.00

MATCH LINE STA. 951+00.00



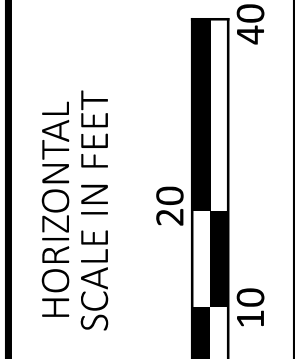

**TRAFFIC CONTROL - SR 95
 STA. 946+00 TO STA. 951+00**

DESIGN AGENCY	
Environmental Design Group	
DESIGNER	
WES	
REVIEWER	
JES 03/24/25	
PROJECT ID	
114818	
SHEET	TOTAL
P.110	P.142