
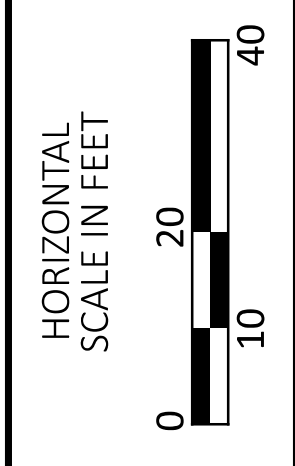


**LEGEND:**  
 LIMITS OF PAVEMENT RESURFACING

**NOTES:**  
 FOR SUP A PROFILE, SEE SHEET P.37  
 FOR SR 95 SUP B PROFILE, SEE SHEET P.38  
 FOR SR 95 CROSS SECTIONS, SEE SHEETS P.42-P.77  
 FOR STORM SEWER PROFILES, SEE SHEETS P.96-P.97  
 FOR INTERSECTION DETAILS, SEE SHEETS P.98-P.104  
 FOR RETAINING WALL DETAILS, SEE SHEETS P.136-P.142

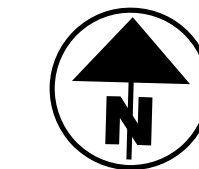

PLAN - SR 95  
 STA. 941+50 TO STA. 946+50

DESIGN AGENCY	
Environmental Design Group	
DESIGNER	
WES	
REVIEWER	
JES 03/24/25	
PROJECT ID	
114818	
SHEET TOTAL	
P.36	P.142