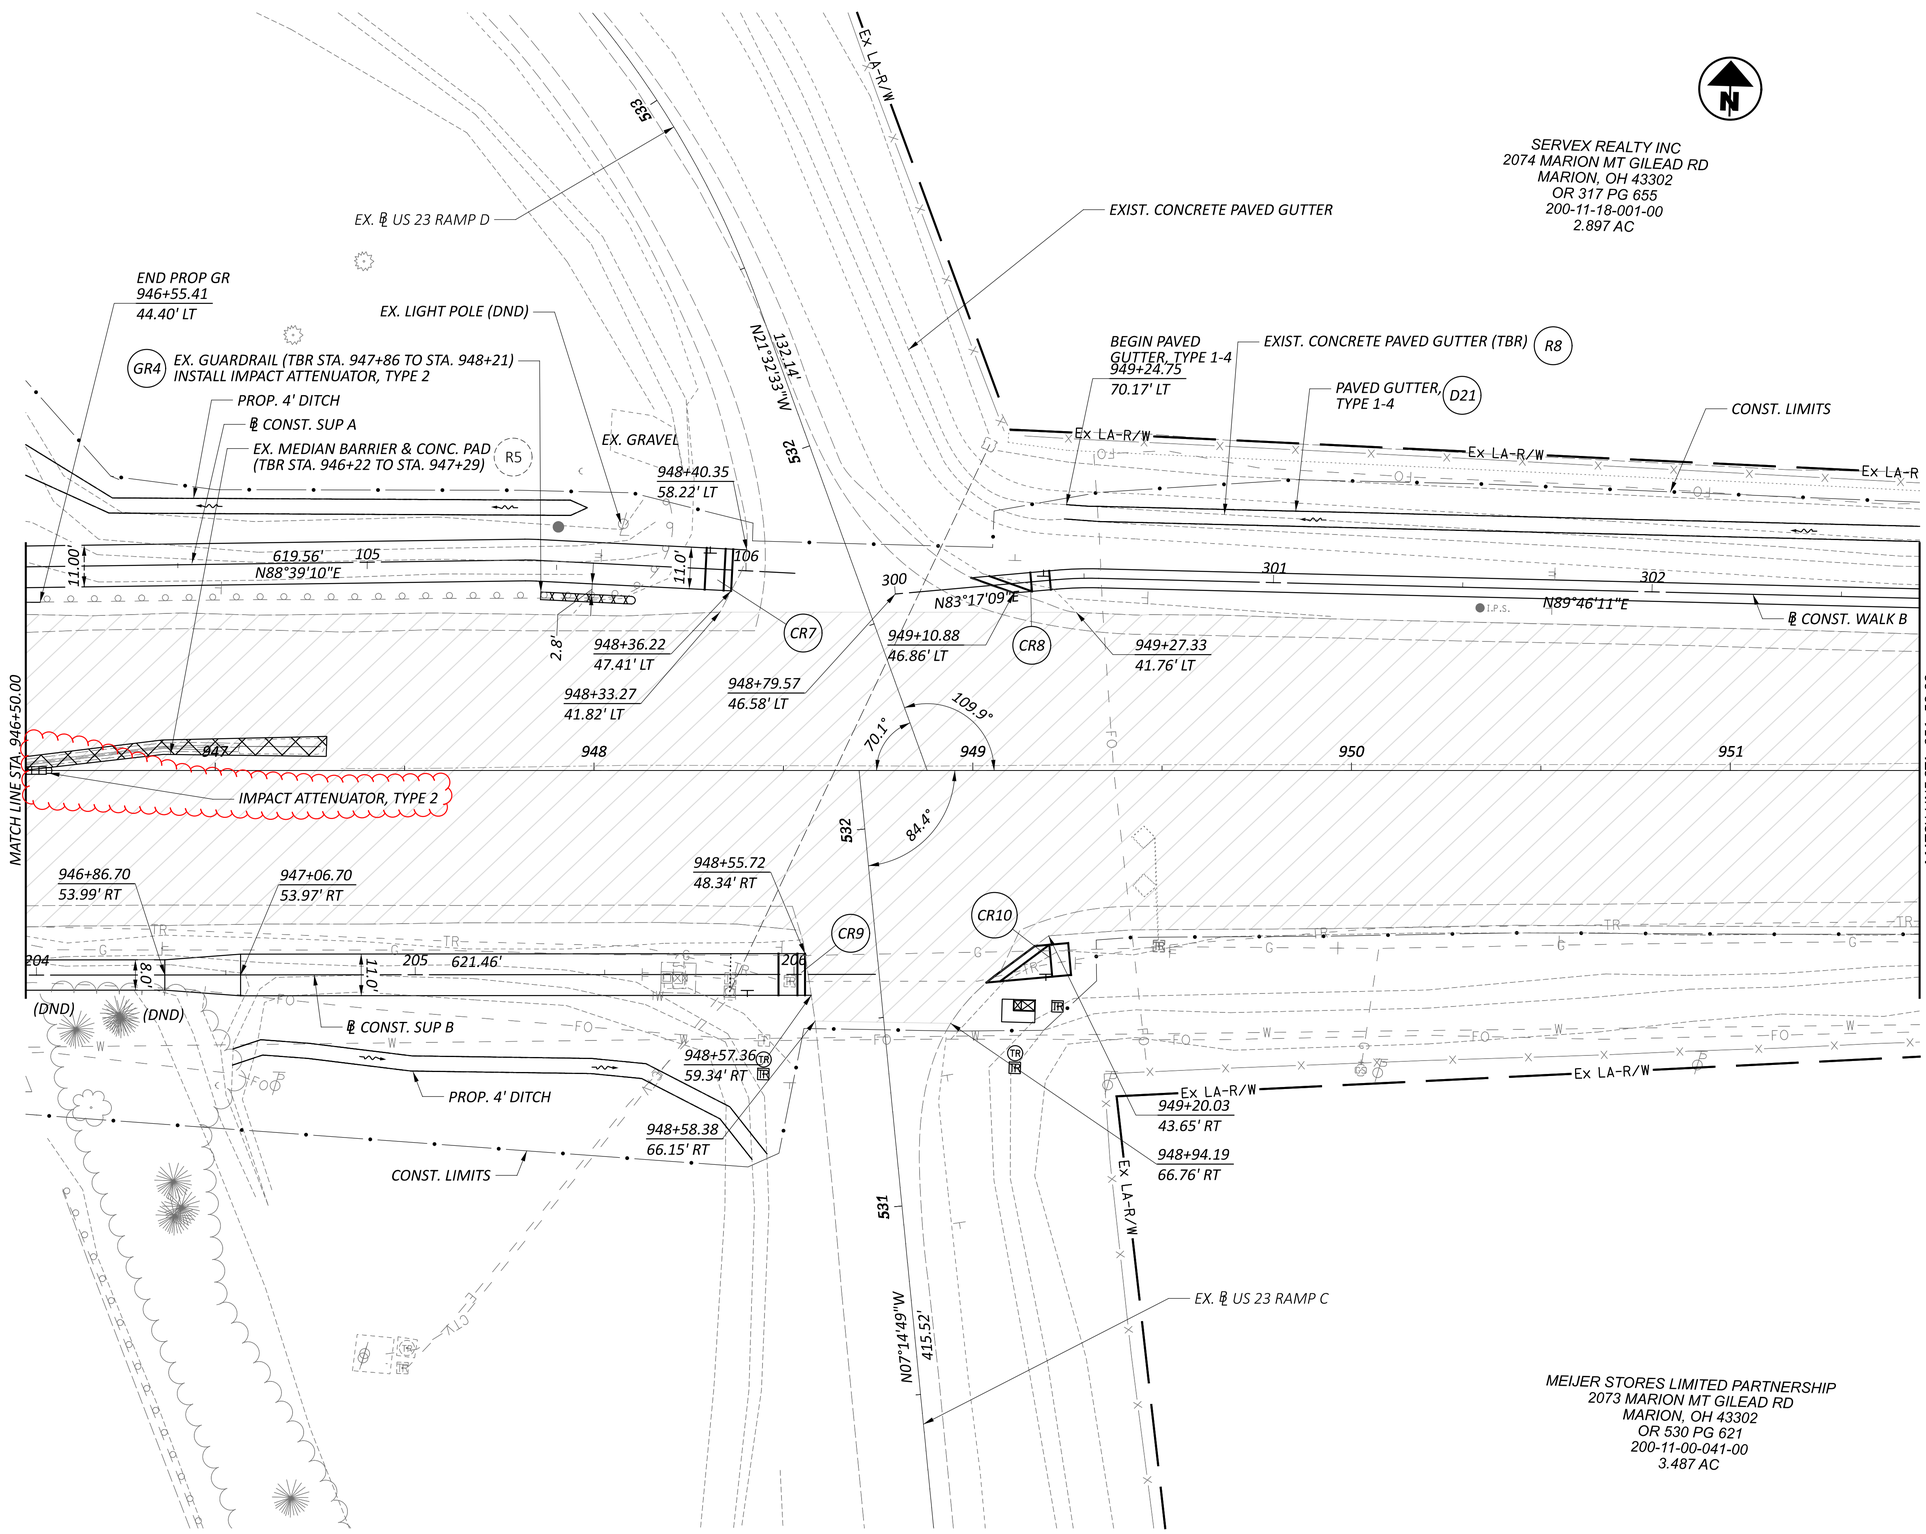

LEGEND:

LIMITS OF PAVEMENT RESURFACING

NOTES:

FOR SR 95 WALK B PROFILE, SEE SHEET P.40

FOR SR 95 CROSS SECTIONS, SEE SHEETS P.42-P.77

FOR INTERSECTION DETAILS, SEE SHEETS P.98-P.104

FOR RETAINING WALL DETAILS, SEE SHEETS P.136-P.142

HORIZONTAL SCALE IN FEET 0 10 20 40

PLAN - SR 95
STA. 946+50 TO STA. 951+50

DESIGN AGENCY
Environmental Design Group
ADVANCED ENVIRONMENTAL SOLUTIONS
P 330.928.1813 | 3150 GEAUGA ST | AKRON, OH 44223
W ENVIRODESIGNGROUP.COM

DESIGNER WES

REVIEWER JES 03/24/25

PROJECT ID 114818

SHEET P.39 TOTAL P.142

MAR-95-17.90

MODEL: 114818_GP003 PAPERSIZE: 34x22 (in.) DATE: 3/26/2026 TIME: 10:34:40 AM USER: bshepherd
E:\ODOT\21-00473-010 MAR-95-17.90\114818\400-Engineering\Roadway\Sheets\114818_GP003.dgn