
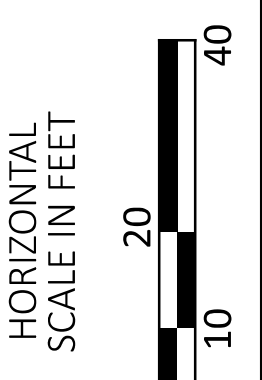


LEGEND:
 LIMITS OF PAVEMENT RESURFACING

NOTES:
 FOR SR 95 CROSS SECTIONS, SEE SHEETS P.42-P.77
 FOR INTERSECTION DETAILS, SEE SHEETS P.98-P.104

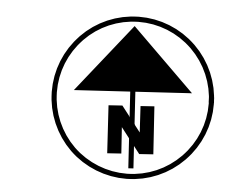

PLAN - SR 95
 STA. 951+50 TO END

HOMER BELVINS AND BONNIE BELVINS
 2117 MARION MT GILEAD RD
 MARION, OH 43302
 OR 368 PG 910
 040-35-00-018-00
 1.674 AC

MEIJER STORES LIMITED PARTNERSHIP
 2153 MARION MT GILEAD RD
 MARION, OH 43302
 OR 530 PG 621
 040-35-00-017-01
 28.168 AC

DESIGN AGENCY	
Environmental Design Group	
DESIGNER	
WES	
REVIEWER	
JES 03/24/25	
PROJECT ID	
114818	
SHEET	TOTAL
P.41	P.142