

# Montgomery County

## Auditor



**Karl L. Keith**

Section Corner Monument Documents  
access courtesy of

**Montgomery County Auditor's Office**

Documents are to be used as public general information and is provided strictly as a courtesy. No warranty as to the content, accuracy or completeness of any information provided herein.


Jamaica Road 1/2 mile south Manning Rd.

Beachler, Stewart, Oaks, Poston

Section 5 + 4 Town 2N Range 5E

4-25-03

22-141 50 SHEETS  
22-142 100 SHEETS  
22-144 200 SHEETS

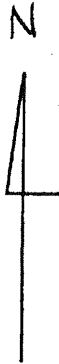

606501.55  
1453795.84  
819.72

1/2 mile south  
of Manning  
Road

MIAMI TWP

GERMAN TWP.

mag nail in  
PP 3' AG.  
Set in SE  
Face  
Pole No# 6895

Section 5

Section 4

MB 6807

GRAVEL DR.

5' OFFSET  
MAG NAIL

RR SPK Found.  
Dug 2' x 2' x 2'  
nothing found  
replace RR SPK  
with 5' ties

20.49'

mag nail in PP 10' AG  
West face  
H1909 Pole Number

5' OFFSET  
MAG NAIL

SPK WAS RESET BELOW  
GRADE. BOOPEE PLAN ON  
PUTTING PK ON SURFACE  
AFTER PAVING 4-25-03  
MAG NAIL RESET BY  
TIES AFTER PAVING  
6-5-2006

Mag nail set in  
PP NE Face  
2' AG.

section line

1/2 mile north  
of SR 725

556

# MONTGOMERY COUNTY SECTION CORNERS VALUES

*Project : MCGPSCON99*

<b>User name</b>	stewartJ	<b>Date &amp; Time</b>	4:18:36 PM 3/1/2010
<b>Coordinate System</b>	US State Plane 1983	<b>Zone</b>	Ohio South 3402
<b>Project Datum</b>	NAD 1983 (Conus)		
<b>Vertical Datum</b>		<b>Geoid Model</b>	GEOID99 (Conus)
<b>Coordinate Units</b>	US survey feet		
<b>Distance Units</b>	US survey feet		
<b>Height Units</b>	US survey feet		

?

NAME	NORTHING	EASTING	ELEVATION
	LATITUDE	LONGITUDE	HIEGHT
DESCRIPTION			
NOTES			
LOCATED BY USE OF			
COMBINE SCALE - GRID TO GROUND CONVERSION FACTOR = ( 1/COMBINE SCALE X GRID DISTANCE = GROUND DISTANCE )			
SC0556	606501.550sft	1453795.840sft	819.720sft
	39°39'03.26449"N	84°19'41.18803"W	710.295sft
JAMAICA RD 1/2 MILE NORTH OF SR725			
MAG SET ABOVE SPK			
VRS TENATIVE			
0.99991280			

[Back to top](#)