



# ODOT District 2 No Passing Zone Log (SAN)

Route: 0510R (SSANSR00510\*\*C)

Length: 6.182

Direction: North


From: 0.830 LEAVE CLYDE

To: 7.012 U0006R

Length	Left	C/L	Right	Length	Control Points	Scale: 1.00 mile/page
0.214	1.574		1.504	0.057	1.778 Mile Post = 002	
			1.447		1.509 T0223 BOOKMEYER	
	1.360					
			1.295	0.105	Google maps shows this dashed	
			1.190			

ODOT District 2  
No Passing Zone Log (SAN)

Route: 0510R (SSANSR00510\*\*C)      From: 0.830 LEAVE CLYDE  
Length: 6.182      Direction: North      To: 7.012 U0006R

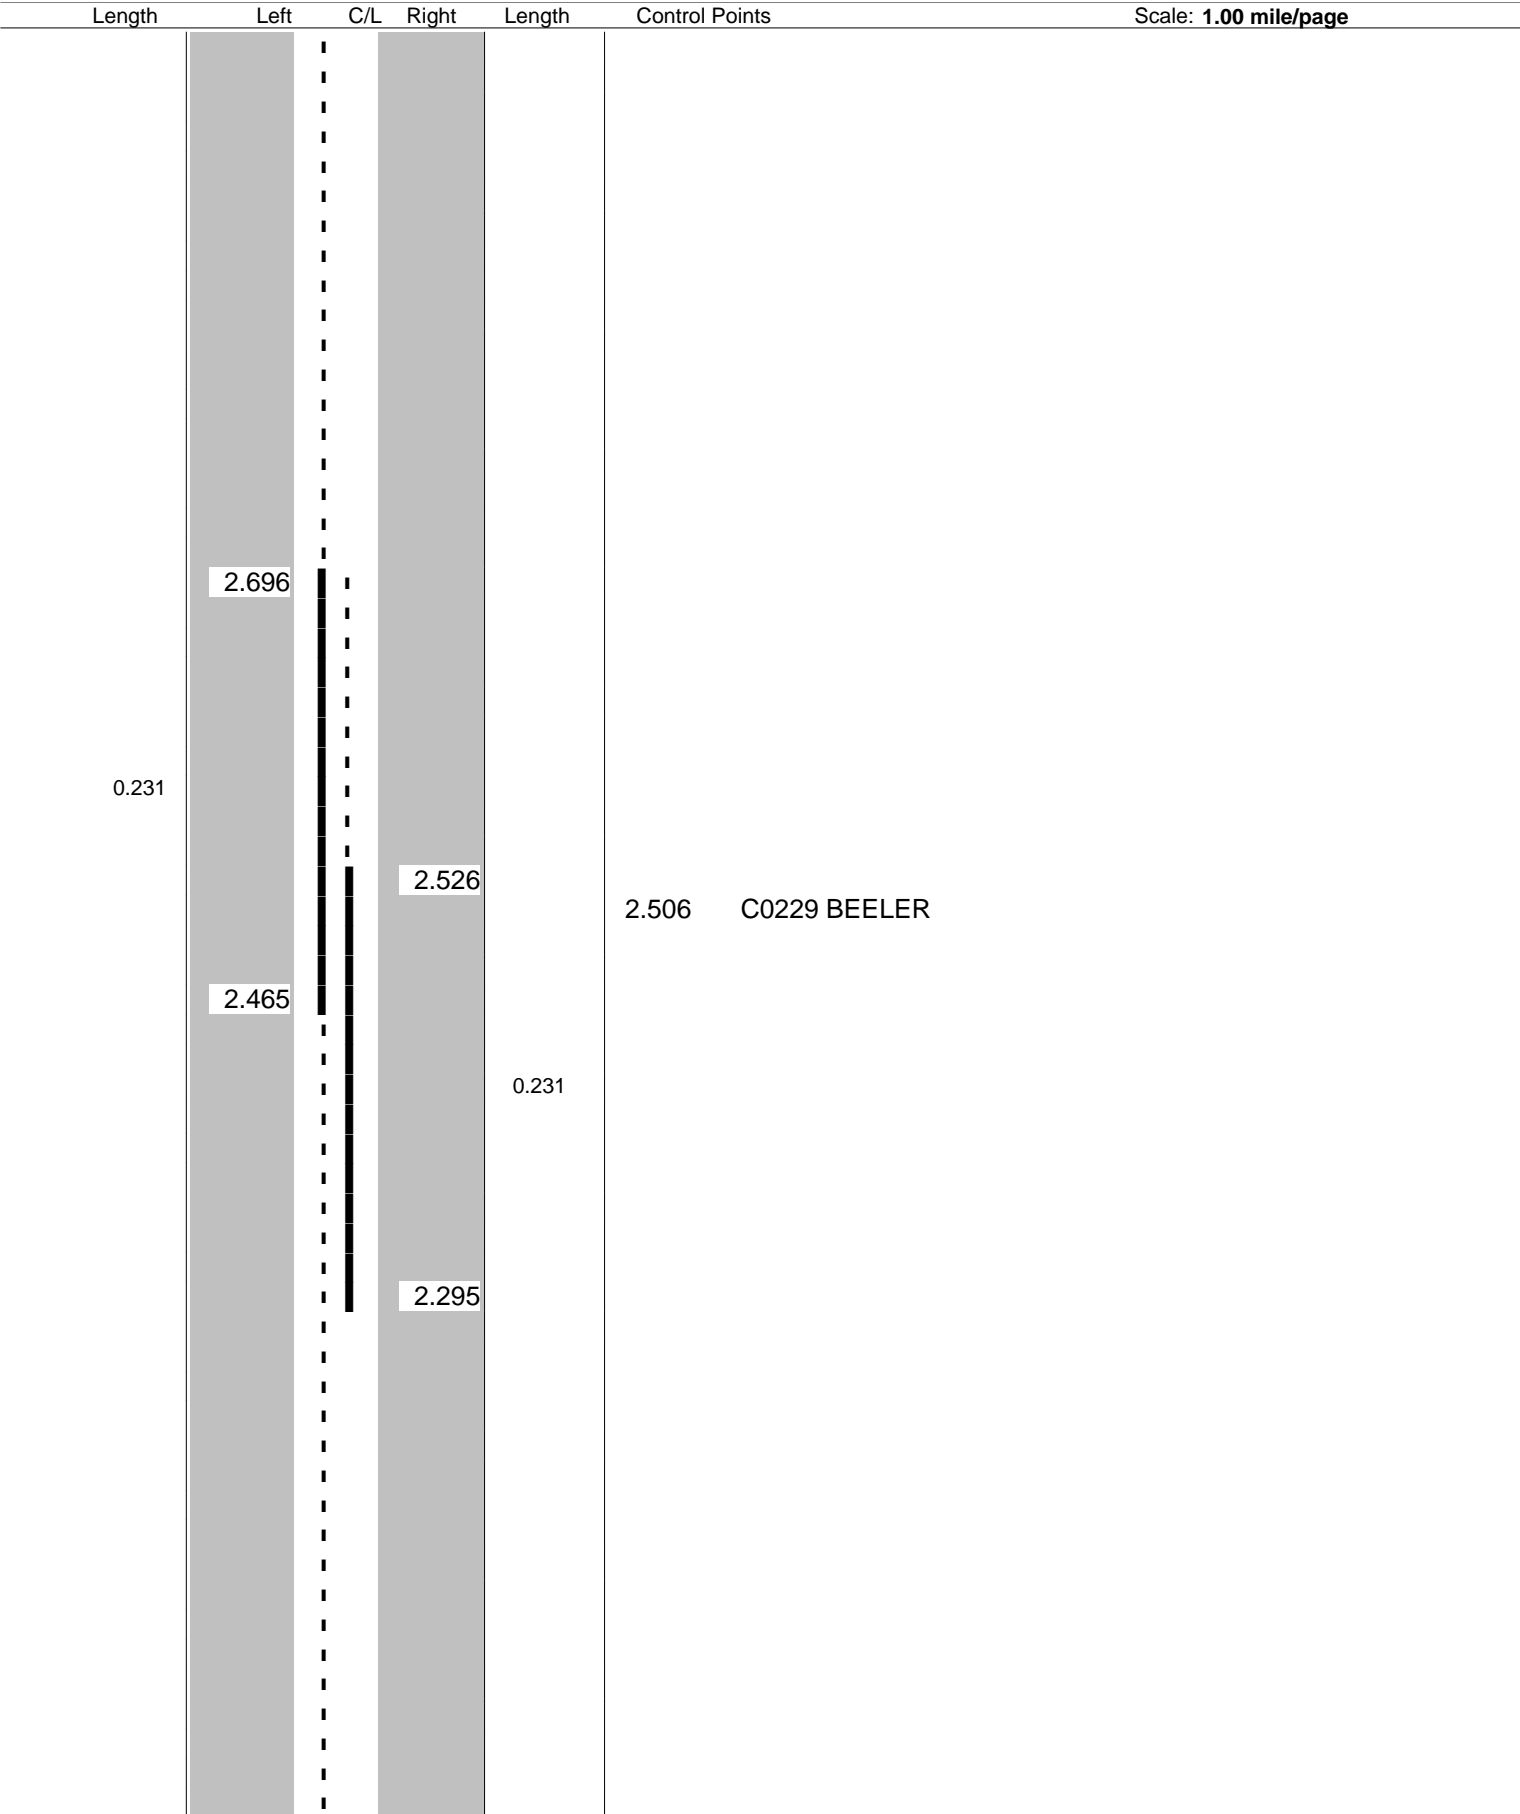







# ODOT District 2 No Passing Zone Log (SAN)


Route: **0510R (SSANSR00510\*\*C)**

Length: **6.182**

Direction: **North**

From: **0.830 LEAVE CLYDE**

To: **7.012 U0006R**

Length	Left	C/L	Right	Length	Control Points	Scale: 1.00 mile/page
			7.000 6.939	0.061	6.978 Mile Post = 007  Google maps shows this double solid. Changed marking to match no passing zone log.	
					6.335 BRIDGE	
					6.050 Mile Post = 006	

## Page: 8 of 8

From: **0.830 LEAVE CLYDE**

To: **7.012 U0006R**

Scale: 1.00 mile/page



0.001

7.012

U0006R