


TO FRANKLIN
R.R. SOUTH
M.P. INCREASING

TO CARLISLE JCT.
R.R. NORTH
M.P. DECREASING

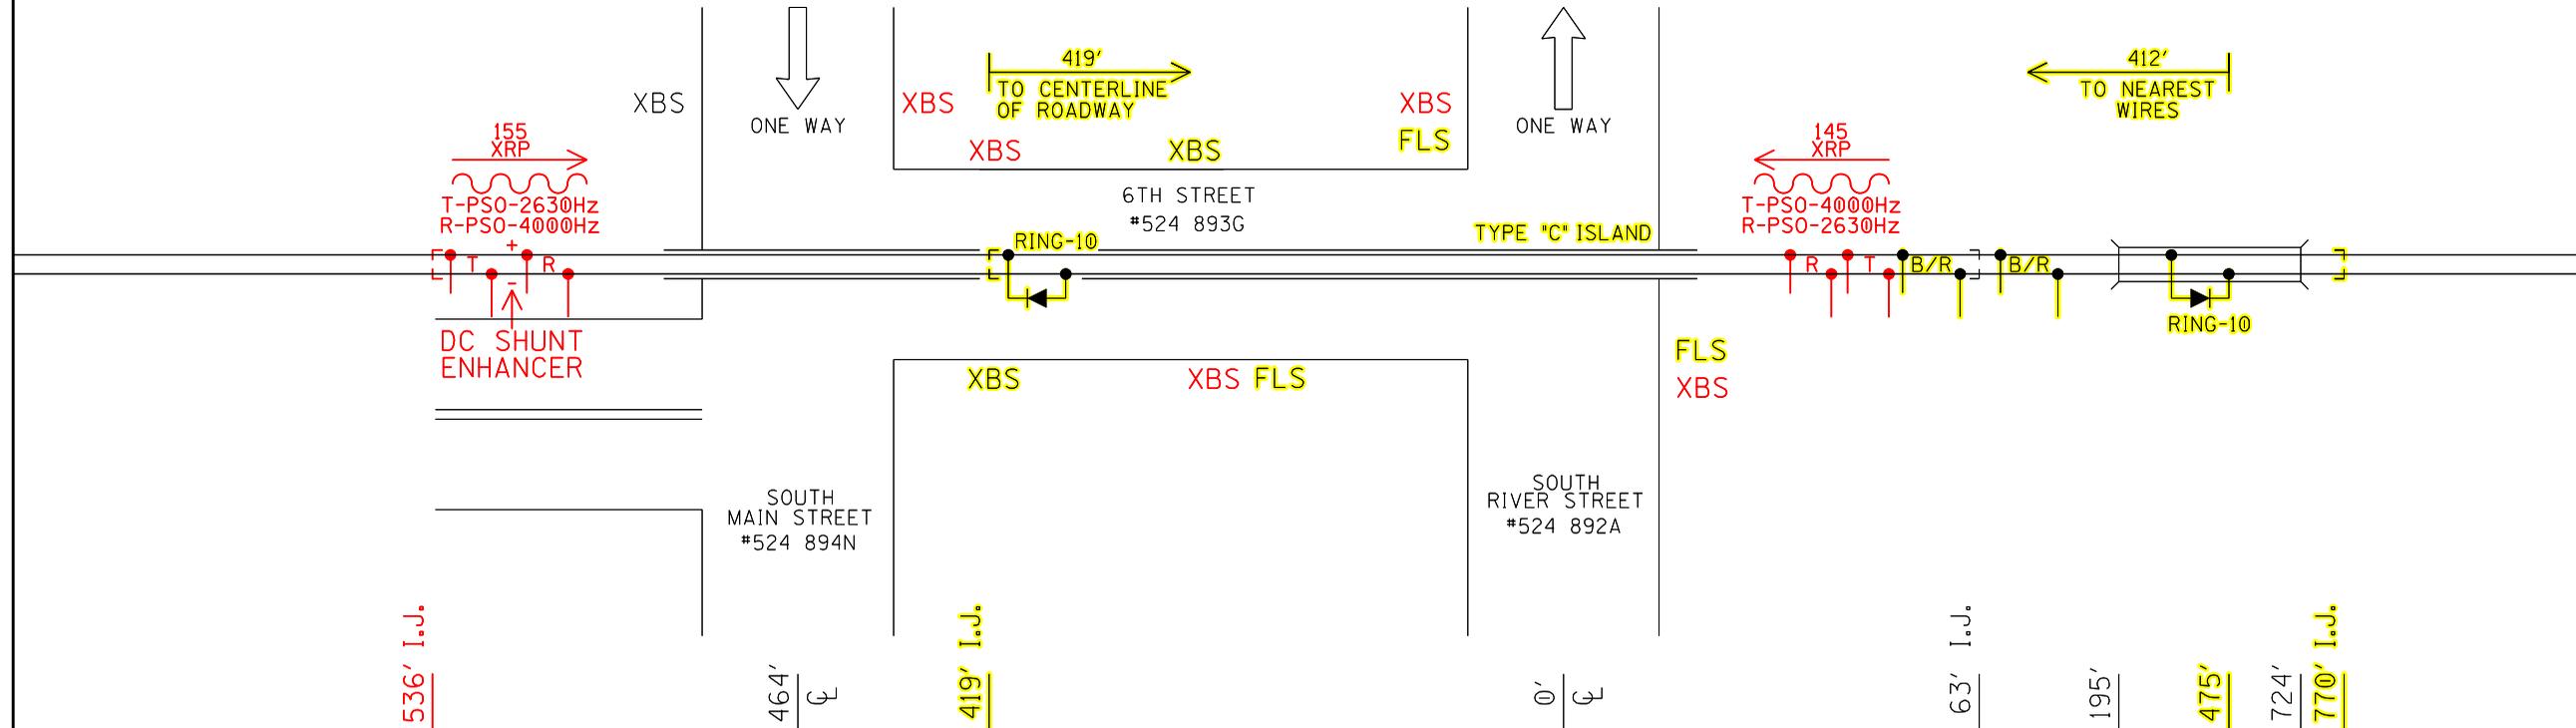

536' I.J.

464' $\frac{1}{2}$

419' I.J.

0' $\frac{1}{2}$

63' I.J.

195'

475'

724'

770' I.J.

PROJECT:
#10.3273
RED = IN
YELLOW = OUT
DESIGN: 10-12-21
PROGRESS RAIL
CHECK: XX-XX-XX
JMW

PRELIMINARY
NOT FOR
CONSTRUCTION


PROPOSED PROFILE

PROPERTY
PENNSYLVANIA R.R.

DESIGNED BY:	MST 10-12-21		OFFICE OF ASS'T. VICE PRESIDENT COMM. & SIGNAL, ATLANTA, GA.	M.P.: QD-1.45
DRAWN BY:	PRS 10-12-21			
CHECKED BY:	JMW - -	FRANKLIN, OH XBS AT SOUTH RIVER STREET		
IN SERVICE:	- -	DAYTON DISTRICT	REV. 1	
		CADD or DWG. No. 82580016.003	SHEET No. 3	

TO FRANKLIN
R.R. SOUTH
M.P. INCREASING

TO CARLISLE JCT.
R.R. NORTH
M.P. DECREASING

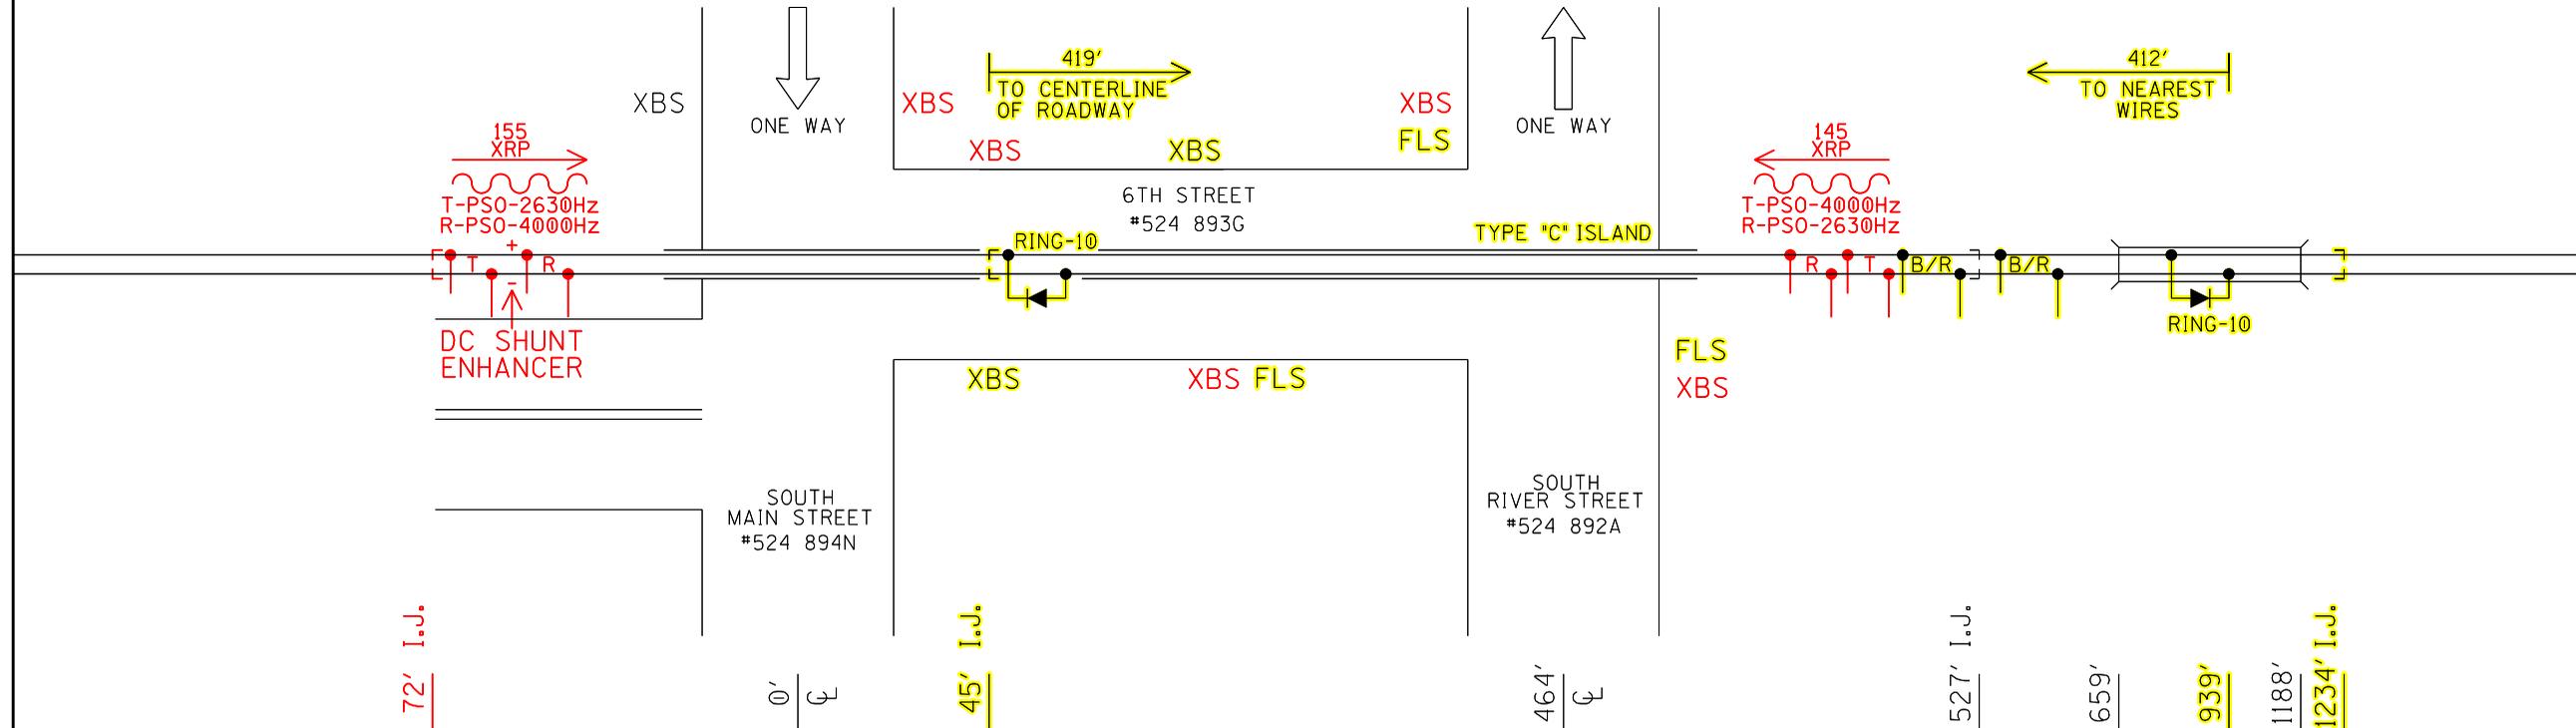

72' I.J.

0' | 9

45' I.J.

464' | 9

527' I.J.

659'

939'

1188'

1234' I.J.

PROJECT:
#10.3274
RED = IN
YELLOW = OUT
DESIGN: 10-12-21
PROGRESS RAIL
CHECK: XX-XX-XX
JMW

PRELIMINARY
NOT FOR
CONSTRUCTION


PROPOSED PROFILE

PROPERTY
PENNSYLVANIA R.R.

DESIGNED BY:	MST 10-12-21		OFFICE OF ASS'T. VICE PRESIDENT COMM. & SIGNAL, ATLANTA, GA.	M.P.: QD-1.55
DRAWN BY:	PRS 10-12-21			
CHECKED BY:	JMW - -	FRANKLIN, OH XBS AT SOUTH MAIN STREET		
IN SERVICE:	- -	DAYTON DISTRICT	REV. 1	
		CADD or DWG. No. 82580017.003	SHEET No. 3	

TO FRANKLIN
R.R. SOUTH
M.P. INCREASING

TO CARLISLE JCT.
R.R. NORTH
M.P. DECREASING

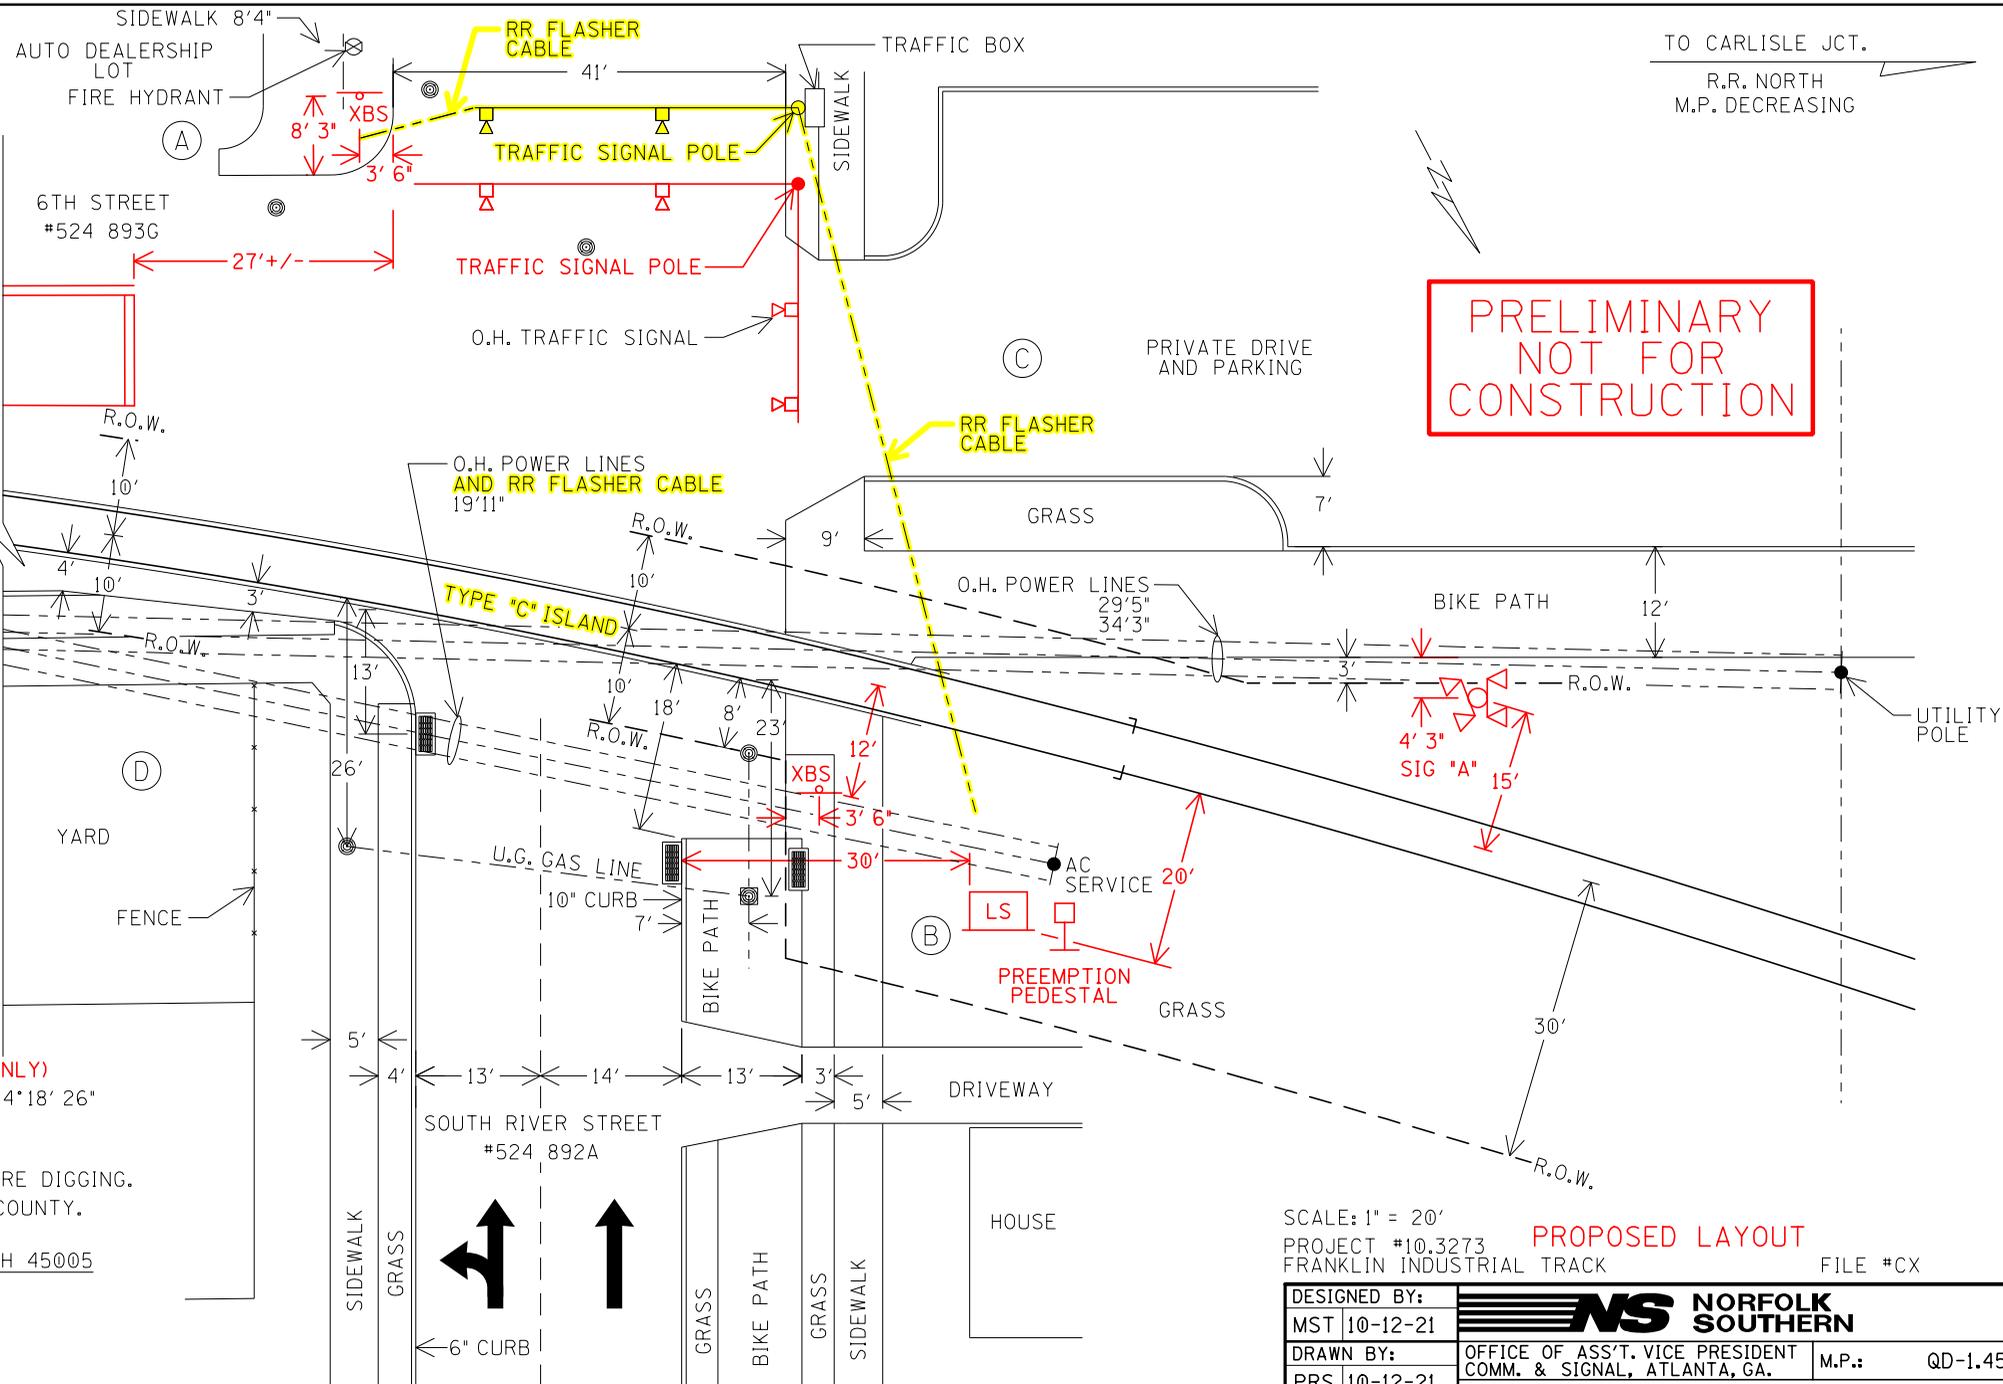

**PRELIMINARY
NOT FOR
CONSTRUCTION**

PROJECT:
#10.3273
RED = IN
YELLOW = OUT
DESIGN: 10-12-21
PROGRESS RAIL
CHECK: 01-16-25
JMW

- NOTES:
1. MAX. TRAIN SPEED 10 M.P.H. (ISLAND ONLY)
 2. LATITUDE N 39°33' 30" LONGITUDE W 84°18' 26" ELEVATION 675'
 3. SIGNAL "A" TO HAVE BELL.
 4. LOCATE U/G UTILITIES & CABLE BEFORE DIGGING.
 5. CROSSING LOCATED IN WARREN COUNTY.
 6. NEAREST STREET ADDRESS IS 528 SOUTH RIVER STREET, FRANKLIN, OH 45005
 7. NEAREST INTERSECTING STREET IS 6TH STREET
 8. DISTANCE TO NEAREST INTERSECTING STREET IS 0 FT.
 9. THIS CROSSING WILL BE PROTECTED BY TRAFFIC LIGHTS AND USE SIMULTANEOUS PREEMPTION.

(A) (B) (C) (D) = QUADRANT MARKERS


SCALE: 1" = 20'
PROJECT #10.3273
FRANKLIN INDUSTRIAL TRACK
PROPOSED LAYOUT
FILE #CX

DESIGNED BY:	NS NORFOLK SOUTHERN	
MST 10-12-21	OFFICE OF ASS'T. VICE PRESIDENT COMM. & SIGNAL, ATLANTA, GA.	M.P.: QD-1.45
DRAWN BY:	FRANKLIN, OH	
PRS 10-12-21	XBS AT SOUTH RIVER STREET	
CHECKED BY:	DAYTON DISTRICT	REV. 1
JMW 01-16-25	CADD or DWG. No. 82580016.001	SHEET 1
IN SERVICE:		

PROPERTY
PENNSYLVANIA R.R.

TO FRANKLIN
R.R. SOUTH
M.P. INCREASING

TO CARLISLE JCT.
R.R. NORTH
M.P. DECREASING

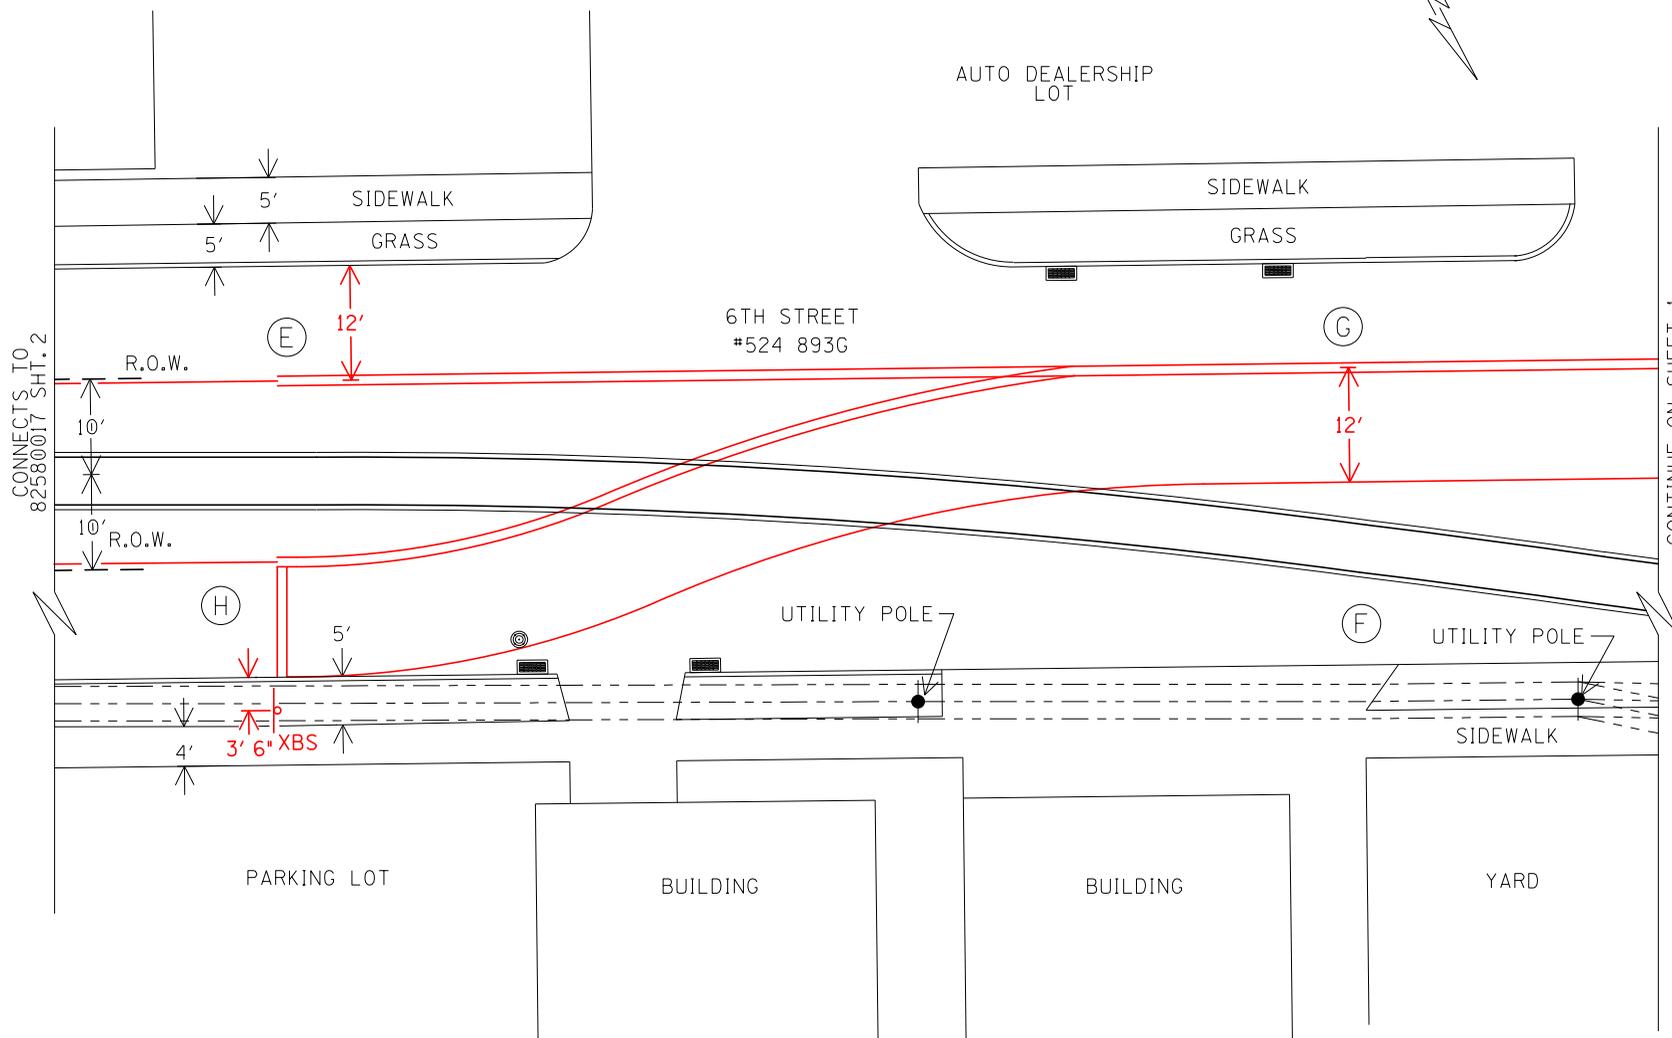

CONNECTS TO
82580017 SHT. 2

CONTINUE ON SHEET 1

NOTE:


(E) (F) (G) (H) = QUADRANT MARKERS

PROJECT:
#10.3273
RED = IN
YELLOW = OUT
DESIGN: 10-12-21
PROGRESS RAIL
CHECK: 01-16-25
JMW

PRELIMINARY
NOT FOR
CONSTRUCTION

SCALE: 1" = 20'
PROJECT #10.3273 PROPOSED LAYOUT
FRANKLIN INDUSTRIAL TRACK FILE #CX

DESIGNED BY: MST 10-12-21	NS NORFOLK SOUTHERN	
DRAWN BY: PRS 10-12-21	OFFICE OF ASS'T. VICE PRESIDENT COMM. & SIGNAL, ATLANTA, GA.	M.P.: QD-1.45
CHECKED BY: JMW 01-16-25	FRANKLIN, OH XBS AT SOUTH RIVER STREET	
IN SERVICE:	DAYTON DISTRICT	REV. 1
PROPERTY PENNSYLVANIA R.R.	CADD or DWG. No. 82580016.002	SHEET 2

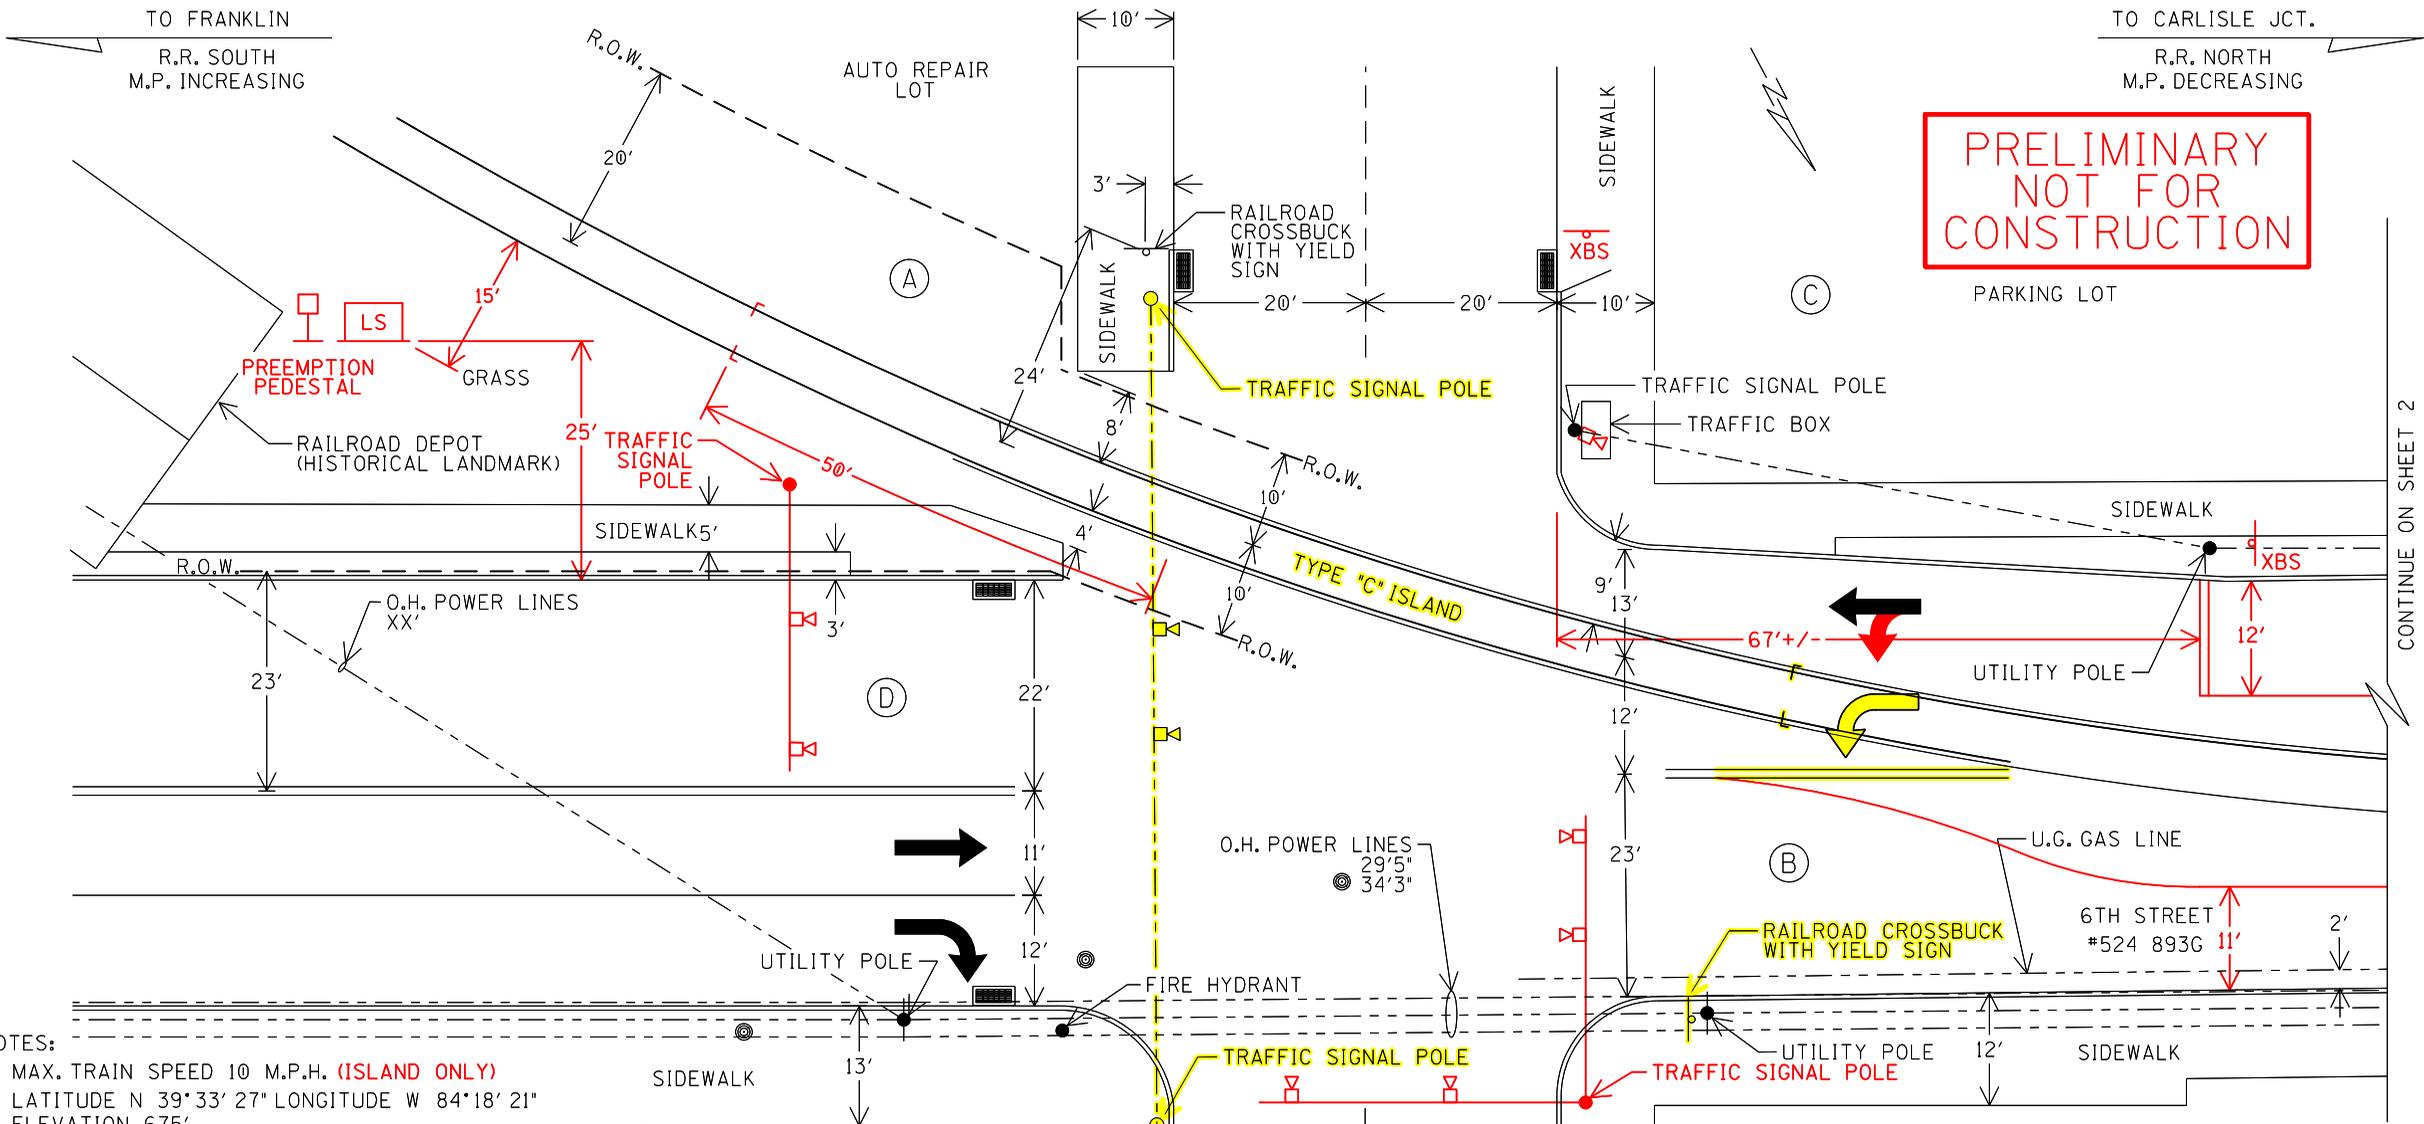

PRELIMINARY
NOT FOR
CONSTRUCTION

- NOTES:
1. MAX. TRAIN SPEED 10 M.P.H. (ISLAND ONLY)
 2. LATITUDE N 39°33' 27" LONGITUDE W 84°18' 21" ELEVATION 675'
 3. INTERSECTION HAS CROSSBUCKS WITH YIELD SIGNS.
 4. LOCATE U/G UTILITIES & CABLE BEFORE DIGGING.
 5. CROSSING LOCATED IN WARREN COUNTY.
 6. NEAREST STREET ADDRESS IS 550 SOUTH MAIN STREET, FRANKLIN, OH 45005
 7. NEAREST INTERSECTING STREET IS 6TH STREET
 8. DISTANCE TO NEAREST INTERSECTING STREET IS 0 FT.
 9. THIS CROSSING WILL BE PROTECTED BY TRAFFIC LIGHTS AND USE SIMULTANEOUS PREEMPTION.

(A) (B) (C) (D) = QUADRANT MARKERS

PROJECT:
 #10.3274
 RED = IN
 YELLOW = OUT
 DESIGN: 10-12-21
 PROGRESS RAIL
 CHECK: 01-16-25
 JMW


SCALE: 1" = 20'
 PROJECT #10.3274 **PROPOSED LAYOUT**
 FRANKLIN INDUSTRIAL TRACK FILE #CX

DESIGNED BY:	NS NORFOLK SOUTHERN	
MST 10-12-21	OFFICE OF ASS'T. VICE PRESIDENT COMM. & SIGNAL, ATLANTA, GA.	M.P.: QD-1.55
DRAWN BY:	FRANKLIN, OH	
PRS 10-12-21	XBS AT SOUTH MAIN STREET	
CHECKED BY:	DAYTON DISTRICT	
JMW 01-16-25	REV. 1	
IN SERVICE:	SHEET 1	
PROPERTY PENNSYLVANIA R.R.	CADD or DWG. No. 82580017.001	REV. 1 SHEET 1

CONTINUE ON SHEET 2

TO FRANKLIN
R.R. SOUTH
M.P. INCREASING

TO CARLISLE JCT.
R.R. NORTH
M.P. DECREASING

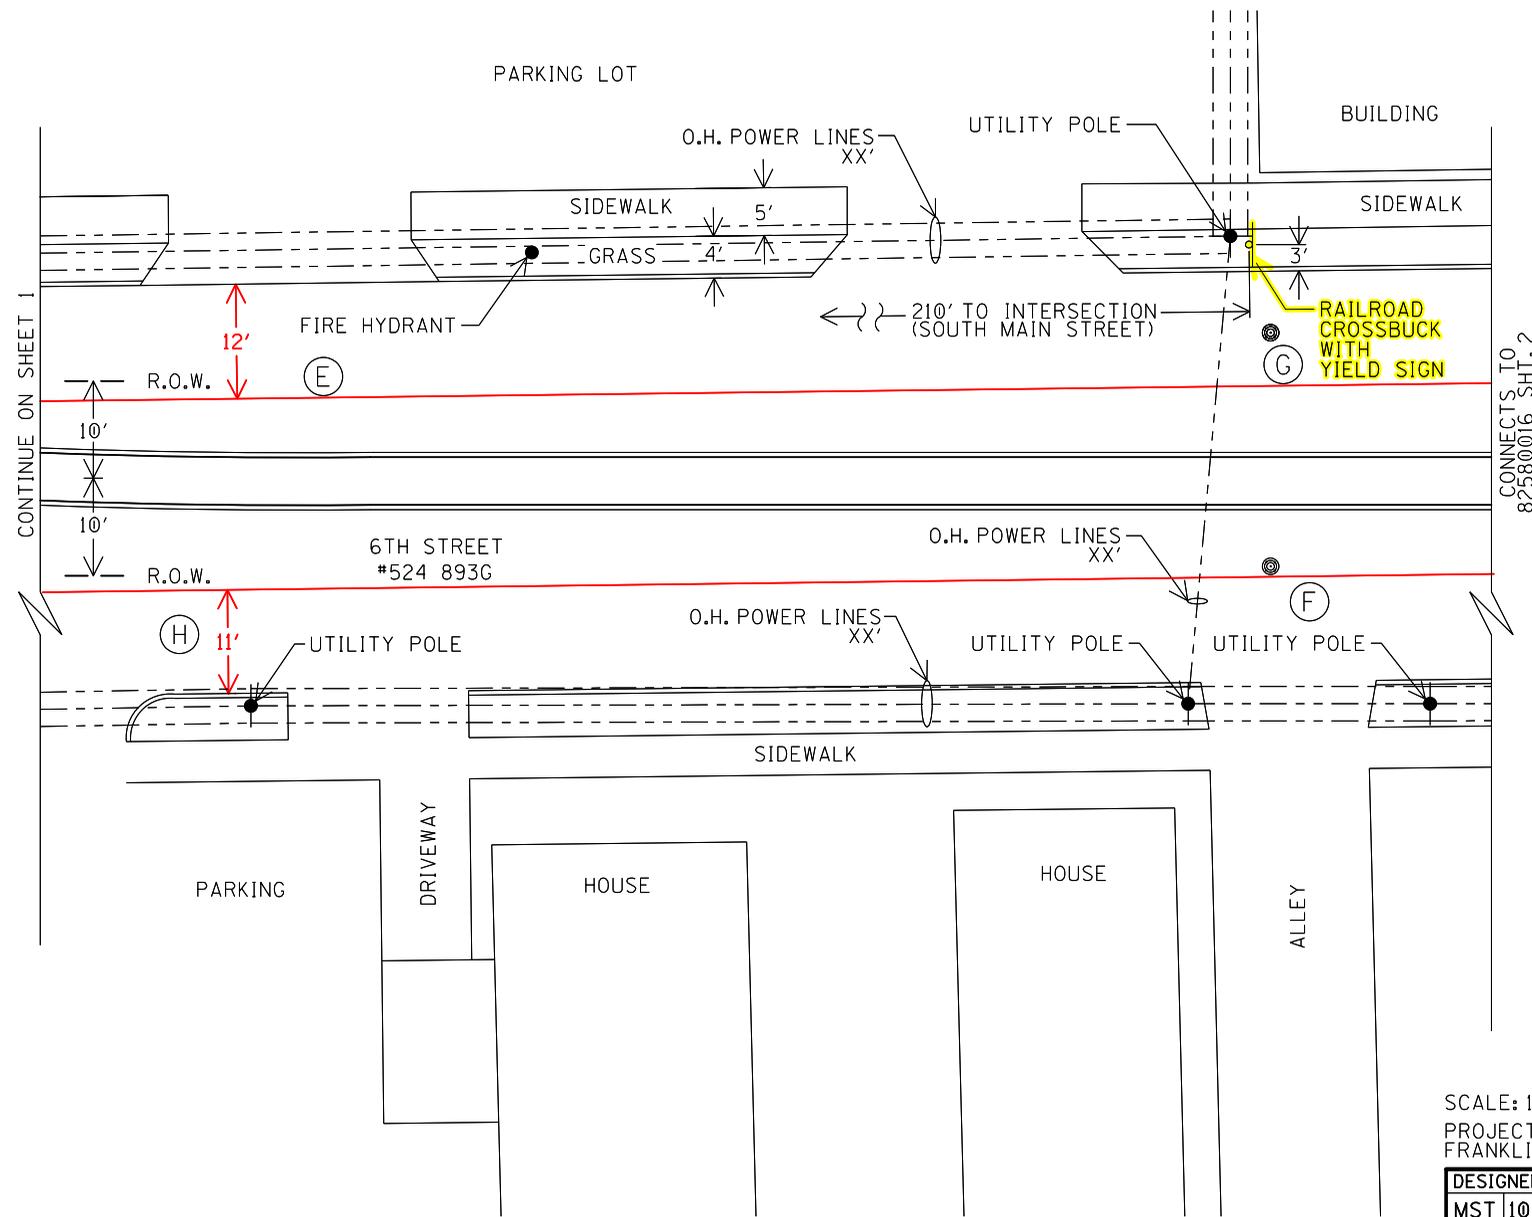

PRELIMINARY
NOT FOR
CONSTRUCTION

PROJECT:
#10.3274
RED = IN
YELLOW = OUT
DESIGN: 10-12-21
PROGRESS RAIL
CHECK: 01-16-25
JMW

SCALE: 1" = 20'
PROJECT #10.3274
FRANKLIN INDUSTRIAL TRACK
PROPOSED LAYOUT
FILE #CX

NOTE:
E F G H = QUADRANT MARKERS

PROPERTY
PENNSYLVANIA R.R.

DESIGNED BY: MST 10-12-21	NS NORFOLK SOUTHERN	
DRAWN BY: PRS 10-12-21	OFFICE OF ASS'T. VICE PRESIDENT COMM. & SIGNAL, ATLANTA, GA.	M.P.: QD-1.55
CHECKED BY: JMW 01-16-25	FRANKLIN, OH XBS AT SOUTH MAIN STREET	
IN SERVICE:	DAYTON DISTRICT	REV. 1
	CADD or DWG. No. 82580017.002	SHEET 2