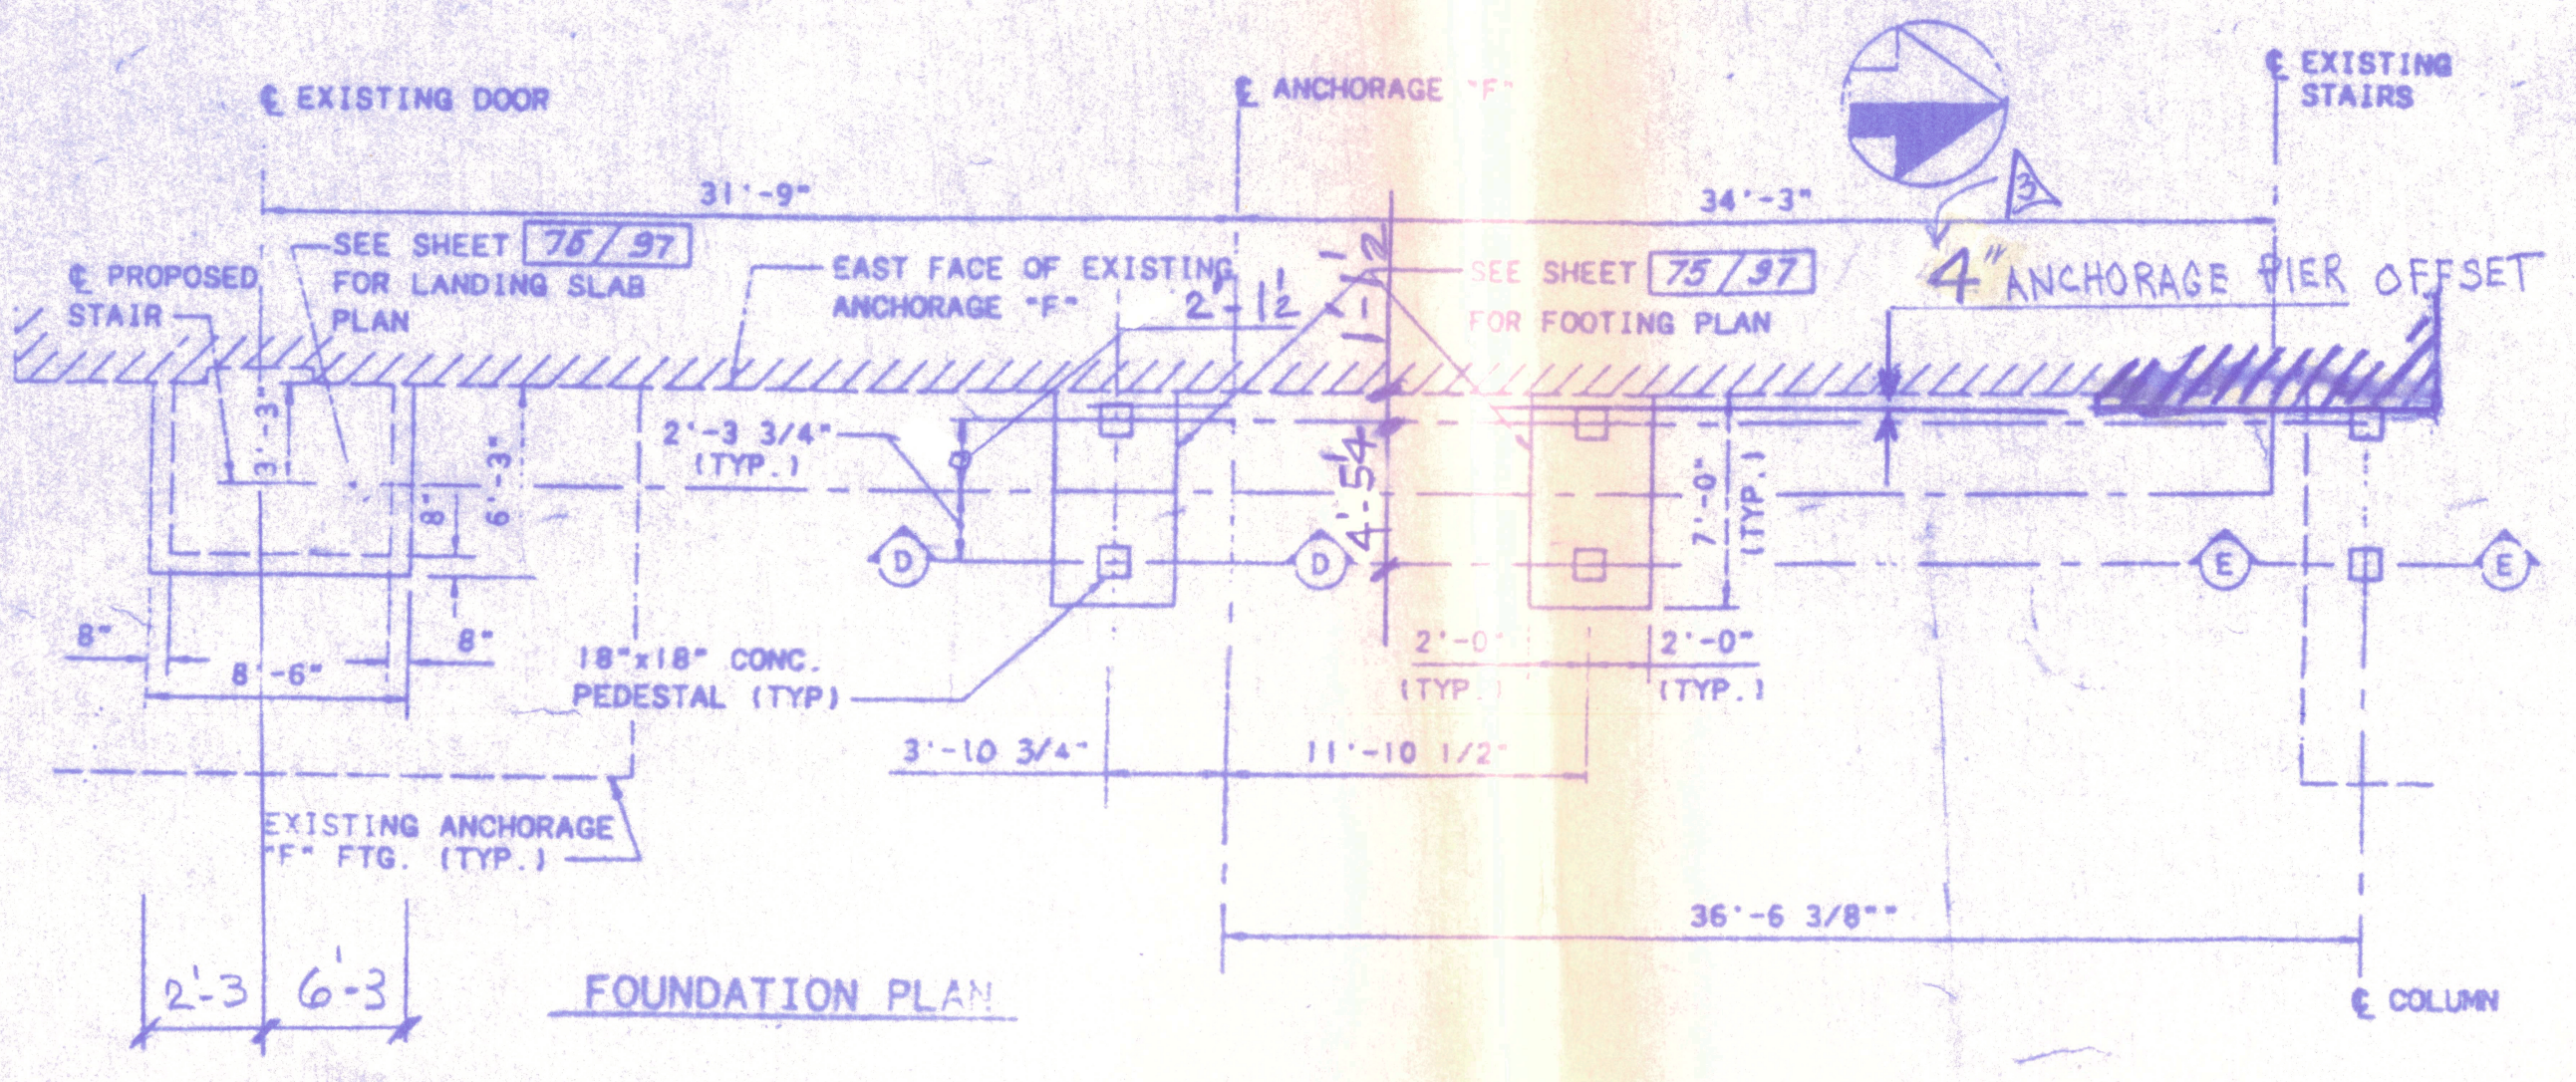

FOUNDATION PLAN

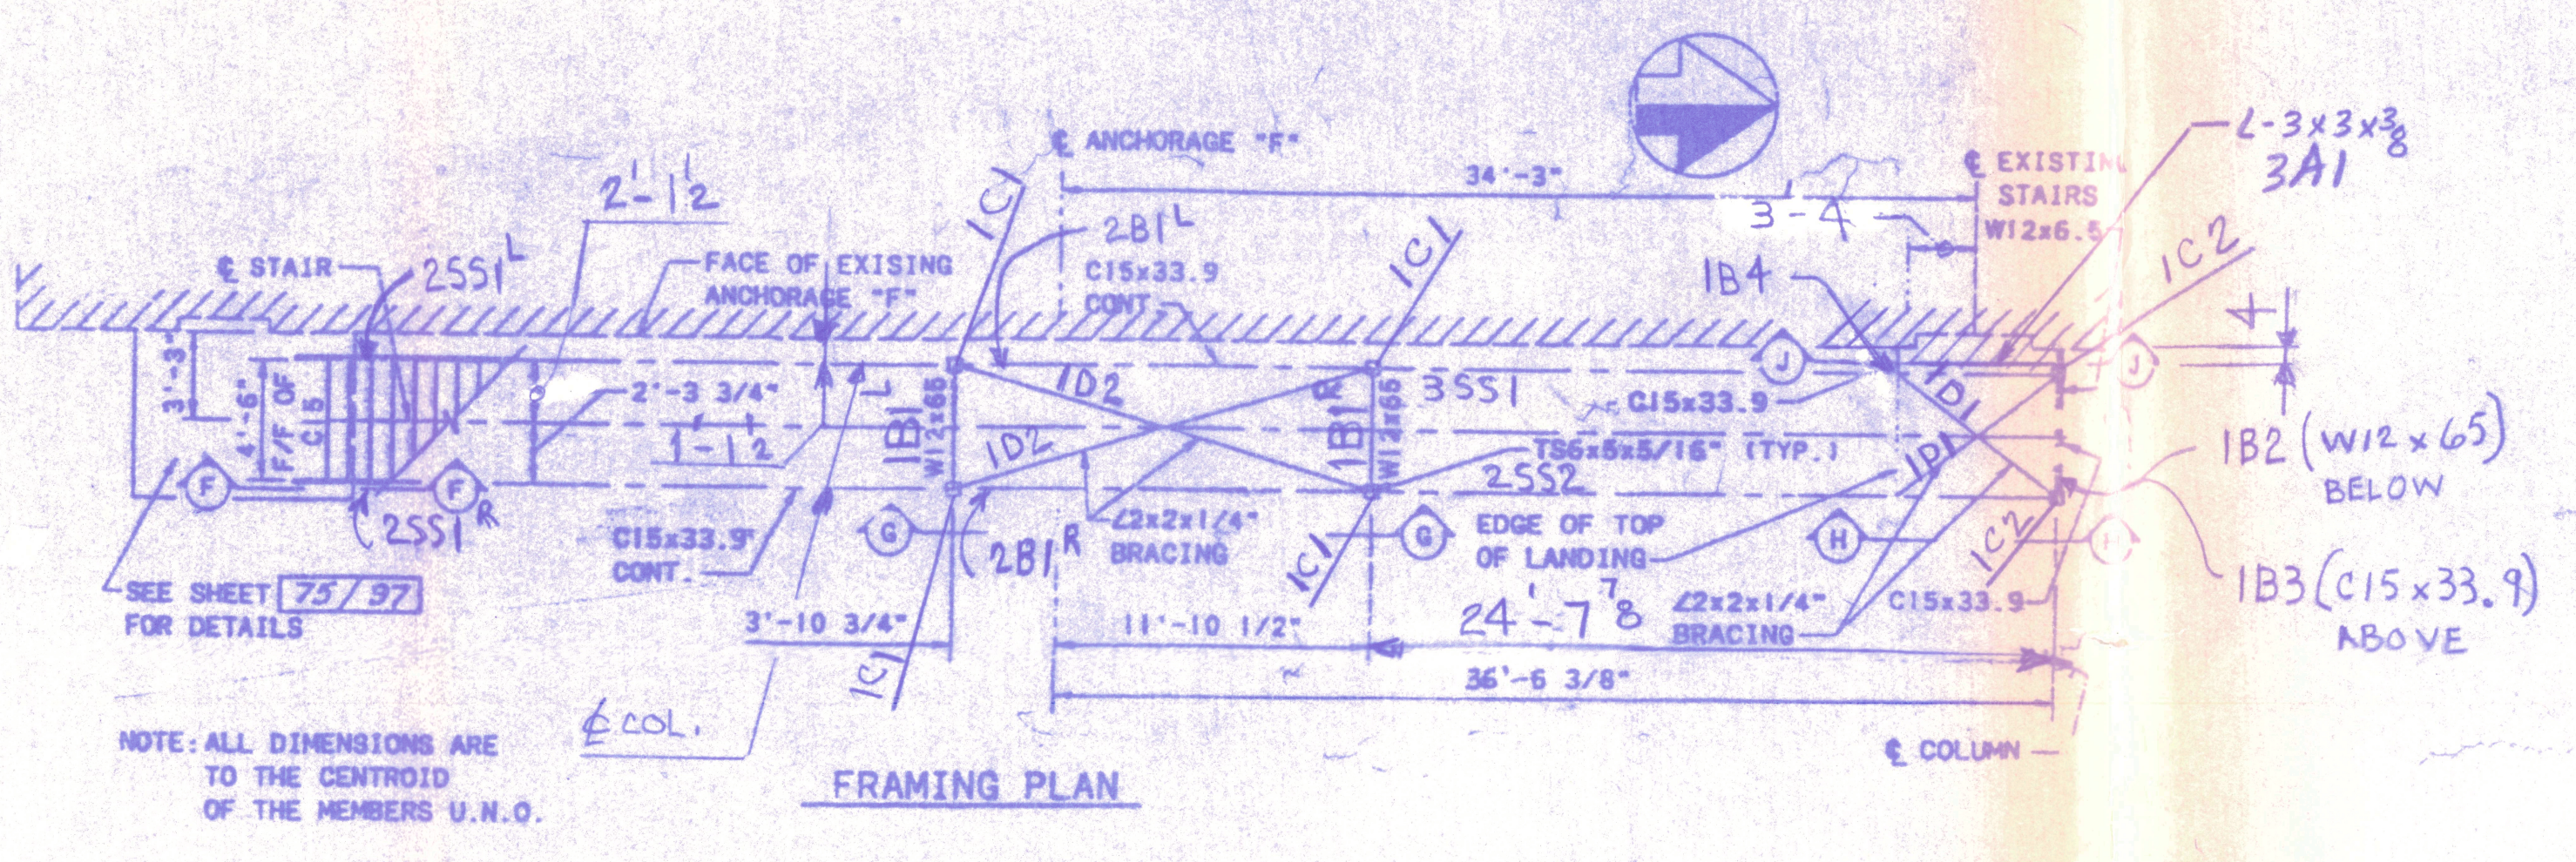

NOTE: ALL DIMENSIONS ARE TO THE CENTROID OF THE MEMBERS U.N.O.

FRAMING PLAN

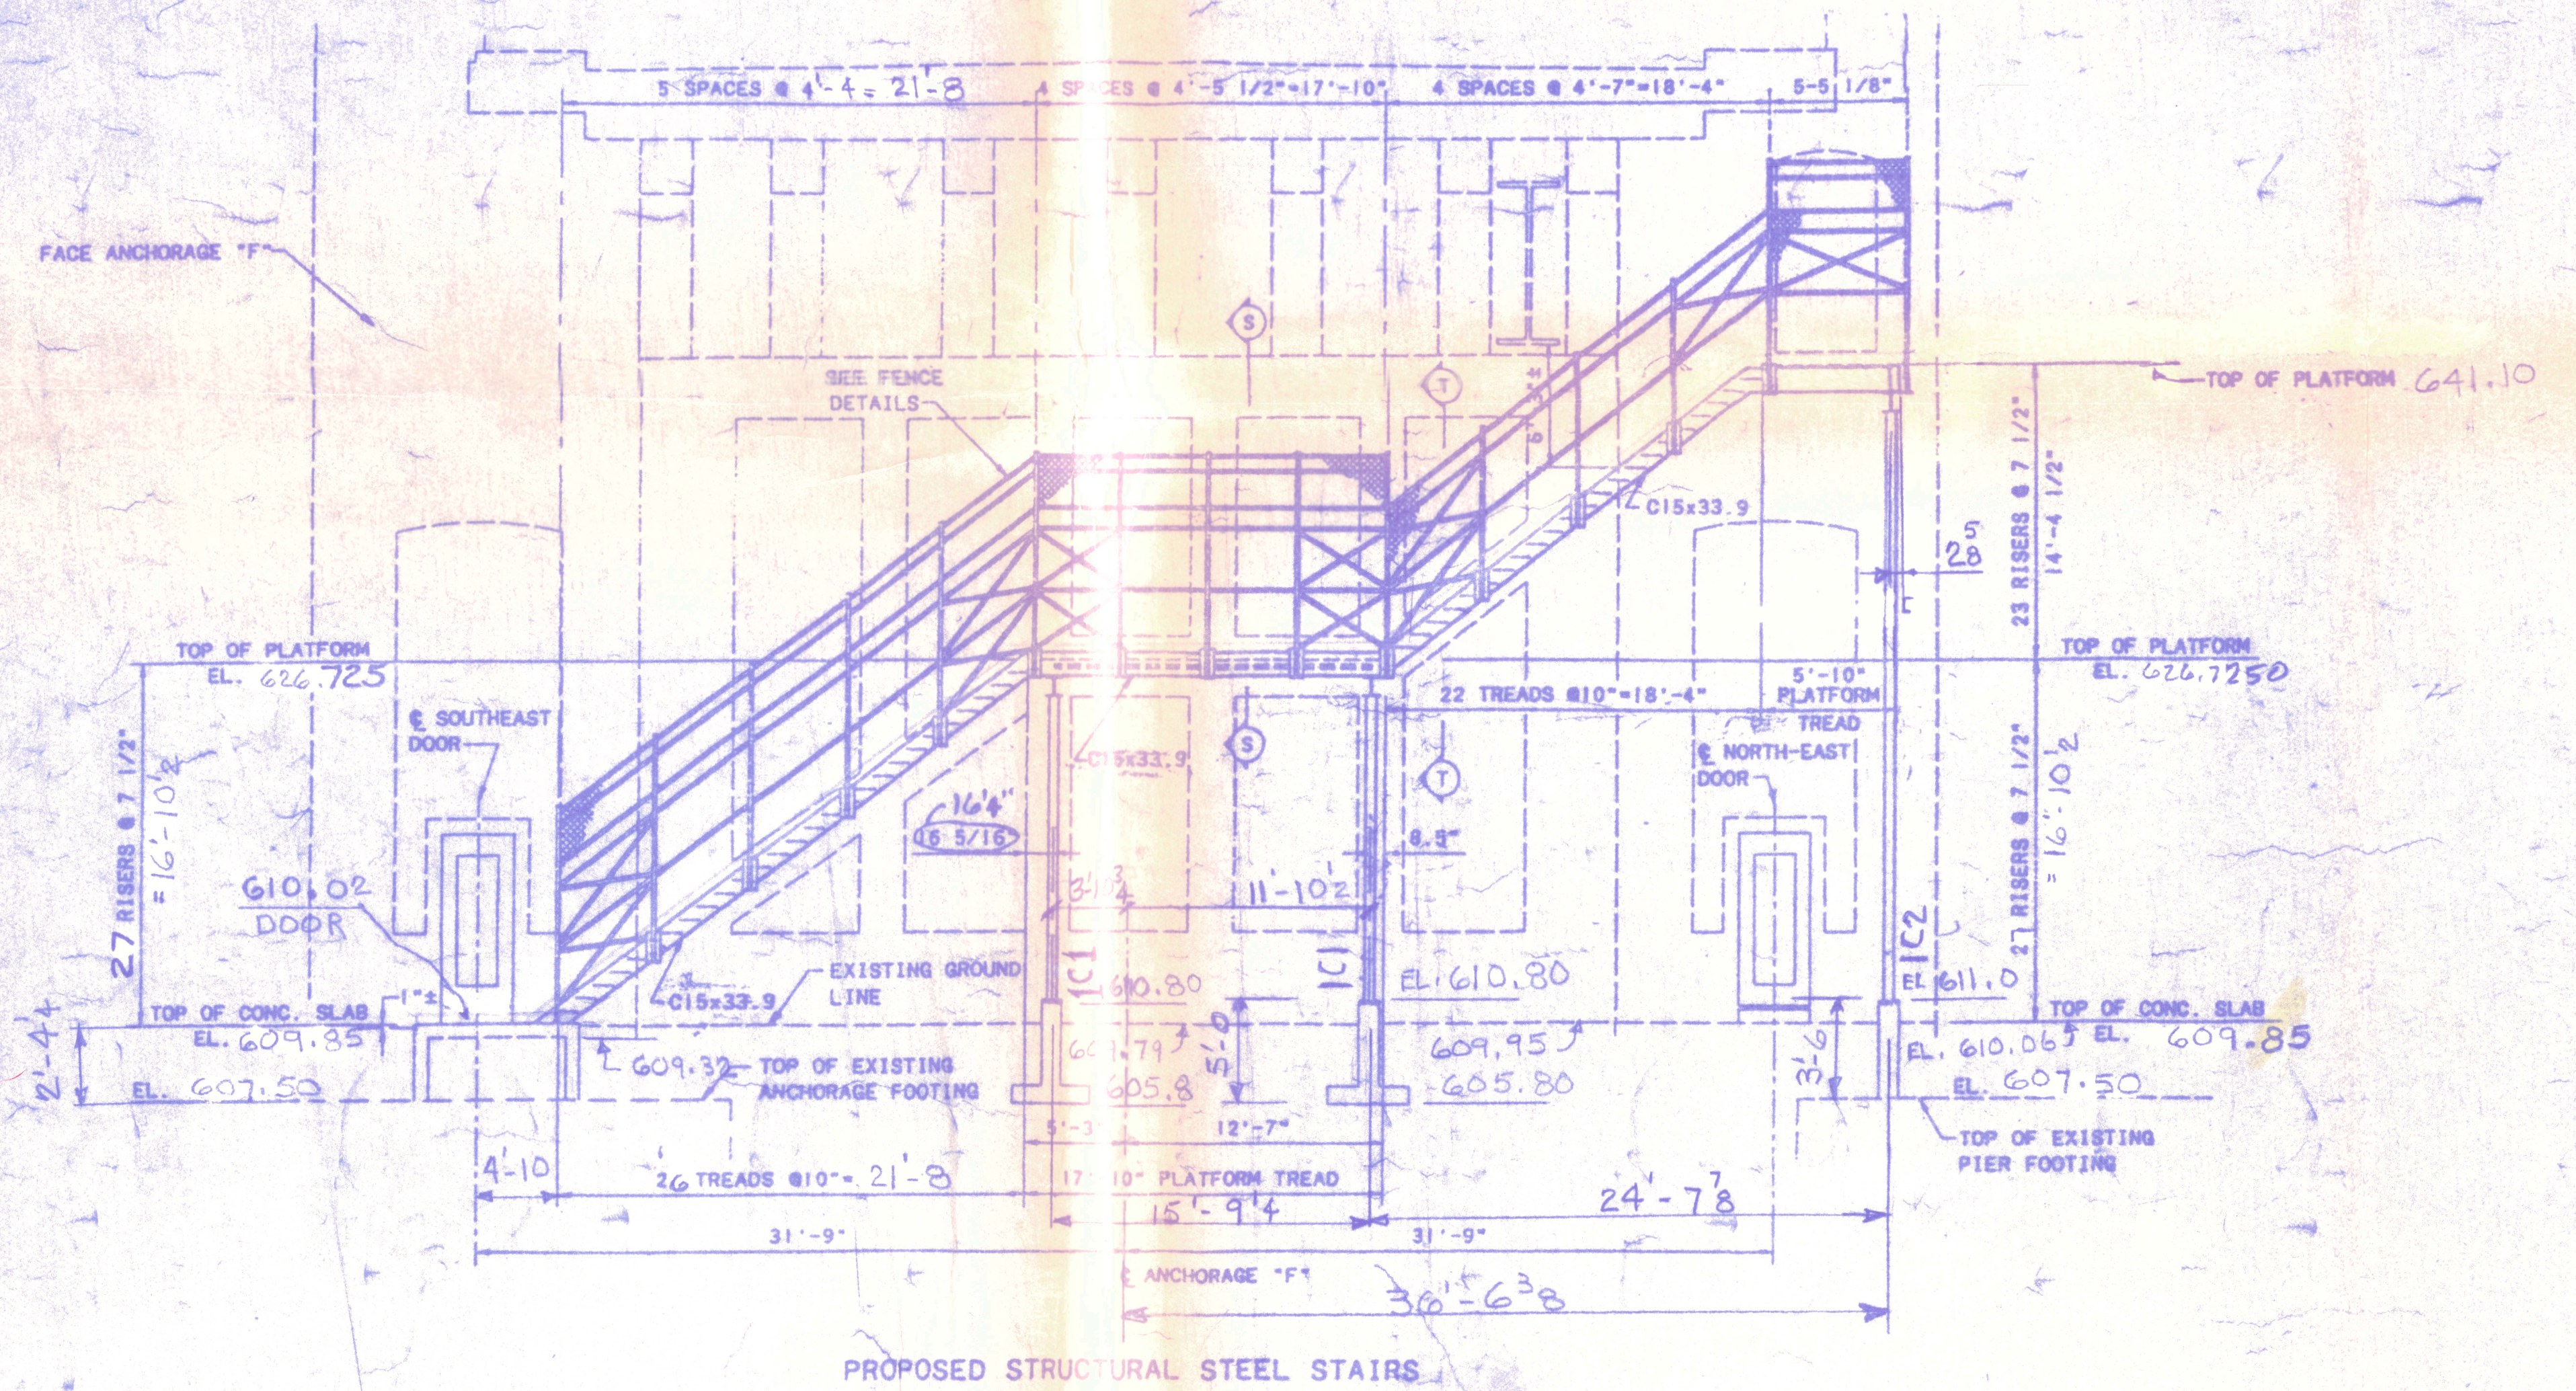

PROPOSED STRUCTURAL STEEL STAIRS
GENERAL ELEVATION

Alpine Tech. Services Inc.
270-B Saxonburg Blvd.
Cheswick, PA. 15024
(412) 767-4966

1350

NO.	DATE	BY	DESCRIPTION
2	11/5/97	ATS	APP. 10/20/97 CH
1	9/12/97	ATS	REV. OF 8/12/97

REVISION

DISTRICT 2
PRODUCTION OFFICE
Bernadette J. Barth, P.E., Administrator
ACCEPTED JTB ACCEPTED AS NOTED
for construction, fabrication or manufacture per Section 105.02 of the construction and materials specifications.
NOT ACCEPTED District II DATE 3/2/98
OFFICE COPY

custom steel products, inc.

CUSTOMER AMERICAN BRIDGE CO - LJC 772 (96) REF 108 ITEM 530				
DESCRIPTION STEEL - ARRG'T.				
MADE ATS	DATE	CONTRACT	SEQ.	DRAWING	REV.
CHECKED B	DATE	97-137		E1	3