O.D.O.T. DISTRICT 2 SURVEY OFFICE (USE ONLY)

PERSONNEL

NOTES NIESE
H.C. RHOADES
R.C.

DWG BY NIESE

REFERENCE NO. 15

DATE 3/12/21
WEATHER SUNNY
TEMP. 50°

PID PAVE TRAIN

SHEET 23 OF 25

ROUTE SR 109
COUNTY HENRY
TOWNSHIP MONROE
SECTION 34
T 4 N R 7 E

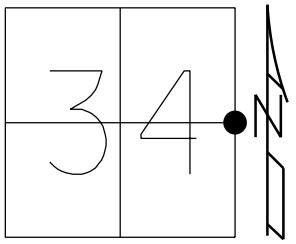

TYPE MONUMENT P.K.NAIL
~~ON SURFACE~~ - BELOW 1/2"
OFFSET ℄ PAVEMENT 7.5' LT : ~~RT~~
2.1' TO LT EDGE PAVEMENT
STATION: 344+03

HORZ.DATUM: NAD83 2011
GEOID: NAVD88 2012A
GRID: NORTHING: 584682.087
EASTING: 1546062.452

RECORD:
FD P.K./WASHER
5/18/98, MC
FD SM.R.R.SPIKE
SET SM.R.R.SPIKE
9/28/98, MDB
FD P.K.NAIL
0.5' DOWN
2/25/19, JLL
REF15
6/9/20, JFO
3/12/21, JMR
12/2/21, DSA

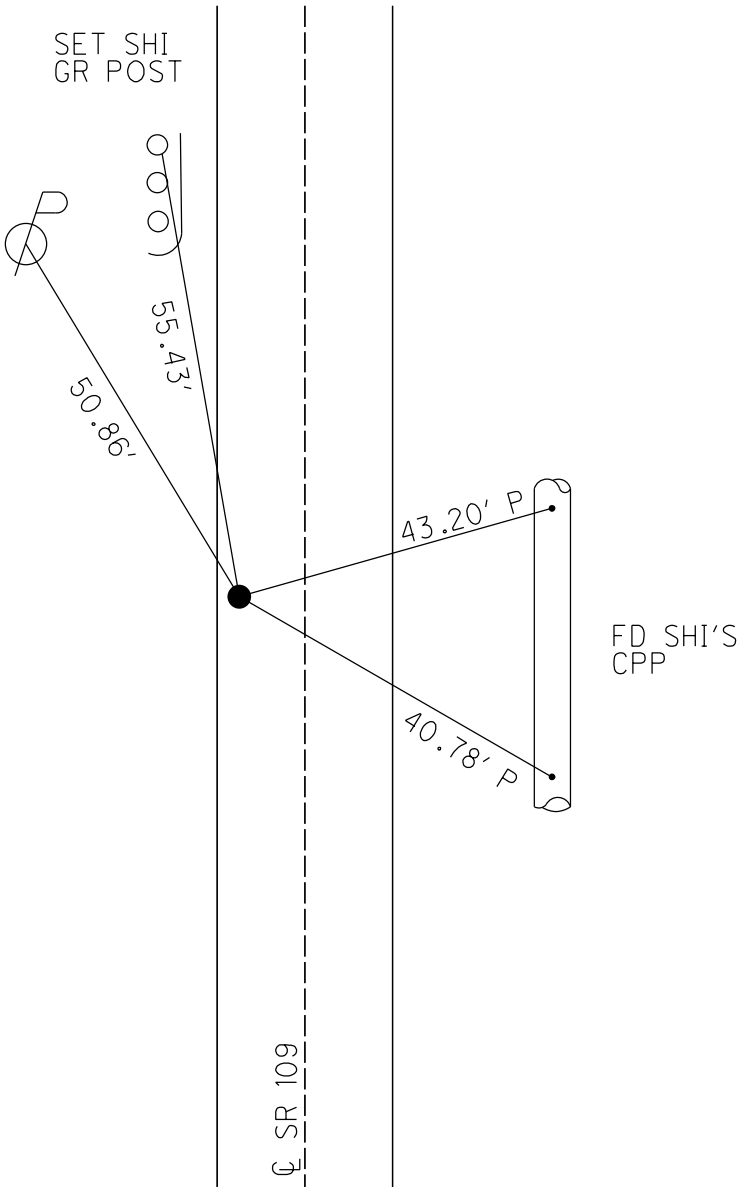

O.D.O.T. DISTRICT 2 SURVEY OFFICE (USE ONLY)

PERSONNEL

NOTES NIESE
H.C. RHOADES
R.C. _____

DWG BY NIESE

REFERENCE NO. 15

DATE 3/12/21
WEATHER SUNNY
TEMP. 50°

PID PAVE TRAIN

SHEET 23 OF 25

ROUTE SR 109
COUNTY HENRY
TOWNSHIP MONROE
SECTION 34
T 4 N R 7 E

TYPE MONUMENT P.K.NAIL
~~ON SURFACE~~ - BELOW 1/2"
OFFSET ℄ PAVEMENT 7.5' LT : ~~RT~~
2.1' TO LT EDGE PAVEMENT
STATION: 344+03

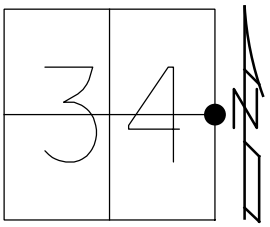

HORZ.DATUM: NAD83 2011
GEOID: NAVD88 2012A
GRID: NORTHING: 584682.087
EASTING: 1546062.452

RECORD:
FD P.K./WASHER
5/18/98, MC
FD SM.R.R.SPIKE
SET SM.R.R.SPIKE
9/28/98, MDB
FD P.K.NAIL
0.5' DOWN
2/25/19, JLL
REF15
6/9/20, JFO
3/12/21, JMR

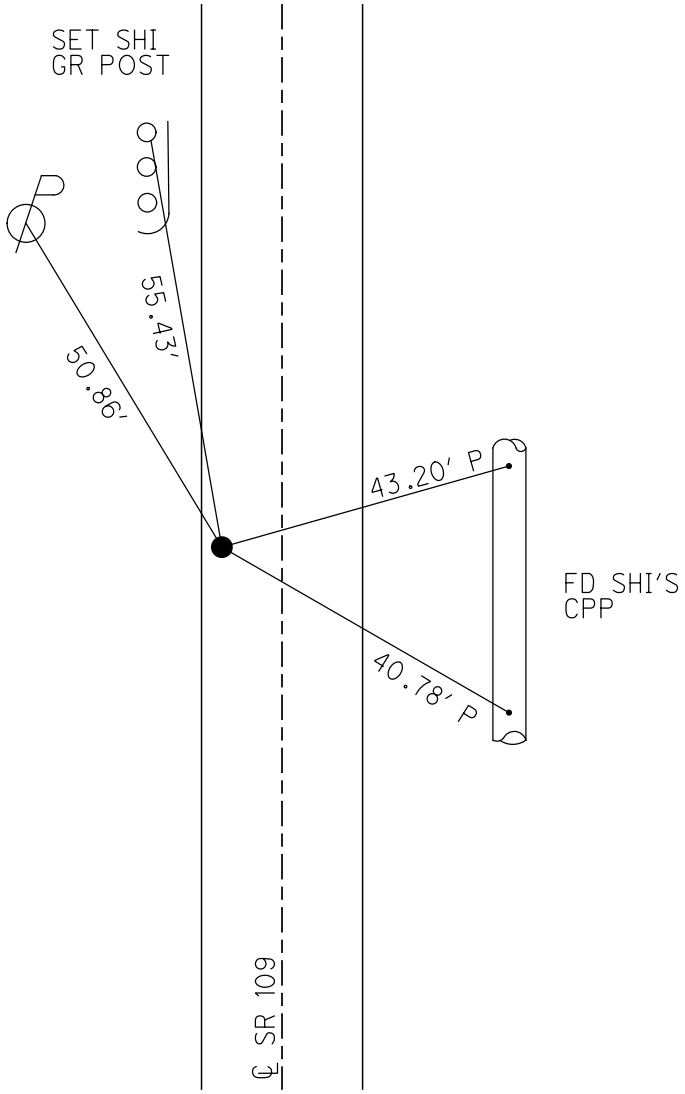

O.D.O.T. DISTRICT 2 SURVEY OFFICE (USE ONLY)

PERSONNEL

NOTES CANTERBURY
H.C. ROUSOS
R.C. HUSS

REFERENCE NO. 15 SHEET 23 OF 26

DATE 05-18-1998
WEATHER SUNNY
TEMP. 80°F

ROUTE SR 109
COUNTY HENRY
TOWNSHIP MONROE
SECTION 34
T 4 N R 7 E

TYPE MONUMENT PK & WASHER
ON SURFACE - ~~BELOW~~ ON
LEFT - ℄ PAV'T - ~~RIGHT~~ 7.5'
2.1' TO LT EDGE PAVEMENT
S.L.M. 344+03
Grid: Northing: _____ Easting: _____

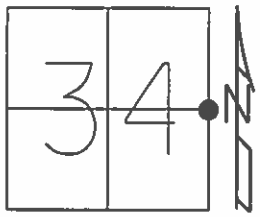

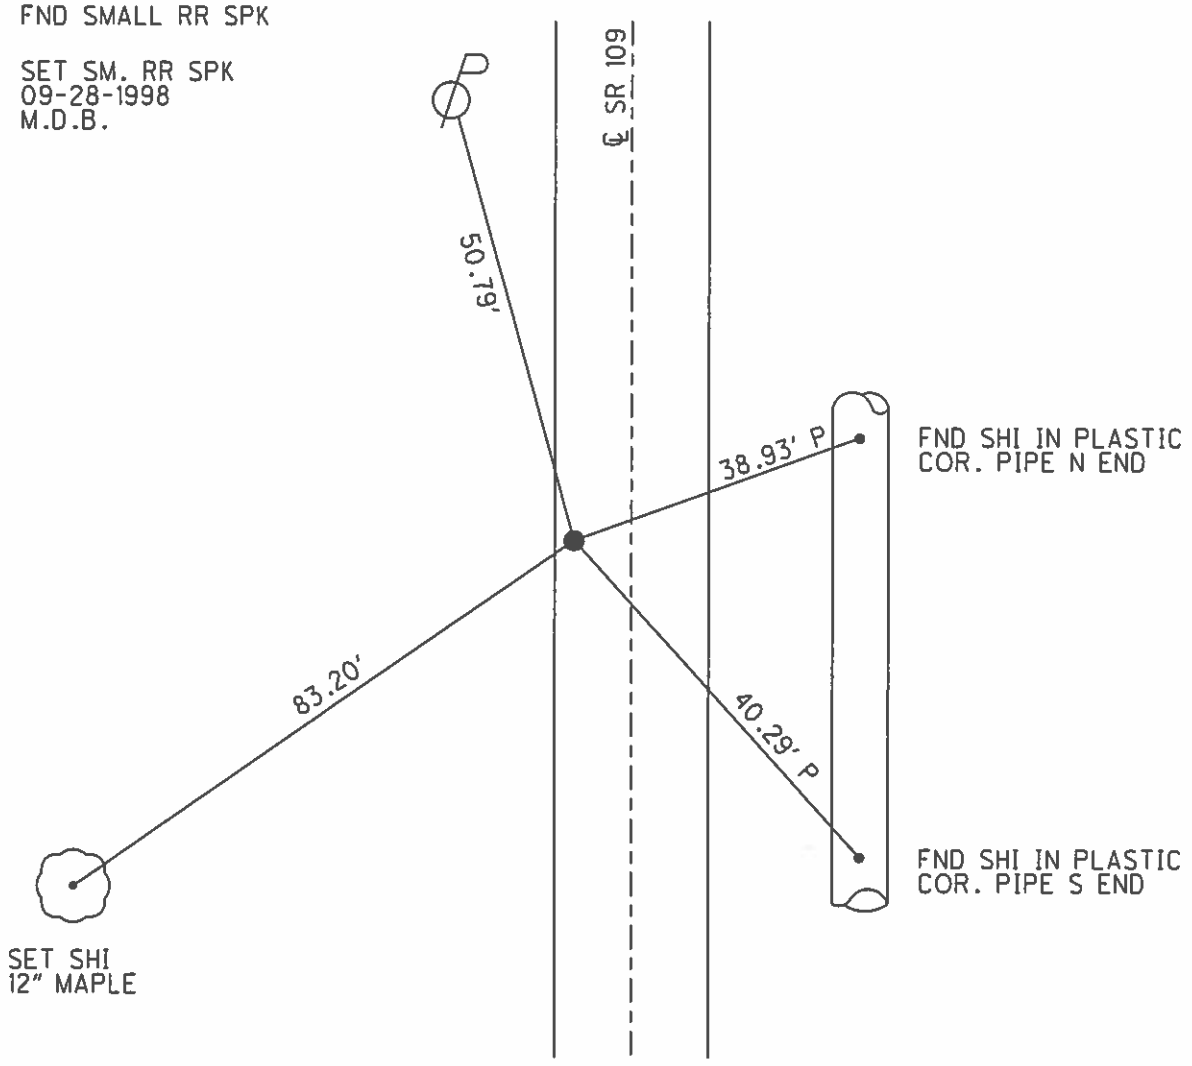

O.D.O.T. DISTRICT 2 SURVEY OFFICE

PERSONNEL

NOTES Canterbury
H.C. Rouse
R.C. Huss

REFERENCE NO. 15

DATE 5-18-98
WEATHER Sunny
TEMP. +80°F

SHEET 18 OF 21

ROUTE 109
COUNTY HENRY
TOWNSHIP Monroe
SECTION 34
T 4 N R 7 E

TYPE MONUMENT P.K & Washer
ON SURFACE - ~~BELOW~~ Surface
LEFT - ~~℄ PAV'T. RIGHT~~ 7.5 L of ℄ Pvmt
2.1 TO Lt EDGE PAVEMENT
S.L.~~M~~. 10+467 SLK (Sta 344+03 Sm)

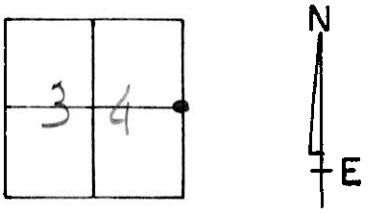

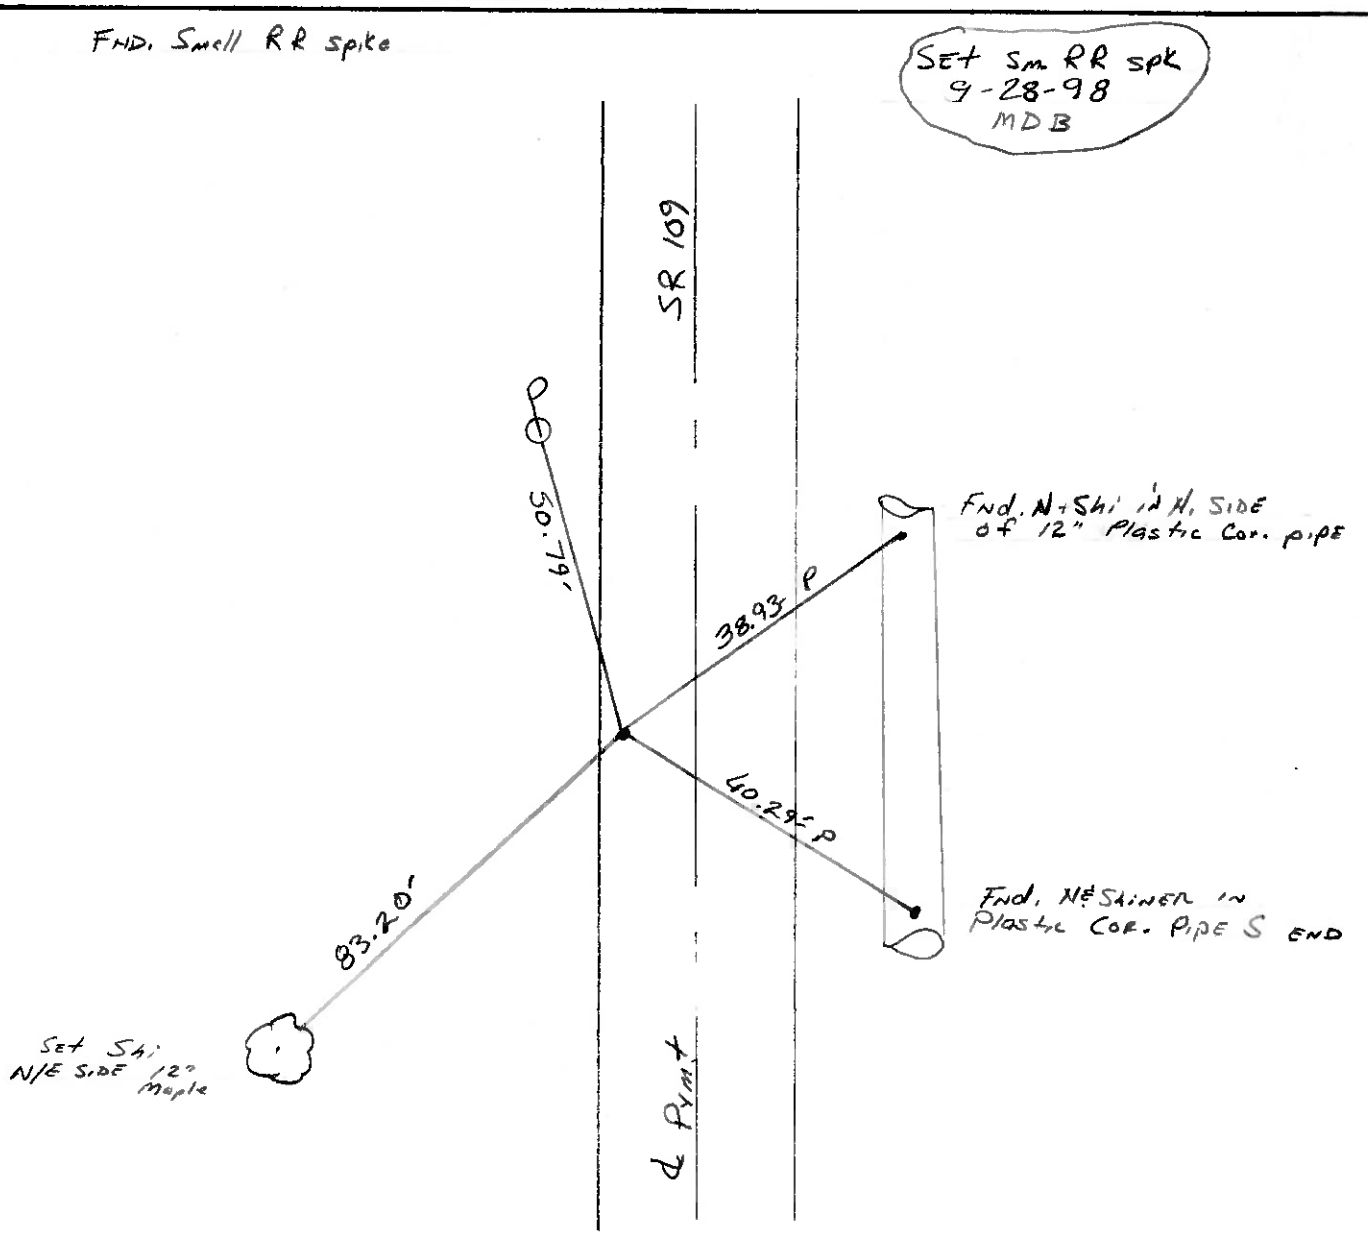

DRAWN BY TR

O.D.O.T. DISTRICT 2 SURVEY OFFICE

PERSONNEL
NOTES Barnhisel
H.C. " "
R.C. Loeheke

REFERENCE NO. 15 SHEET 18 OF ____

DATE 3-30-89
WEATHER Rain
TEMP. +40°

ROUTE 109
COUNTY Henry
TOWNSHIP Monroe
SECTION 34
T 4 N R 7 E

TYPE MONUMENT P.K. & Washer
ON SURFACE - ~~BELOW~~ Yes
LEFT - ℄ PAV'T. - ~~RIGHT~~ 7.5
L.T. TO Lt. EDGE PAVEMENT
S.L.M. 394+03

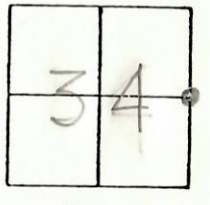

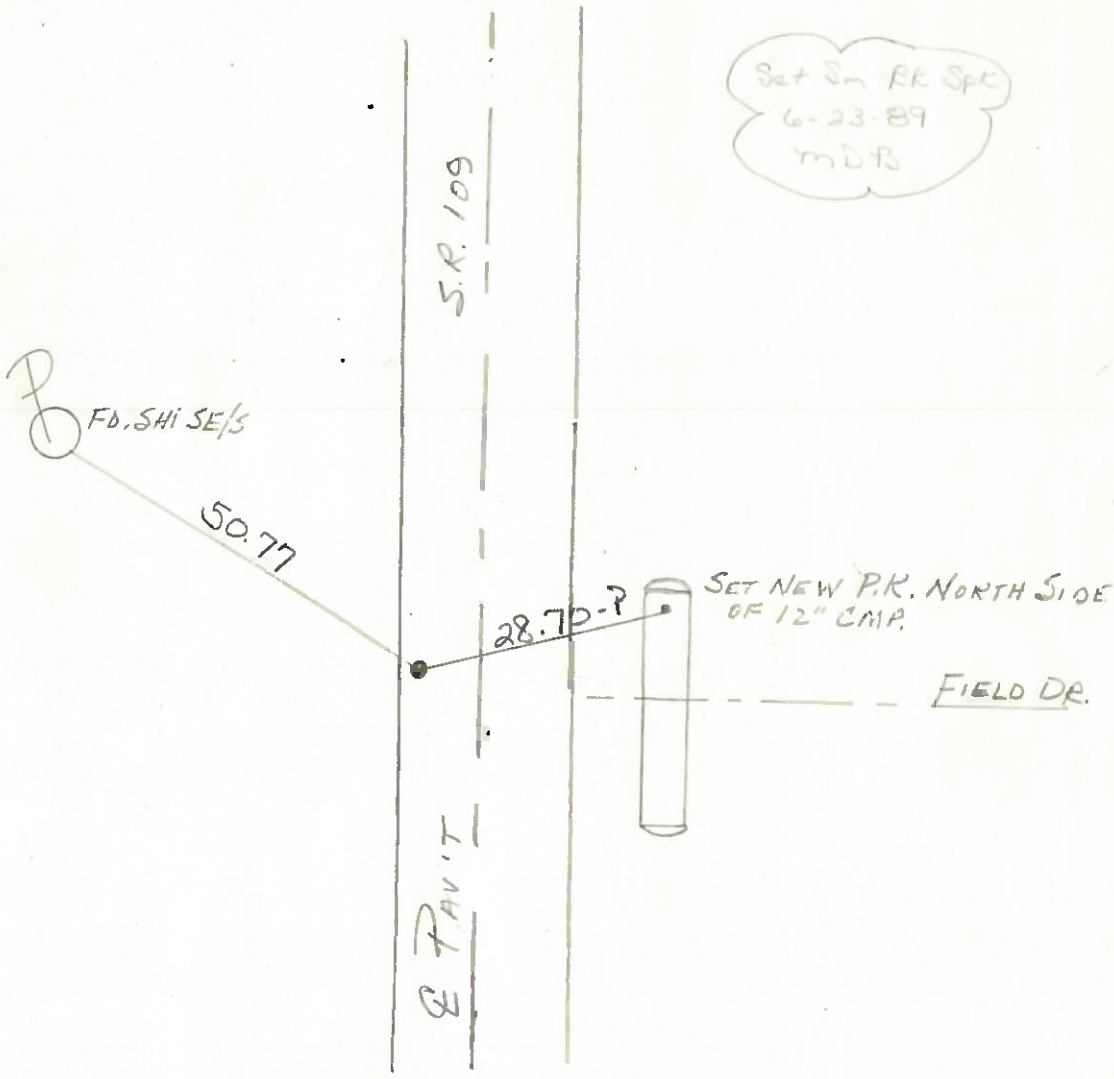

O.D.O.T. DISTRICT 2 SURVEY OFFICE

SHEET____ OF____

County HENRY S.R. 109
Township MONROE
Section 34
T4N, R7E
Personnel HOFFMAN
LOEHRKE
DARNHISEL
#15

Date APRIL 26, 83
Weather CLEAR
Temp. +65°

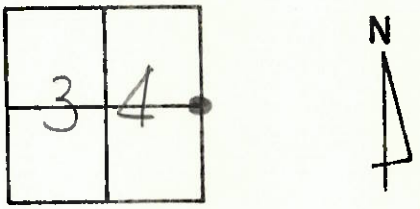

Fd R.R. Spike surface, set by County
7.9' Lt. of ℄ Paut.
~~1.8' to Nt. EP.~~
4.5' EAST of WEST E.P.

SLM 343+32
SET P.K./WASHER
9-19-83
SWH

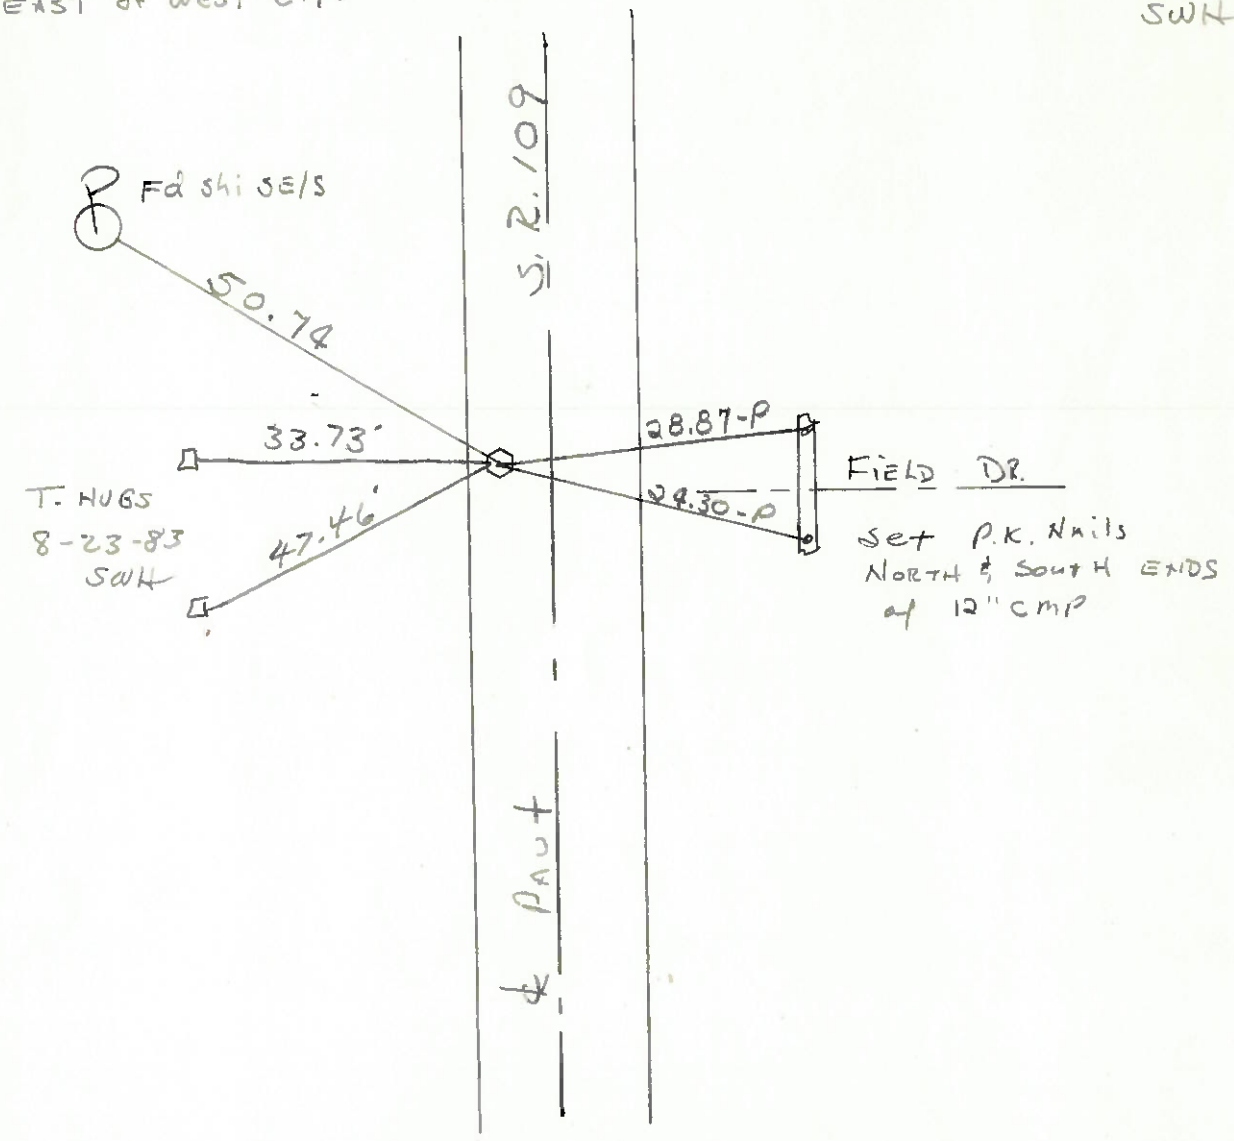

LD-5-(25M—2-59)

SHEET NO. 4

PERSONNEL	TITLE	PERSONNEL	TITLE
Tomsic			
Neusel			
Smith			
[illegible]			

COUNTY Henry DATE Nov. 1, 1973

S. R. 109 WEATHER

SEC. Monroe Twp. TEMP

DESCRIPTION JOB NO.
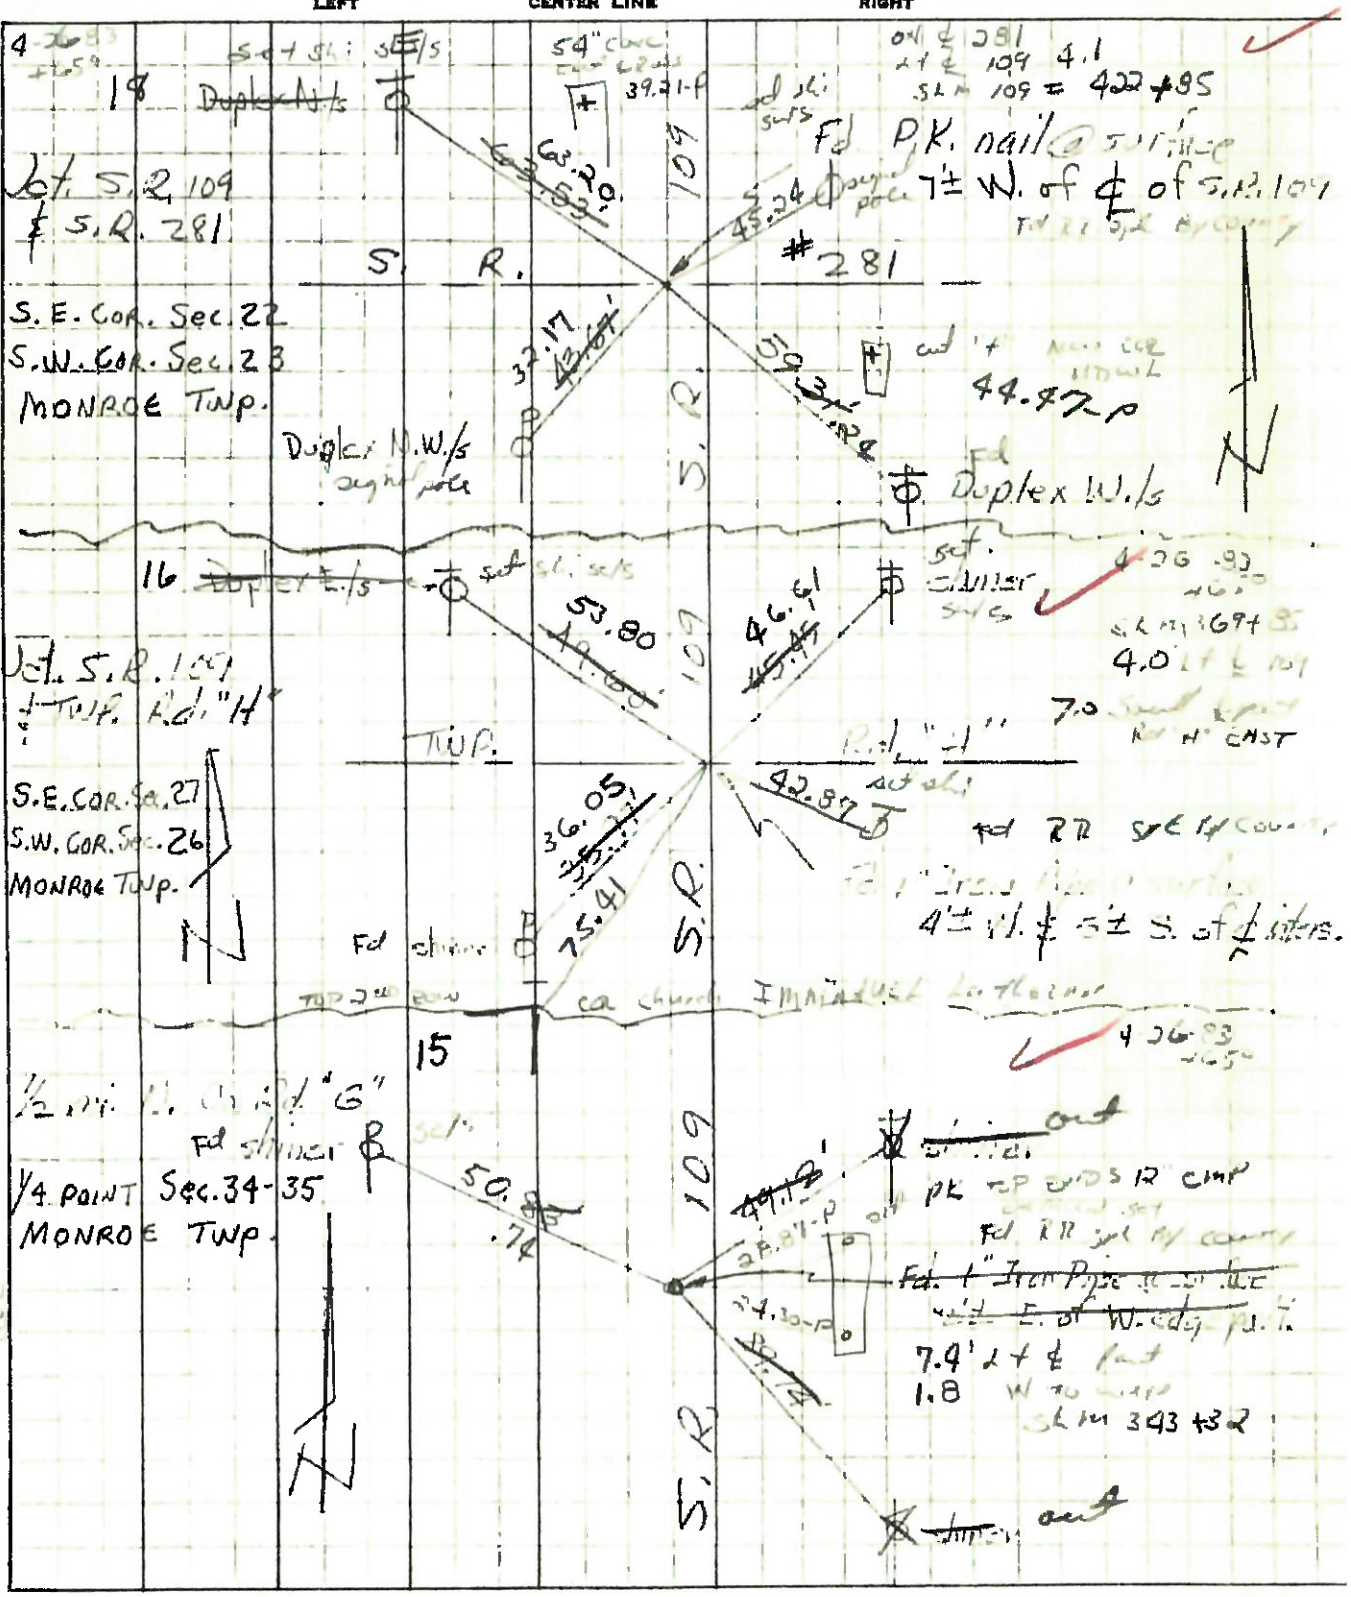
LEFT CENTER LINE RIGHT