O.D.O.T. DISTRICT 2 SURVEY OFFICE (USE ONLY)

PERSONNEL

REFERENCE NO. 25

SHEET 21 OF 25

NOTES NIESE

H.C. MILLER

R.C. PRESTON-COLVIN

DATE 10/7/24

WEATHER SUNNY

TEMP. 58°

ROUTE SR 109

COUNTY HENRY

TOWNSHIP MONROE

SECTION 2

T 4 N R 7 E

DWG BY BARRIERE

PID 99587

TYPE MONUMENT MAG NAIL/WASHER

ON SURFACE - BELOW ON

OFFSET ℄ PAVEMENT _____ LT : RT

_____ TO _____ EDGE PAVEMENT

STATION: 610+25

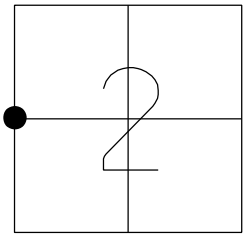

HORZ.DATUM: OHIO LDP (HENRY)

GEOID: 18

GRID: NORTHING: 611188.4184

EASTING: 1546181.8254

LDP: NORTHING: 467830.162

EASTING: 181097.306

RECORD:
SET MAG/WASHER
10-28-04, MC
DNF
SET MAG/WASHER
REF25
9-2-15, JFO
FD MAG/WASHER
REF25
8-3-16, JMR
6/27/22, DSA
1/11/23, JMR
SET MAG/WASHER
10/7/24, JAM

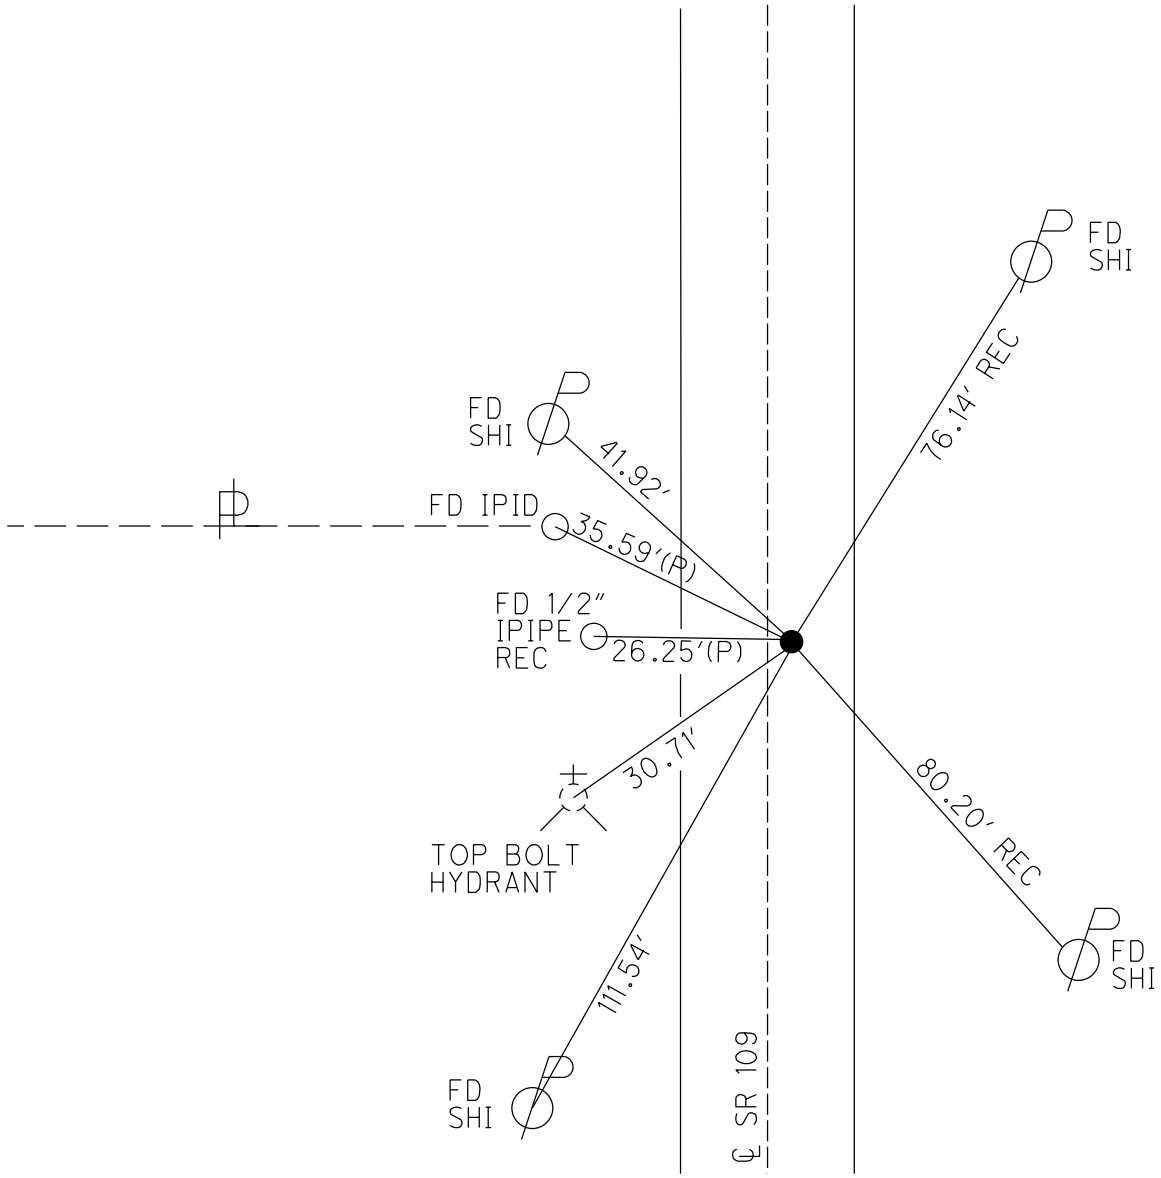

O.D.O.T. DISTRICT 2 SURVEY OFFICE (USE ONLY)

PERSONNEL

REFERENCE NO. 25

SHEET 12 OF 36

NOTES RHOADES
H.C. AUBLE
R.C. RHOADES

DATE 6/27/22
WEATHER SUNNY
TEMP. 67°

ROUTE SR 109
COUNTY HENRY
TOWNSHIP MONROE
SECTION 2

DWG BY RHOADES

PID PAVETRAIN

T 4 N R 7 E

TYPE MONUMENT MAG/WASHER
ON SURFACE - ~~BELOW~~ ON
OFFSET ℄ PAVEMENT 2.3' ~~LT~~ : RT
6.9' TO RT EDGE PAVEMENT
STATION: 604+03.2

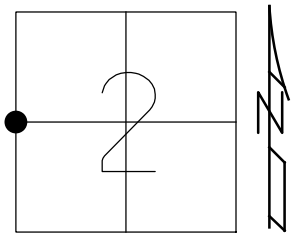

HORZ.DATUM: NAD83 2011

GEOID: NAVD88 2018

GRID: NORTHING: 611188.418

EASTING: 1546181.825

RECORD:
SET MAG/WASHER
10-28-04, MC
DNF
SET MAG/WASHER
REF25
9-2-15, JFO
FD MAG/WASHER
REF25
8-3-16, JMR
6/27/22, DSA
1/11/23, JMR

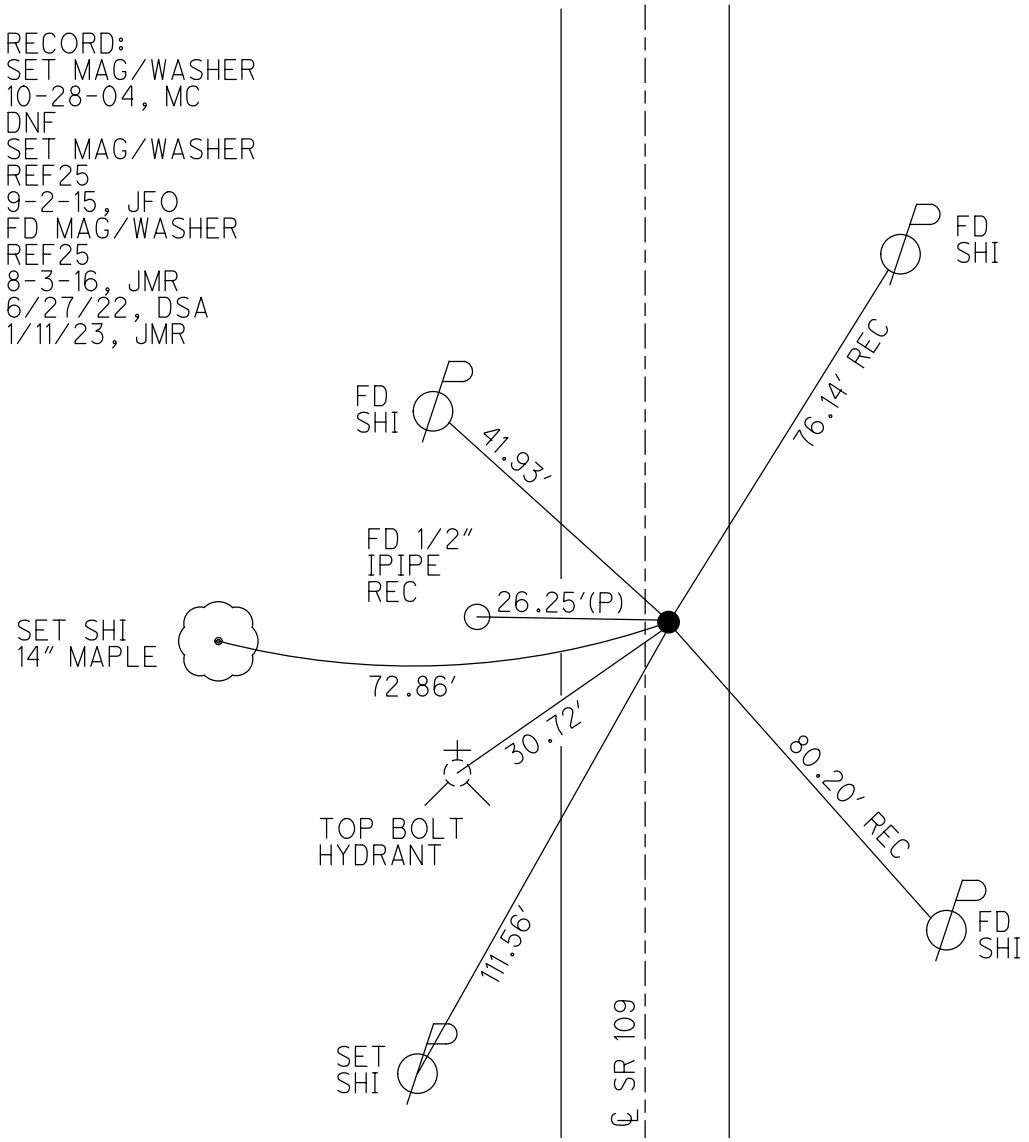

O.D.O.T. DISTRICT 2 SURVEY OFFICE (USE ONLY)

PERSONNEL

NOTES RHOADES
H.C. O'DONNELL
R.C. RHOADES

REFERENCE NO. 25 SHEET 12 OF 38

DATE 9-3-15
WEATHER SUNNY
TEMP. 78°F

ROUTE SR 109
COUNTY HENRY
TOWNSHIP MONROE
SECTION 2
T 4 N R 7 E

TYPE MONUMENT MAG/WASHER
ON SURFACE - ~~BELOW~~ ON
~~LEFT~~ - ℄ PAV'T - RIGHT 2.3'
6.9' TO RT EDGE PAVEMENT
S.L.M. 610+25
Grid: Northing: 611188.4184 Easting: 1546181.8254

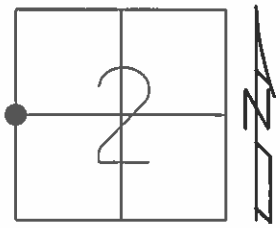

RECORD:
SET MAG/WASHER
10-28-04, MC

DNF
SET WITH TIES
9-1-15, JFO

SET MAG/WASHER
GPS, REF25
9-2-15, JFO

NOT COVERED
8-3-16, JMR

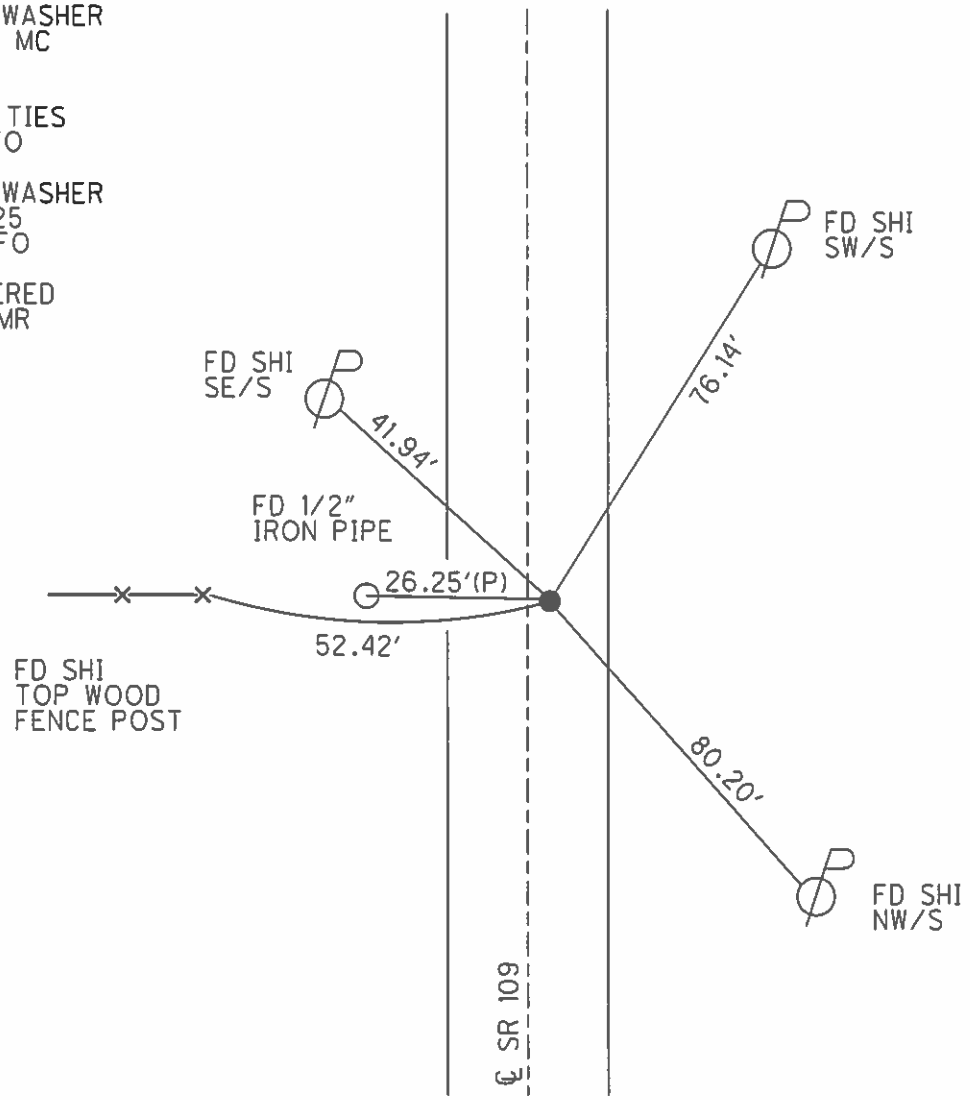

O.D.O.T. DISTRICT 2 SURVEY OFFICE

PERSONNEL

NOTES Canterbury
H.C. Barnhisel
R.C. Hooker

REFERENCE NO. 25

DATE 8-31-04
WEATHER Sun
TEMP. +70°

SHEET 11 OF 23

ROUTE SR 109
COUNTY HENRY
TOWNSHIP MONROE
SECTION 2
T 4 N R 7 E

TYPE MONUMENT LG R.R. SPK.
ON SURFACE - ~~BELOW~~ 2" DOWN
~~LEFT~~ - ℄ PAV'T. - RIGHT 2.3' Rt ℄
6.9' TO RT. EDGE PAVEMENT
S.L.M. 610+25

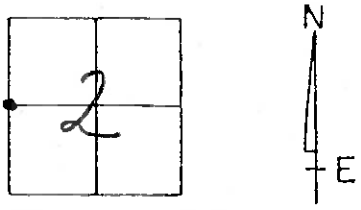

RESET MAG/WASHER
10/28/04
M.C.

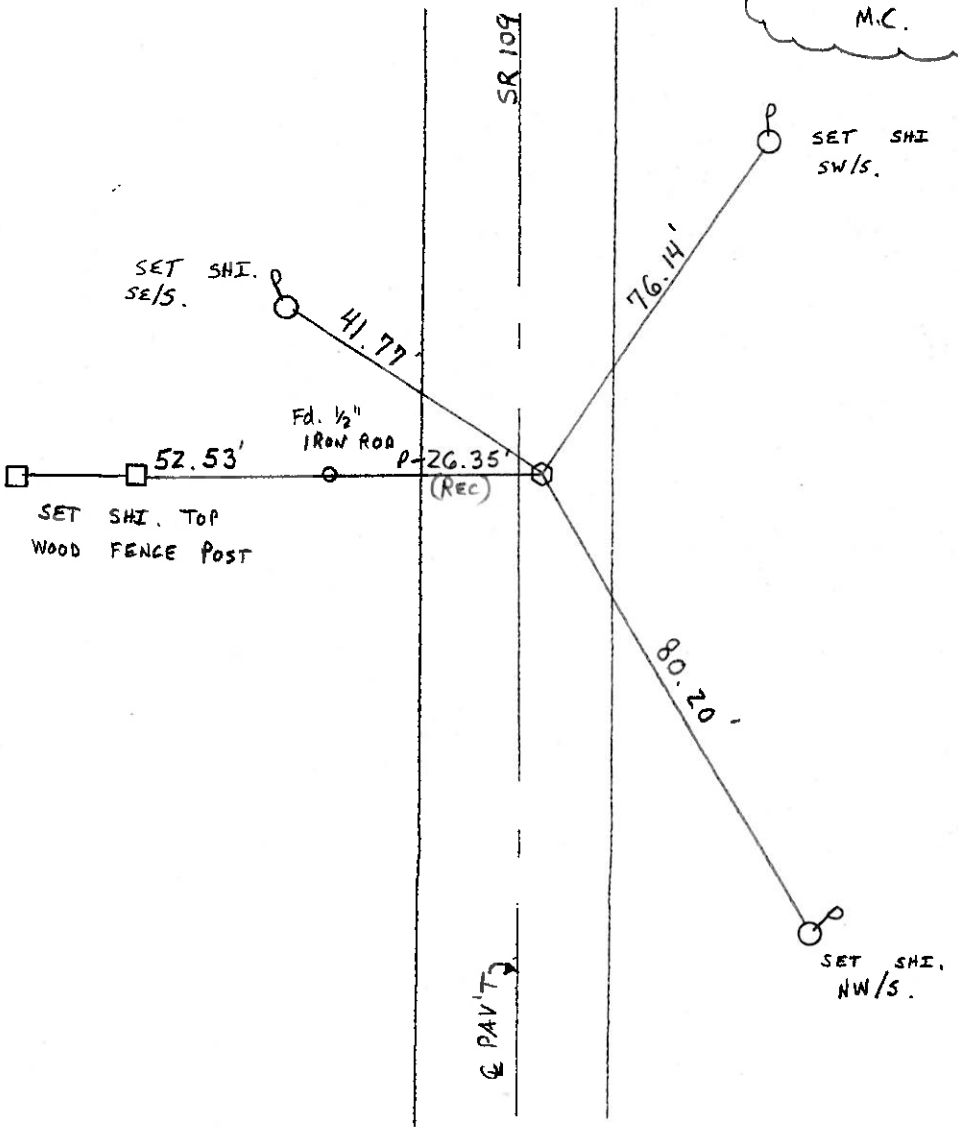

O.D.O.T. DISTRICT 2 SURVEY OFFICE

PERSONNEL

NOTES BARNHISEL
H.C. VAN DUSEN
R.C. BARNHISEL

REFERENCE NO. 25

DATE 8-13-93
WEATHER SUNNY
TEMP. +80°F

SHEET ____ OF ____

ROUTE SR 109
COUNTY HENRY
TOWNSHIP MONROE
SECTION 2
T 4 N R 7 E

TYPE MONUMENT LARGE RR/SPK.
ON SURFACE - ~~BELOW~~ YES
~~LEFT~~ - ℄ PAV'T. - RIGHT 2.8
2.2 TO RT. EDGE PAVEMENT
S.L.M. 610+14

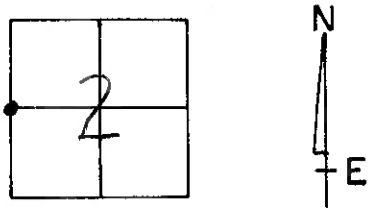

SET PK & WASHER
8-27-93
MB

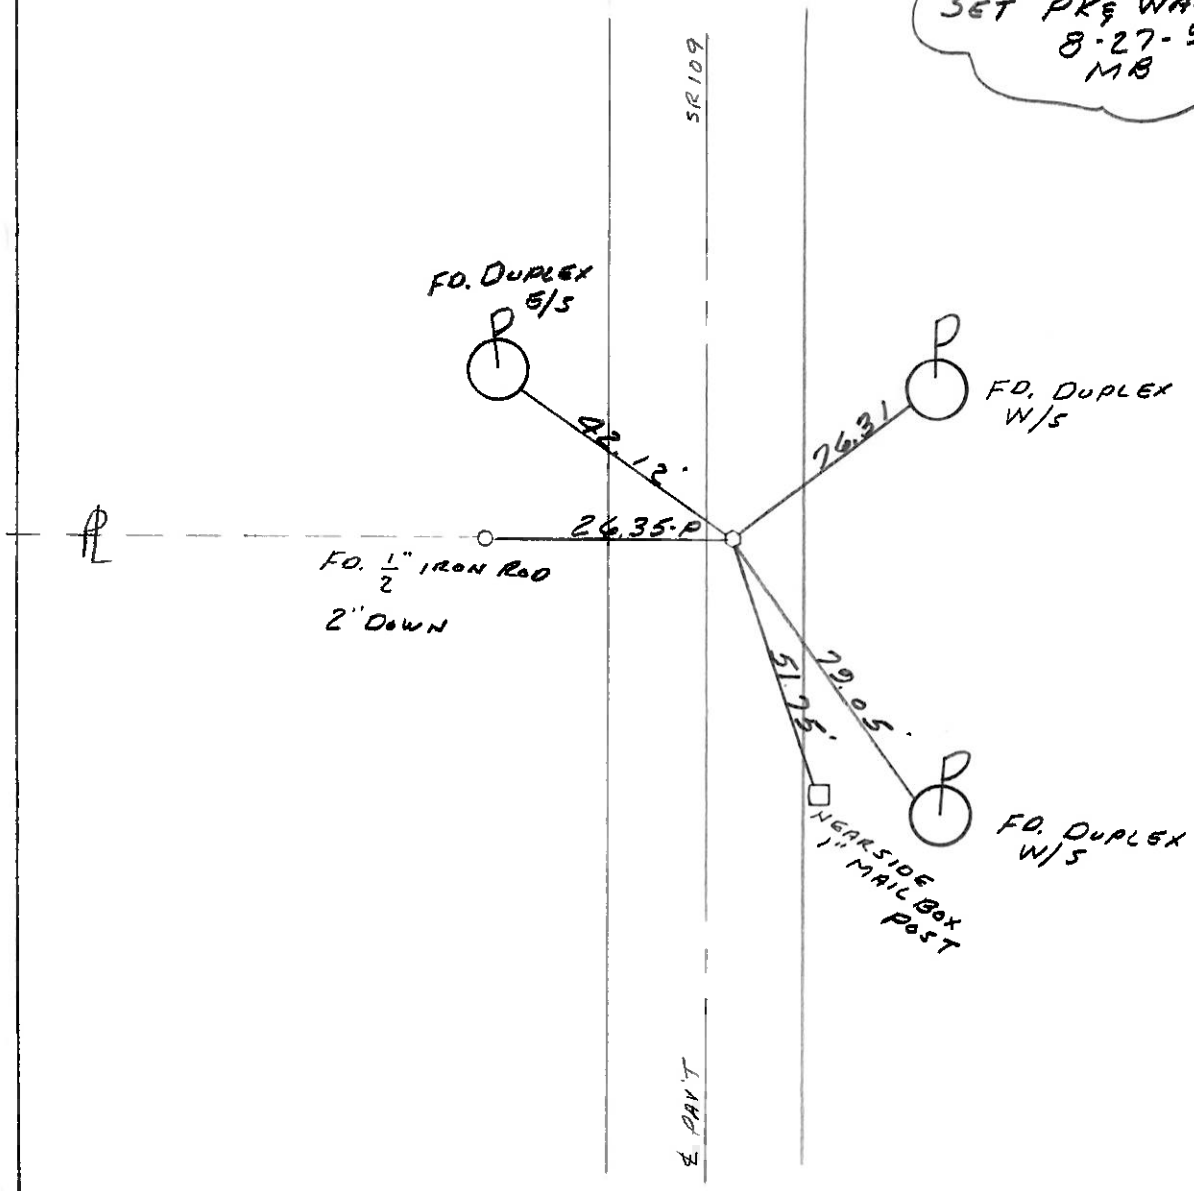

O.D.O.T. DISTRICT 2 SURVEY OFFICE

PERSONNEL
NOTES Barnhisel
H.C. Hoffman
R.C. Loehrke

REFERENCE NO. 25
DATE 4-8-85
WEATHER Cloudy
TEMP. +35°

SHEET ____ OF ____
ROUTE 109
COUNTY Henry
TOWNSHIP Monroe
SECTION 2
T 4 N R 7 E

TYPE MONUMENT Lg RR/spk
ON SURFACE - ~~BELOW~~ ✓
~~LEFT~~ - ℄ PAV'T. - RIGHT 2.5
5.9 TO Rt EDGE PAVEMENT
S.L.M. 609+54

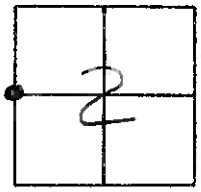

Set PK/Washer
5-24-85
MDB

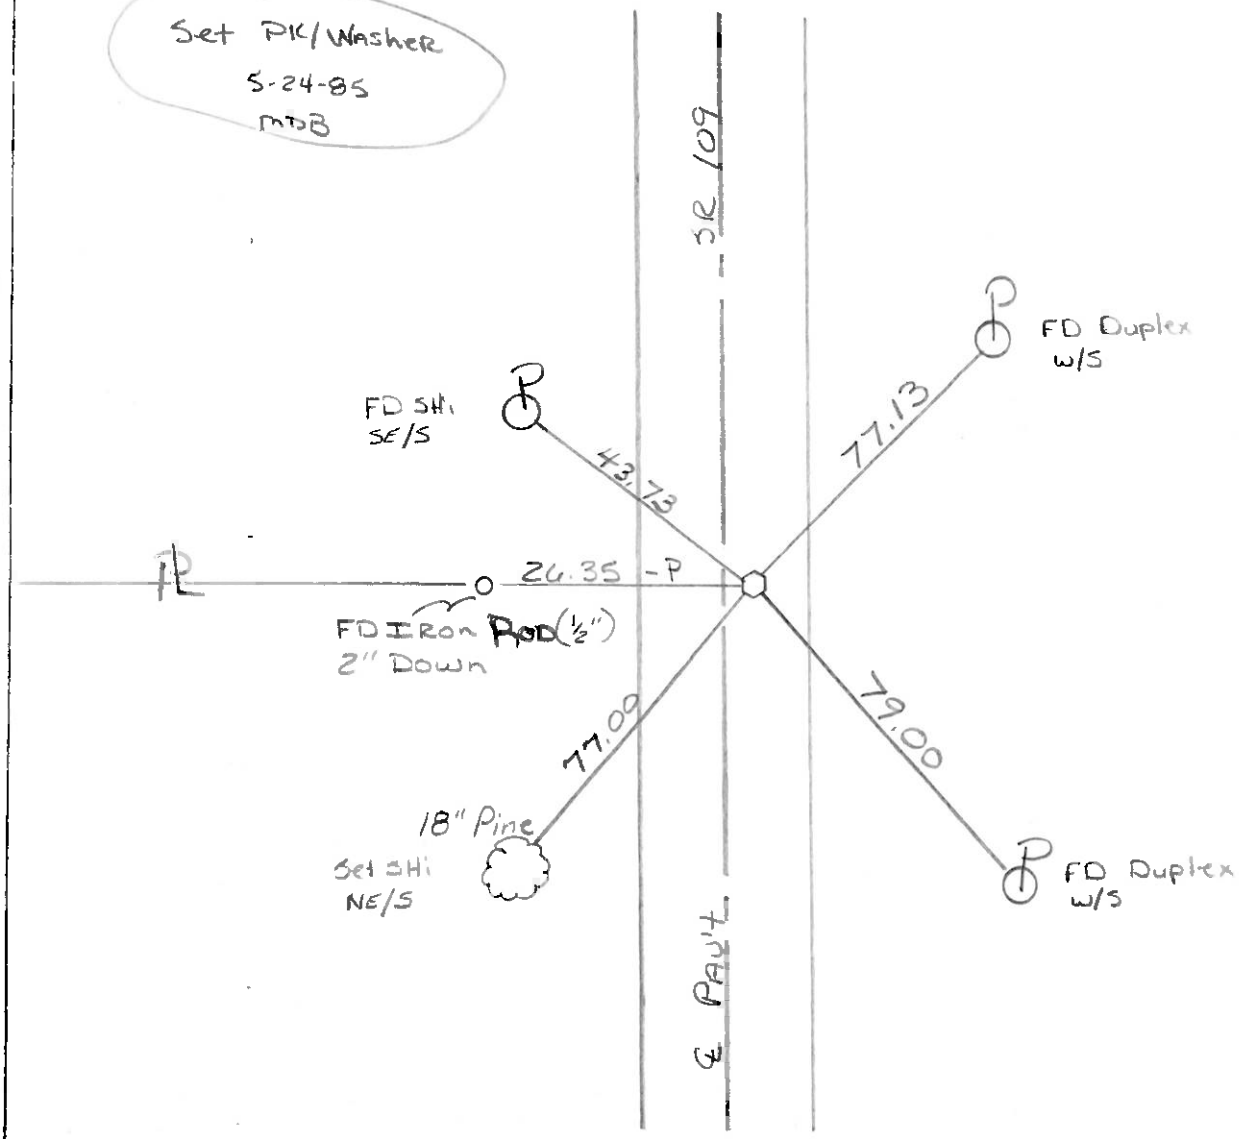

COUNTY HENRY S.R. 109 T 4 N, R 7 E

TOWNSHIP MONROE

SECTION 2

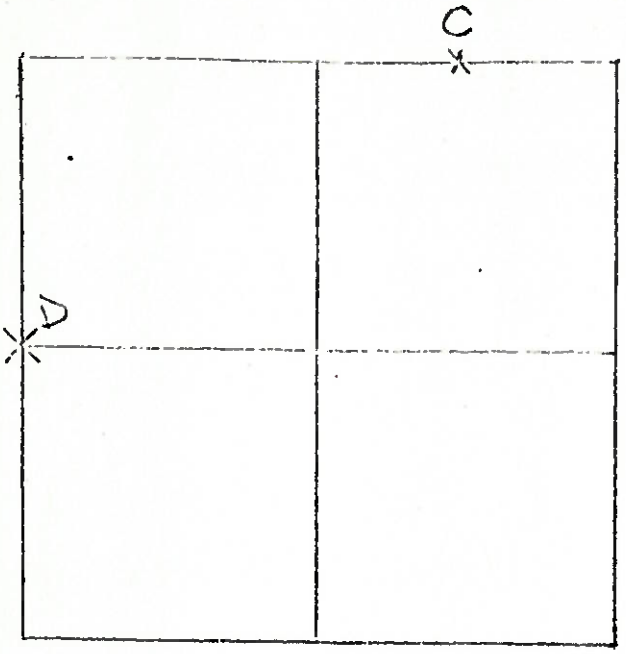

3-6-'79
R.W, J.J, D.B.

C - FD. RECOVERED IRON PIN 6" NORTH & 3½" EAST OF CENTER OF FLAT TOP OF STONE. STONE MEASURES 10" x 8" x 6" AND IS 10" BELOW ROAD SURFACE. REMOVED IRON PIN AND PLACED CHISLER. PUNCHED R.R. SPIKE OVER CENTER OF STONE AT ROAD SURFACE. P.K.'s 6' N & E

STONE IS IN CENTER OF 18' PAVEMENT.

64.05' E.S.E. TO DUPLEX IN N/S I

29.53' S. TO IRON PIN (PLUMBED)

90.05' W.N.W. TO DUPLEX IN S/S I

60.83' W.N.W. TO IRON PIN (PLUMBED)

7-9-79 R.W. J.J. G.M.

D - RECOVERED NAIL AND WASHER DESTROYED DURING CONSTRUCTION OF CROSS TILE. RE-ESTABLISHED ¼ POST BY SURVEY PROPORTIONATE MEASURE POINTS ALONG WEST LINE OF [illegible] 2, MONROE TWP. PLACED CENTER PUNCH MARK IN TOP OF CHISLER. RR SPIKE [illegible] 6.5' WEST OF EAST EDGE OF 18' PAVEMENT. P.K. SET 6' N & E

46.93' N.W. TO DUPLEX N.E/S P

77.15' N.N.E TO DUPLEX N/S P

79.05' S.S.E. TO DUPLEX N/S P

26.33' W TO (½" DIA) IRON PIPE

LD-5—(25M—2-59)

SHEET NO. 1

PERSONNEL	TITLE	PERSONNEL	TITLE
BURNSIDE			
SMITH			
TOMSIC			
MEAD			

COUNTY HENRY DATE 9-16-76

S. R. 109 WEATHER CLOUDY - SHOWER

SEC. W1/4 POST SEC. 2 TEMP. +68°

DESCRIPTION REF. TO POINTS FD. BEFORE RESURFACING. JOB NO.

LEFT CENTER LINE RIGHT

25

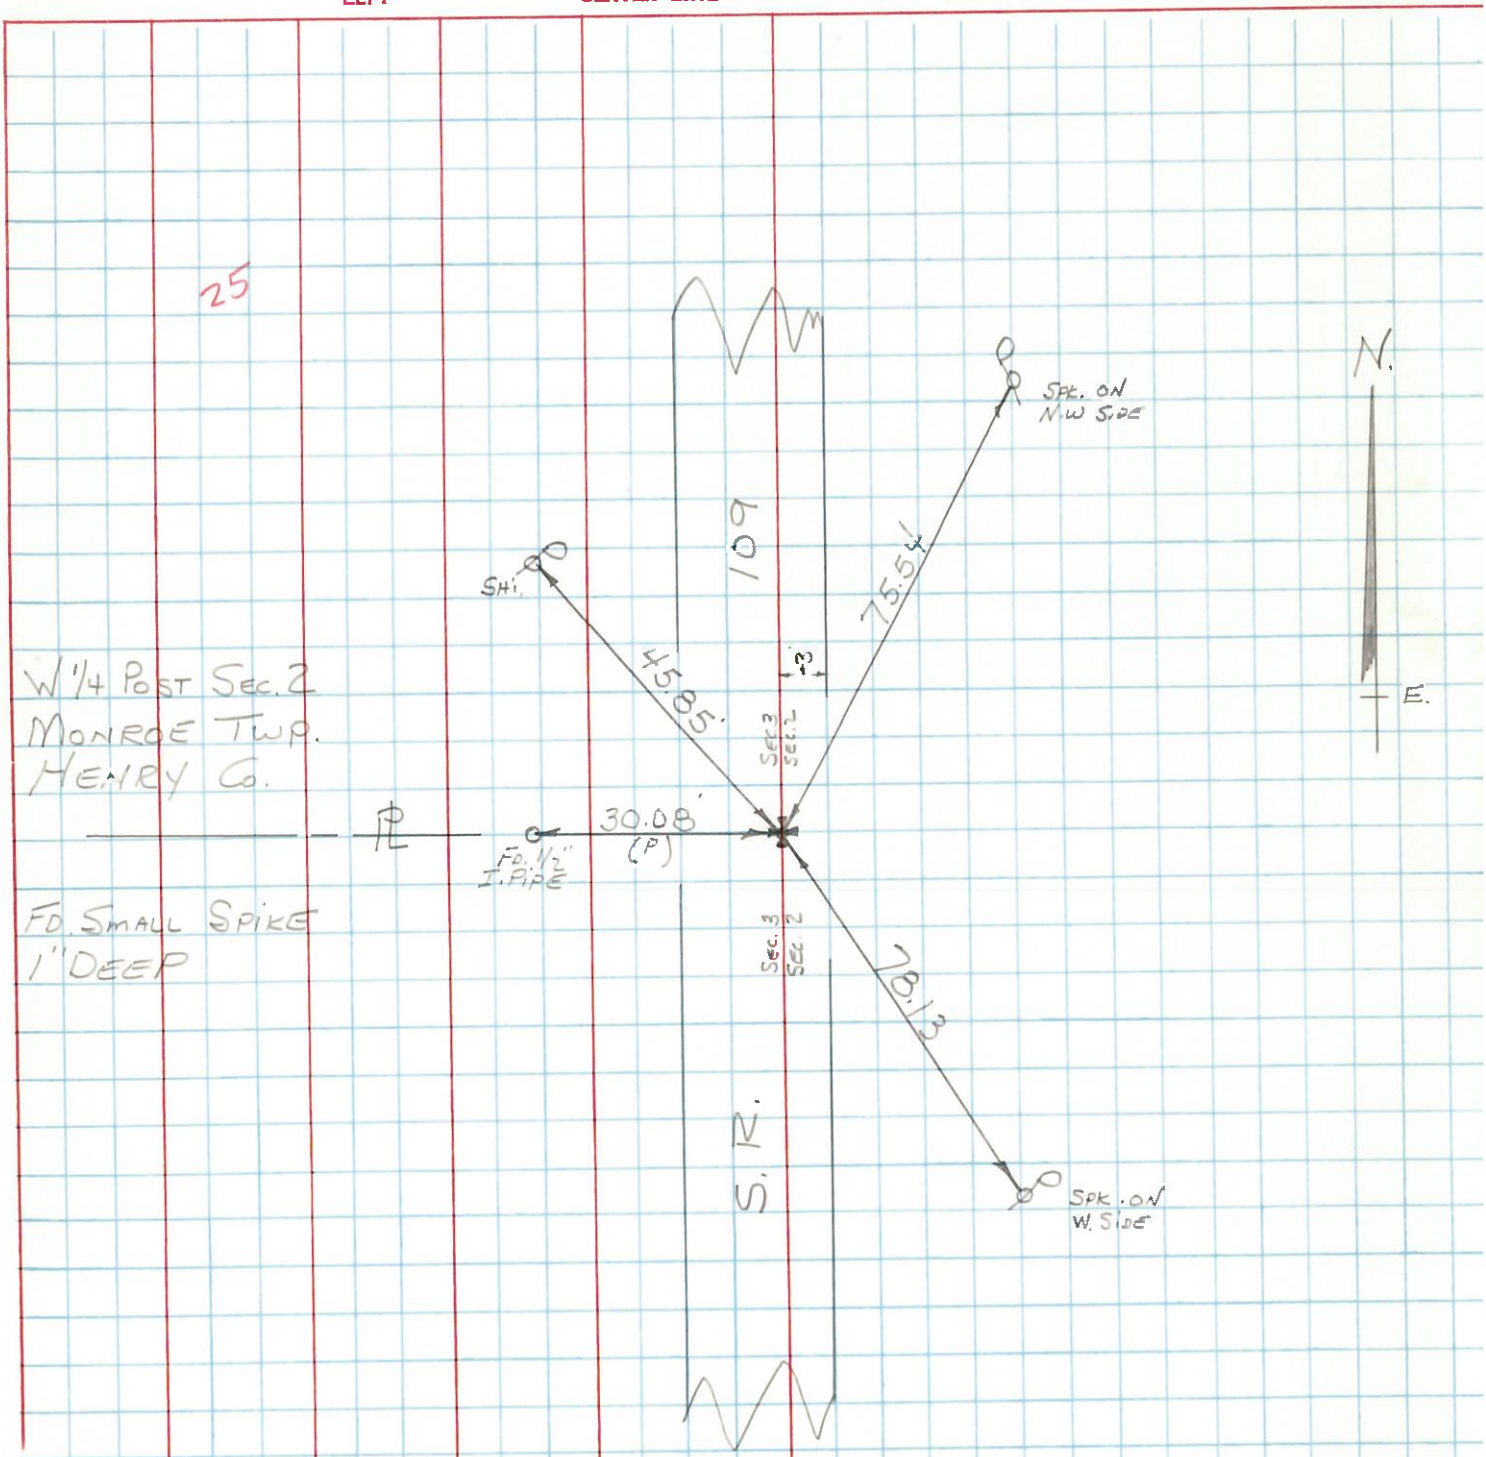

W1/4 POST SEC. 2
MONROE TWP.
HENRY CO.

FD. SMALL SPIKE
1" DEEP