O.D.O.T. DISTRICT 2 SURVEY OFFICE (USE ONLY)

PERSONNEL

REFERENCE NO. 27

SHEET 21 OF 25

NOTES NIESE
H.C. MILLER
R.C. PRESTON-COLVIN

DATE 10/7/24
WEATHER SUNNY
TEMP. 52°

ROUTE SR 109
COUNTY HENRY
TOWNSHIP HARRISON
SECTION 35
T 5 N R 7 E

DWG BY BARRIERE

PID 99587

TYPE MONUMENT MAG NAIL/WASHER
ON SURFACE - BELOW ON
OFFSET ℄ PAVEMENT _____ LT : RT
_____ TO _____ EDGE PAVEMENT
STATION: 664+60

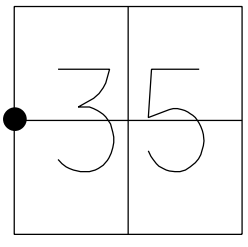

HORZ.DATUM: OHIO LDP (HENRY)
GEOID: 18
GRID: NORTHING: 616639.9854
EASTING: 1546155.4620
LDP: NORTHING: 473280.765
EASTING: 180970.91

RECORD:
SET MAG/WASHER
10-27-04, MC
FD MAG/WASHER
REF27
9-1-15, JFO
8-3-16, JMR
REF27
6/27/22, DSA
1/11/23, JMR
SET MAG/WASHER
W/ GPS & 1 TIE
10/7/24, TDN

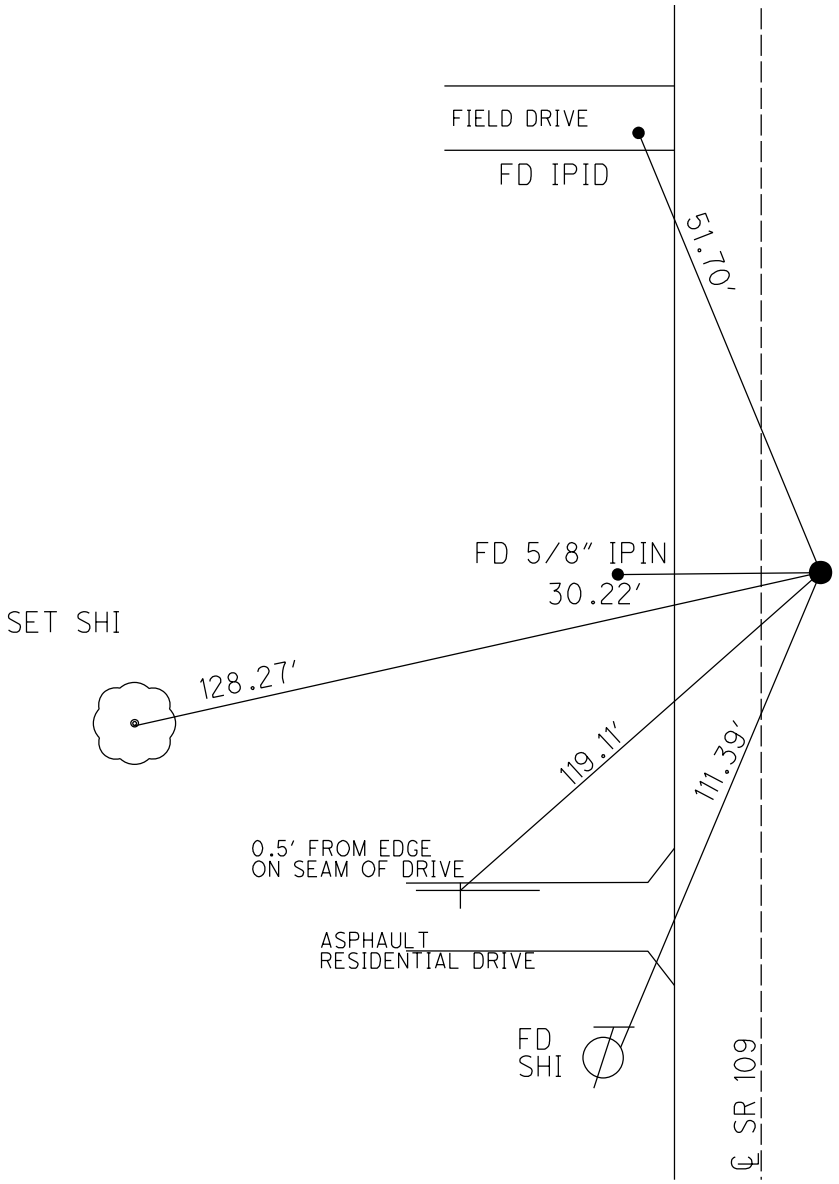

O.D.O.T. DISTRICT 2 SURVEY OFFICE (USE ONLY)

PERSONNEL

REFERENCE NO. 27

SHEET 15 OF 36

NOTES RHOADES
H.C. AUBLE
R.C. RHOADES

DATE 6/27/22
WEATHER SUNNY
TEMP. 67°

ROUTE SR 109
COUNTY HENRY
TOWNSHIP HARRISON
SECTION 35
T 5 N R 7 E

DWG BY RHOADES
PID PAVETRAIN

TYPE MONUMENT MAG/WASHER
ON SURFACE - ~~BELOW~~ ON
OFFSET ℄ PAVEMENT 6.6′ ~~LT~~ : RT
3′ TO RT EDGE PAVEMENT
STATION: 664+75.2

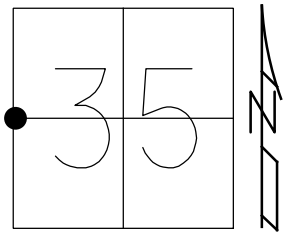

HORZ.DATUM: NAD83 2011
GEOID: NAVD88 2018
GRID: NORTHING: 616639.985
EASTING: 1546155.462

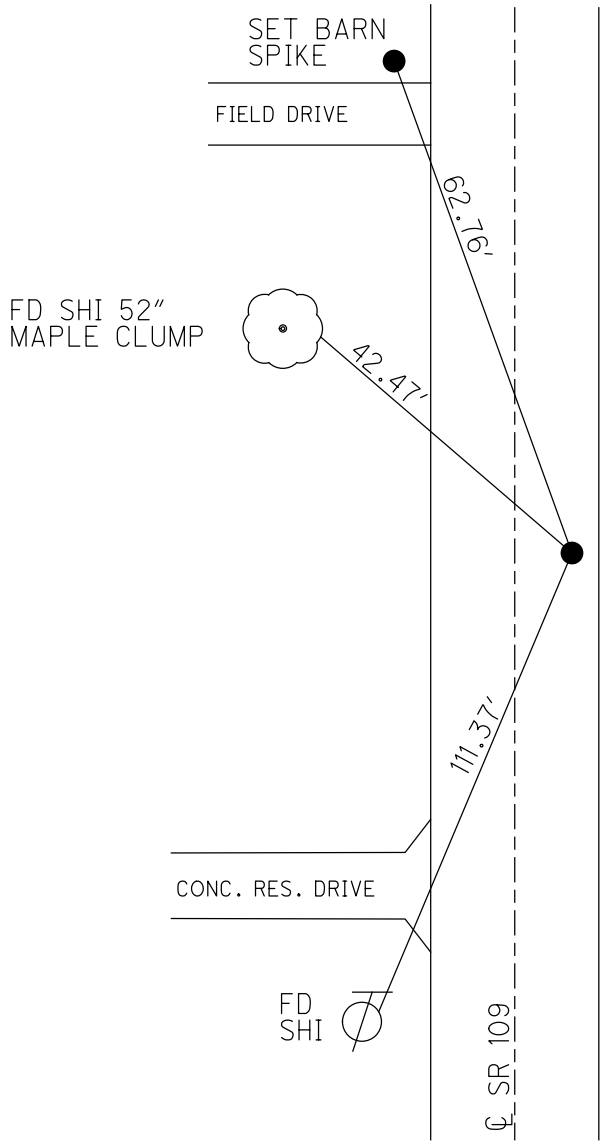

RECORD:
SET MAG/WASHER
10-27-04, MC
FD MAG/WASHER
REF27
9-1-15, JFO
8-3-16, JMR
REF27
6/27/22, DSA
1/11/23, JMR

O.D.O.T. DISTRICT 2 SURVEY OFFICE (USE ONLY)

PERSONNEL

NOTES RHOADES
H.C. O'DONNELL
R.C. RHOADES

REFERENCE NO. 27 SHEET 15 OF 38

DATE 9-3-15
WEATHER CLEAR
TEMP. 88°12

ROUTE SR 109
COUNTY HENRY
TOWNSHIP HARRISON
SECTION 35
T 5 N R 7 E

TYPE MONUMENT MAG/WASHER
ON SURFACE - ~~BELOW~~ ON
~~LEFT~~ - ℄ PAV'T - RIGHT 6.6'
3.0' TO RT EDGE PAVEMENT
S.L.M. 664+60
Grid: Northing: 616639.9854 Easting: 1546155.4620

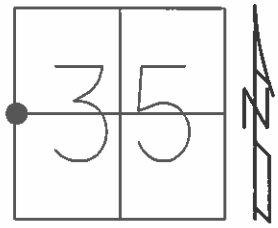

RECORD:
SET MAG/WASHER
10-27-04, MC

FD MAG/WASHER
GPS, REF27
9-1-15, JFO

NOT COVERED
8-3-16, JMR

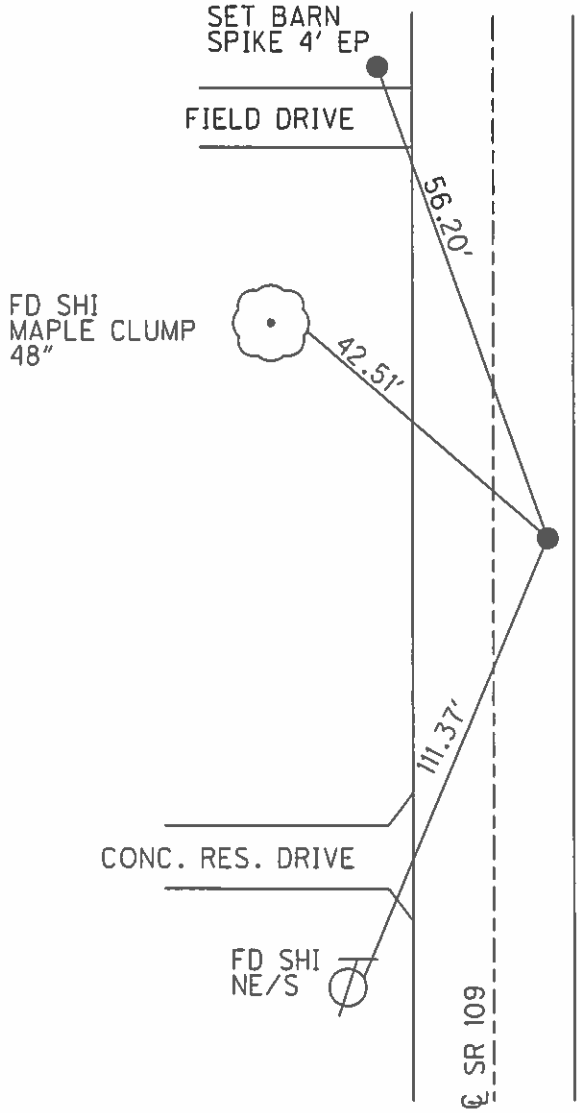

O.D.O.T. DISTRICT 2 SURVEY OFFICE

PERSONNEL

NOTES CANTERBURY
H.C. BARNHISEL
R.C. HOOKER

REFERENCE NO. 27

DATE 8-31-04
WEATHER SUN
TEMP. +75°

SHEET 13 OF 23

ROUTE SR 109
COUNTY HENRY
TOWNSHIP HARRISON
SECTION 35
T 5 N R 7 E

TYPE MONUMENT P.K. / WASHER
ON SURFACE - ~~BELOW~~ SURFACE
~~LEFT~~ - ℄ PAV'T. - RIGHT 6.6' RT ℄
3.0' TO RT. EDGE PAVEMENT
S.L.M. 664 + 60

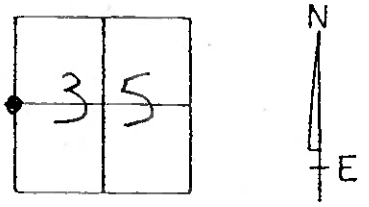

RESET MAG/WASHER
10/27/04
M.C.

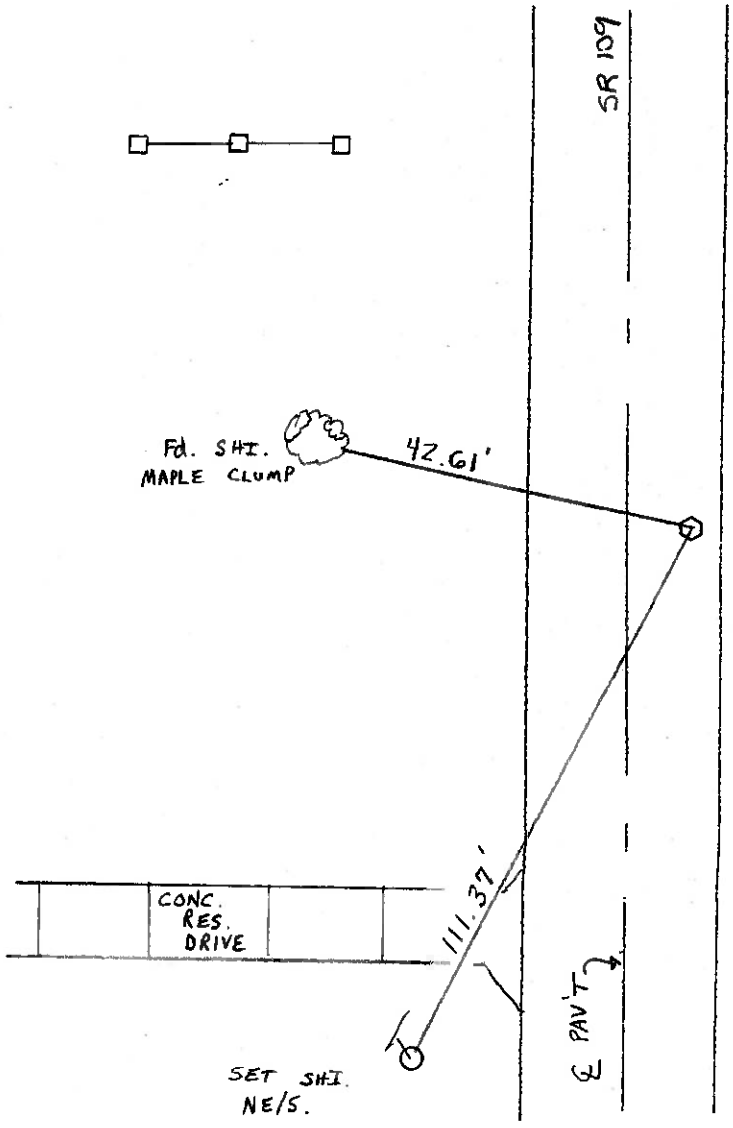

O.D.O.T. DISTRICT 2 SURVEY OFFICE

PERSONNEL

NOTES BARNHISEL
H.C. VAN OOSEN
R.C. BARNHISEL

REFERENCE NO. 27 SHEET ____ OF ____

DATE 8-13-93
WEATHER SUNNY
TEMP. +80° F

ROUTE SR 109
COUNTY HENRY
TOWNSHIP HARRISON
SECTION 35
T 5 N R 7 E

TYPE MONUMENT LG. RR/SPK.
ON ~~SURFACE~~ - BELOW 1"
~~LEFT~~ - ℄ PAV'T. - RIGHT 2.0'
3.6 TO RT. EDGE PAVEMENT
S.L.M. 664+60

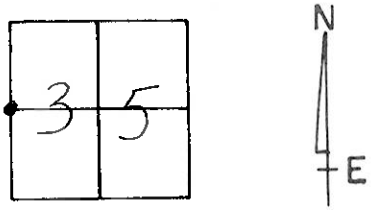

SET PK & WASHER
8-27-93
MB

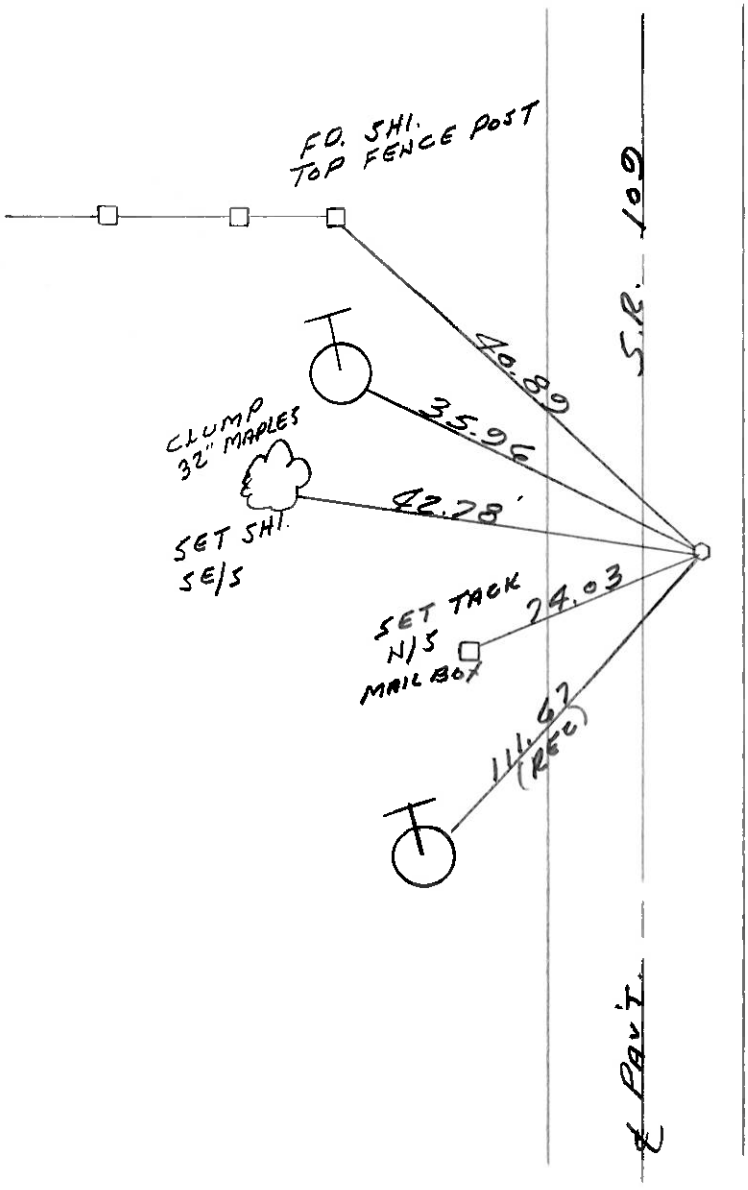

O.D.O.T. DISTRICT 2 SURVEY OFFICE

PERSONNEL
NOTES Barnhisel
H.C. Hoffman
R.C. Loehrke

REFERENCE NO. 27
DATE 4-8-85
WEATHER cloudy
TEMP. +35°

SHEET ____ OF ____
ROUTE 109
COUNTY Henry
TOWNSHIP Harrison
SECTION 35
T 5 N R 7 E

TYPE MONUMENT Lg RR/spk
~~ON SURFACE~~ - BELOW 1"
~~LEFT~~ - ℄ PAV'T. - RIGHT 6.8
2.5 TO Rt EDGE PAVEMENT
S.L.M. 6664+12

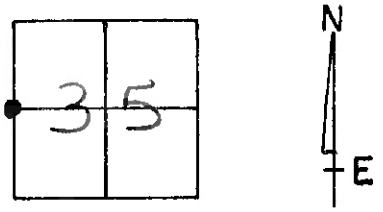

Set PK/Washer
5-24-85
MDR

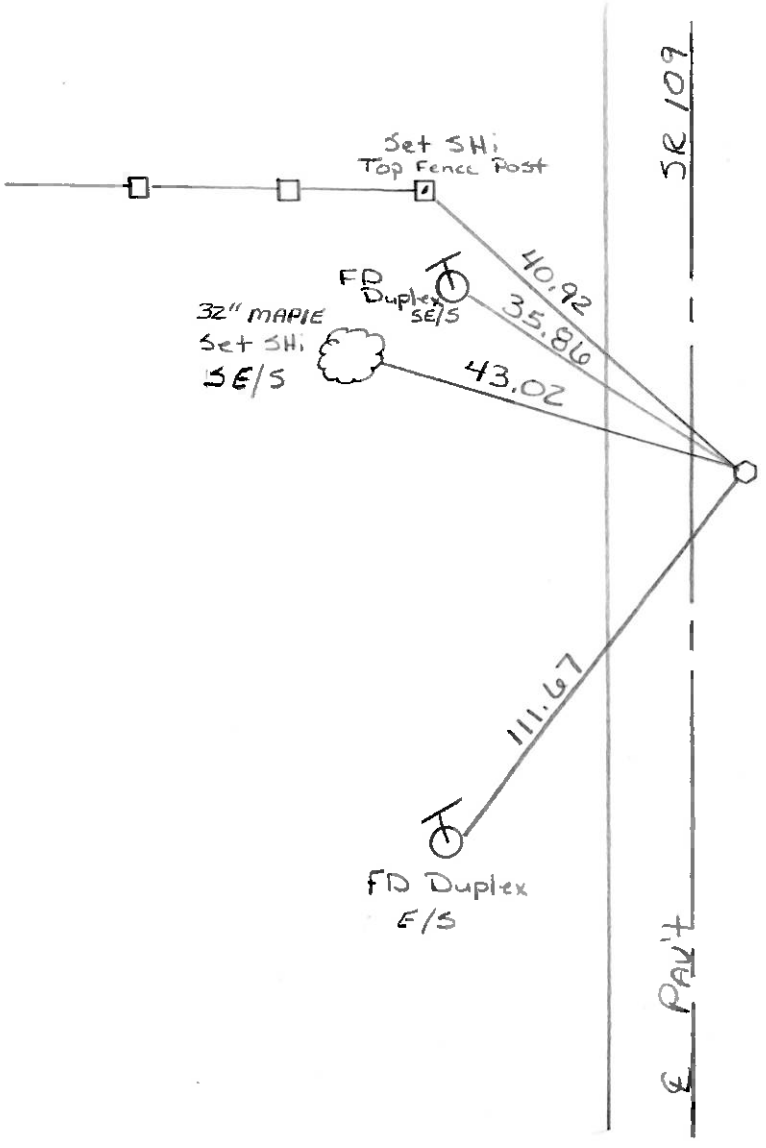

LD-5—(25M—2-59)

SHEET NO. 3

PERSONNEL	TITLE	PERSONNEL	TITLE
BURNSIDE			
SMITH			
TOMSIC			
MEAD			

COUNTY HENRY DATE 9-16-76

S. R. 109 WEATHER CLOUDY-SHOWE

SEC. W 1/4 POST SEC 35 TEMP. +68°

DESCRIPTION REF. TO CONTROL POINTS JOB NO.

LEFT CENTER LINE RIGHT

27

W. 1/4 POST. SEC. 35
HARRISON TWP.
HENRY CO.
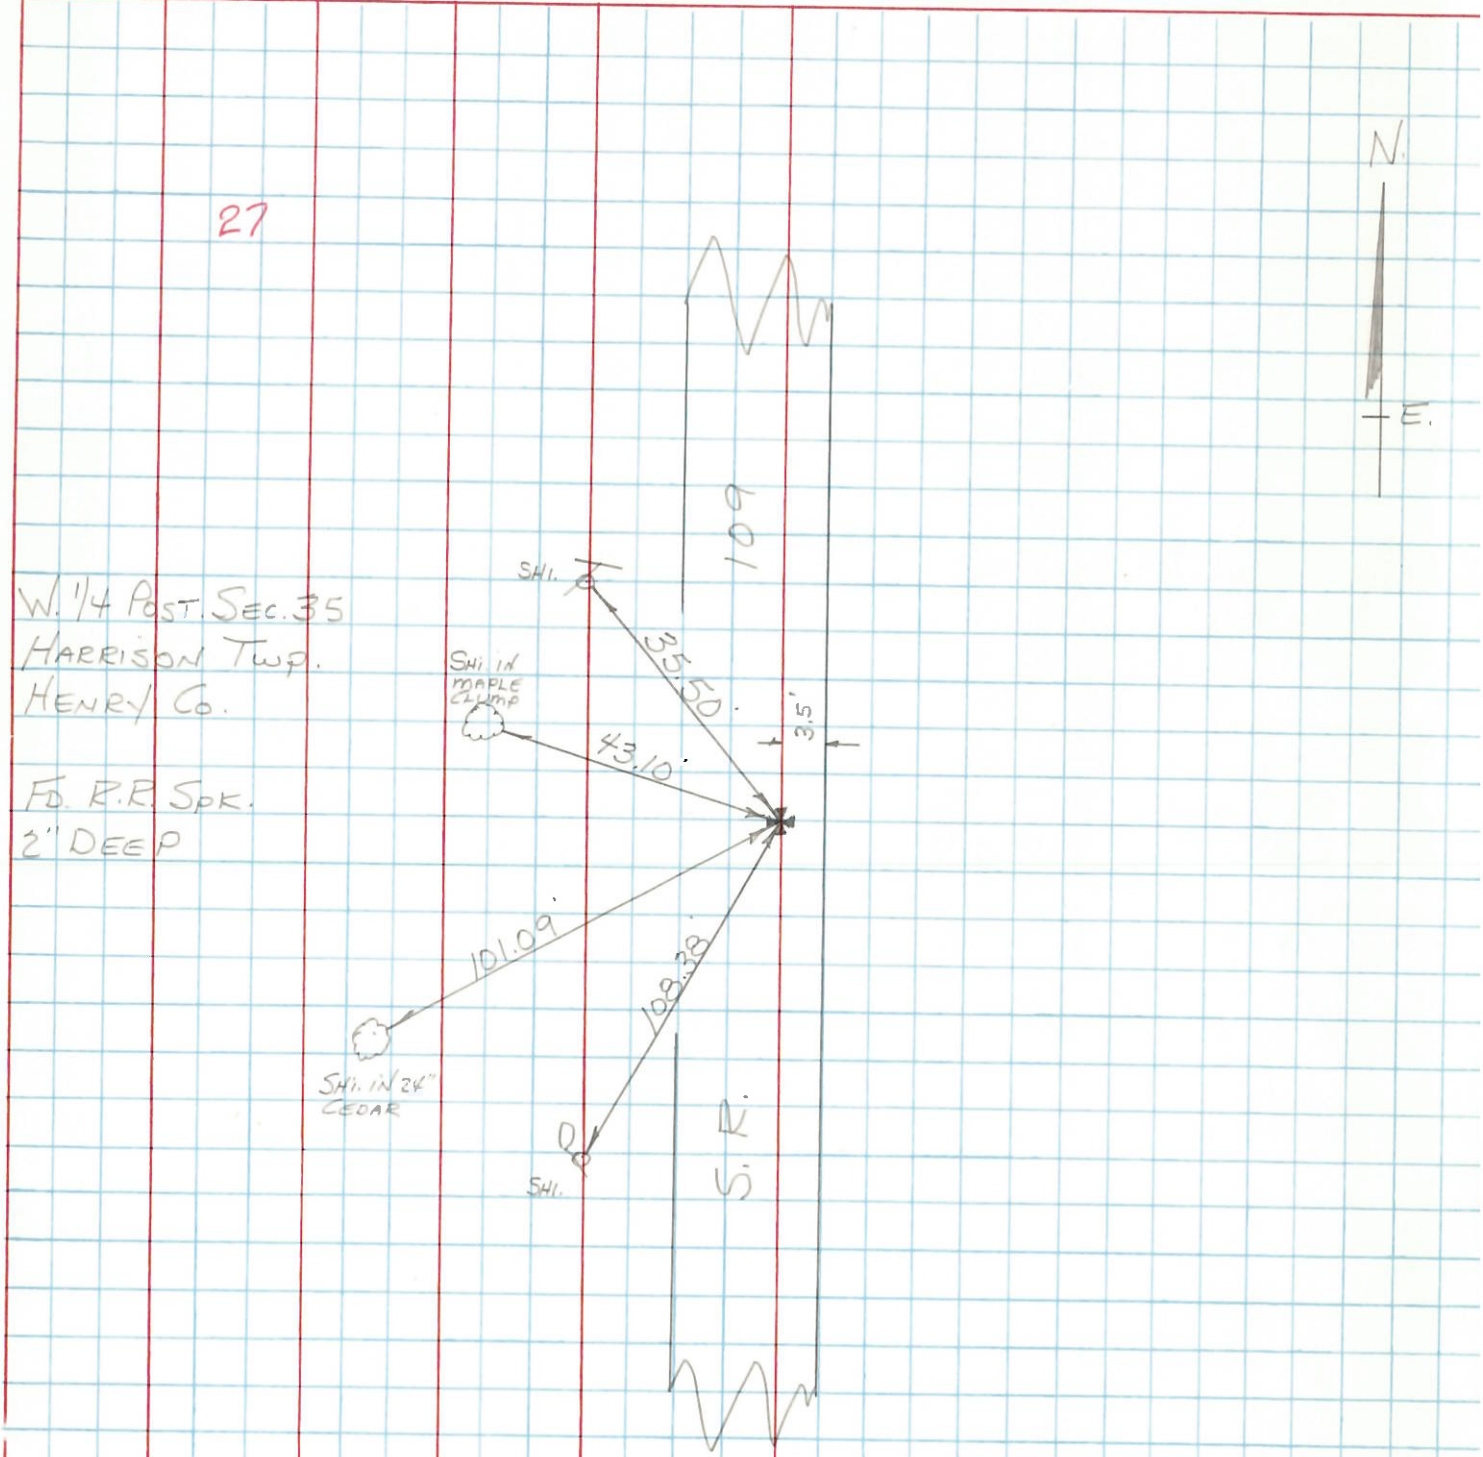
FD. R.R. SPK.
2" DEEP