O.D.O.T. DISTRICT 2 SURVEY OFFICE (USE ONLY)

PERSONNEL

NOTES RHOADES
H.C. O'DONNELL
R.C. RHOADES

DWG BY RHOADES

REFERENCE NO. 30 B

DATE 9/3/15
WEATHER CLEAR
TEMP. 88°

PID PAVTRAIN

SHEET 20 OF 39

ROUTE SR 109
COUNTY HENRY
TOWNSHIP HARRISON
SECTION 23
T 5 N R 7 E

TYPE MONUMENT MAG/WASHER
ON SURFACE - ~~BELOW~~ ON
OFFSET ℄ PAVEMENT 1.0' ~~LT~~ : RT
10.5' TO LT EDGE PAVEMENT
STATION: 767+41

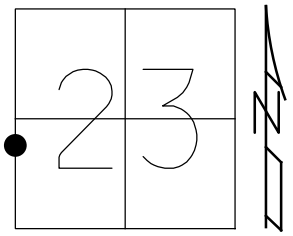

HORZ.DATUM: NAD83 2011
GEOID: NAVD88 2018
GRID: NORTHING: 626924.182
EASTING: 1546360.213

RECORD:
SET MAG/WASHER
10-29-04, D.H
FD MAG/WASHER
REFB30
9-1-15, JFO
8-3-16, JMR
FD MAG/WASHER
REFB30
6/16/21, TDN
10/5/21, JFO

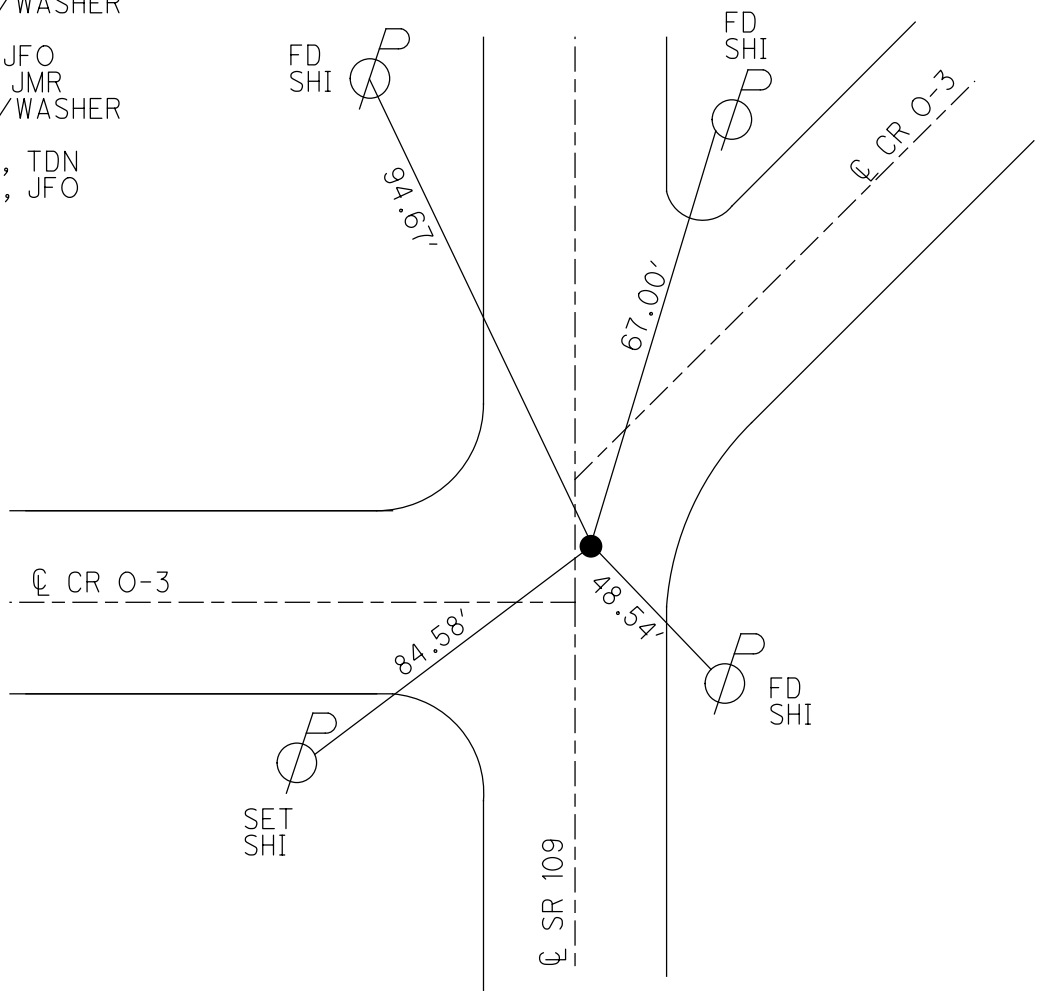

O.D.O.T. DISTRICT 2 SURVEY OFFICE (USE ONLY)

PERSONNEL

NOTES RHOADES
H.C. O'DONNELL
R.C. RHOADES

REFERENCE NO. 30 B SHEET 20 OF 38

DATE 9-3-15
WEATHER CLEAR
TEMP. 88°F

ROUTE SR 109
COUNTY HENRY
TOWNSHIP HARRISON
SECTION 23
T 5 N R 7 E

TYPE MONUMENT MAG/WASHER
ON SURFACE - ~~BELOW~~ ON
~~LEFT~~ - ℄ PAV'T - RIGHT 1.0'
10.5' TO LT EDGE PAVEMENT
S.L.M. 767+41
Grid: Northing: 626924.214 Easting: 1546360.2099

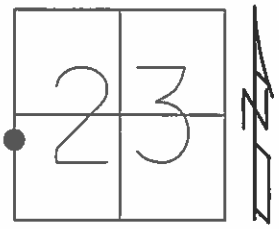

RECORD:
SET MAG/WASHER
10-29-04, D.H

FD MAG/WASHER
GPS, REFB30
9-1-15, JFO

UNCOVERED
8-3-16, JMR

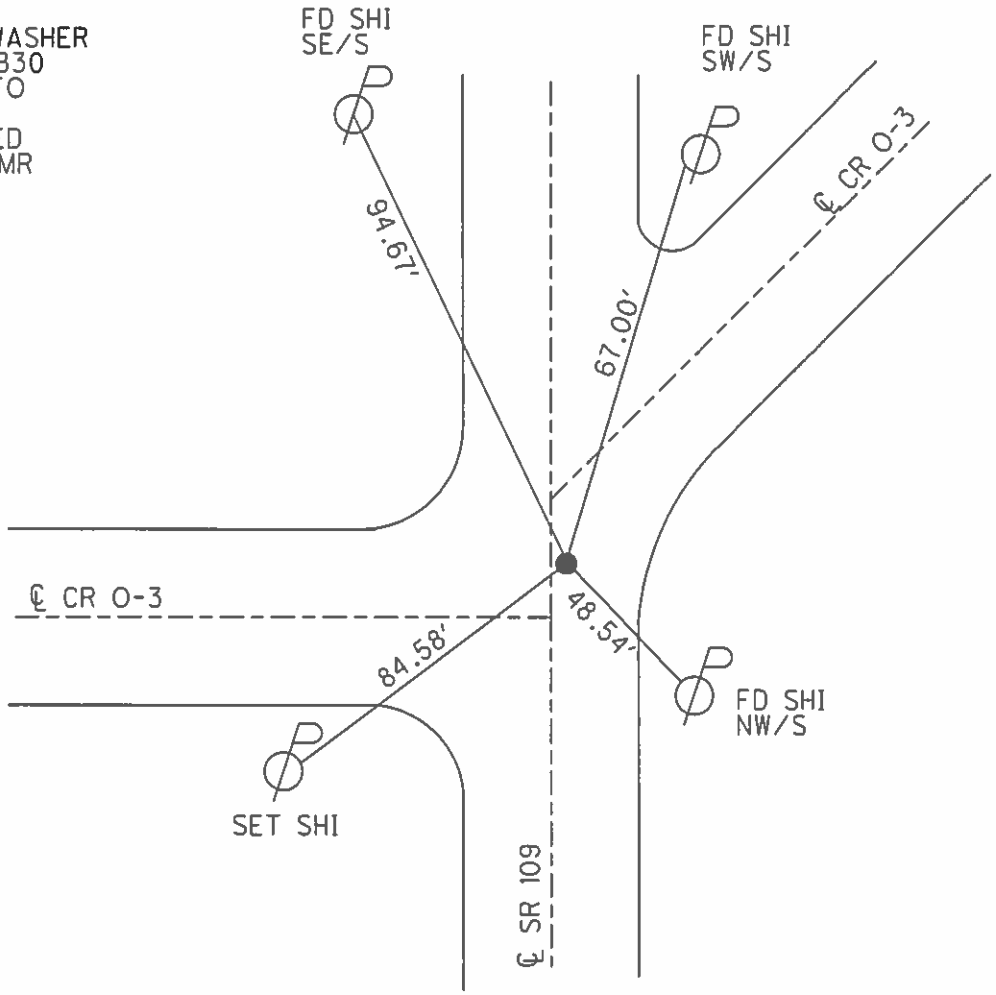

NOTE:
42' N. OF ℄ WEST

O.D.O.T. DISTRICT 2 SURVEY OFFICE

PERSONNEL

NOTES Cordes
H.C. Barnhisel
R.C. Hooker

MC - drawing

REFERENCE NO. 30-B

DATE 8/27/04
WEATHER overcast
TEMP. +80°

SHEET 18 OF 23

ROUTE SR 109
COUNTY Henry
TOWNSHIP Harrison
SECTION 23
T 5 N R 7 E

TYPE MONUMENT P.K. / washer
ON SURFACE - ~~BELOW~~ Surface
~~LEFT~~ - ℄ PAV'T. - RIGHT 0.5' Rt ℄
10.5 TO Lt. EDGE PAVEMENT
S.L.M. 767 + 41 42' N. of ℄ West

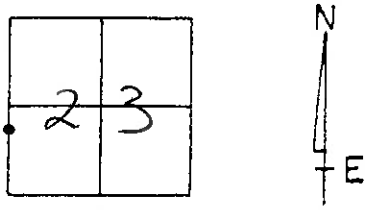

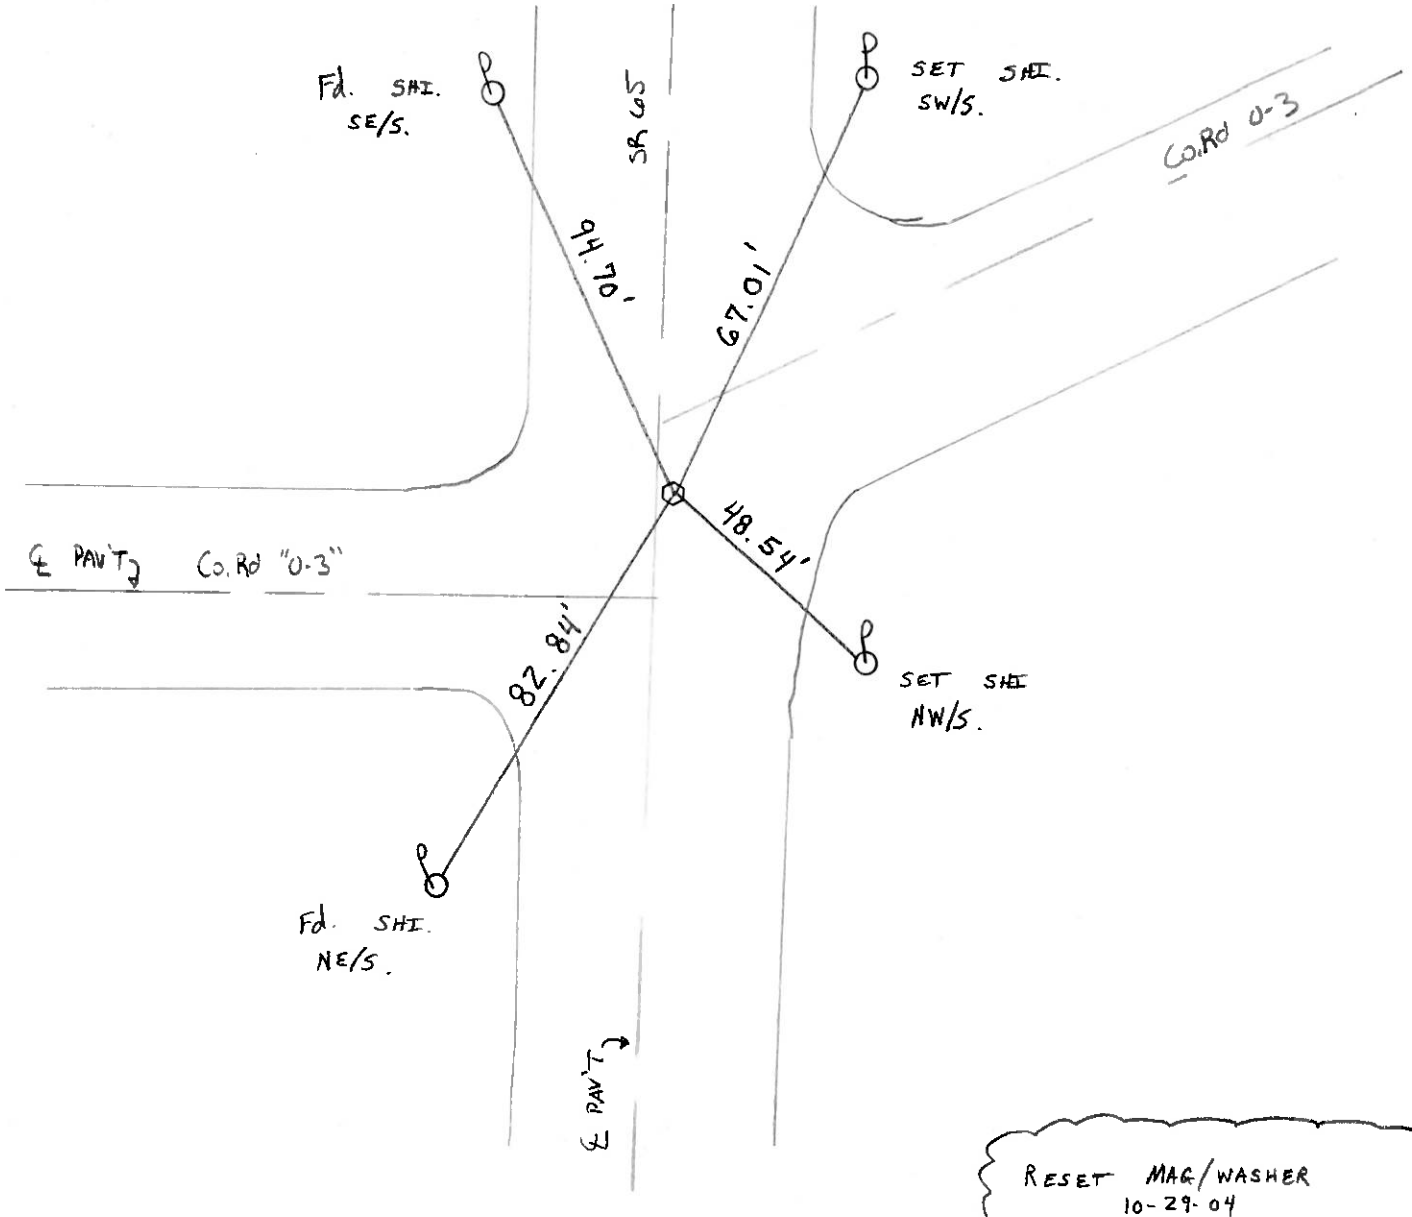

RESET MAG/WASHER
10-29-04
D.H.

O.D.O.T. DISTRICT 2 SURVEY OFFICE

PERSONNEL

NOTES Hoffman
H.C. Bannister
R.C.

REFERENCE NO. _____

DATE 3-29-91
WEATHER Clear
TEMP. 48°

SHEET 1 OF 2

ROUTE SR 109
COUNTY HENRY
TOWNSHIP HARRISON
SECTION 23
T 5 N R 7 E

TYPE MONUMENT P.K. nail / washer
ON SURFACE - ~~BELOW~~ yes
LEFT - ℄ PAV'T. - RIGHT 0.6
9.3 TO Rt EDGE PAVEMENT
S.L.M. 767+40

Re-Set P.K./WASHER 5-9-91 MB

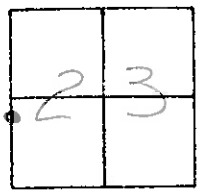

PLAN (1990) sta. =

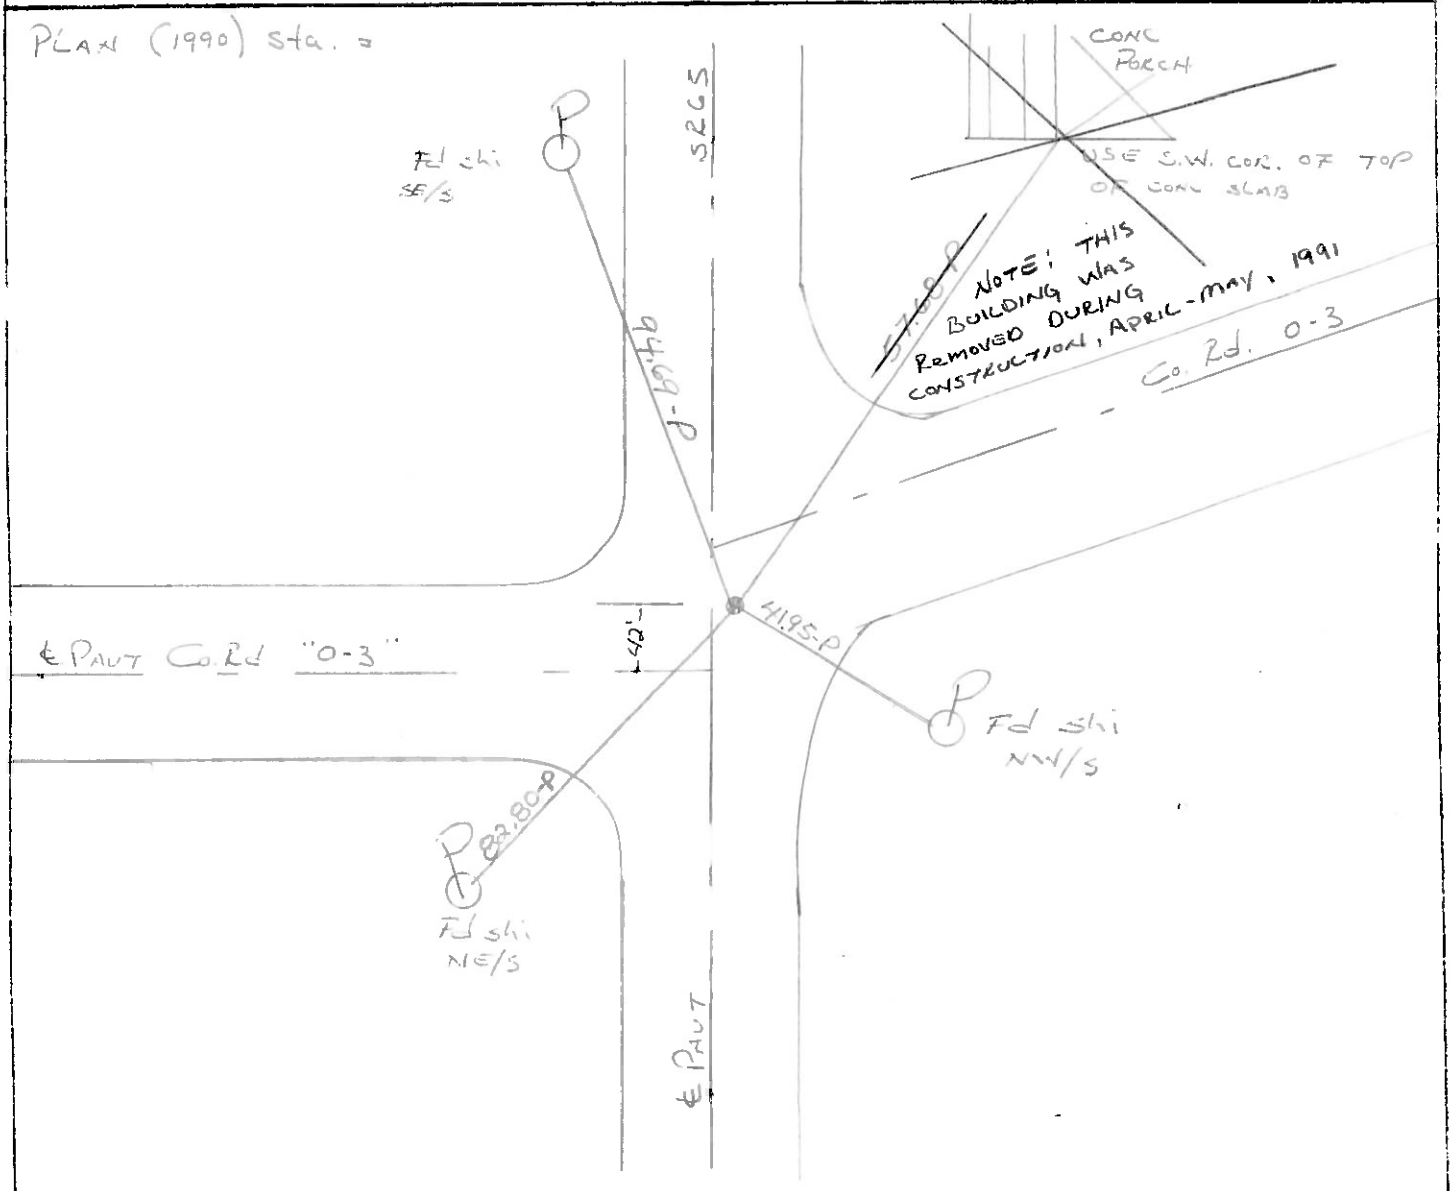

O.D.O.T. DISTRICT 2 SURVEY OFFICE

PERSONNEL

NOTES Barnhisel
H.C. " "
R.C. Hoffman

REFERENCE NO. _____ SHEET ____ OF ____

DATE 9-25-90
WEATHER Clear-Windy
TEMP. +70°

ROUTE 109
COUNTY Henry
TOWNSHIP Harrison
SECTION 23
T 5 N R 7 E

TYPE MONUMENT PK Nail & Washer
ON SURFACE - ~~BELOW~~ Yes
~~LEFT~~ - ℄ PAV'T. - RIGHT 0.6
9.3 TO RT EDGE PAVEMENT
S.L.M. 767+40

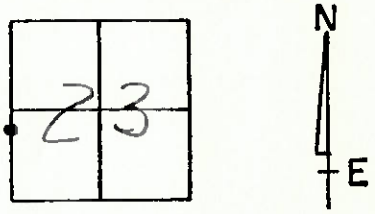

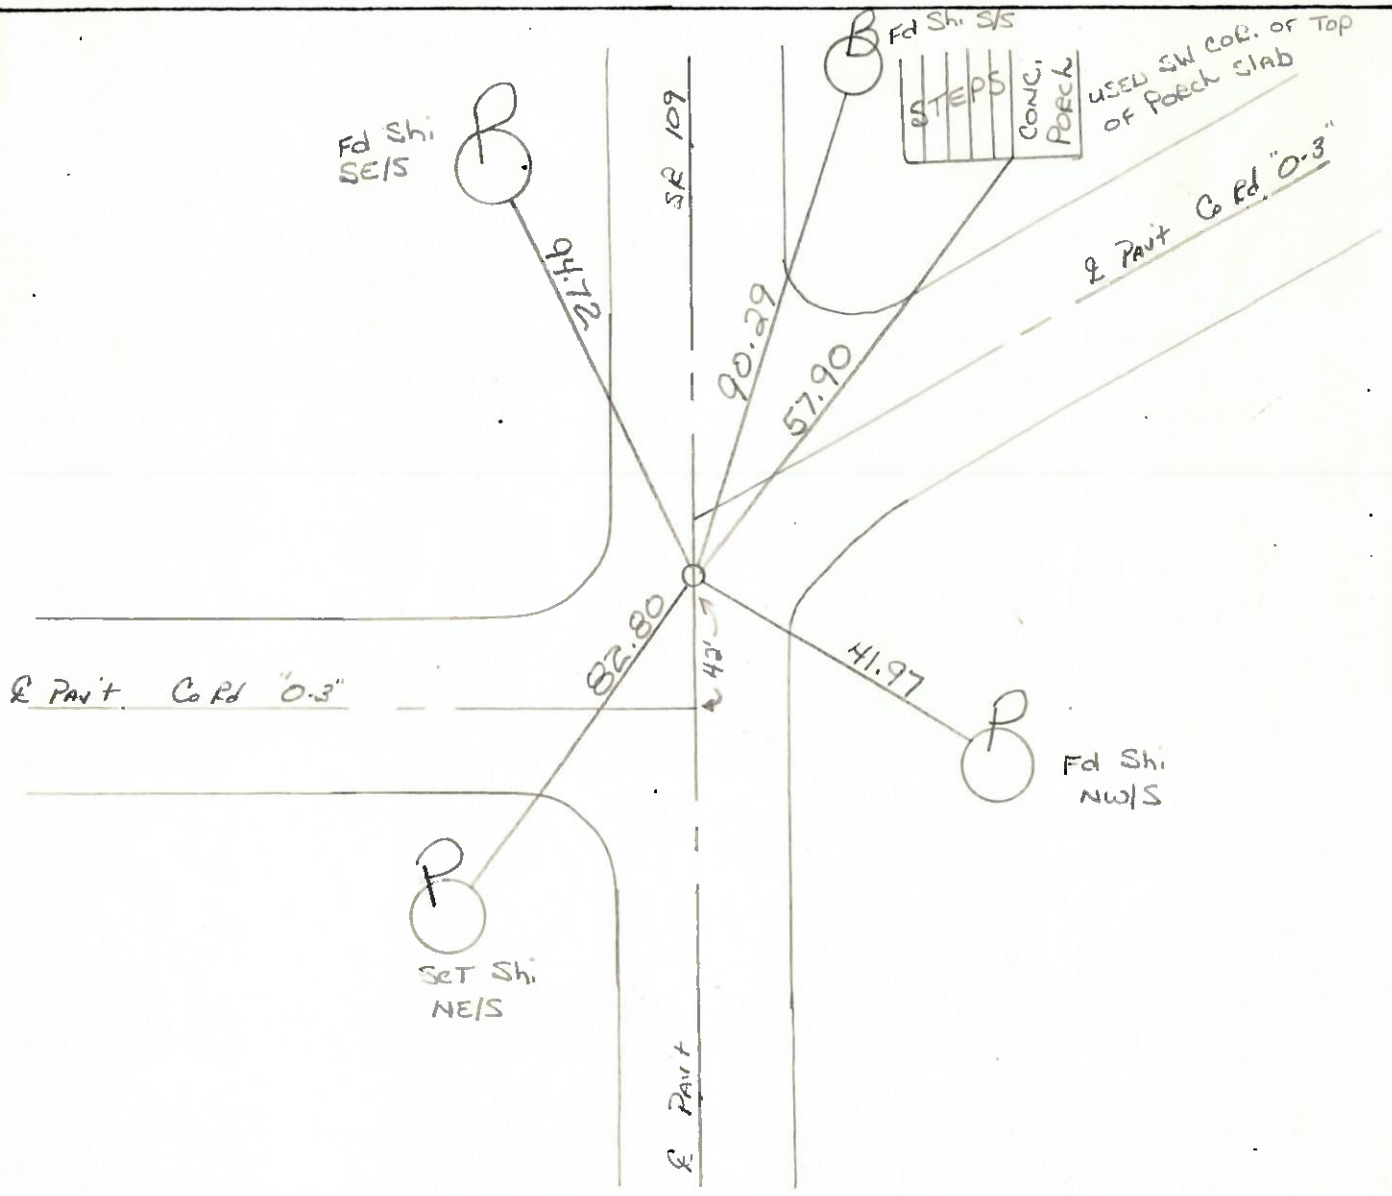

O.D.O.T. DISTRICT 2 SURVEY OFFICE

SHEET ____ OF ____

County HENRY S.R. 109
Township HARRISON
Section 23
T5N, R7E
Personnel HOFFMAN
LOEHRKE
HOUSEHOLDER R.C.
BARNHISEL H.C.

Date 3-19-84
Weather OVERCAST
Temp. +30°

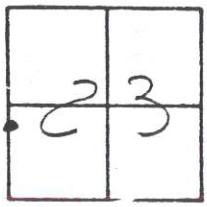

Fd P.K. Nail @ surface
ORIGIN UNKNOWN

S.2, M. = 766+44 40

SET PK/WASHER
8-23-84
S.W.H.

0.6 RT ℄
9.3 TO RT Ed.

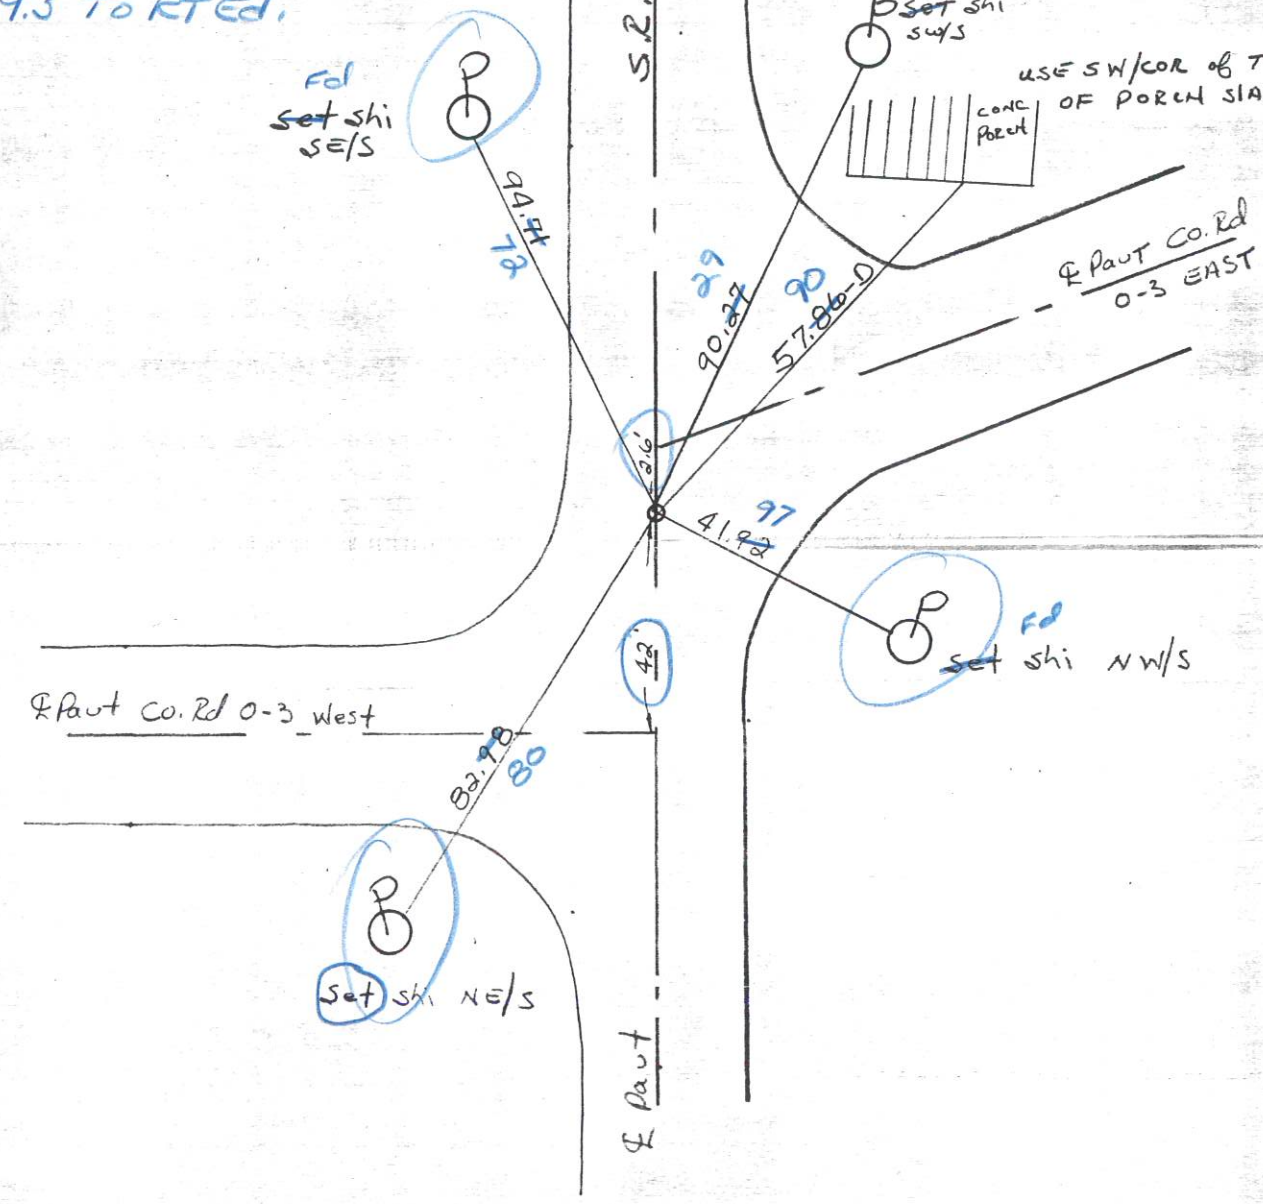

O.D.O.T. DISTRICT 2 SURVEY OFFICE

SHEET ____ OF ____

County HENRY S.R. 109
Township HARRISON
Section 23
T 5N, R 7E
Personnel HOFFMAN
LOCHBKE
HOUSEHOLDER R.C.
BARNHISEL H.C.

Date 3-19-84
Weather OVERCAST
Temp. +30°

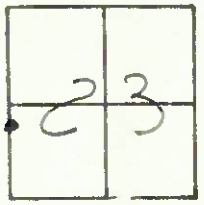

Fd P.K. Nail @ surface
ORIGIN UNKNOWN
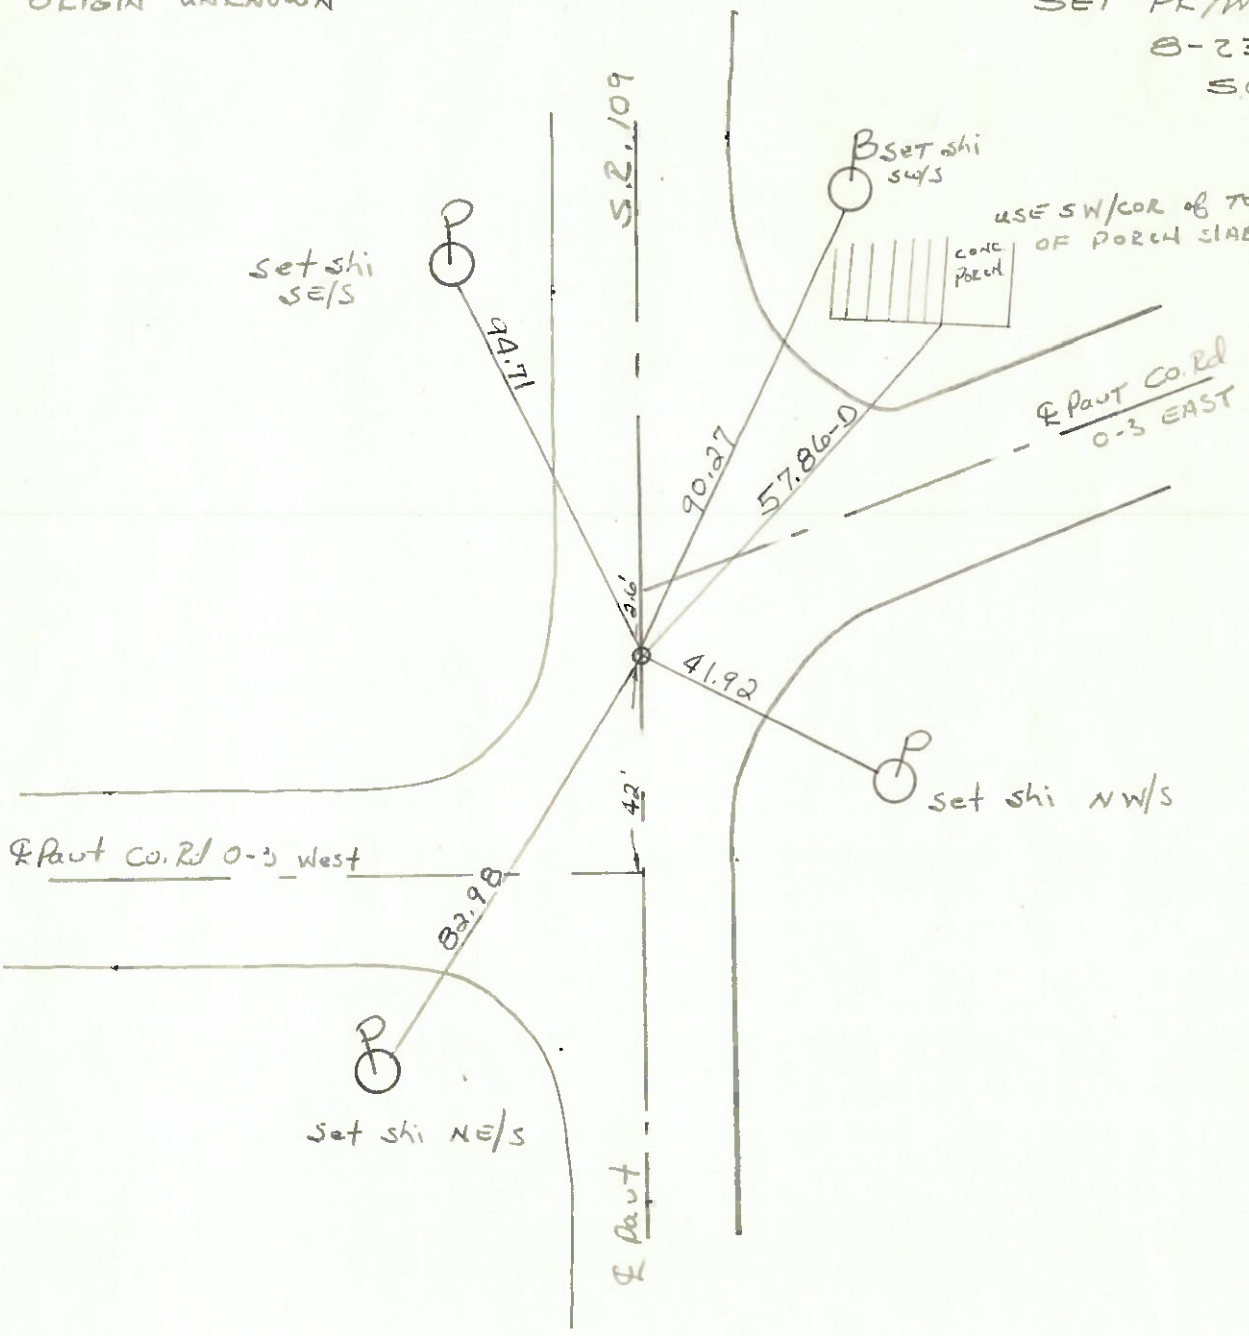
S.L.M. = 766+44
SET PK/WASHER
8-23-84
SCWH.