O.D.O.T. DISTRICT 2 SURVEY OFFICE (USE ONLY)

PERSONNEL

NOTES ASTON
H.C. AUBLE
R.C. MILLER

DWG BY RHOADES

REFERENCE NO. 38 B

DATE 525/23
WEATHER CLOUDY
TEMP. 55°

PID PAVTRAIN

SHEET 35 OF 36

ROUTE SR 109
COUNTY HENRY
TOWNSHIP HARRISON
SECTION 12
T 5 N R 7 E

TYPE MONUMENT MAG SHANK
~~ON SURFACE~~ - BELOW 1 1/2"
OFFSET ℄ PAVEMENT 0.9' LT : ~~RT~~
8.0' TO LT EDGE PAVEMENT
STATION: 944+81

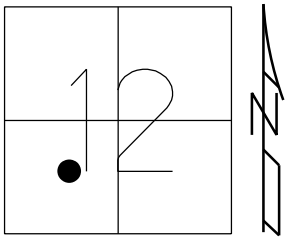

HORZ.DATUM: NAD83 2011
GEOID: NAVD88 2018
GRID: NORTHING: 637102.896
EASTING: 1553638.160

NOTE: REF 14 AC SR 110

RECORD: P.O.T.
FD P.K./WASHER
8/13/02, DCH
SET MAG/WASHER
11-29-02, DCH
SHOT HOLE
REFB38
6/17/21, JMR
FD MAG SHANK
REF14AC
4/10/23, DSA
FD MAG SHANK
7-2-24, TDN

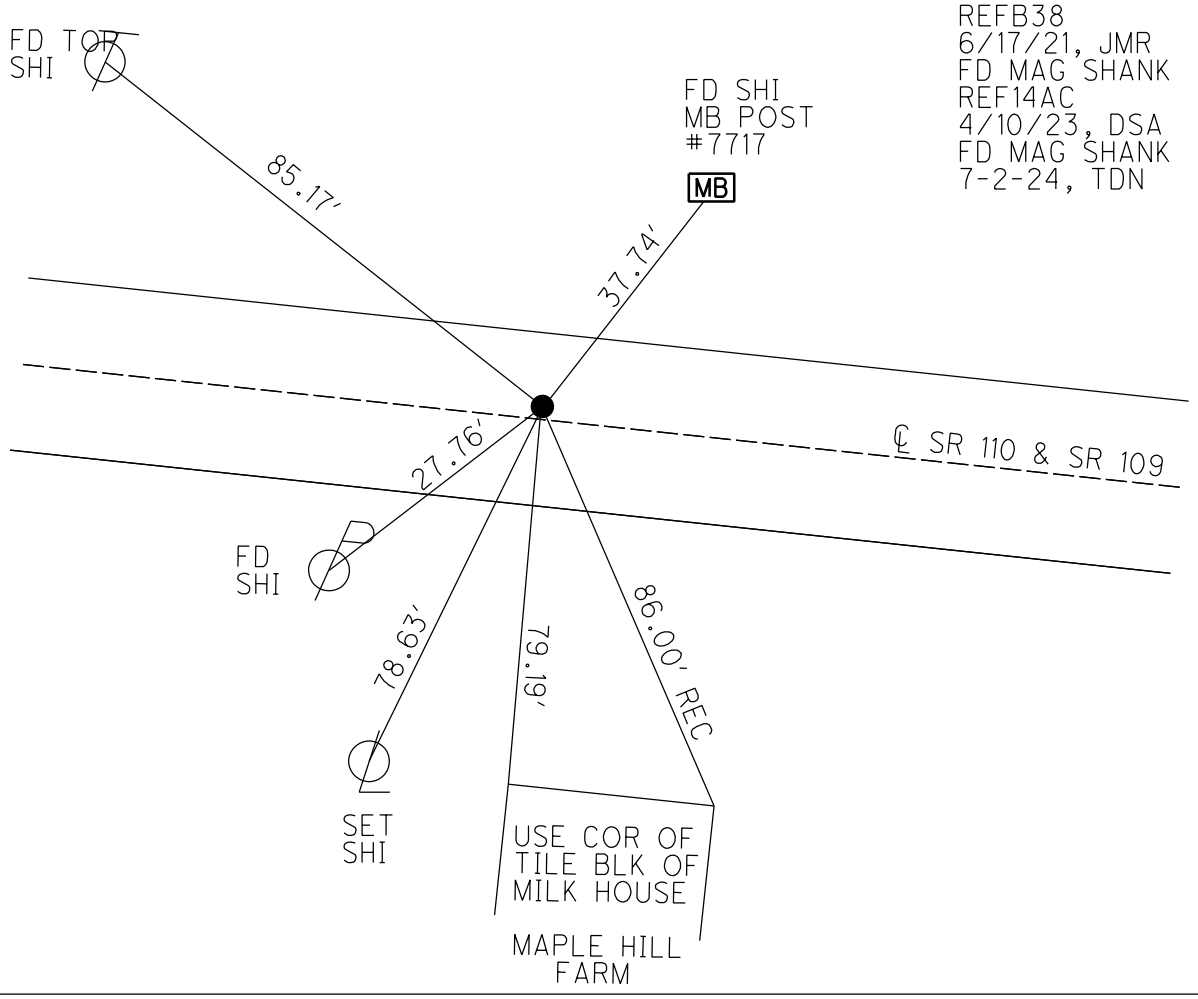

O.D.O.T. DISTRICT 2 SURVEY OFFICE (USE ONLY)

PERSONNEL

REFERENCE NO. 38 B

SHEET 35 OF 36

NOTES ASTON
H.C. AUBLE
R.C. MILLER

DATE 525/23
WEATHER CLOUDY
TEMP. 55°

ROUTE SR 109
COUNTY HENRY
TOWNSHIP HARRISON
SECTION 12
T 5 N R 7 E

DWG BY RHOADES

PID PAVTRAIN

TYPE MONUMENT MAG SHANK
~~ON SURFACE~~ - BELOW 1 1/2"
OFFSET ℄ PAVEMENT 0.9' LT : ~~RT~~
8.0' TO LT EDGE PAVEMENT
STATION: 944+81

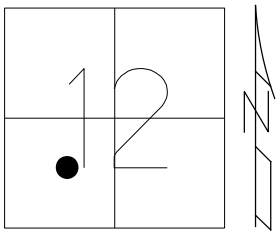

HORZ.DATUM: NAD83 2011

GEOID: NAVD88 2018

GRID: NORTHING: 637102.896

EASTING: 1553638.160

NOTE: REF 14 AC SR 110

RECORD: P.O.T.
FD P.K./WASHER
8/13/02, DCH
SET MAG/WASHER
11-29-02, DCH
SHOT HOLE
REFB38
6/17/21, JMR
FD MAG SHANK
REF14AC
4/10/23, DSA

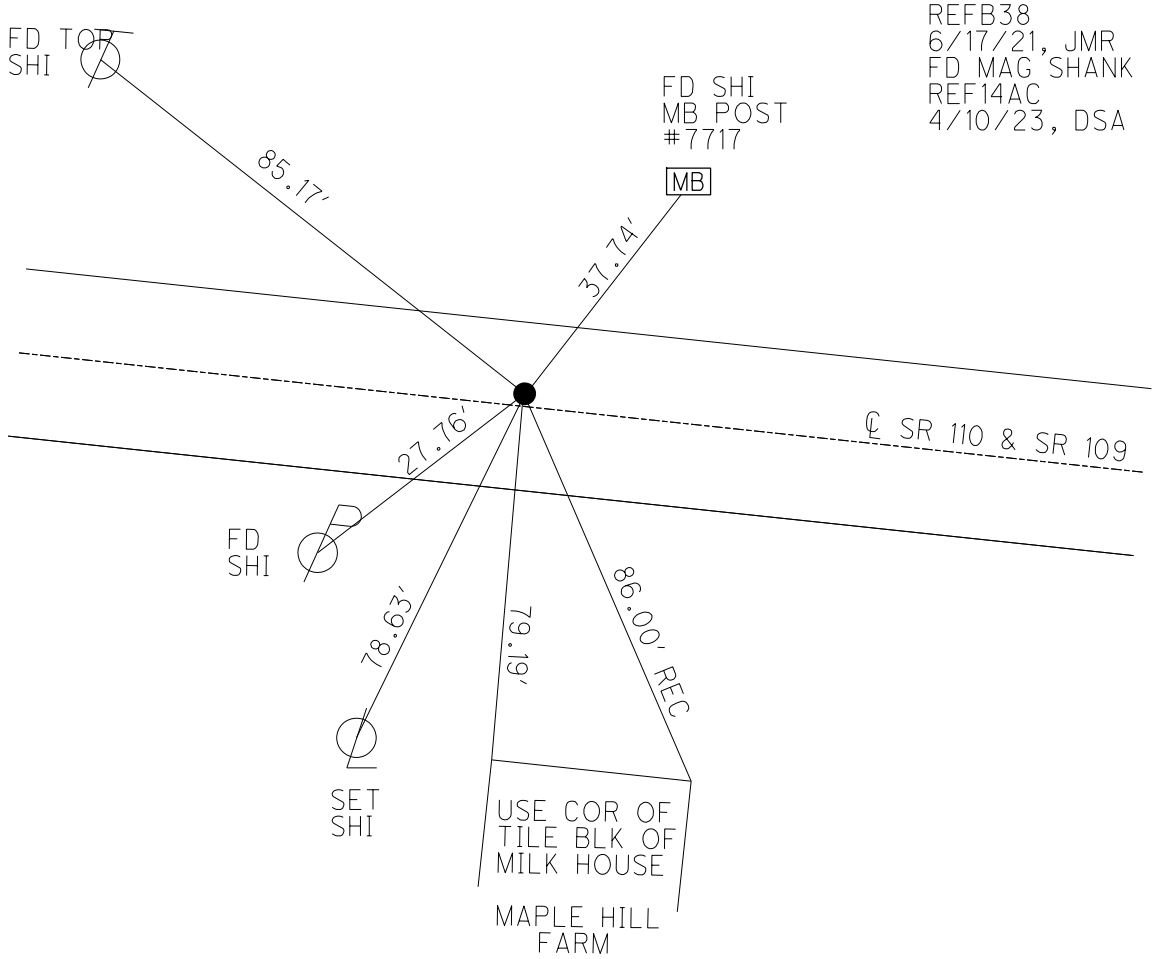

O.D.O.T. DISTRICT 2 SURVEY OFFICE (USE ONLY)

PERSONNEL

NOTES HOMAN
H.C. ROUSOS
R.C. BEAUMONT

DWG BY RHOADES

REFERENCE NO. 38 B

DATE 8/13/02
WEATHER CLOUDY
TEMP. 80°

PID PAVTRAIN

SHEET 36 OF 38

ROUTE SR 109
COUNTY HENRY
TOWNSHIP HARRISON
SECTION 12
T 5 N R 7 E

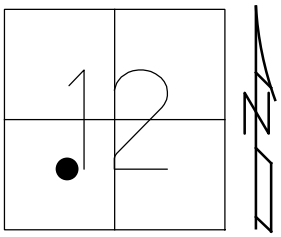

TYPE MONUMENT P.K./WASHER
ON SURFACE - ~~BELOW~~ ON
OFFSET ℄ PAVEMENT 0.9' LT : ~~RT~~
8.0' TO LT EDGE PAVEMENT
STATION: 944+81

HORZ.DATUM: NAD83 2011 GEOID: NAVD88 2018
GRID: NORTHING: 637102.896 EASTING: 1553638.160

RECORD: P.O.T.
FD P.K./WASHER
8/13/02, DCH
SET MAG/WASHER
11-29-02, DCH
SHOT HOLE
REFB38
6/17/21, JMR

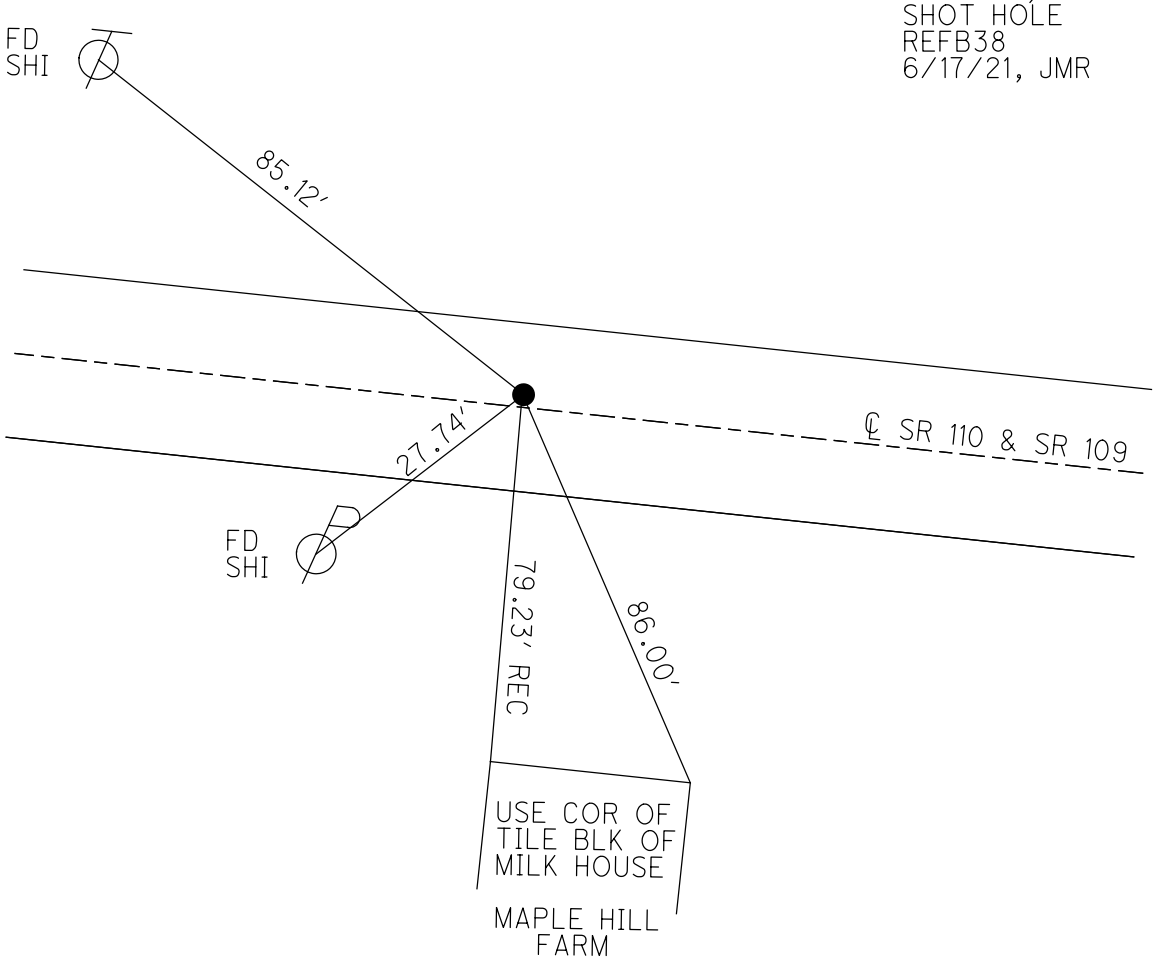

O.D.O.T. DISTRICT 2 SURVEY OFFICE (USE ONLY)

PERSONNEL

NOTES HOMAN
H.C. ROUSOS
R.C. BEAUMONT

REFERENCE NO. 38 B
DATE 8-13-02
WEATHER CLOUDY
TEMP. 80°F

SHEET 36 OF 38
ROUTE SR 109
COUNTY HENRY
TOWNSHIP HARRISON
SECTION 12
T 5 N R 7 E

TYPE MONUMENT PK/WASHER
ON SURFACE - ~~BELOW~~ ON
LEFT - ℄ PAV'T - ~~RIGHT~~ 0.9'
8.0' TO LT EDGE PAVEMENT
S.L.M. 944+81
Grid: Northing: - Easting: -

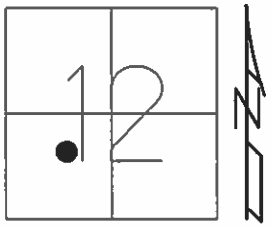

RECORD: P.O.T.
SET PK/WASHER

SET MAG/WASHER
11-29-02,DCH

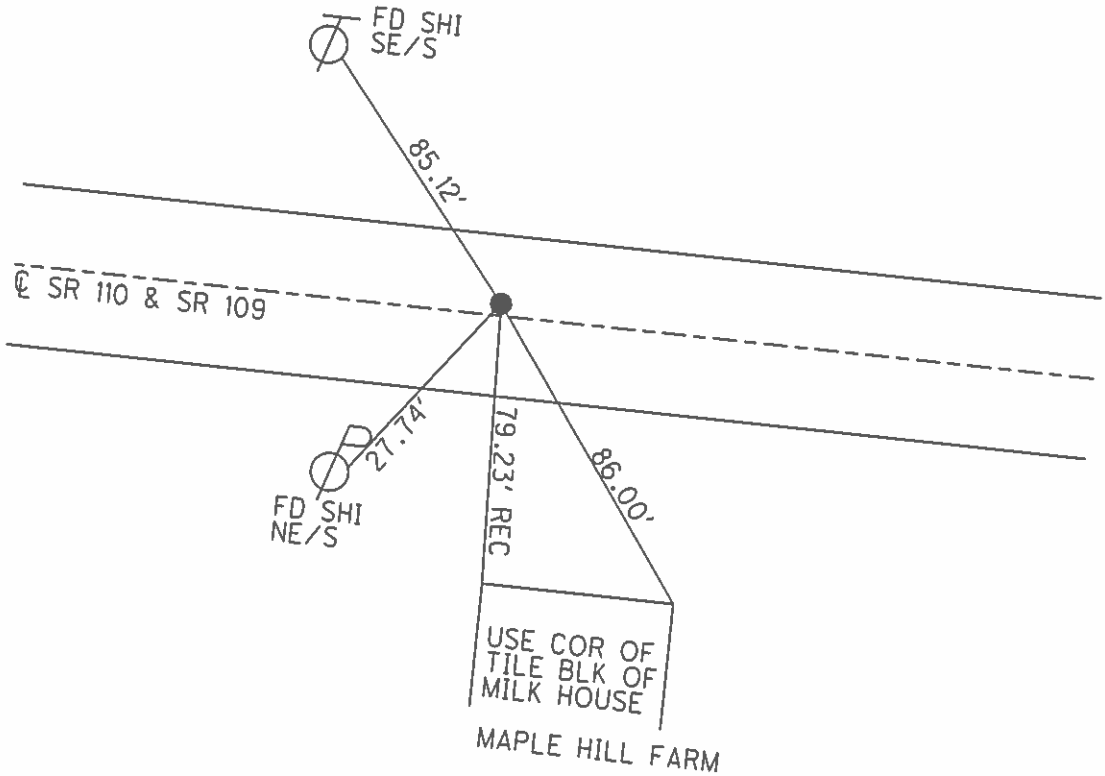

O.D.O.T. DISTRICT 2 SURVEY OFFICE

PERSONNEL

NOTES HOMAN
H.C. ROUSOS
R.C. BEAUMONT

REFERENCE NO. 388
DATE 8-13-02
WEATHER CLOUDY
TEMP. 80

SHEET 8 OF 9
ROUTE S.R. 109
COUNTY HENRY
TOWNSHIP HARRISON
SECTION 12
T 5 N R 7 E

TYPE MONUMENT PK & WASHER
ON SURFACE - ~~BELOW~~ ON
LEFT - ~~℄ PAV'T - RIGHT~~ 0.9'
8' TO LT EDGE PAVEMENT
S.L.M. 944+81

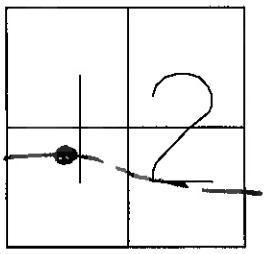

RECORD: P.O.T.
Set PK Nail

SET MAG NAIL
& WASHER
11-29-02
DCH

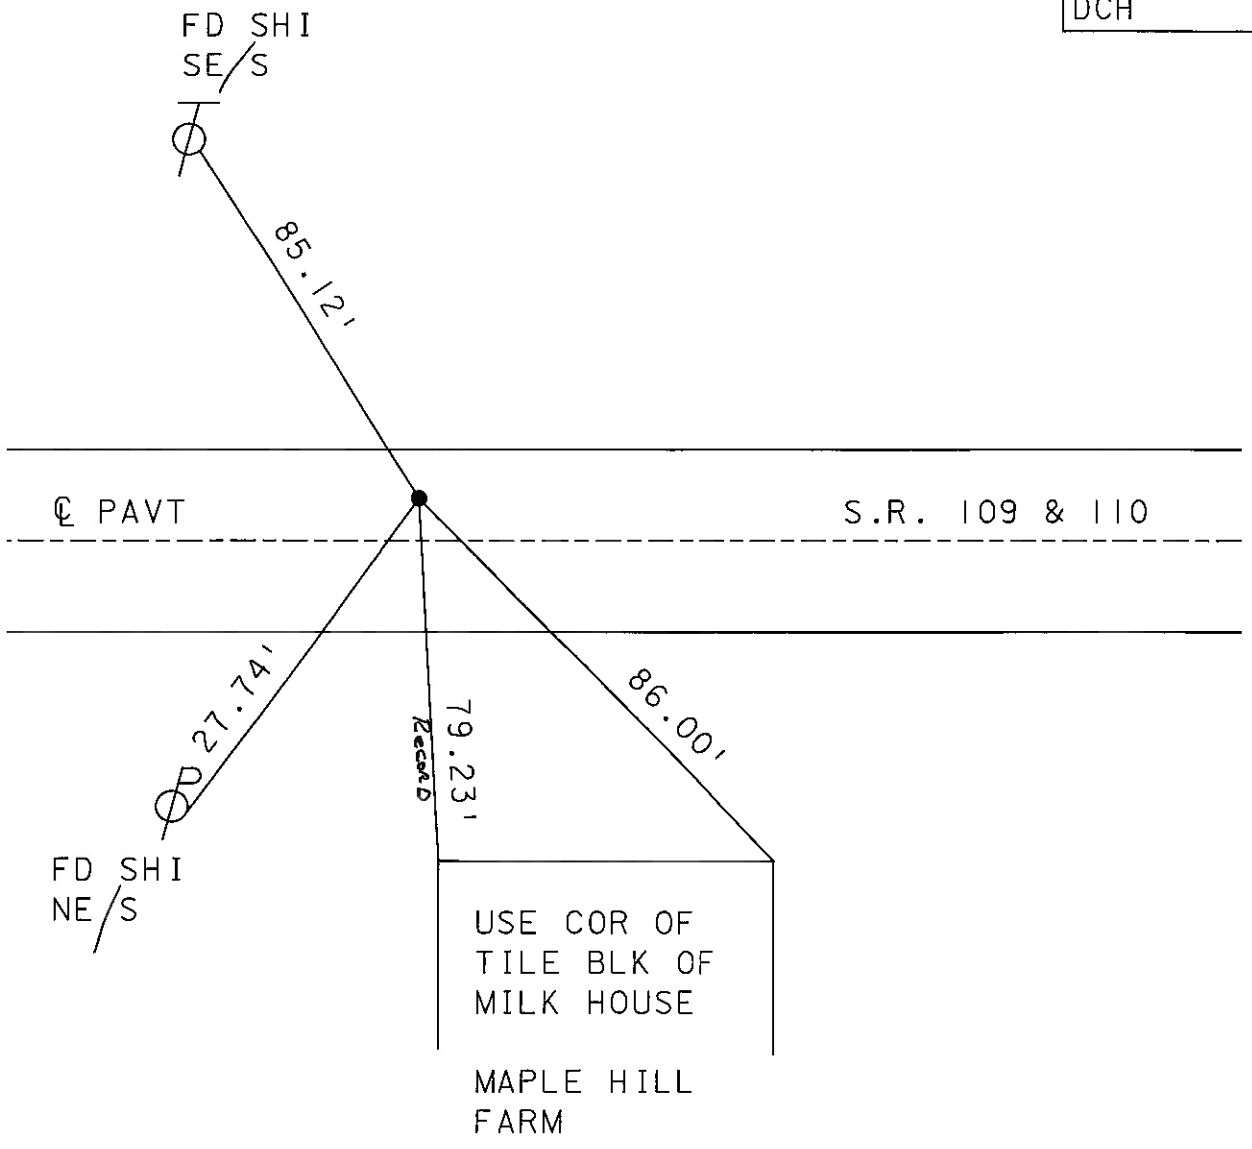

O.D.O.T. DISTRICT 2 SURVEY OFFICE

PERSONNEL
NOTES Barnhisel
H.C. " "
R.C. Hoffman

REFERENCE NO. _____ SHEET ____ OF ____

DATE 9-28-90
WEATHER Clear
TEMP. +65°

ROUTE 109 & 110
COUNTY Henry
TOWNSHIP Harrison
SECTION 12
T 5 N R 7 E

TYPE MONUMENT PK & Washer
ON SURFACE - ~~BELOW~~ Yes
LEFT - ℄ PAV'T. - ~~RIGHT~~ 0.9
~~8.7~~ TO LT EDGE PAVEMENT
S.L.M. 944+81

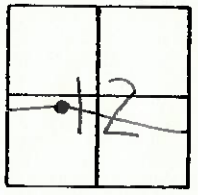

Record: P.O.T.
Set P.K. Nail

Set P.K. & Washer
10-11-90
mb

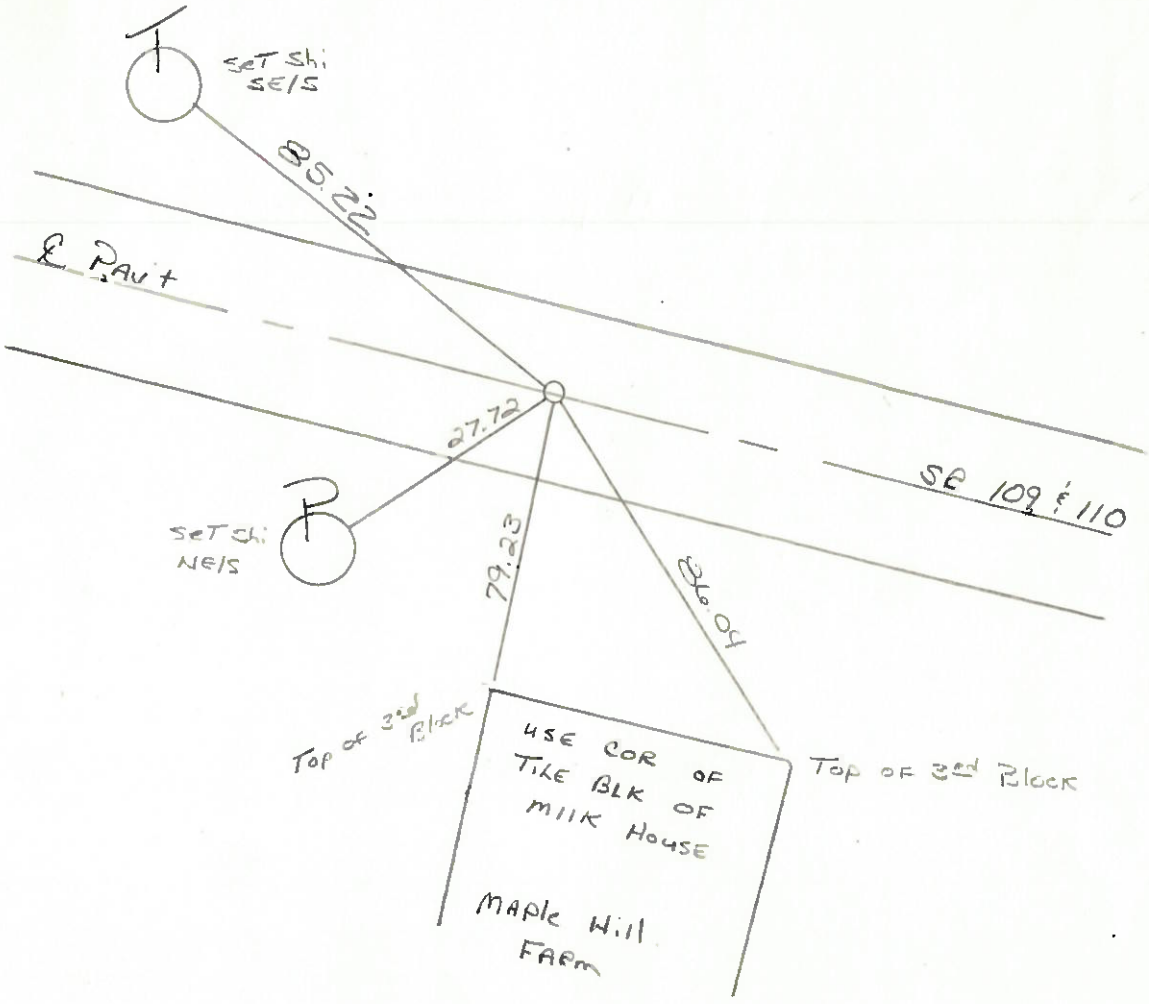

O.D.O.T. DISTRICT 2 SURVEY OFFICE

SHEET ____ OF ____

County Henry S.R. 109 & SR 110
Township Harrison
Section 12
T5N, R7E
Personnel Hoffman
Leohrke
Householder R.C.
Barnhisel H.C.

Date 3-23-84
Weather Clear
Temp. +25°

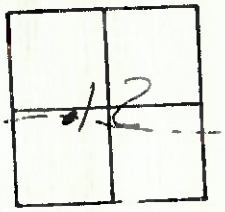

Record: P.O.T.
Set P.K. Nail

DID NOT FIND POINT

SLM 944+99

SET PK/WASHER
8-24-84
SWH
1.0 Lt of ℄ Pavt
11.0 Lt E.P.
13.0 Rt E.P.

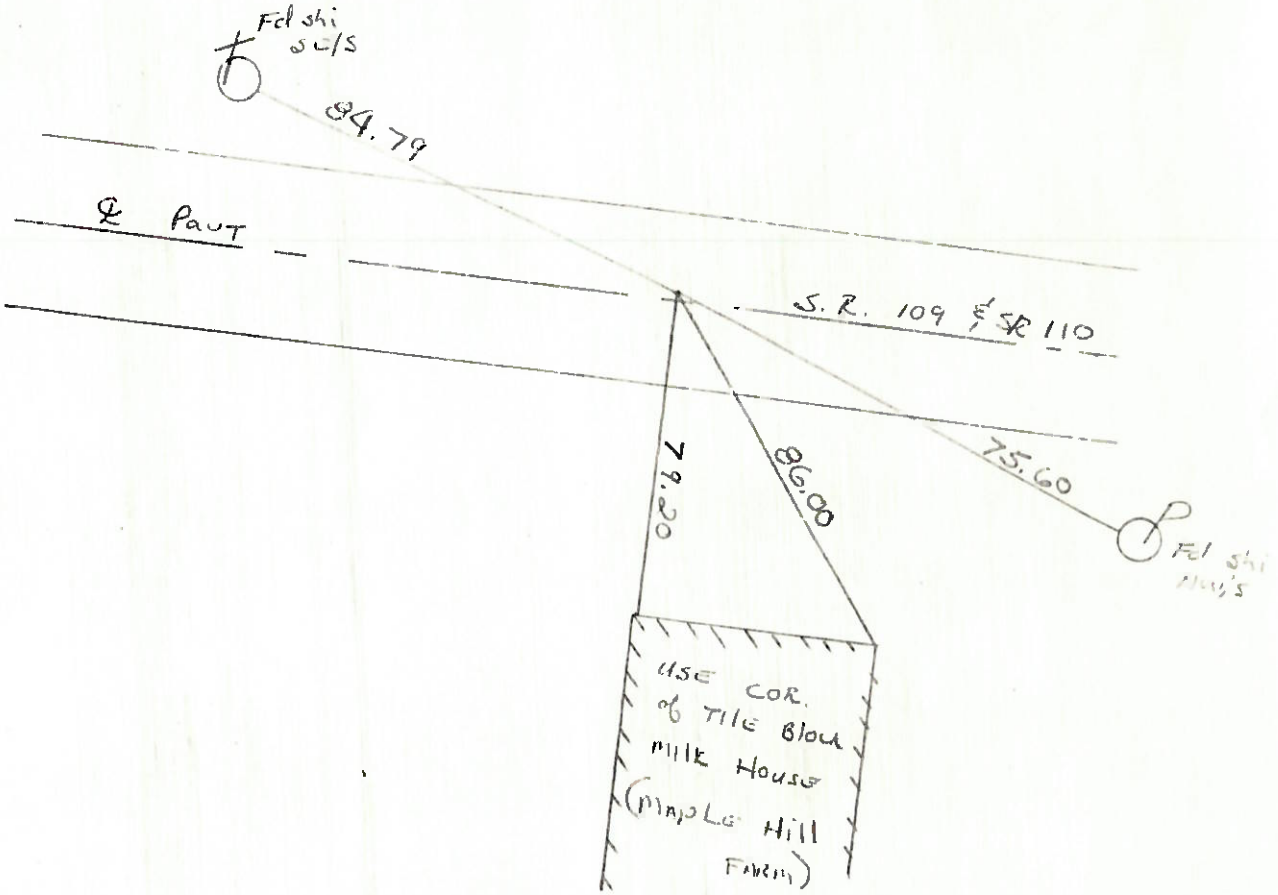

O.D.O.T. DISTRICT 2 SURVEY OFFICE

SHEET ____ OF ____

County HENRY S.R. 109 & SR 110
Township HARRISON
Section 12
T 5 N, R 7 E
Personnel HOFFMAN
LOEHRKE
HOUSEHOLDER R.C.
BARNHUSEL H.C.

Date 3-23-84
Weather Clear
Temp. +25°

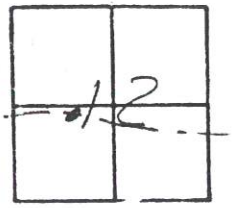

Record: P.O.T.
Set P.K. Nail

DID NOT FIND POINT

SLM 944+~~89~~ 81

SET PK/WASHER
8-24-84
SWH
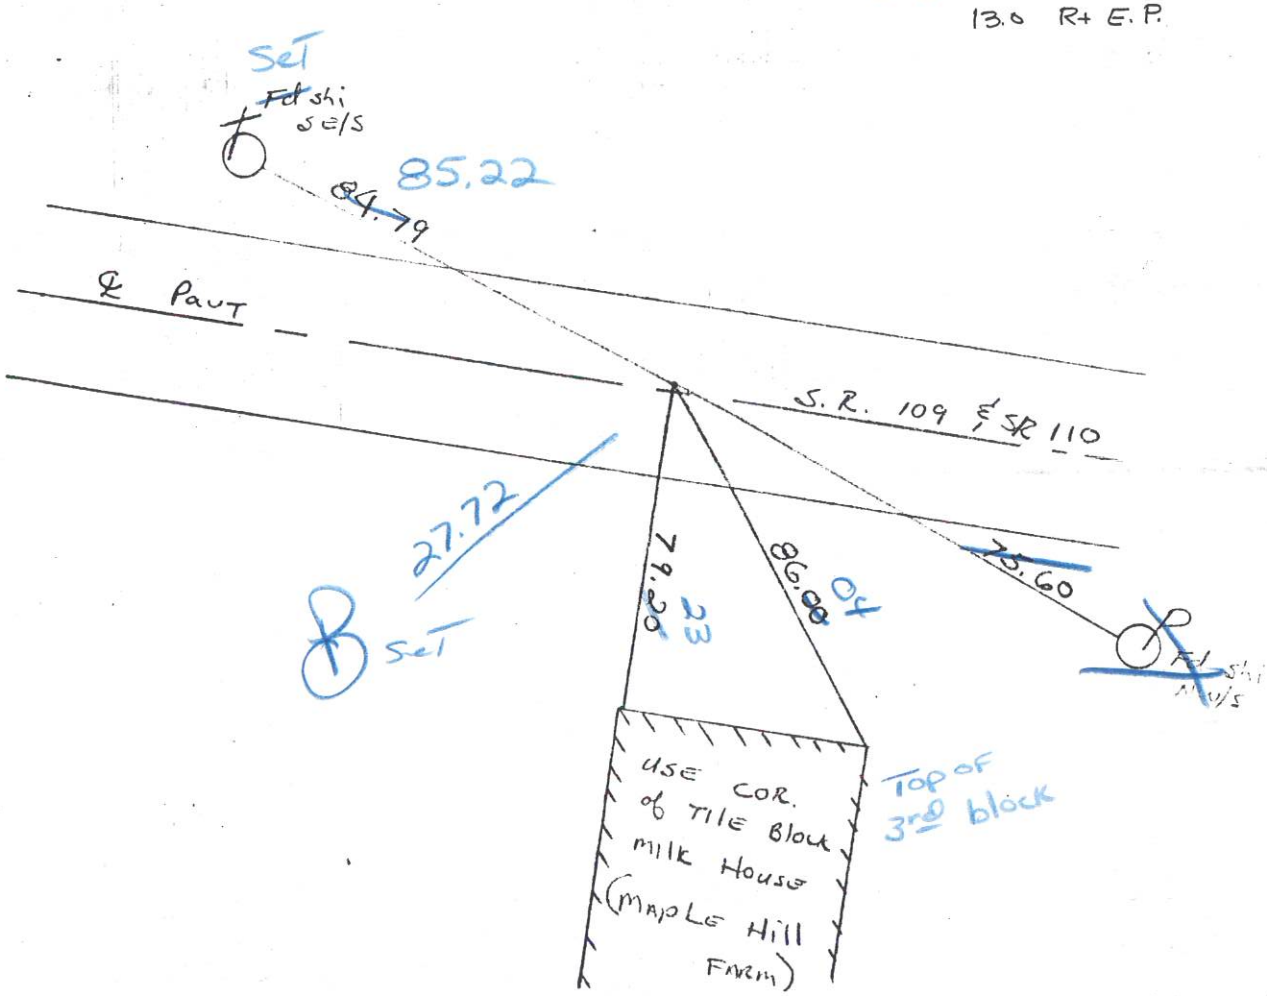
0.9 ~~11.0~~ Lt of ℄ Pav't
8.7 ~~11.0~~ Lt E.P.
13.0 Rt E.P.