

LEGEND - PROPOSED ITEMS

1 FLEXIBLE PAVEMENT OPTION USING:
 ITEM 442 - 1 1/2" ASPHALT CONCRETE SURFACE COURSE, 12.5MM, TYPE A (447), AS PER PLAN (SHT. 43)
 ITEM 407 - NON-TRACKING TACK COAT (RATE OF 0.06 GAL/SY USED FOR ESTIMATING)
 ITEM 442 - 1 3/4" ASPHALT CONCRETE INTERMEDIATE COURSE, 19MM, TYPE A (446), AS PER PLAN (SHT. 43)
 ITEM 407 - NON-TRACKING TACK COAT (RATE OF 0.09 GAL/SY USED FOR ESTIMATING)
 ITEM 302 - 4" ASPHALT CONCRETE BASE, PG64-44 (1st LIFT)
 ITEM 407 - NON-TRACKING TACK COAT (RATE OF 0.09 GAL/SY USED FOR ESTIMATING)
 ITEM 302 - 4" ASPHALT CONCRETE BASE, PG64-44 (2nd LIFT)
 -OR-
 RIGID PAVEMENT OPTION USING:
 ITEM 452 - 13" NON-REINFORCED CONCRETE PAVEMENT, CLASS OC1 WITH OC/OA


- 2 ITEM 407 - NON-TRACKING TACK COAT (RATE OF 0.06 GAL/SY USED FOR ESTIMATING)
- 3 ITEM 452 - 6" NON-REINFORCED CONCRETE PAVEMENT, CLASS OC 1P
- 6 ITEM 304 - 6" AGGREGATE BASE, AS PER PLAN (SHT. 43)
- 7 ITEM 204 - SUBGRADE COMPACTION
- 8 ITEM 204 - PROOF ROLLING
- 9 ITEM 206 - CEMENT STABILIZED SUBGRADE, 14 INCHES DEEP
 ITEM 206 - CEMENT
 ITEM 206 - CURING COAT
 ITEM 206 - MIXTURE DESIGN FOR CHEMICALLY STABILIZED SOIL
- 10 ITEM 302 - 9" ASPHALT CONCRETE BASE (2 LIFTS)
- 11 ITEM 254 - PAVEMENT PLANING, ASPHALT CONCRETE, 1 1/2"
- 12 ITEM 442 - 1 1/2" ASPHALT CONCRETE SURFACE COURSE, 12.5 MM, TYPE A (447), AS PER PLAN (SHT. 43)
- 13 ITEM 442 - 1 1/2" ASPHALT CONCRETE INTERMEDIATE COURSE, 19MM, TYPE B
- 14 ITEM 452 - 11" NON-REINFORCED CONCRETE PAVEMENT, CLASS OC 1P
- 15 ITEM 609 - CURB, TYPE 6, AS PER PLAN (SHT. 42)
- 16 ITEM 608 - 6" CONCRETE WALK

- 17 ITEM 605 - 6" SHALLOW PIPE UNDERDRAIN W/ GEOTEXTILE FABRIC
- 18 ITEM 605 - 6" BASE PIPE UNDERDRAIN W/ GEOTEXTILE FABRIC
- 19 ITEM 606 - GUARDRAIL, TYPE MGS
- 20 ITEM 622 - CONCRETE BARRIER, SINGLE SLOPE, TYPE B1
- 21 ITEM 622 - CONCRETE BARRIER, SINGLE SLOPE, TYPE D
- 22 ITEM 609 - CURB, TYPE 4-C, AS PER PLAN (SHT. 42)
- 23 ITEM 526 - REINFORCED CONCRETE APPROACH SLABS (T=15")
- 24 ITEM 526 - REINFORCED CONCRETE APPROACH SLABS (T=17")
- 25 ITEM 659 - SEEDING AND MULCHING
- 26 ITEM 622 - CONCRETE BARRIER, SINGLE SLOPE, TYPE C, AS PER PLAN (SHT. 18)
- 27 ITEM 622 - CONCRETE BARRIER, SINGLE SLOPE, TYPE C
- 28 ITEM 622 - CONCRETE BARRIER, SINGLE SLOPE, TYPE C1
- 29 ITEM 452 - 9" NON-REINFORCED CONCRETE PAVEMENT, CLASS OC 1P
- 30 ITEM 302 - 6" ASPHALT CONCRETE BASE
- 31 ITEM 442 - 2 3/4" ASPHALT CONCRETE INTERMEDIATE COURSE, 19MM, TYPE B
- 32 ITEM 609 - COMBINATION CURB AND GUTTER, TYPE 2, AS PER PLAN (SHT. 42)
- 33 ITEM 304 - 8" AGGREGATE BASE, AS PER PLAN (SHT. 43)
- 34 ITEM 441 - 2 1/2" ASPHALT CONCRETE SURFACE COURSE, TYPE 1, (448), PG64-22 (2 LIFTS) AS PER PLAN (SHT. 43)
- 35 ITEM 452 - 13" NON-REINFORCED CONCRETE PAVEMENT, CLASS OC 1P
- 36 LONGITUDINAL JOINT AS PER BP-2.1
- 37 ITEM 204 - EXCAVATION OF SUBGRADE
 ITEM 204 - EMBANKMENT
- 38 ITEM 618 - RUMBLE STRIPS (SHT. 23)


LEGEND - EXISTING ITEMS

- (A) 3" ± ASPHALT CONCRETE
- (AA) 7" ± ASPHALT CONCRETE
- (AB) 1" ± ASPHALT CONCRETE
- (AC) 4 1/2" ± ASPHALT CONCRETE
- (AD) 5 1/4" ± ASPHALT CONCRETE
- (B) 9" ± PLAIN CONCRETE PAVEMENT
- (BA) 9" ± REINFORCED CONCRETE PAVEMENT
- (BB) VARIABLE DEPTH PLAIN CONCRETE PAVEMENT
- (BC) 11" ± REINFORCED CONCRETE PAVEMENT
- (C) 6" ± SUBBASE
- (CA) 3" ± WATERPROOFED AGGREGATE BASE
- (CB) 4" ± AGGREGATE BASE
- (D) 3" TO 6" ± STABILIZED CRUSHED AGGREGATE
- (DA) 7" ± STABILIZED CRUSHED AGGREGATE
- (E) PIPE UNDERDRAIN
- (F) CONCRETE BARRIER, TYPE B-50
- (FA) CONCRETE BARRIER, TYPE D
- (G) GUARDRAIL
- (H) CURB
- (HA) CURB AND GUTTER
- (I) WALK
- (J) 6" ± ASPHALT CONCRETE BASE
- (JA) 3" ± ASPHALT CONCRETE BASE
- (JB) 10" ± ASPHALT CONCRETE BASE
- (K) 15" ± REINFORCED CONCRETE APPROACH SLAB

pw:\BN-pw.bentley.com\bn-pw-01\Documents\pr-55239\Sum\10402\Design\roadway\BN\sheet\10402C\1001.dgn Sheet 12/16/2020 3:55:42 PM soroka

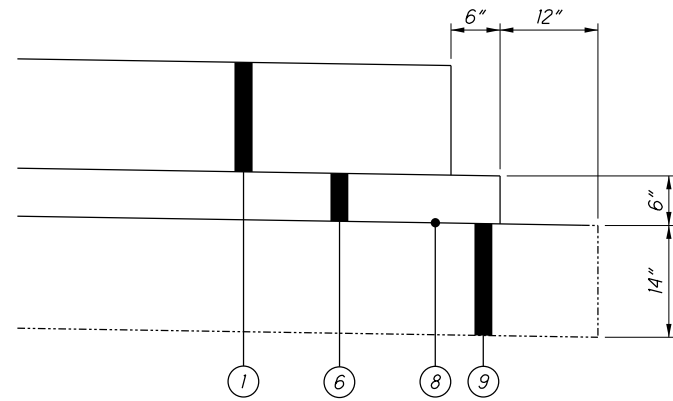


1 PAVEMENT "STEP" DETAIL
RIGID PAVEMENT OPTION

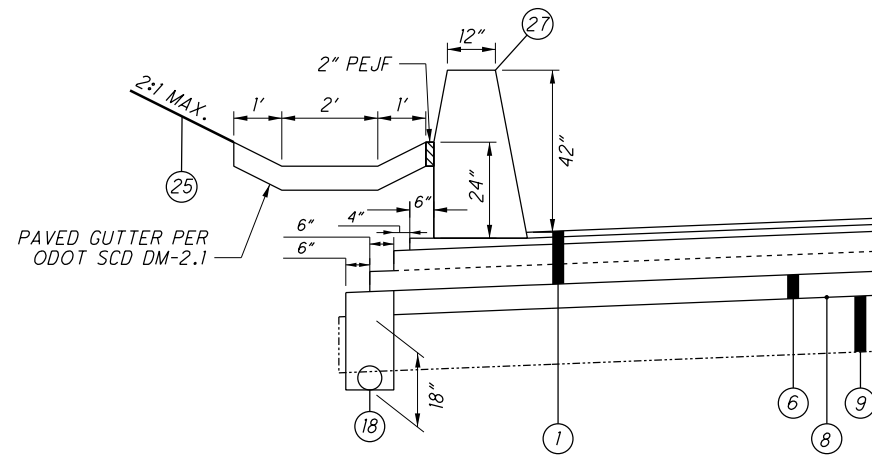

ITEM 622-CONCRETE BARRIER, TYPE C, AS PER PLAN


5 SHOWN FOR FLEXIBLE PAVEMENT OPTION

CONSTRUCT BARRIER PER THIS DETAIL. PAYMENT SHALL BE MADE PER LINEAR FOOT OF BARRIER CONSTRUCTED AND SHALL INCLUDE PAVED GUTTER AND PEJF

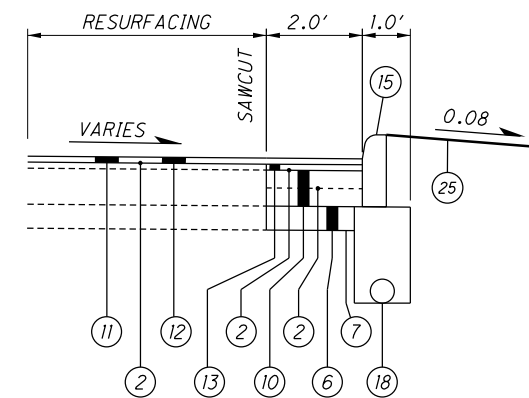


CURB REPLACEMENT W/ RESURFACING

6 (FOR SIDE ROADS AND DRIVES)

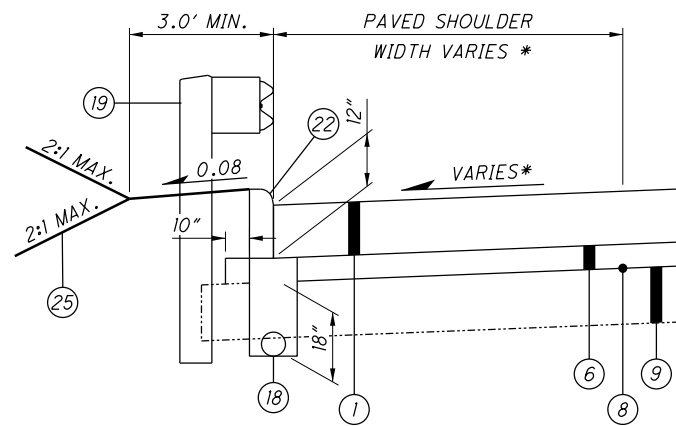

CURB AND GUARDRAIL DETAIL


2 (FOR MAINLINE AND RAMPS)

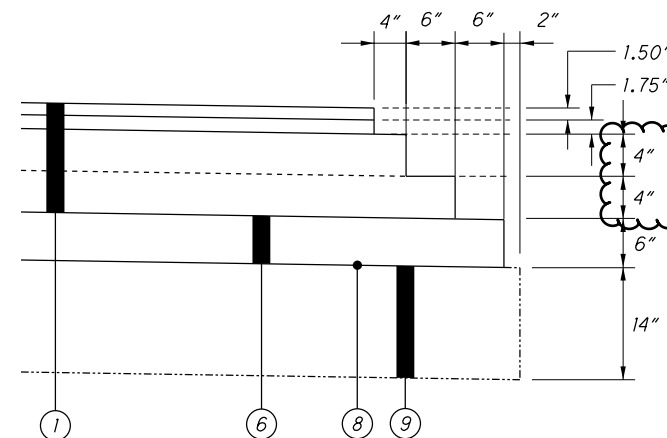

7 PAVEMENT "STEP" DETAIL


FLEXIBLE PAVEMENT OPTION

SURFACE COURSE SHALL BE PLACED AFTER ALL PHASES REQUIRING TRAFFIC SHIFTS ARE COMPLETE AND TRAFFIC RETURNED TO NORMAL LANES.

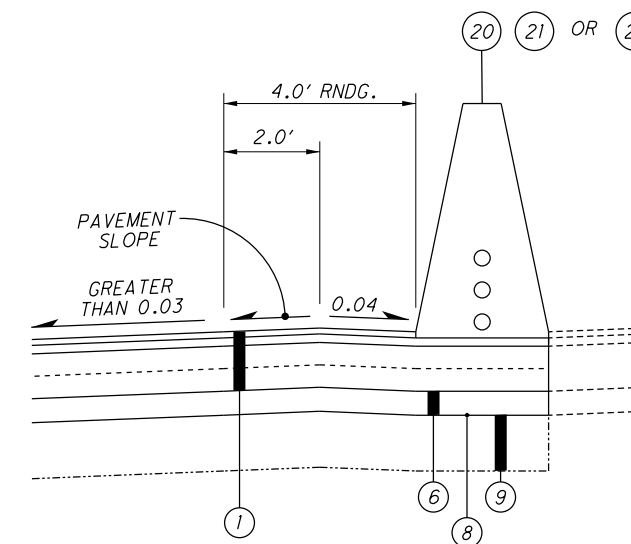


HIGH SIDE BARRIER DETAIL "A"

4 FLEXIBLE PAVEMENT OPTION

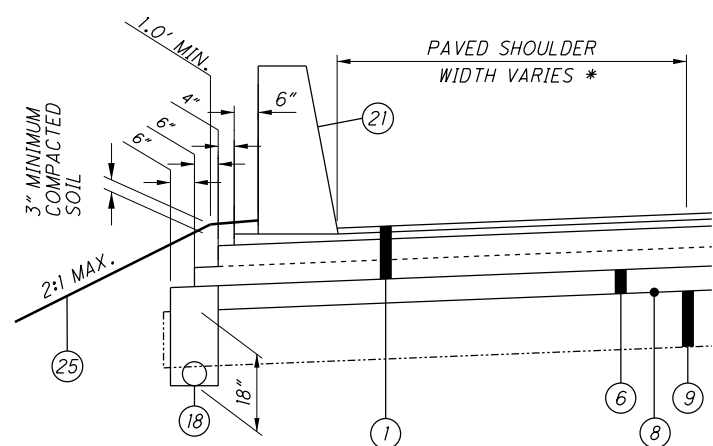


ITEM 622 - CONCRETE BARRIER, TYPE D

3 FLEXIBLE PAVEMENT OPTION

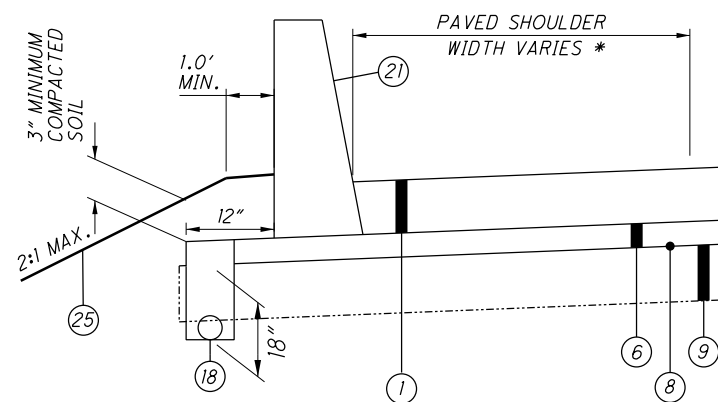

ITEM 622 - CONCRETE BARRIER, TYPE D

3 RIGID PAVEMENT OPTION

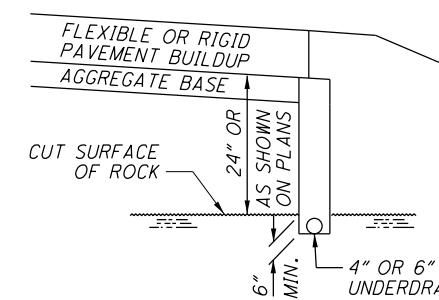

ROCK EXCAVATION DETAIL

PER CMS 204.05 ROCK, COAL OR SHALE SUBGRADE

NOTES

FOR DITCH, SIDE SLOPE GRADING AND ROUNDING DETAILS SEE SHEETS 37, 39
 * SEE TYPICAL SECTIONS FOR DETAILS
 SLJ = STANDARD LONGITUDINAL JOINT
 SLJWT = STANDARD LONGITUDINAL JOINT WITHOUT TIEBARS

X REF. DETAIL NO., SEE PVMT. CALCS.

PAVEMENT NOTES

CONTRACTION AND/OR EXPANSION JOINTS

ALTHOUGH SPECIFIC LOCATIONS OF CERTAIN CONTRACTION AND EXPANSION JOINTS HAVE BEEN DETAILED ON THIS PLAN, NO WAIVER OF THE SPECIFICATIONS IS INTENDED. IN ALL CASES, THE PROVISION OF EXPANSION JOINTS AT ALL MAJOR STRUCTURES INCLUDING THE MAXIMUM SPACING BETWEEN CONTRACTION JOINTS IS IN ACCORDANCE WITH STANDARD CONSTRUCTION DRAWING BP-2.2 AND THE SPECIFICATIONS.

CONTRACTION JOINTS IN CONCRETE PAVEMENT OR BASE WIDENING

WHERE NEW CONCRETE IS PLACED ADJACENT TO EXISTING CONCRETE, PROVIDE CONTRACTION JOINTS IN THE NEW CONCRETE TO FORM CONTINUOUS JOINTS WITH THOSE IN THE EXISTING CONCRETE. THE MAXIMUM DISTANCE BETWEEN THE JOINTS IN THE NEW CONCRETE ARE IN ACCORDANCE WITH STANDARD CONSTRUCTION DRAWING BP-2.2, IF NECESSARY, ADDITIONAL JOINTS MAY BE PROVIDED IN THE NEW CONCRETE AT APPROXIMATELY EQUAL INTERVALS BETWEEN EXISTING JOINTS THAT EXCEED THE MAXIMUM SPACING.

PHASE JOINT FOR PAVEMENT

PER THE PHASE JOINT DETAIL, BEFORE PAVING AGAINST THE PHASE JOINT, THE CONTRACTOR SHALL MILL OUT THE UNCONSOLIDATED EDGE OF EACH PAVEMENT COURSE TO PROVIDE THE APPROPRIATE STEPS IN THE PAVEMENT JOINT, WHILE REMOVING UNCONSOLIDATED MATERIAL, PER THE DETAIL BELOW. UPON COMPLETION OF THE MILLING, THE VERTICAL FACES SHALL BE SEALED WITH SUPPLEMENTAL SPECIFICATION 875.02 HOT APPLIED ASPHALT JOINT ADHESIVE TO PROVIDE 100% COVERAGE OF THE JOINTS. THE COST FOR MILLING AND SEALING SHALL BE INCIDENTAL TO THE COST OF THE COST OF THE PAVEMENT ITEMS.

THE FOLLOWING QUANTITIES HAVE BEEN PROVIDED FOR THE WORK NOTED ABOVE:

RIGID PAVEMENT OPTION

ITEM 442 - 1 3/4" ASPH. CONCRETE INTERMEDIATE COURSE, 19MM, TYPE A (446) XXX CU. YD.

ITEM 302 - 10" ASPH. CONCRETE BASE, PG64-22 XXX CU. YD

ITEM 407 - NON-TRACKING TACK COAT XXX GAL.

ITEM 442 - ANTI-SEGREGATION EQUIPMENT XXX CU. YD.


FLEXIBLE PAVEMENT OPTION

ITEM 442 - 1 3/4" ASPH. CONCRETE INTERMEDIATE COURSE, 19MM, TYPE A (446) 140 CU. YD.

ITEM 302 - 10" ASPH. CONCRETE BASE, PG64-22 380 CU. YD.

ITEM 407 - NON-TRACKING TACK COAT 110 GAL.

ITEM 442 - ANTI-SEGREGATION EQUIPMENT 95 CU. YD.

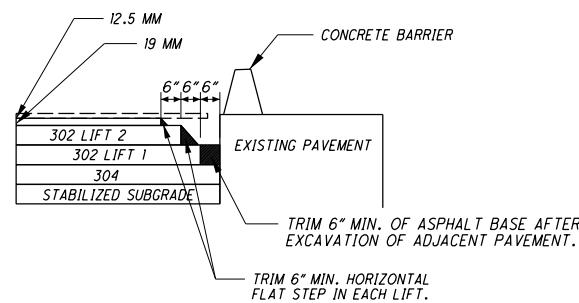

PHASING JOINT DETAIL

INTERSECTIONS

INTERSECTIONS WILL BE RESURFACED 2 FT. BEYOND THE EDGE LINE, UNLESS OTHERWISE DIRECTED BY THE ENGINEER OR INDICATED IN THE PLAN. INTERSECTIONS SHALL BE PAVED AFTER COMPLETION OF THE SURFACE COURSE OR WITH THE MAINLINE PAVEMENT IF THIS CAN BE ACCOMPLISHED WITHOUT CHANGING THE VELOCITY AND DIRECTION OF THE PAVER. USE THE SAME ASPHALT CONCRETE AS THE MAINLINE PAVEMENT. A BUTT JOINT, AS PER STANDARD CONSTRUCTION DRAWING BP-3.1, SHALL BE USED TO PROVIDE A SMOOTH TRANSITION TO THE EXISTING PAVEMENT. ANY GRADING OR PRIME NECESSARY TO ACCOMPLISH THIS WORK SHALL BE INCLUDED IN THE COST OF THE ASPHALT SURFACE COURSE.

BUTT JOINTS

AT THE START OR END OF ALL FULL-DEPTH PAVEMENT SECTIONS SHOWN IN THE PLANS, CONTRACTOR SHALL PROVIDE A BUTT JOINT PER SCD BP-3.1.

UNDERDRAIN CONNECTIONS AT SAWCUTS

AT THE START, END OR WIDENING OF ALL FULL-DEPTH PAVEMENT SECTIONS SHOWN IN THE PLANS, CONTRACTOR SHALL CONNECT PROPOSED UNDERDRAINS TO EXISTING AND ENSURE POSITIVE DRAINAGE IS MAINTAINED.

ITEM 251 - PARTIAL DEPTH PAVEMENT REPAIR (441)


A QUANTITY OF THIS ITEM SHALL BE PROVIDED FOR USE AS DIRECTED BY THE ENGINEER. THIS ITEM SHALL CONSIST OF REPAIRING EXISTING LOCATIONS EXHIBITING SURFACE DETERIORATION AND PLACING ITEM 441 ASPHALT CONCRETE, TYPE 2. THE ASPHALT CONCRETE SHALL BE COMPACTED WITH A TYPE 1 PNEUMATIC TIRE ROLLER AND A STEEL WHEEL ROLLER AS PER 401.13. IT IS NOT THE INTENT TO REPAIR EVERY DETERIORATED AREA WITHIN THE PROJECT. THE ENGINEER SHALL DETERMINE WHICH AREAS ARE TO BE REPAIRED. UNLESS OTHERWISE DIRECTED BY THE ENGINEER THIS ITEM SHALL BE PERFORMED AFTER THE COMPLETION OF MAINLINE PAVEMENT PLANNING. ALSO, THIS ITEM SHALL COMMENCE WITHIN 7 DAYS OF THE COMPLETION OF MAINLINE PAVEMENT PLANNING. PAVEMENT SHALL BE BASED ON THE ACTUAL NUMBER OF SQUARE YARDS OF PAVEMENT REPAIR. SEE DETAIL BELOW. THE FOLLOWING ESTIMATED QUANTITY HAD BEEN CARRIED TO THE GENERAL SUMMARY:

ITEM 251, PARTIAL DEPTH PAVEMENT REPAIR (442), 250 SQ. YD.

ITEM 253 - PAVEMENT REPAIR

A QUANTITY OF THIS ITEM SHALL BE PROVIDED FOR USE AS DIRECTED BY THE ENGINEER. THIS ITEM SHALL CONSIST OF CUTTING AND REMOVING DETERIORATED PAVEMENT FULL DEPTH AND PLACING 12\"/>

ITEM 253, PAVEMENT REPAIR, 250 SQ YD

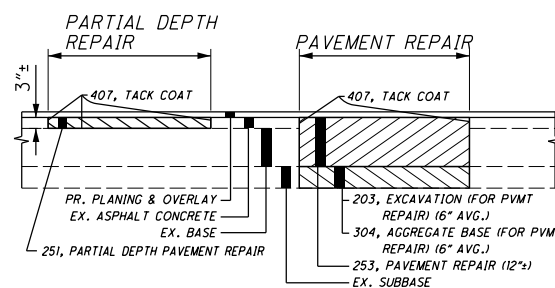

PAVEMENT REPAIR DETAIL

PAVEMENT RESTORATION FOR PIPE INSTALLATIONS AND/OR REMOVALS

THE FOLLOWING QUANTITY HAS BEEN PROVIDED FOR PAVEMENT RESTORATION FOLLOWING INSTALLATION AND/OR REMOVAL OF PIPES.

ITEM 302 - ASPHALT CONCRETE BASE, PG64-22 15 CU. YDS.

THE ABOVE QUANTITY IS BASED ON A 301 THICKNESS OF 8 INCHES AND A PAVEMENT RESTORATION WIDTH THAT INCLUDES THE TRENCH WIDTH PLUS TWO FEET ON EACH SIDE OF THE TRENCH.

PROVIDE ANY MATERIALS USED OUTSIDE THE LIMITS STATED ABOVE AT NO ADDITIONAL COST.

PAVEMENT RESTORATION FOR DRAINAGE STRUCTURE INSTALLATIONS

THE FOLLOWING QUANTITY IS PROVIDED FOR PAVEMENT RESTORATION FOLLOWING INSTALLATION OF ITEM 611, DRAINAGE STRUCTURES.

ITEM 302, ASPHALT CONCRETE BASE, PG64-22 10 CU. YDS.

THE ABOVE QUANTITY IS BASED ON A 301 THICKNESS OF 8 INCHES AND A WIDTH OF TWO FEET AROUND THE PERIMETER OF THE DRAINAGE STRUCTURE.

PROVIDE ANY MATERIALS USED OUTSIDE THE LIMITS STATED ABOVE AT NO ADDITIONAL COST.

ITEM 304 - AGGREGATE BASE, AS PER PLAN

GRANULATED SLAG (GS) SHALL NOT BE PERMITTED FOR THIS ITEM. ALL OTHER REQUIREMENTS OF SECTIONS 304 AND 703.17 OF THE CONSTRUCTION

ITEM 441 & 442 - ASPHALT CONCRETE SURFACE COURSE, AS PER PLAN

DO NOT USE COARSE AGGREGATE FROM A SOURCE DESIGNATED 'SR' OR 'SRH' ACCORDING TO THE OFFICE OF MATERIALS MANAGEMENT (OMM) IN ANY JOB MIX FORMULA (JMF) FOR THIS ITEM.

ITEM 442 - ANTI-SEGREGATION EQUIPMENT

PROVIDE ANTI-SEGREGATION EQUIPMENT FOR ALL COURSES OF UNIFORM THICKNESS IN ACCORDANCE WITH CMS 401.12. THE FOLLOWING ESTIMATED QUANTITY HAS BEEN CARRIED TO THE GENERAL SUMMARY:

ITEM 442 - ANTI-SEGREGATION EQUIPMENT 3,186 CY

ITEM 442 - ASPHALT CONCRETE INTERMEDIATE COURSE, AS PER PLAN

ON THIS PROJECT SUPPLY A 19MM INTERMEDIATE COURSE MEETING THE REQUIREMENTS OF 442 EXCEPT AS MODIFIED BELOW. MODIFY TABLE 442.02-2 AS FOLLOWS:

Sieve Size	Total Percent Passing		
	9.5 mm mix	12.5 mm mix	19 mm mix
1 1/2 inch (38 mm)	-	-	100
3/4 inch (19 mm)	-	100	95 to 100
1/2 inch (12.5 mm)	100	95 to 100	90 to 100
3/8 inch (9.5 mm)	90 to 100	96 max	96 max
No. 4 (4.75 mm)	70 max	52 to 65	60 max
No. 8 (2.36 mm)	34 to 52	34 to 45	34 to 45
No. 200 (75 µm)	2 to 8	2 to 8	2 to 8

MODIFY TABLE 442.02-3 AS FOLLOWS:

- APPLY 14.0 FOR A VMA (PERCENT MINIMUM) FOR A 19MM MIX.
- APPLY 5.3 PERCENT FOR THE MINIMUM TOTAL ASPHALT BINDER CONTENT FOR A 19MM MIX.

MODIFY THE 442 INTERMEDIATE COURSE REQUIREMENTS OF TABLES 401.04-1 AND 401.04-2 AS FOLLOWS:

- APPLY 3.5 PERCENT FOR THE TOTAL VIRGIN ASPHALT BINDER CONTENT, MINIMUM.
- USE A PG 64-22 IF USING 25 PERCENT OR LESS RAP. USE PG 64-28 IF USING GREATER THAN 25 PERCENT RAP.

DRAINAGE NOTES

ITEM SPECIAL - FILL AND PLUG EXISTING CONDUIT

THIS ITEM SHALL CONSIST OF THE CONSTRUCTION OF BULKHEADS IN EXISTING CONDUIT(S) AND FILLING THE AREA THUS SEALED OFF WITH ITEM 613, SAND OR OTHER MATERIAL APPROVED BY THE ENGINEER.

BULKHEADS SHALL BE LOCATED AT THE LIMITS OF THE AREA TO BE FILLED AS INDICATED ON THE PLANS. THE BULKHEADS SHALL CONSIST OF BRICK OR CONCRETE MASONRY WITH A MINIMUM THICKNESS OF 12 INCHES.

THE FILL MATERIAL SHALL BE PUMPED INTO PLACE, OR PLACED BY OTHER MEANS APPROVED BY THE ENGINEER, SO THAT, AFTER SETTLEMENT, AT LEAST 90 PERCENT OF THE CROSS-SECTIONAL AREA OF THE CONDUIT, FOR ITS ENTIRE LENGTH, SHALL BE FILLED. THE LENGTH OF FILLED AND PLUGGED CONDUIT TO BE PAID FOR SHALL BE THE ACTUAL NUMBER OF FEET (MEASURED ALONG THE CENTERLINE OF EACH CONDUIT FROM OUTER FACE TO OUTER FACE OF BULKHEADS) FILLED AND PLUGGED AS DESCRIBED ABOVE.

IN LIEU OF FILLING AND PLUGGING THE EXISTING CONDUIT, THE PIPE MAY BE CRUSHED AND BACKFILLED IN ACCORDANCE WITH THE PROVISIONS OF 203, OR IT MAY BE REMOVED. THE LENGTH, MEASURED AS PROVIDED ABOVE, SHALL BE PAID FOR AT THE CONTRACT PRICE PER FOOT FOR, ITEM SPECIAL, FILL AND PLUG EXISTING CONDUIT.

CROSSINGS AND CONNECTIONS TO EXISTING PIPES AND UTILITIES

WHERE PLANS PROVIDE FOR A PROPOSED CONDUIT TO BE CONNECTED TO, OR CROSS OVER OR UNDER AN EXISTING SEWER OR UNDERGROUND UTILITY, THE CONTRACTOR SHALL LOCATE THE EXISTING PIPES OR UTILITIES BOTH AS TO LINE AND GRADE BEFORE STARTING TO LAY THE PROPOSED CONDUIT.

IF IT IS DETERMINED THAT THE ELEVATION OF THE EXISTING CONDUIT, OR EXISTING APPURTENANCE TO BE CONNECTED, DIFFERS FROM THE PLAN ELEVATION OR RESULTS IN A CHANGE IN THE PLAN CONDUIT SLOPE, THE ENGINEER SHALL BE NOTIFIED BEFORE STARTING CONSTRUCTION OF ANY PORTION OF THE PROPOSED CONDUIT WHICH WILL BE AFFECTED BY THE VARIANCE IN THE EXISTING ELEVATIONS.

IF IT IS DETERMINED THAT THE PROPOSED CONDUIT WILL INTERSECT AN EXISTING SEWER OR UNDERGROUND UTILITY IF CONSTRUCTED AS SHOWN ON THE PLAN, THE ENGINEER SHALL BE NOTIFIED BEFORE STARTING CONSTRUCTION OF ANY PORTION OF THE PROPOSED CONDUIT WHICH WOULD BE AFFECTED BY THE INTERFERENCE WITH AN EXISTING FACILITY.

PAYMENT FOR ALL THE OPERATIONS DESCRIBED ABOVE SHALL BE INCLUDED IN THE CONTRACT PRICE FOR THE PERTINENT 611 CONDUIT ITEM.

REVIEW OF DRAINAGE FACILITIES

BEFORE ANY WORK IS STARTED ON THE PROJECT AND AGAIN BEFORE FINAL ACCEPTANCE BY THE STATE, REPRESENTATIVES OF THE STATE AND THE CONTRACTOR, ALONG WITH LOCAL REPRESENTATIVES, SHALL MAKE AN INSPECTION OF ALL EXISTING SEWERS WHICH ARE TO REMAIN IN SERVICE AND WHICH MAY BE AFFECTED BY THE WORK. THE CONDITION OF THE EXISTING CONDUITS AND THEIR APPURTENANCE SHALL BE DETERMINED FROM FIELD OBSERVATIONS. RECORDS OF THE INSPECTION SHALL BE KEPT IN WRITING ALONG WITH PHOTOS BY THE STATE.

ALL NEW CONDUITS, INLETS, CATCH BASINS, AND MANHOLES CONSTRUCTED AS A PART OF THE PROJECT SHALL BE FREE OF ALL FOREIGN MATTER AND IN A CLEAN CONDITION BEFORE THE PROJECT WILL BE ACCEPTED BY THE STATE.

ALL EXISTING SEWERS INSPECTED INITIALLY BY THE ABOVE MENTIONED PARTIES SHALL BE MAINTAINED AND LEFT IN A CONDITION REASONABLY COMPARABLE TO THAT DETERMINED BY THE ORIGINAL INSPECTION. ANY CHANGE IN THE CONDITION RESULTING FROM THE CONTRACTOR'S OPERATIONS SHALL BE CORRECTED BY THE CONTRACTOR TO THE SATISFACTION OF THE ENGINEER.

PAYMENT FOR ALL OPERATIONS DESCRIBED ABOVE SHALL BE INCLUDED IN THE CONTRACT PRICE FOR THE PERTINENT 611 CONDUIT ITEMS.

p:\BN-pw-bentley.com\bn-pw-01\Documents\pr-55239\Sum\01402\Design\roadway\BN\sheet\01402GNI00.dgn Sheet 12/16/2020 4:43:56 PM soroka

CALCULATED
TK
CHECKED
MRT

GENERAL NOTES

SUM-76/77/8
10.99/11.54/0.00

pw:\BN-pw.bentley.com\bn-pw-0\Documents\pr-55239\Sum\10402\Design\Roadway\BN\sheet\10402G000.dgn Sheet 12/16/2020 3:54:05 PM sor-oka

SHEET NUM.											PART.		ITEM	ITEM EXT	GRAND TOTAL	UNIT	DESCRIPTION	SEE SHEET NO.
42	44	51	56	61	72	207	530	536	951	OFFICE CALC	09/IMS/PV	10/NHS/PV						
																	ROADWAY	
LS											LS		201	11000	LS		CLEARING AND GRUBBING	
										95,119	95,119		202	23000	95,119	SY	PAVEMENT REMOVED	
										5,546	5,546		202	23010	5,546	SY	PAVEMENT REMOVED, ASPHALT	
		8,294									8,294		202	30000	8,294	SF	WALK REMOVED	
		7,427									7,427		202	30700	7,427	FT	CONCRETE BARRIER REMOVED	
		10,409									10,409		202	32000	10,409	FT	CURB REMOVED	
			2,843				49				2,892		202	35100	2,892	FT	PIPE REMOVED, 24" AND UNDER	
			619								619		202	35200	619	FT	PIPE REMOVED, OVER 24"	
		16,675									15,895	780	202	38000	16,675	FT	GUARDRAIL REMOVED	
		92									92		202	38300	92	FT	GUARDRAIL REMOVED, BARRIER DESIGN	
			5								5		202	58000	5	EACH	MANHOLE REMOVED	
			41								41		202	58100	41	EACH	CATCH BASIN REMOVED	
			7								7		202	58200	7	EACH	INLET REMOVED	
			1,789								1,789		SPECIAL	20270000	1,789	FT	FILL AND PLUG EXISTING CONDUIT	43
									13,314		13,314		202	75000	13,314	FT	FENCE REMOVED	
									1		1		202	75250	1	EACH	GATE REMOVED	
	12										12		202	98100	12	EACH	REMOVAL MISC.:INSPECTION WELL	42
	700										700		202	98200	700	FT	REMOVAL MISC.:CONDUIT	42
						41,377					41,377		203	10000	41,377	CY	EXCAVATION	41
						112,840					112,840		203	20001	112,840	CY	EMBANKMENT, AS PER PLAN	41
											60		203	20001	60	CY	EMBANKMENT, AS PER PLAN, FOR DRAINAGE	44
	60										15,049		204	10000	15,049	SY	SUBGRADE COMPACTION	
					9,860						9,860		204	13000	9,860	CY	EXCAVATION OF SUBGRADE, BEDROCK	
					10,335						10,335		204	20000	10,335	CY	EMBANKMENT	
55											55		204	45000	55	HOUR	PROOF ROLLING	
										2,877	2,877		206	10500	2,877	TON	CEMENT	
										95,518	95,518		206	11000	95,518	SY	CURING COAT	
										95,518	95,518		206	15020	95,518	SY	CEMENT STABILIZED SUBGRADE, 14 INCHES DEEP	
LS				15,674							LS		206	30000	LS		MIXTURE DESIGN FOR CHEMICALLY STABILIZED SOILS	
											14,449	1,225	606	15050	15,674	FT	GUARDRAIL, TYPE MGS	
				2							2		606	20050	2	EACH	ROUNDED END SECTION	
				17							16	1	606	26150	17	EACH	ANCHOR ASSEMBLY, MGS TYPE E	
				13							12	1	606	26550	13	EACH	ANCHOR ASSEMBLY, MGS TYPE T	
				16							15	1	606	35002	16	EACH	MGS BRIDGE TERMINAL ASSEMBLY, TYPE 1	
				17							16	1	606	35102	17	EACH	MGS BRIDGE TERMINAL ASSEMBLY, TYPE 2	
				3							3		606	60022	3	EACH	IMPACT ATTENUATOR, TYPE 2 (UNIDIRECTIONAL)	
									9,828		9,828		607	23001	9,828	FT	FENCE, TYPE CLT, AS PER PLAN	42
									4		4		607	61201	4	EACH	GATE, TYPE CLT, AS PER PLAN	42
					2,739						2,739		608	13000	2,739	SF	6" CONCRETE WALK	
					893						893		608	52000	893	SF	CURB RAMP	
								2,183			2,183		622	10100	2,183	FT	CONCRETE BARRIER, SINGLE SLOPE, TYPE BI	
								69			69		622	10120	69	FT	CONCRETE BARRIER, SINGLE SLOPE, TYPE C	
								1,248			1,248		622	10121	1,248	FT	CONCRETE BARRIER, SINGLE SLOPE, TYPE C, AS PER PLAN	18
								1,112			1,112		622	10140	1,112	FT	CONCRETE BARRIER, SINGLE SLOPE, TYPE CI	
								5,763			5,763		622	10160	5,763	FT	CONCRETE BARRIER, SINGLE SLOPE, TYPE D	
								1			1		622	24840	1	EACH	CONCRETE BARRIER END SECTION, TYPE B	
								1			1		622	24841	1	EACH	CONCRETE BARRIER END SECTION, TYPE B, AS PER PLAN	18
								13			13		622	25000	13	EACH	CONCRETE BARRIER END SECTION, TYPE D	
								56			56		622	25006	56	EACH	CONCRETE BARRIER, END ANCHORAGE, REINFORCED, TYPE BI	
								1			1		622	25008	1	EACH	CONCRETE BARRIER, END ANCHORAGE, REINFORCED, TYPE C	
								8			8		622	25009	8	EACH	CONCRETE BARRIER, END ANCHORAGE, REINFORCED, TYPE C, AS PER PLAN	18
								37			37		622	25014	37	EACH	CONCRETE BARRIER, END ANCHORAGE, REINFORCED, TYPE CI	
								65			65		622	25050	65	EACH	CONCRETE BARRIER, END ANCHORAGE, REINFORCED, TYPE D	
				6							6		SPECIAL	69050600	6	EACH	BOLLARD (PER RM-5.1)	
5											5		690	98000	5	EACH	SPECIAL -VERTICAL CLEARANCE	42
											1,000		690	98100	1,000	FT	SPECIAL -PIPE CLEANOUT, 24" AND UNDER	44
											500		690	98100	500	FT	SPECIAL -PIPE CLEANOUT, 27" TO 48"	44
											500		690	98100	500	FT	SPECIAL -PIPE CLEANOUT, OVER 48"	44
											1,500		690	99400	1,500	LB	SPECIAL -MISCELLANEOUS METAL	44

QUANTITIES FOR EXCAVATION AND EMBANKMENT ARE BASED ON PAVEMENT BUILD-UP PRIOR TO ADDENDUM 4 THAT CHANGED THE ASPHALT CONCRETE BASE DEPTH.

GENERAL SUMMARY

SUM -76 / 77 / 8
 10.99 / 11.54 / 0.00

pw:\BN-pw.bentley.com\bn-pw-0\Documents\pr-55239\Sum\010402\Design\roadway\BN\sheet\010402G000.dgn Sheet 12/16/2020 4:52:30 PM soroka

SHEET NUM.										PART.		ITEM	ITEM EXT	GRAND TOTAL	UNIT	DESCRIPTION	SEE SHEET NO.
43	44	45	61	65	426	530	641	OFFICE CALC		09/IMS/PV	10/NHS/PV						
				4						4		611	99575	4	EACH	MANHOLE, NO. 3, AS PER PLAN	44
				2						2		611	99654	2	EACH	MANHOLE ADJUSTED TO GRADE	
				2						2		611	99655	2	EACH	MANHOLE ADJUSTED TO GRADE, AS PER PLAN	44
				10						10		611	99660	10	EACH	MANHOLE RECONSTRUCTED TO GRADE	
				3						3		611	99661	3	EACH	MANHOLE RECONSTRUCTED TO GRADE, AS PER PLAN	45
	10	10			7					17		611	99710	17	EACH	PRECAST REINFORCED CONCRETE OUTLET	
										10		611	99720	10	EACH	INSPECTION WELL	
				24						24		638	06712	24	FT	30" STEEL PIPE ENCASEMENT, OPEN CUT	
				27						27		899	10000	27	FT	CURED-IN-PLACE PIPE LINER, 48" DIAMETER	45
																PAVEMENT	
250										250		251	01020	250	SY	PARTIAL DEPTH PAVEMENT REPAIR (442)	
250										250		253	01000	250	SY	PAVEMENT REPAIR	
								39,636		8,832	30,804	254	01000	39,636	SY	PAVEMENT PLANING, ASPHALT CONCRETE, 1.5"	
405								17		422		302	46000	422	CY	ASPHALT CONCRETE BASE, PG64-22	
								554		554		304	20001	554	CY	AGGREGATE BASE, AS PER PLAN	43
110								27,752		26,014	1,848	407	20000	27,862	GAL	NON-TRACKING TACK COAT	
140										140		442	10100	140	CY	ASPHALT CONCRETE INTERMEDIATE COURSE, 19 MM, TYPE A (446)	
								1,651		367	1,284	442	10301	1,651	CY	ASPHALT CONCRETE SURFACE COURSE, 12.5 MM, TYPE A (447), AS PER PLAN	43
								269		269		442	10351	269	CY	ASPHALT CONCRETE SURFACE COURSE, 12.5 MM, TYPE B (447), AS PER PLAN	43
								6		6		442	20250	6	CY	ASPHALT CONCRETE INTERMEDIATE COURSE, 19 MM, TYPE B (448)	
								1,741		1,741		452	13010	1,741	SY	9" NON-REINFORCED CONCRETE PAVEMENT, CLASS QC 1P	
			5,328							5,328		609	24511	5,328	FT	CURB, TYPE 4-C, AS PER PLAN	42
			1,817							1,817		609	26001	1,817	FT	CURB, TYPE 6, AS PER PLAN	42
										QUANTITY IS BASED ON PAVEMENT BUILD-UP PRIOR TO ADDENDUM 4 THAT CHANGED THE ASPHALT CONCRETE BASE DEPTH.							
																PAVEMENT DESIGN - OPTION A (FLEXIBLE)	
								29,350		29,350		302	46000	29,350	CY	ASPHALT CONCRETE BASE, PG64-22	
								18,526		18,526		304	20001	18,526	CY	AGGREGATE BASE, AS PER PLAN	43
								25,204		25,204		407	20000	25,204	GAL	NON-TRACKING TACK COAT	
3,281										3,281		442	00100	3,281	CY	ANTI-SEGREGATION EQUIPMENT	
								4,336		4,336		442	10301	4,336	CY	ASPHALT CONCRETE SURFACE COURSE, 12.5 MM, TYPE A (447), AS PER PLAN	43
								5,218		5,218		442	10101	5,218	CY	ASPHALT CONCRETE INTERMEDIATE COURSE, 19 MM, TYPE A (446), AS PER PLAN	43
																PAVEMENT DESIGN - OPTION B (RIGID)	
												304	20001		CY	AGGREGATE BASE, AS PER PLAN	43
												452	16020		SY	13" NON-REINFORCED CONCRETE PAVEMENT, CLASS QC 1P WITH QC 1A	
																WATER WORK	
								35		35		638	01205	35	FT	8" WATER MAIN DUCTILE IRON PIPE ANSI CLASS 53, PUSH-ON JOINTS AND FITTINGS, AS PER PLAN	531
								1		1		638	10481	1	EACH	FIRE HYDRANT REMOVED, AS PER PLAN	532
								9		9		638	10801	9	EACH	VALVE BOX ADJUSTED TO GRADE, AS PER PLAN	531
																LIGHTING	
																SEE SHEET 645 FOR LIGHTING GENERAL SUMMARY	
																TRAFFIC SURVEILLANCE OPTION A	
								995		995		625	23000	995	FT	NO. 4 AWG 600 VOLT DISTRIBUTION CABLE	
								1,228		1,228		625	25410	1,228	FT	CONDUIT, 2", 725.052	
								12		12		625	25504	12	FT	CONDUIT, 3", 725.051	
								1,234		1,234		625	29001	1,234	FT	TRENCH, AS PER PLAN	640
								10		10		625	30700	10	EACH	PULL BOX, 725.08, 18"	
								2		2		625	31510	2	EACH	PULL BOX REMOVED	
								2		2		625	31600	2	EACH	PULL BOX, MISC.: ADJUSTED TO GRADE	640
								1		1		625	32000	1	EACH	GROUND ROD	
								1,020		1,020		632	62810	1,020	FT	INTERCONNECT CABLE, MISC.: CABLE RELOCATED	640
								1		1		633	67100	1	EACH	CABINET FOUNDATION	
								1		1		633	67200	1	EACH	CONTROLLER WORK PAD	
								1		1		809	65000	1	EACH	ITS CABINET - GROUND MOUNTED	
								1		1		809	65990	1	EACH	ITS DEVICE, MISC.: REMOVAL OF SMART JACK	640
								1		1		809	65990	1	EACH	ITS DEVICE, MISC.:RELOCATION OF CCTV CONTROL PANEL	640
																TRAFFIC SURVEILLANCE OPTION B (ATC)	
										LS		SPECIAL	80999000	LS		ITS	

GENERAL SUMMARY

SUM-76 / 77 / 8
10.99 / 11.54 / 0.00