

GUE-70-0735 Guernsey

I-70

Co. Rd. 335 Subway

GRADE SEPARATION

COUNTY

ROUTE NO

R.R. &amp; METHOD OF ELIM

H10 H12 H15 H20

15 18 19 22 23 +

12 12-14 14 + OPEN

A B C D T

STRENGTH

ROADWAY

CLEARANCE

TYPE

SHOW BY SKETCH - NO. OF TRACKS R.R. AND HIGHWAY ALIGNMENT; SUBWAY CLEARANCES, HORIZONTAL AND VERTICAL.

SHOW OCCUPANCY BY TRACTION LINE; SIZE, LENGTH AND ARRANGEMENT OF DRAINAGE SYSTEM, SUBMERGENCE BY HIGH WATER.

IF AN OVERHEAD NOT MAINTAINED BY STATE SHOW TYPE; MATERIAL; ROADWAY; VERTICAL CLEARANCE ABOVE TRACKS, GENERAL DATA FOR DETERMINING STRENGTH.

IS HIGHWAY GRADE UNSATISFACTORY?

WHY?



IS HIGHWAY ALIGNMENT UNSATISFACTORY?

WHY?

IF SEPARATION BY HIGHWAY RELOCATION, SHOW BY SKETCH.

RT. ON G.R. 335 Lkq. It on CR 335  
5-24-67

Rear Lkq. Hhd. 5-24-67

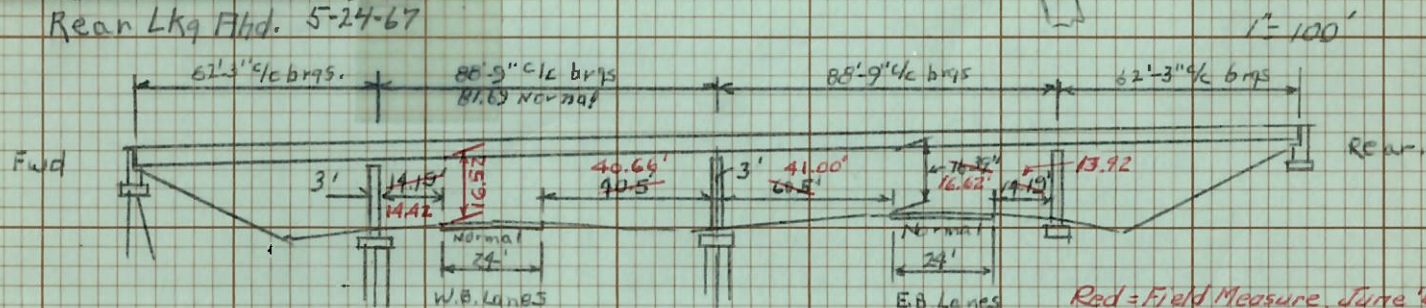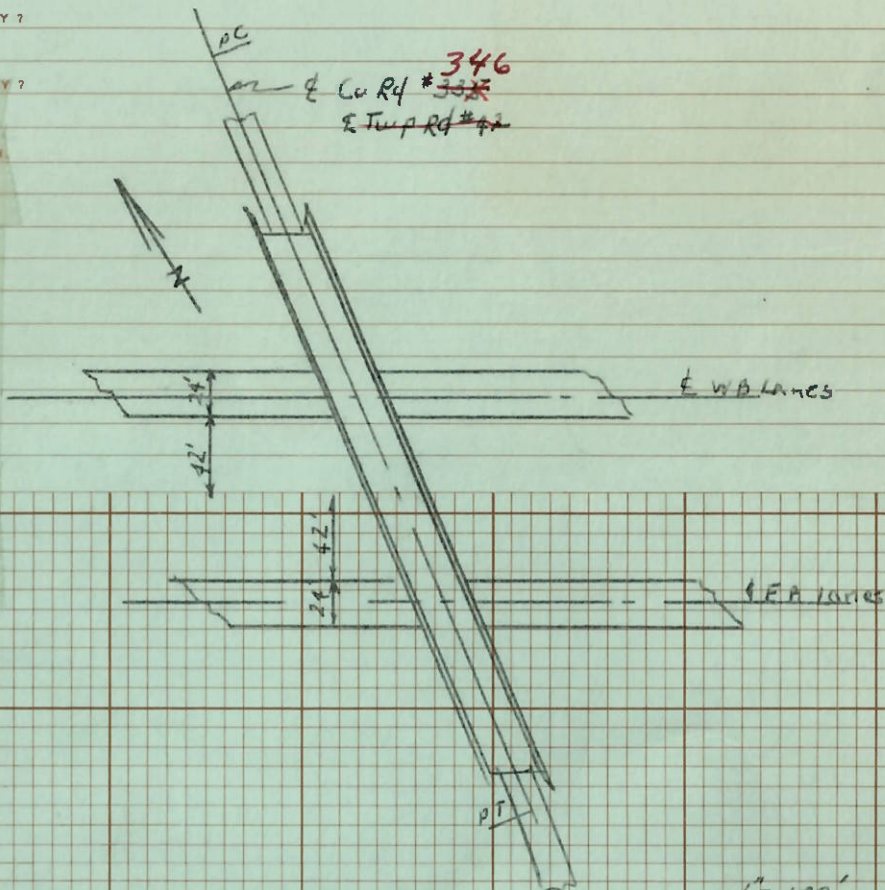

1" = 50'

GHD-BR  
48048