



**OHIO & ERIE CANAL
TOWPATH TRAIL
OHIO DEPARTMENT OF
DEVELOPMENT**

30% DESIGN


| DATE: | | |
|-----------|------|-------------|
| REVISIONS | | |
| ▲ | DATE | DESCRIPTION |
| # | # | # |
| # | # | # |
| # | # | # |
| # | # | # |
| # | # | # |
| # | # | # |
| # | # | # |
| # | # | # |

PROJECT NO.: 22-00734-010

DRAWN BY: CMW

CHECKED BY: HRD

DATE ISSUED: 2024-03-29

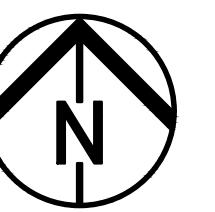

SCHEMATIC PLAN

0 300 600
GRAPHIC SCALE IN FEET

OHIO & ERIE CANAL
TOWPATH TRAIL
OHIO DEPARTMENT OF
DEVELOPMENT

30% DESIGN


| DATE: | | |
|-----------|------|-------------|
| REVISIONS | | |
| ▲ | DATE | DESCRIPTION |
| # | # | # |
| # | # | # |
| # | # | # |
| # | # | # |
| # | # | # |
| # | # | # |
| # | # | # |
| # | # | # |

PROJECT NO.: 22-00734-010

DRAWN BY: CMW

CHECKED BY: HRD

DATE ISSUED: 2024-03-29

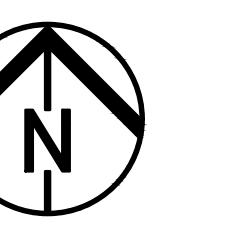


SCHEMATIC PLAN

0 100 200
GRAPHIC SCALE IN FEET




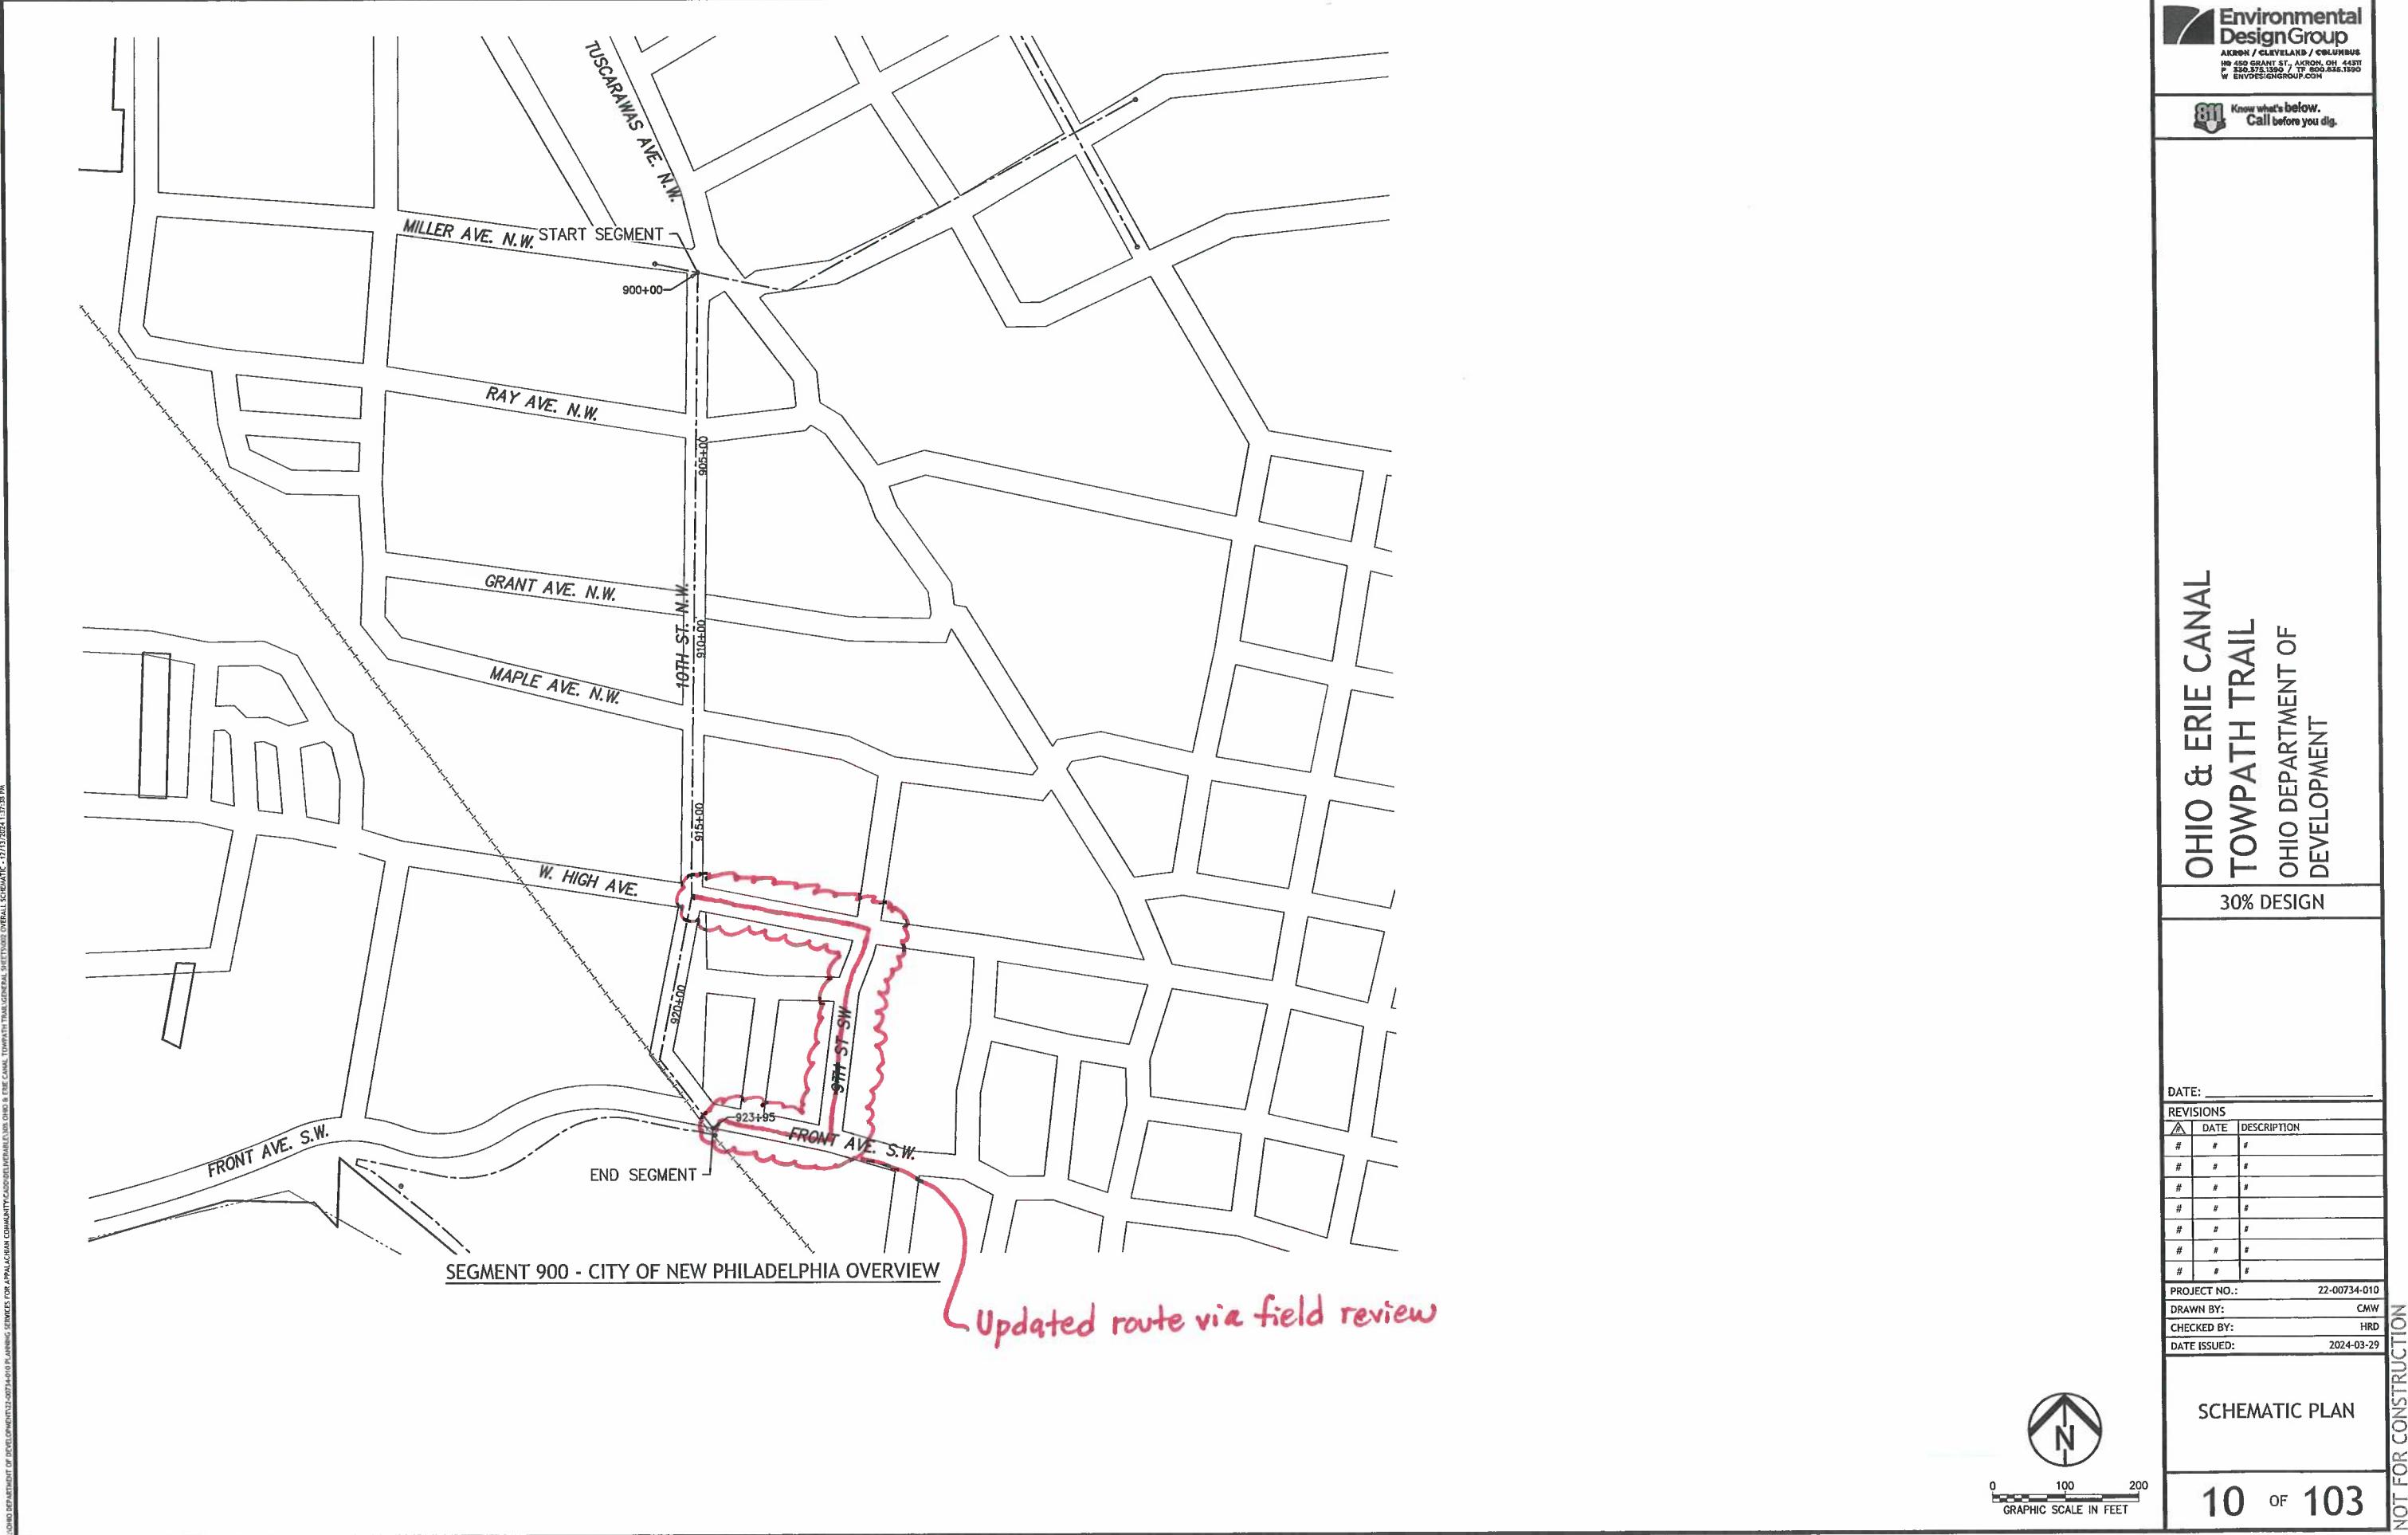

**OHIO & ERIE CANAL
 TOWPATH TRAIL
 OHIO DEPARTMENT OF
 DEVELOPMENT**

30% DESIGN

DATE:

REVISIONS


| ▲ | DATE | DESCRIPTION |
|---|------|-------------|
| # | # | # |
| # | # | # |
| # | # | # |
| # | # | # |
| # | # | # |
| # | # | # |
| # | # | # |
| # | # | # |

PROJECT NO.: 22-00734-010

DRAWN BY: CMW

CHECKED BY: HRD

DATE ISSUED: 2024-03-29

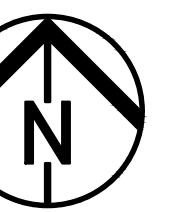

SCHEMATIC PLAN

11 OF 103

