

SEEDING  
END Sq.  
Width Yds.

ESTIMATED QUANTITIES

- I-1 15" Class J-1 Pipe Sec M6.6(b) or M6.8(b) 110 L.F.
- I-2 Masonry 0.26 C.Y.
- I-8 Std. No 2-2 B.C.B. 1 Ea.
- I-10 Dumped Rock 3 Cu. Yd.
- L-10 Sodding 3 S.Y.


Std. No. 4 C.B.  
Top of Grate E.I. = 945.32  
E.I. 15" Class J-1 = 941.30

Begin Special Sod Ditch  
Sta. 597+05 Rt.  
Width of Sod = 8.0 ft.

CUYAHOGA COUNTY  
MED-42-26.17  
CUY-42-0.00

90  
302

END AREA		Cu. Yds.	
CUT	FILL	CUT	FILL
		507	6654
		115	1682
			5466395
		177	1737
			3486087
		10	1553
			1266109
		57	1739

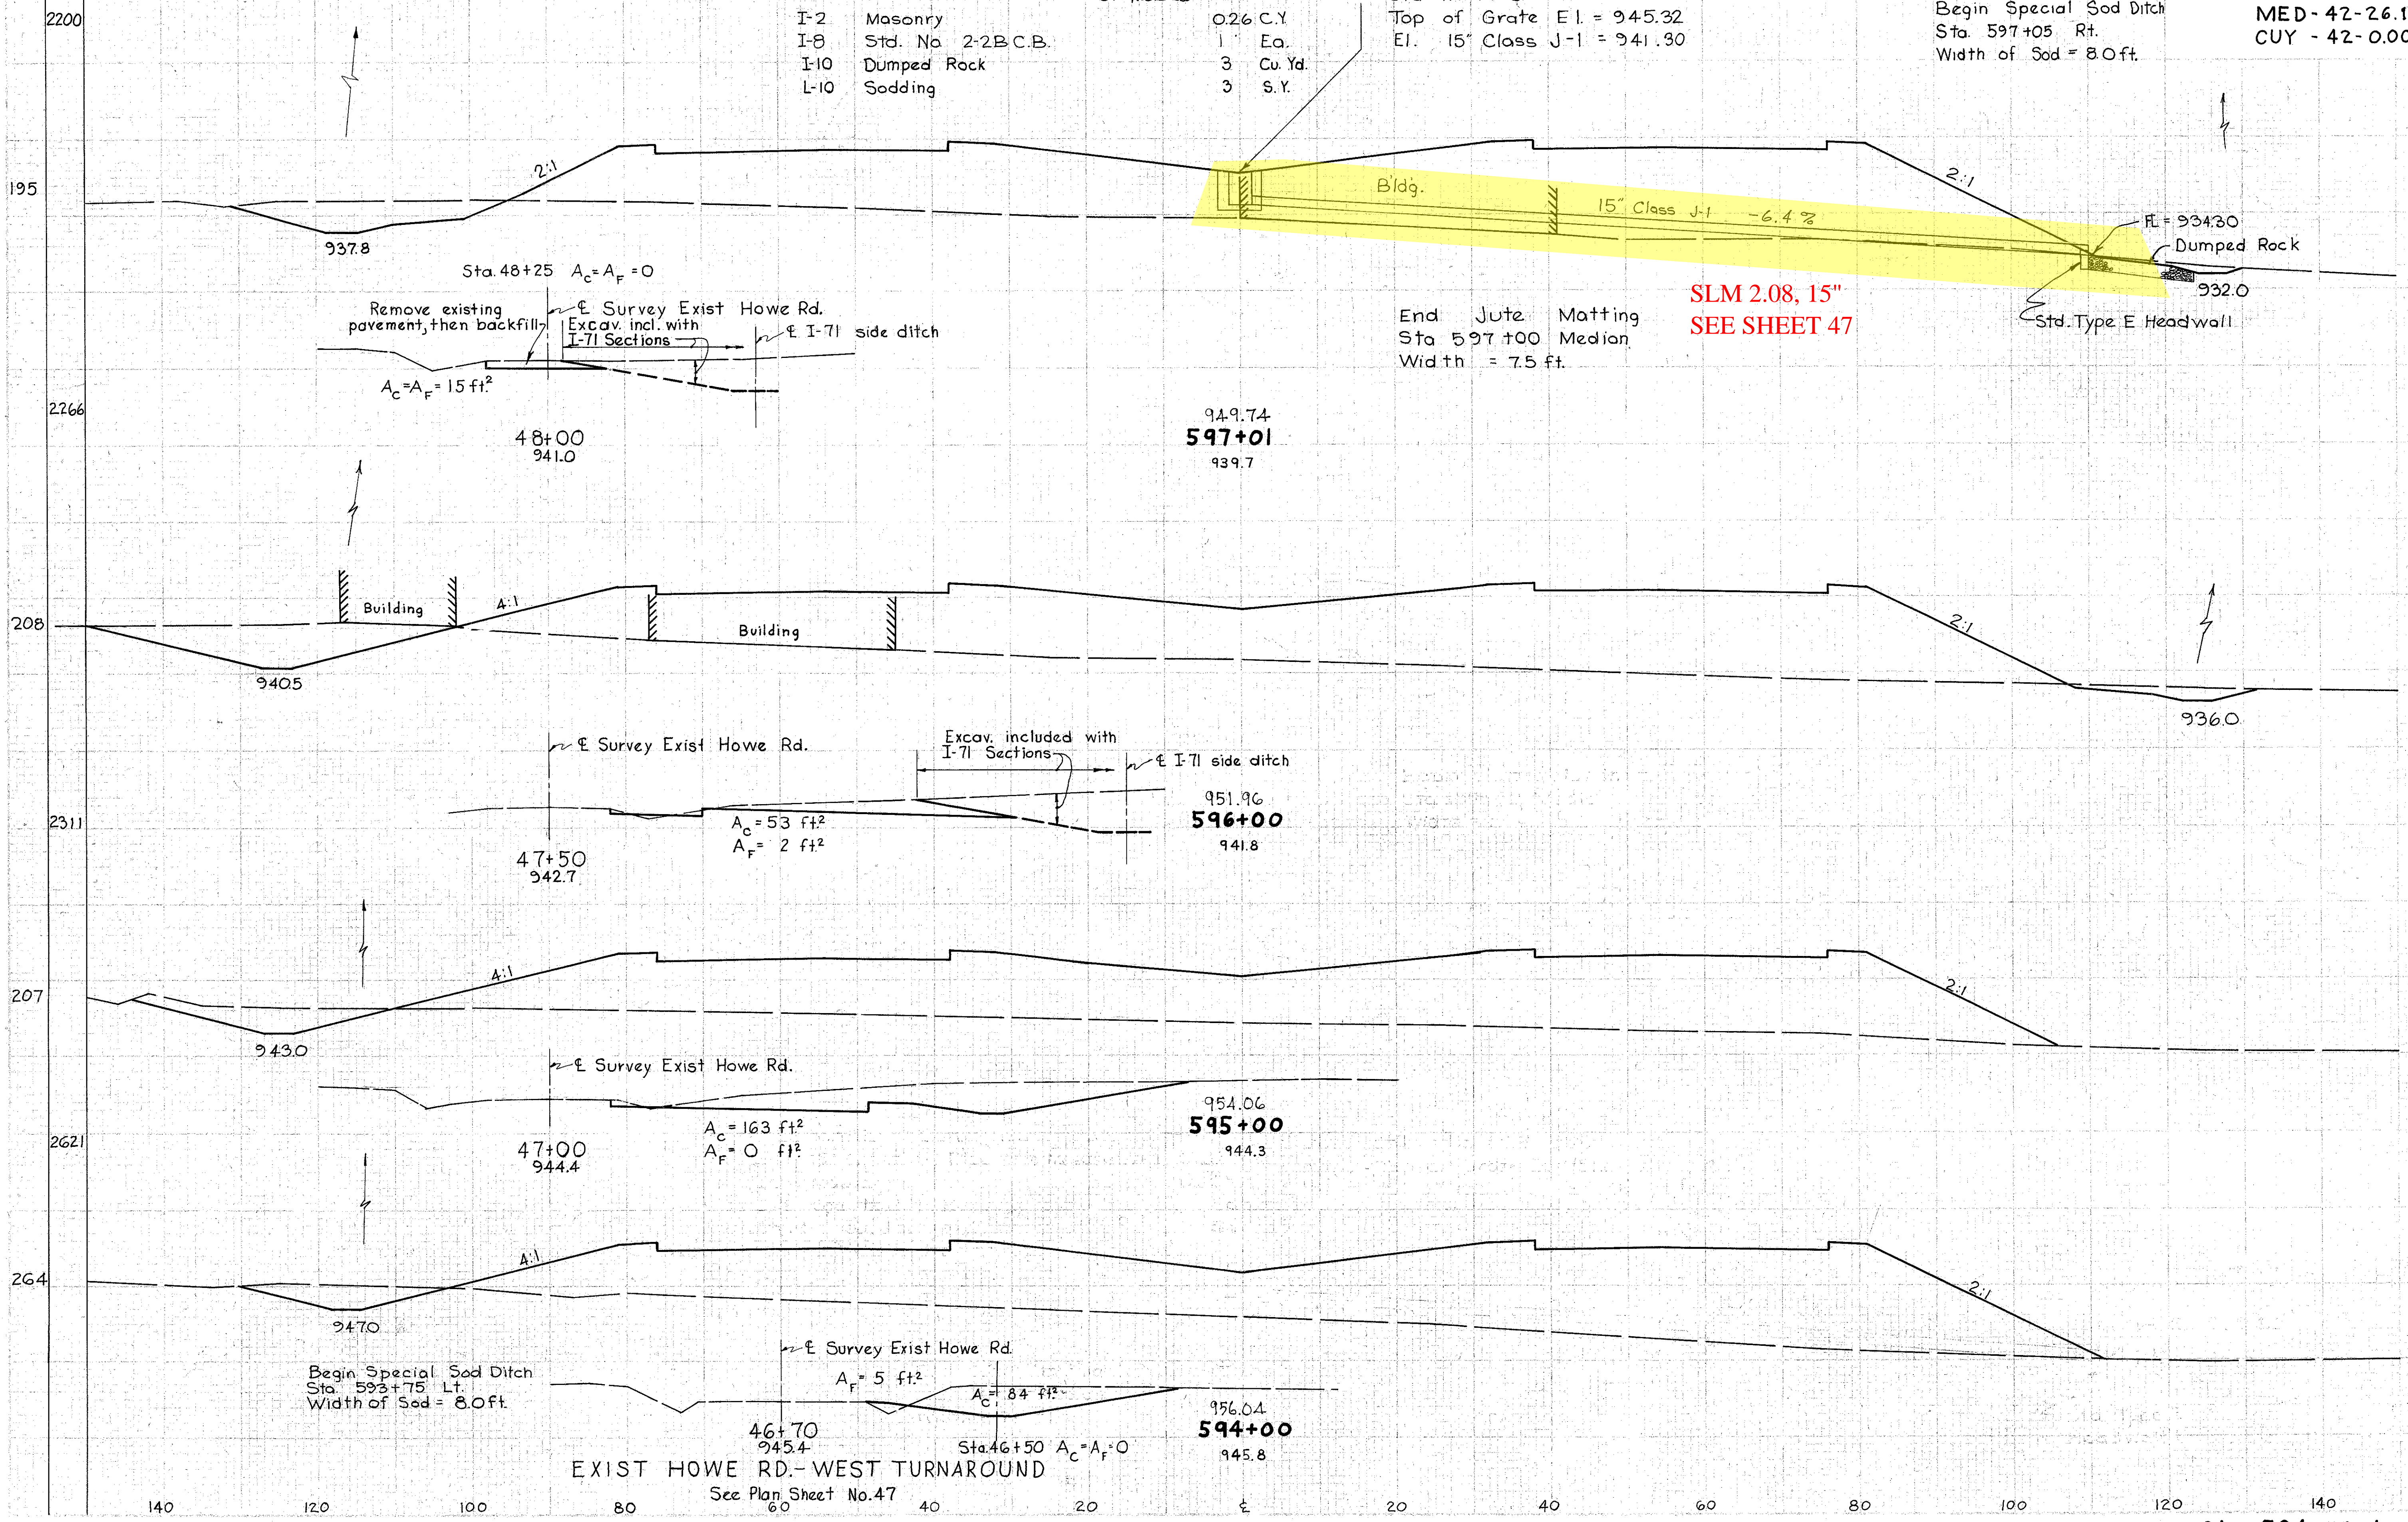

EXIST HOWE RD.-WEST TURNAROUND  
See Plan Sheet No. 47

Sta. 594+00 to 597+01