


FED. NO. DIVISION	STATE	PROJECT	
2	OHIO	I-71-5(15)233	

296
302

MEDINA & CUYAHOGA COUNTIES
 MED-42-26.63
 CUY-42- 0.00
 LIMITED ACCESS
 SCALE: 1" = 50'
 SOLD AS MED/CUY-42-26.17/0.00

23
29

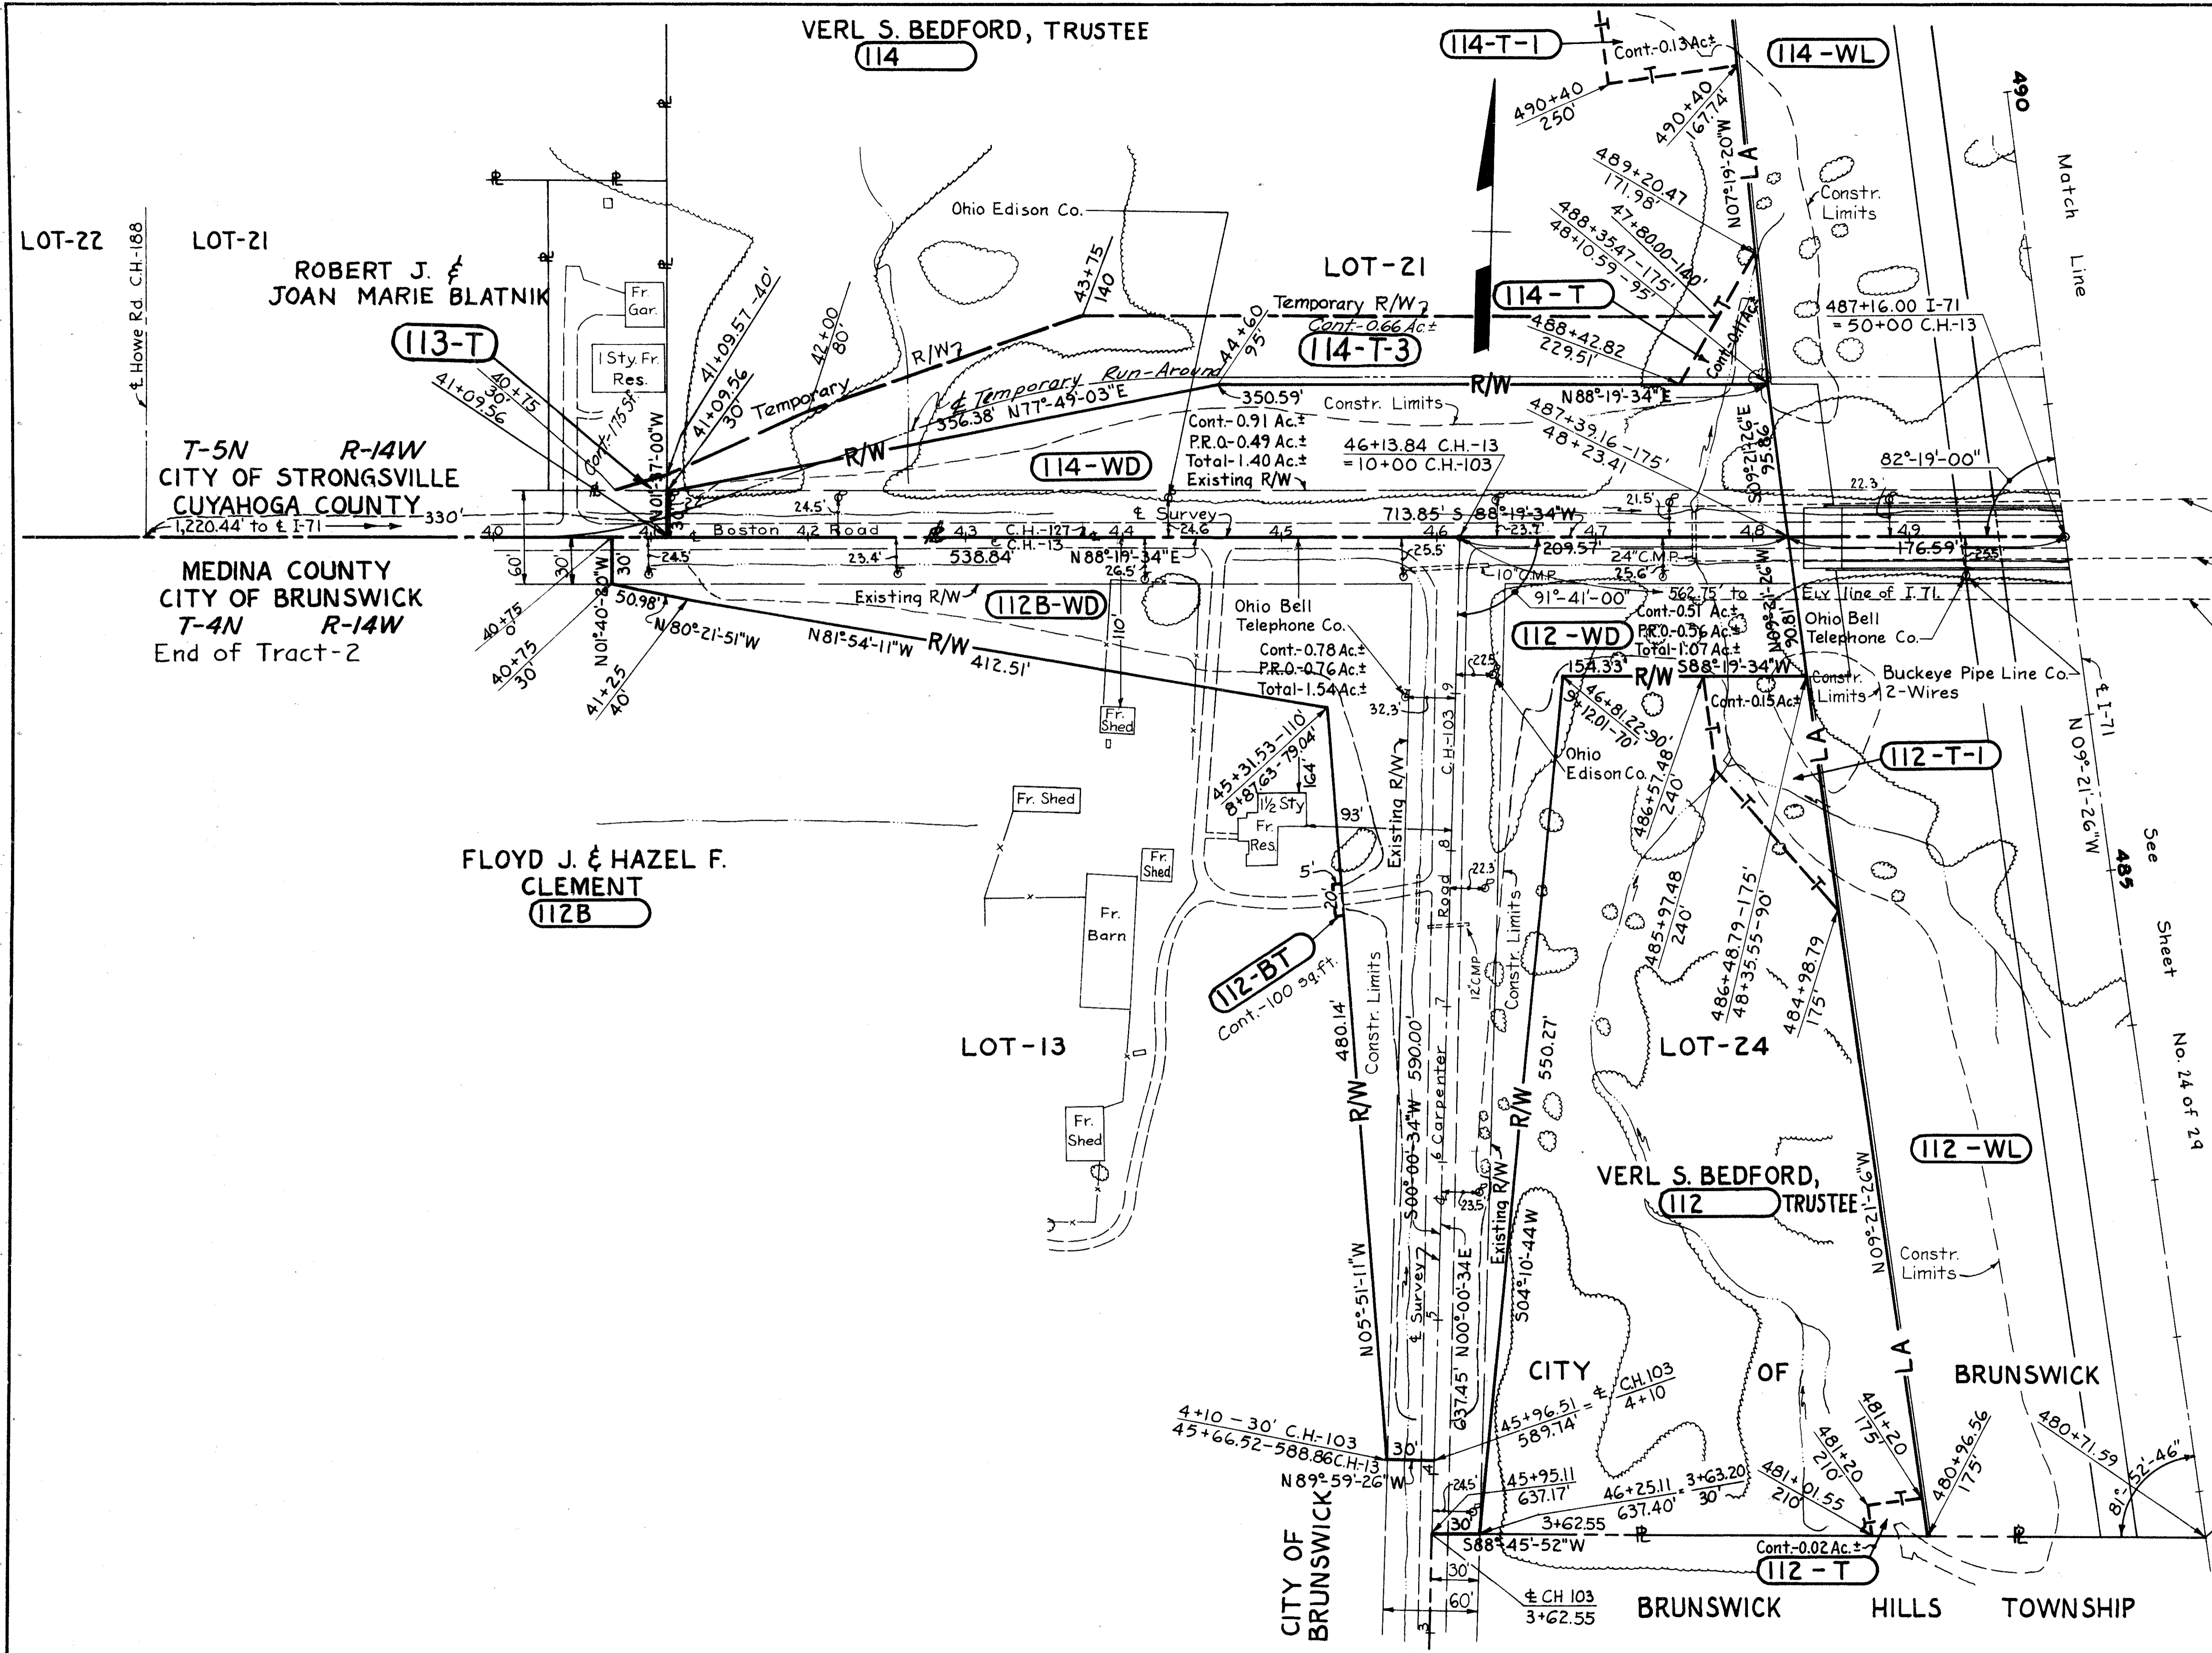

Begin Acquisition
Sta. 480+71.59

REVISIONS
 Completed - 9-13-63
 9-26-63 Changed Temp.
 R/W for Par. 113T & Par. 114T