


END AREA		VOLUME	
CUT	FILL	CUT	FILL
129	25	457	154
118	58	400	224
98	63	356	237
94	65	352	243
96	66	356	235
96	61		
<b>SHEET TOTAL</b>		1921	1093

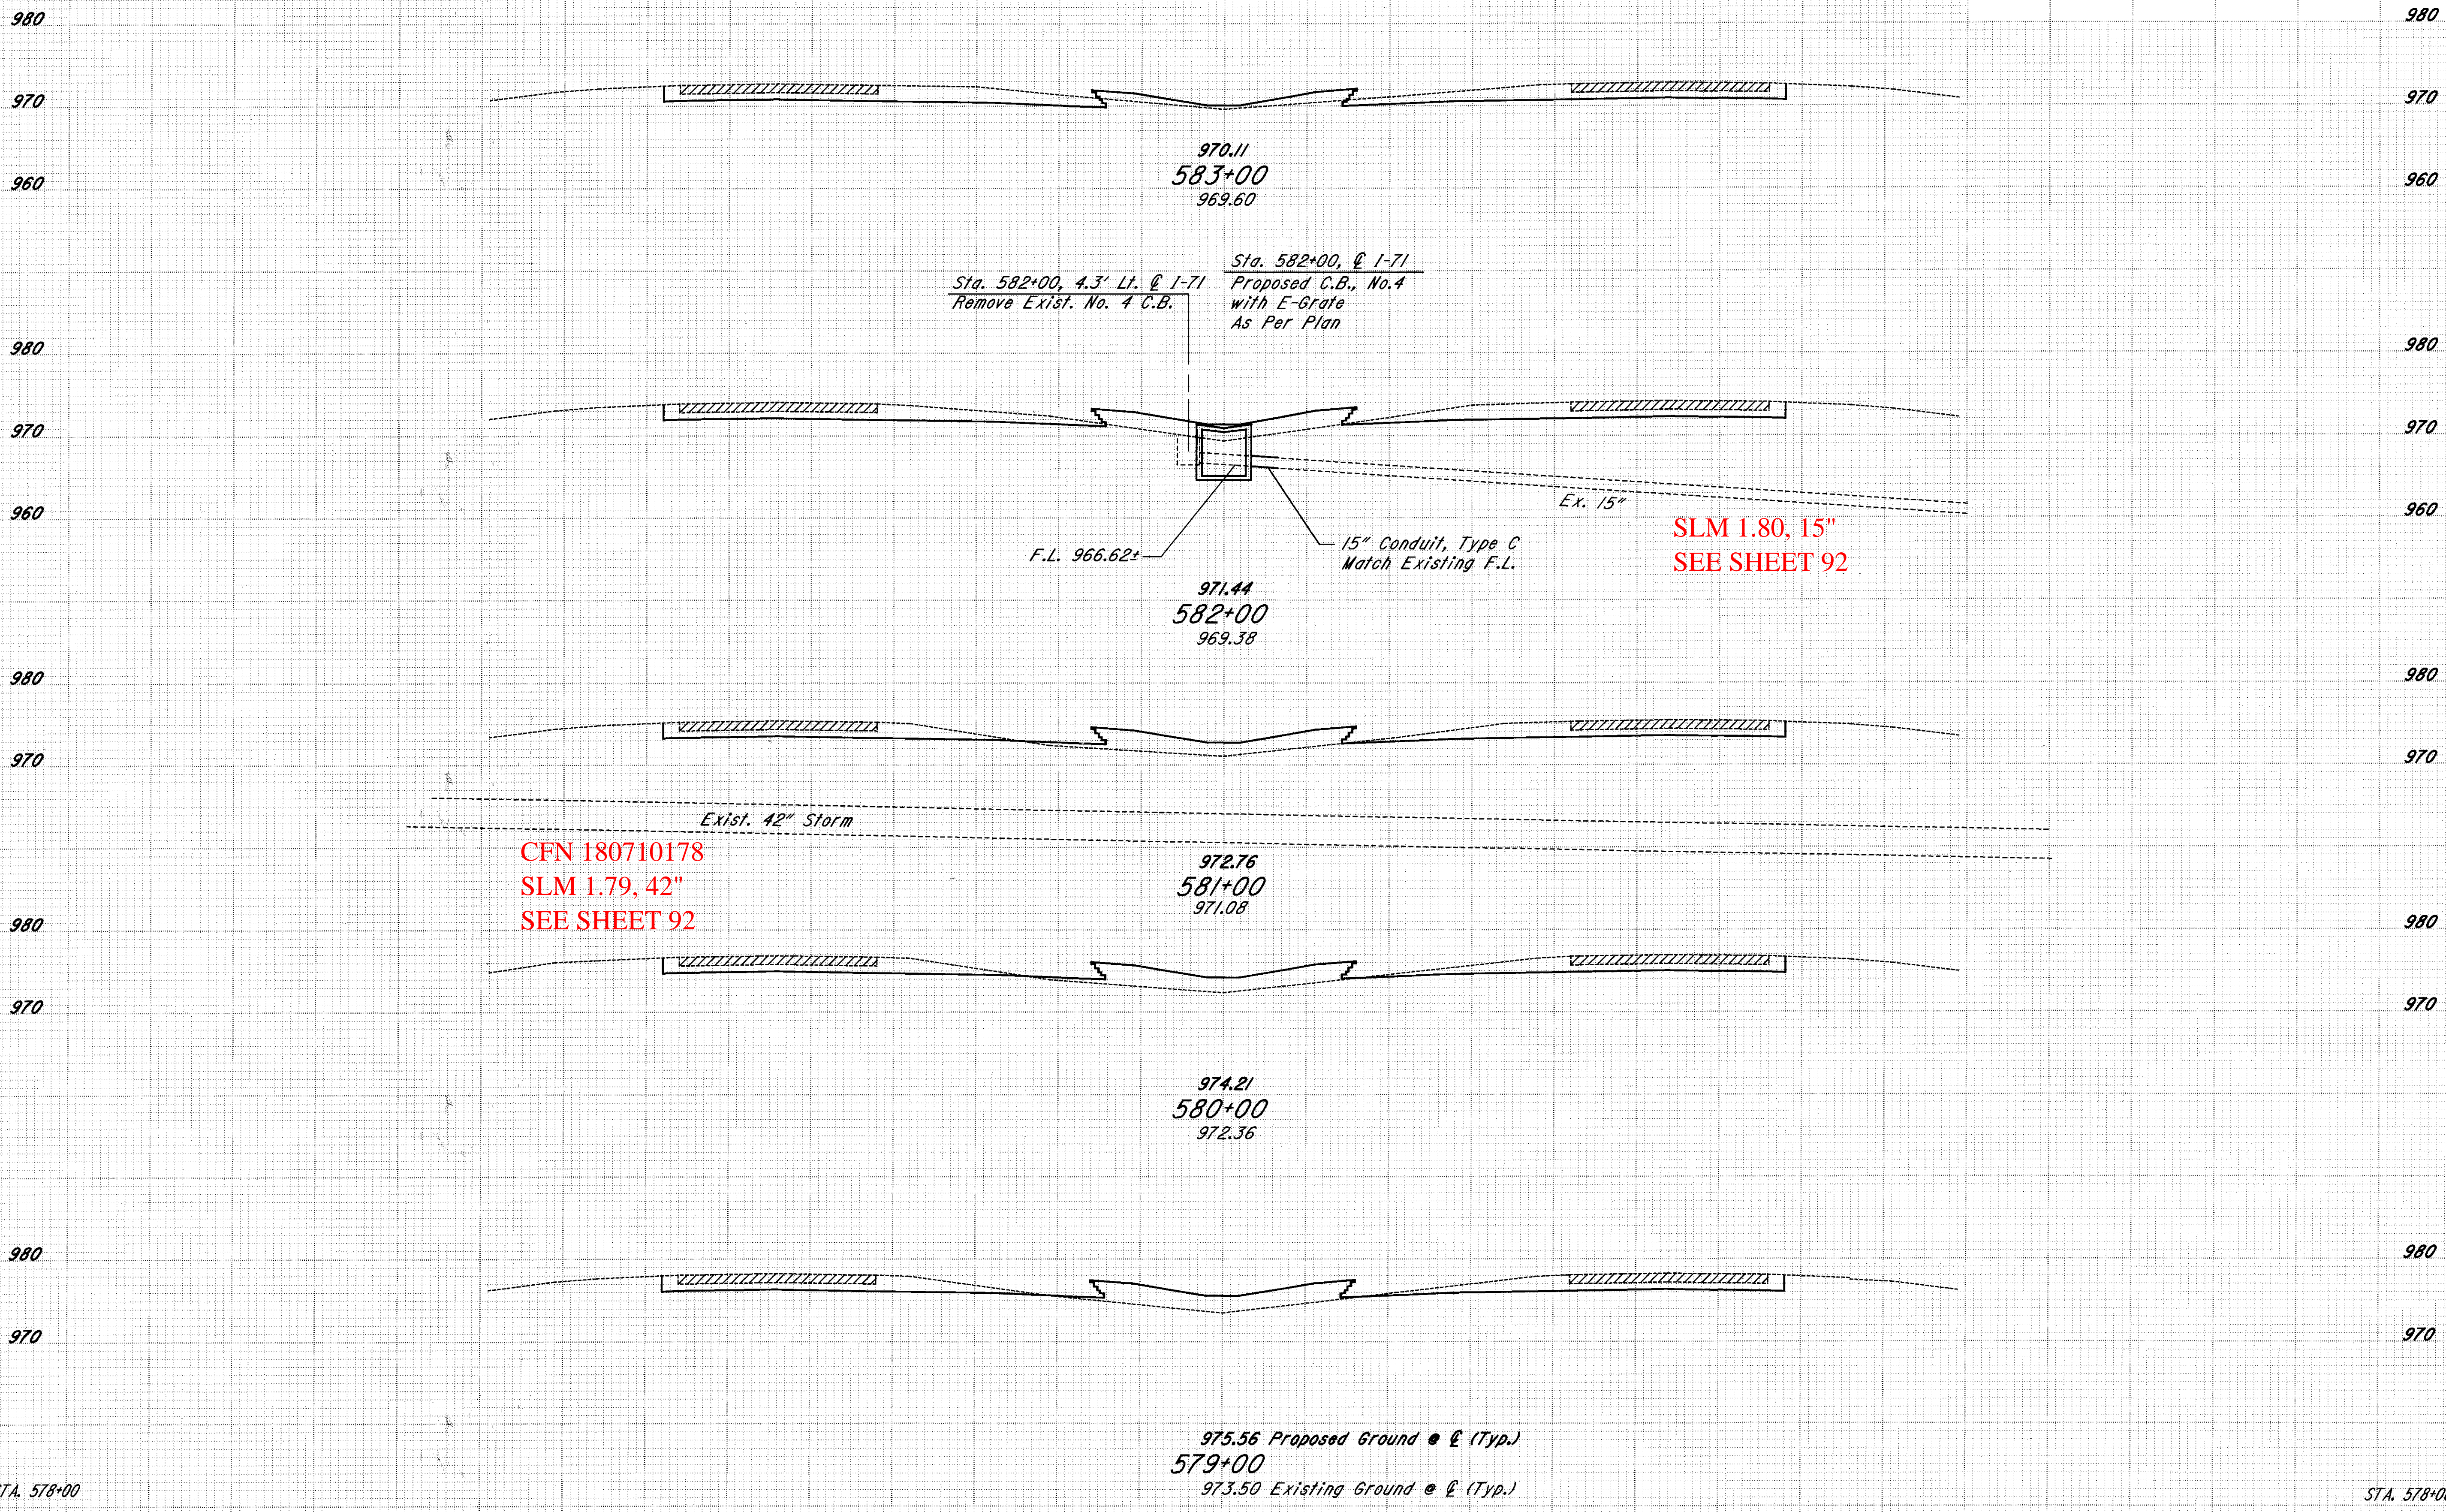

PLOTTED FROM: i:\users\eforsber\pic\08459\dgn\307xs20.dgn

PLOT SUBMITTED: 24-JUL-1998 15:11

307XS20.DGN