




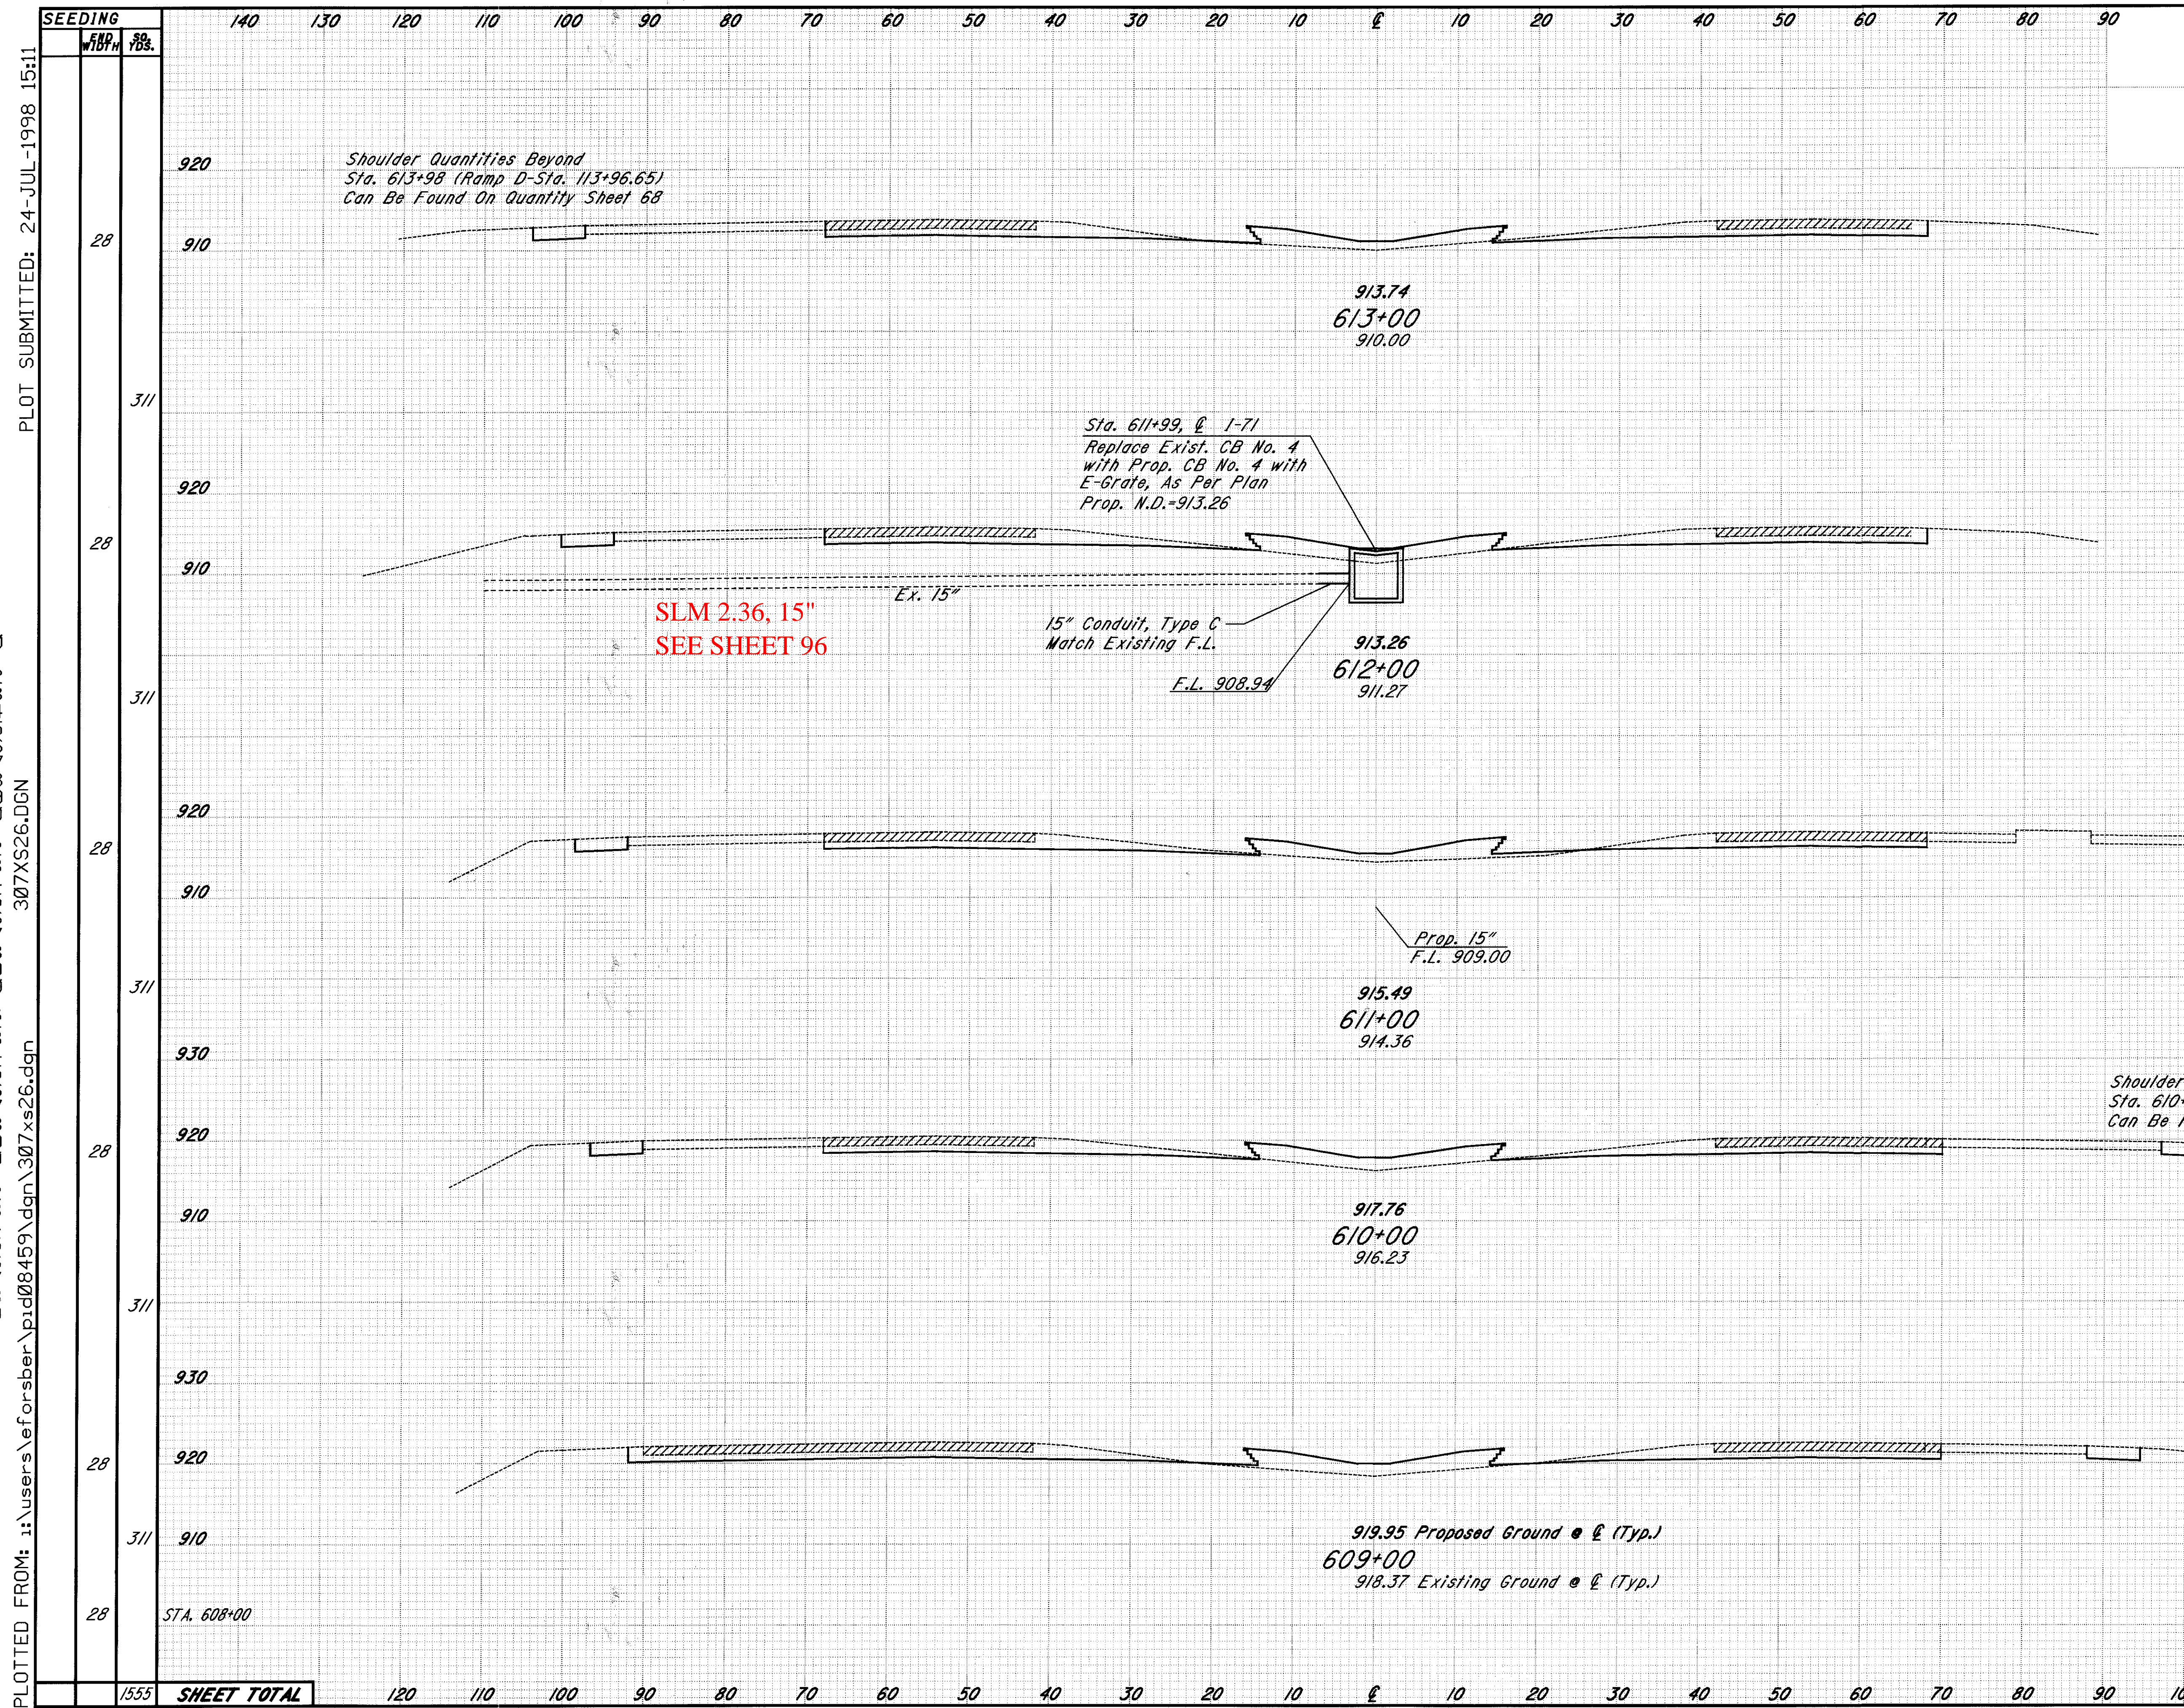

CROSS SECTIONS STA. 609+00 TO STA. 613+00