


PLOTTED FROM: I:\users\eforsber\p\d08459\dgn\307xs48.dgn  
 PLOT SUBMITTED: 24-JUL-1998 15:11  
 307XS48.DGN

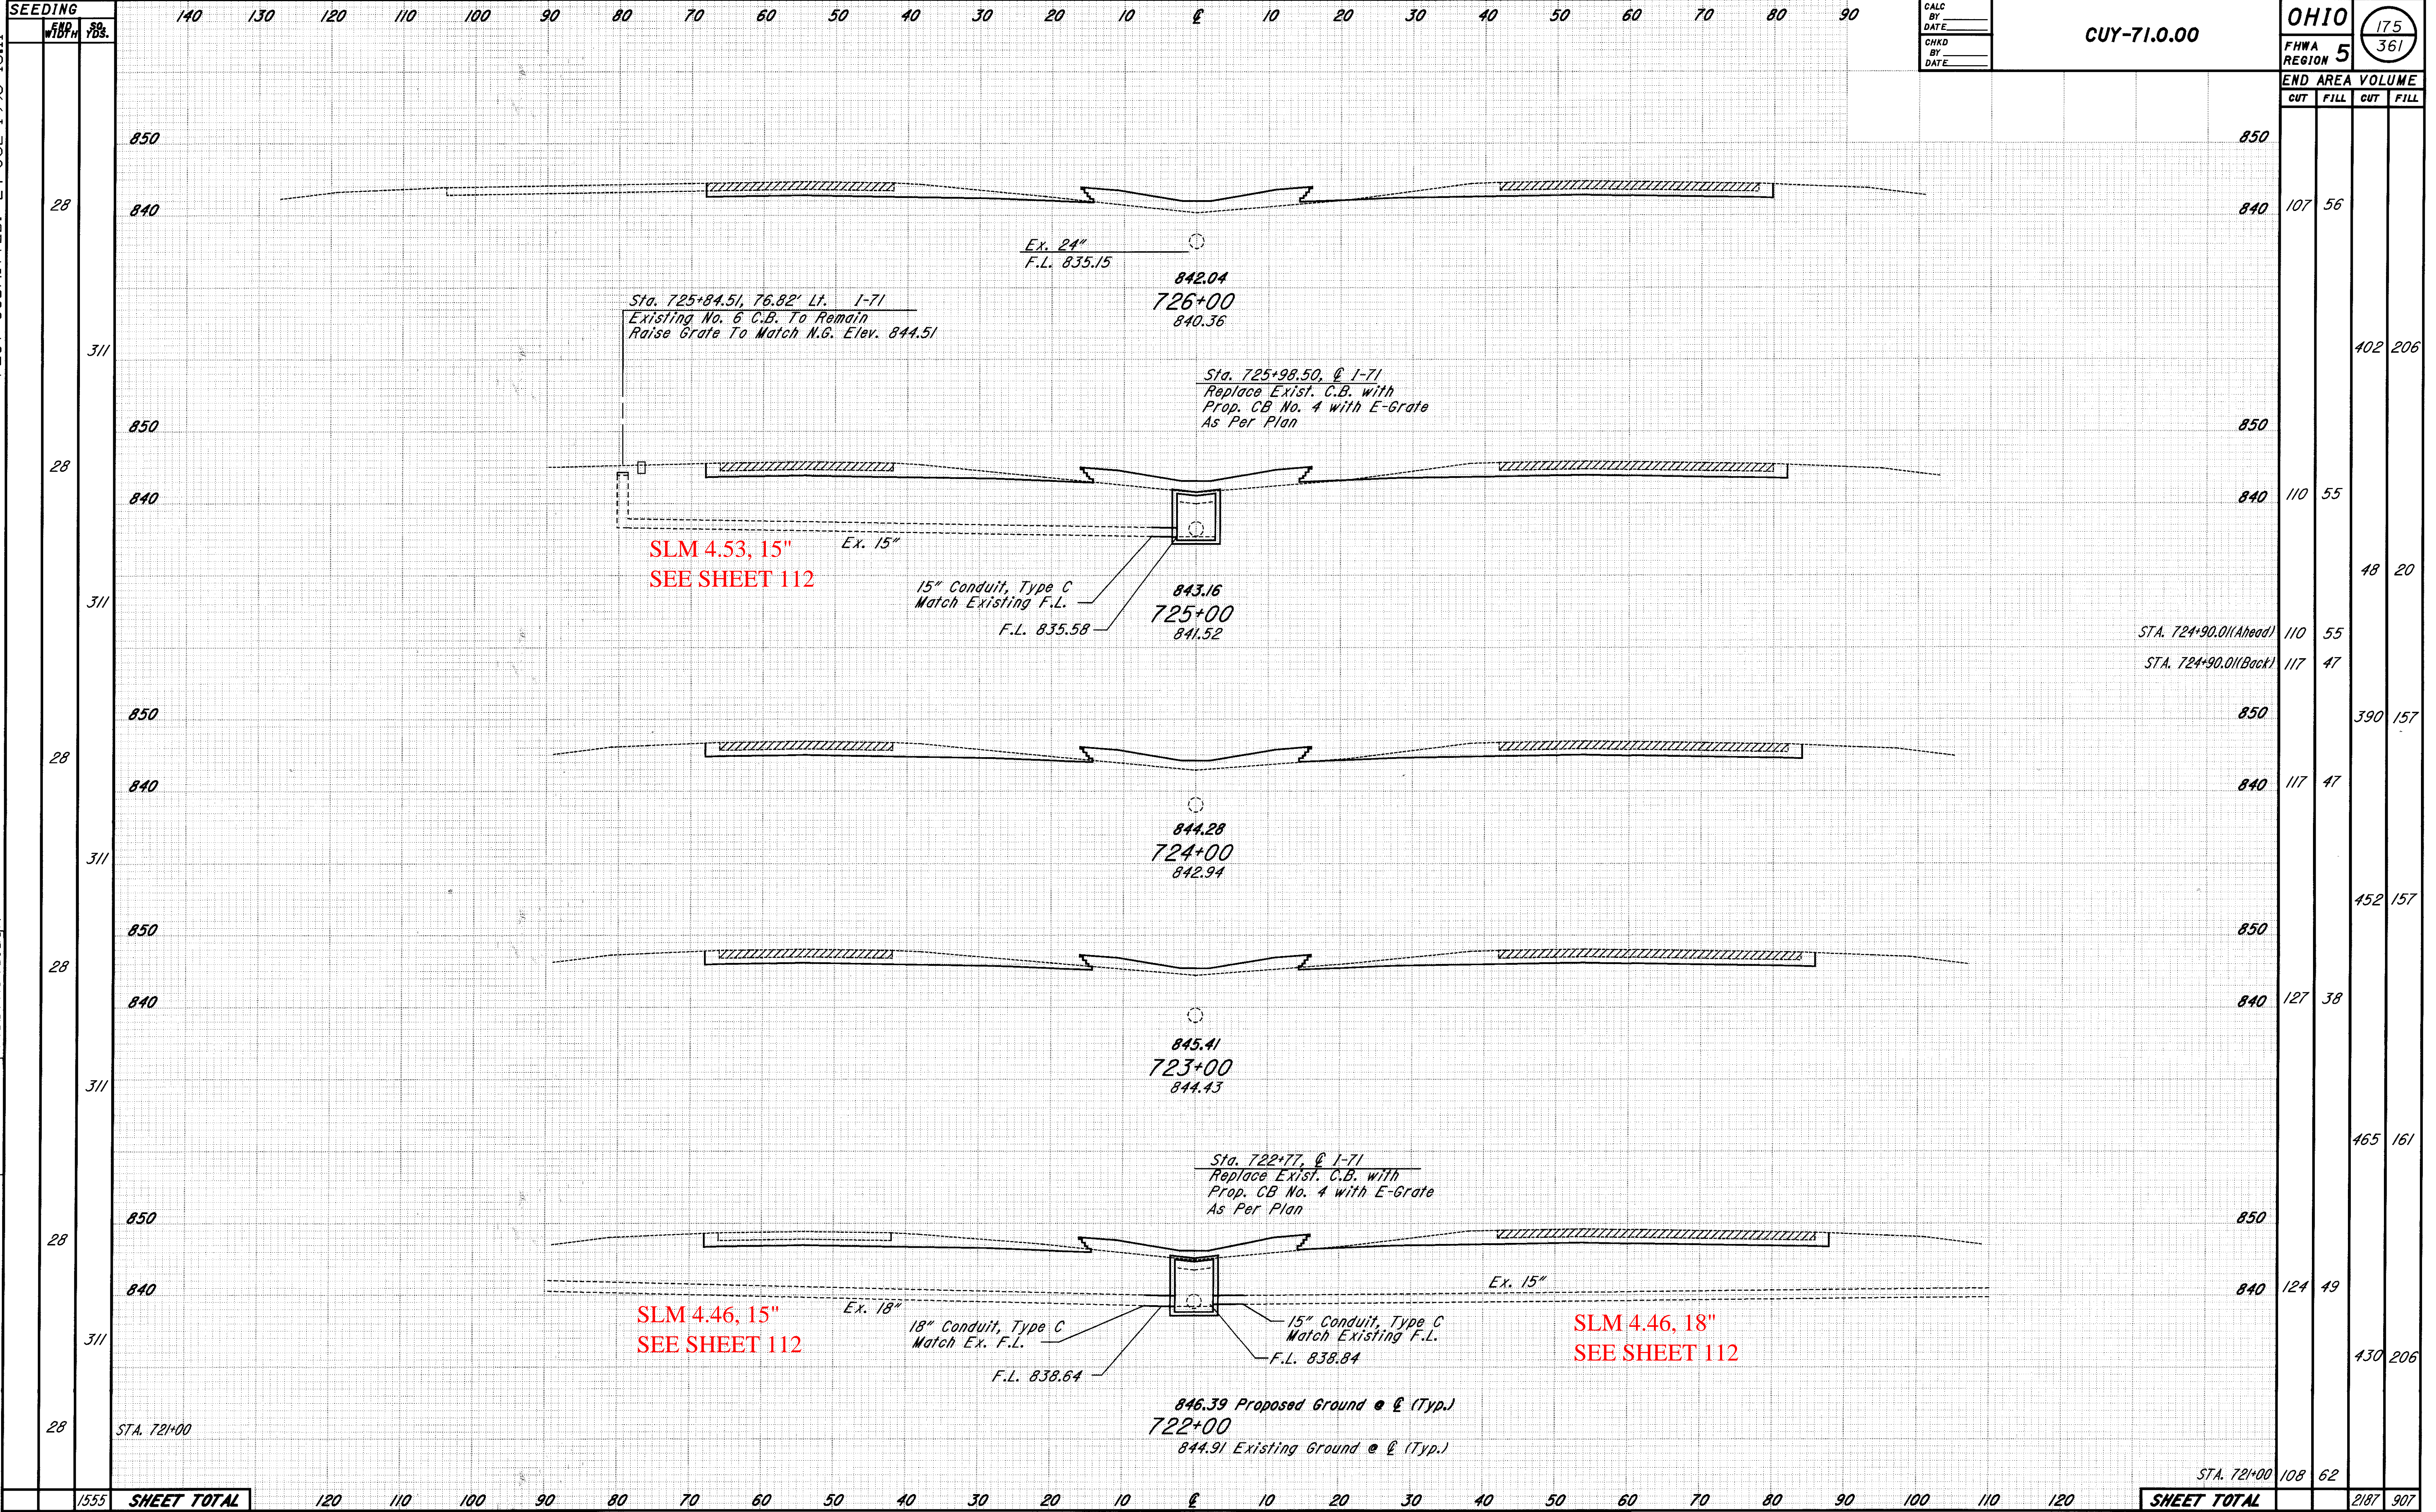

CROSS SECTIONS STA. 722+00 TO STA. 726+00