CALC BY ____ DATE ____	CUY-71-0.00	OHIO	182 / 361
CHKD BY ____ DATE ____		FHWA REGION 5	

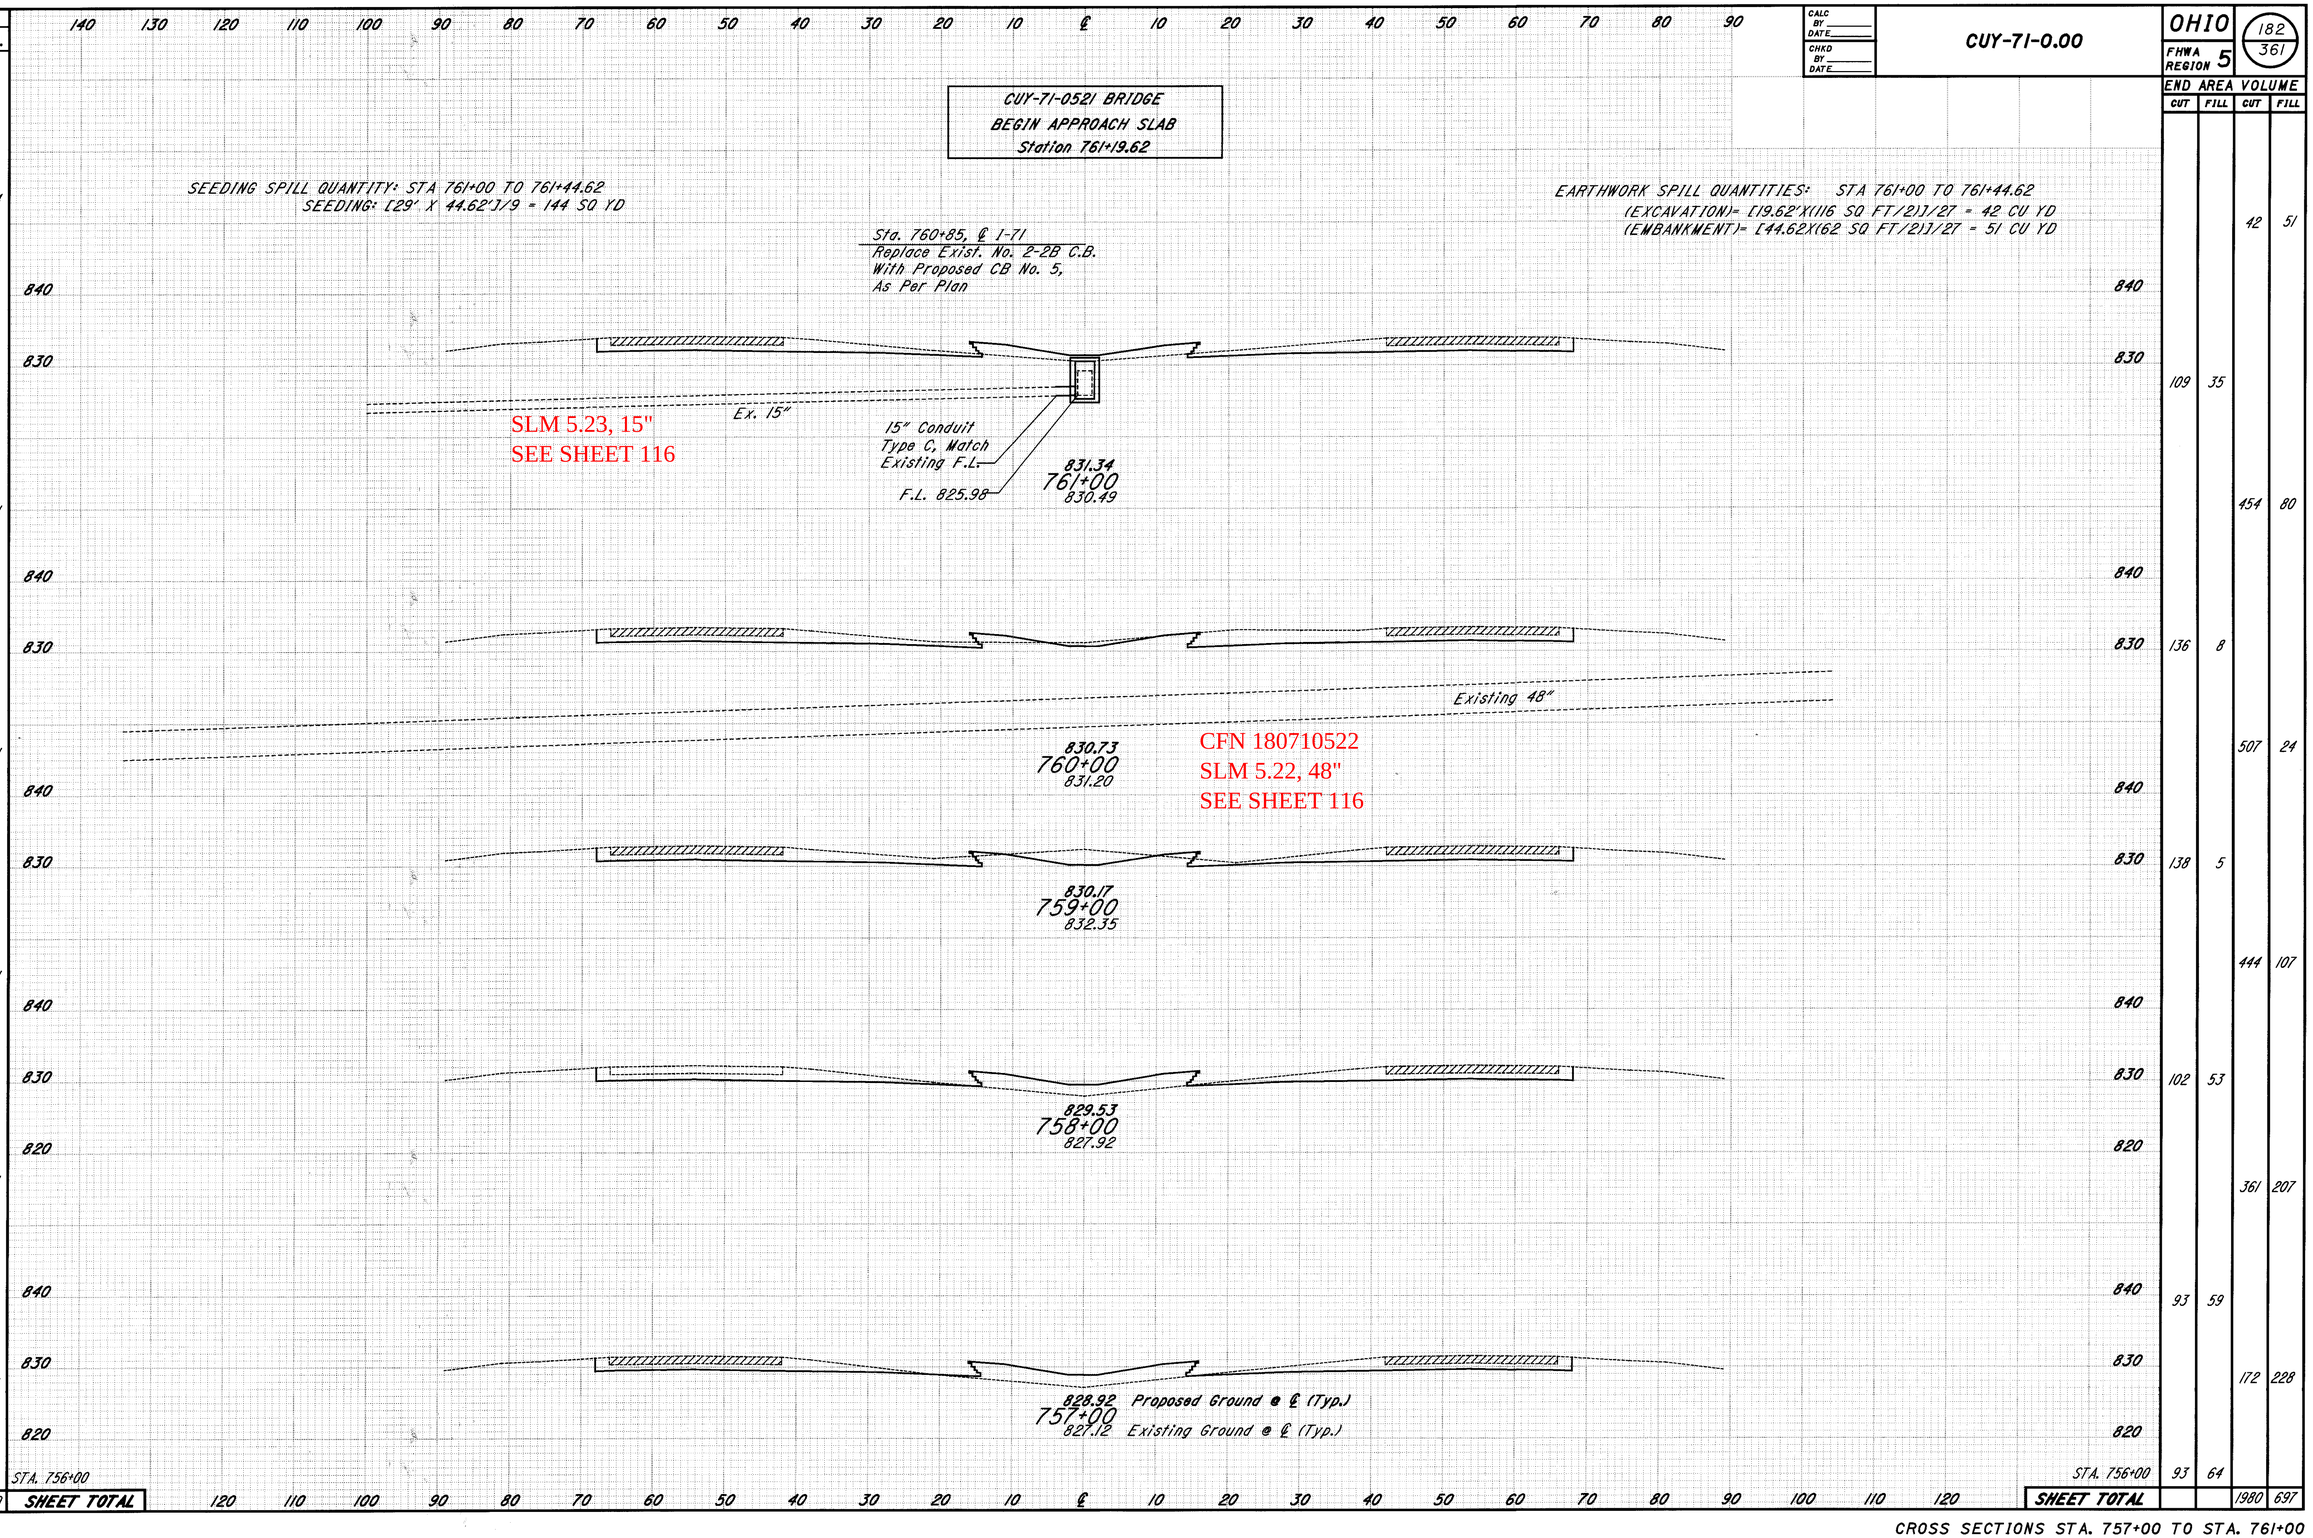

SEEDING END WIDTH	SEEDING SQ. YDS.	END AREA VOLUME CUT	END AREA VOLUME FILL	VOLUME CUT	VOLUME FILL
	144			42	51
28		109	35		
	311			454	80
28		136	8		
	311			507	24
28		138	5		
	311			444	107
28		102	53		
	311			361	207
28		93	59		
	311			172	228
28		93	64		
	1699 SHEET TOTAL			1980	697

CROSS SECTIONS STA. 757+00 TO STA. 761+00

PLOTTED FROM ~~Mrsbeforsber~~ Bpid08459Bdgn B307xs55.dgn PLOT SUBMITTED: 24-JUL-1998 15:11