


ESTIMATED QUANTITIES

I-1	48" Class A-1 Pipe Sec. M.G.4(d)	238	L.F.
I-2	Masonry	17	C.Y.
I-10	Dumped Rock Channel Protection	19	C.Y.
L-10	Sodding	8	S.Y.
E-3	Channel Excavation	48	C.Y.

Drainage Area = 52 Ac.  
Q50 = 113 CFS

CFN 180710522  
SLM 5.22, 48"  
SEE SHEET 29

PIPE CULVERT @ STA. 759+84  
Scale: 1" = 20'

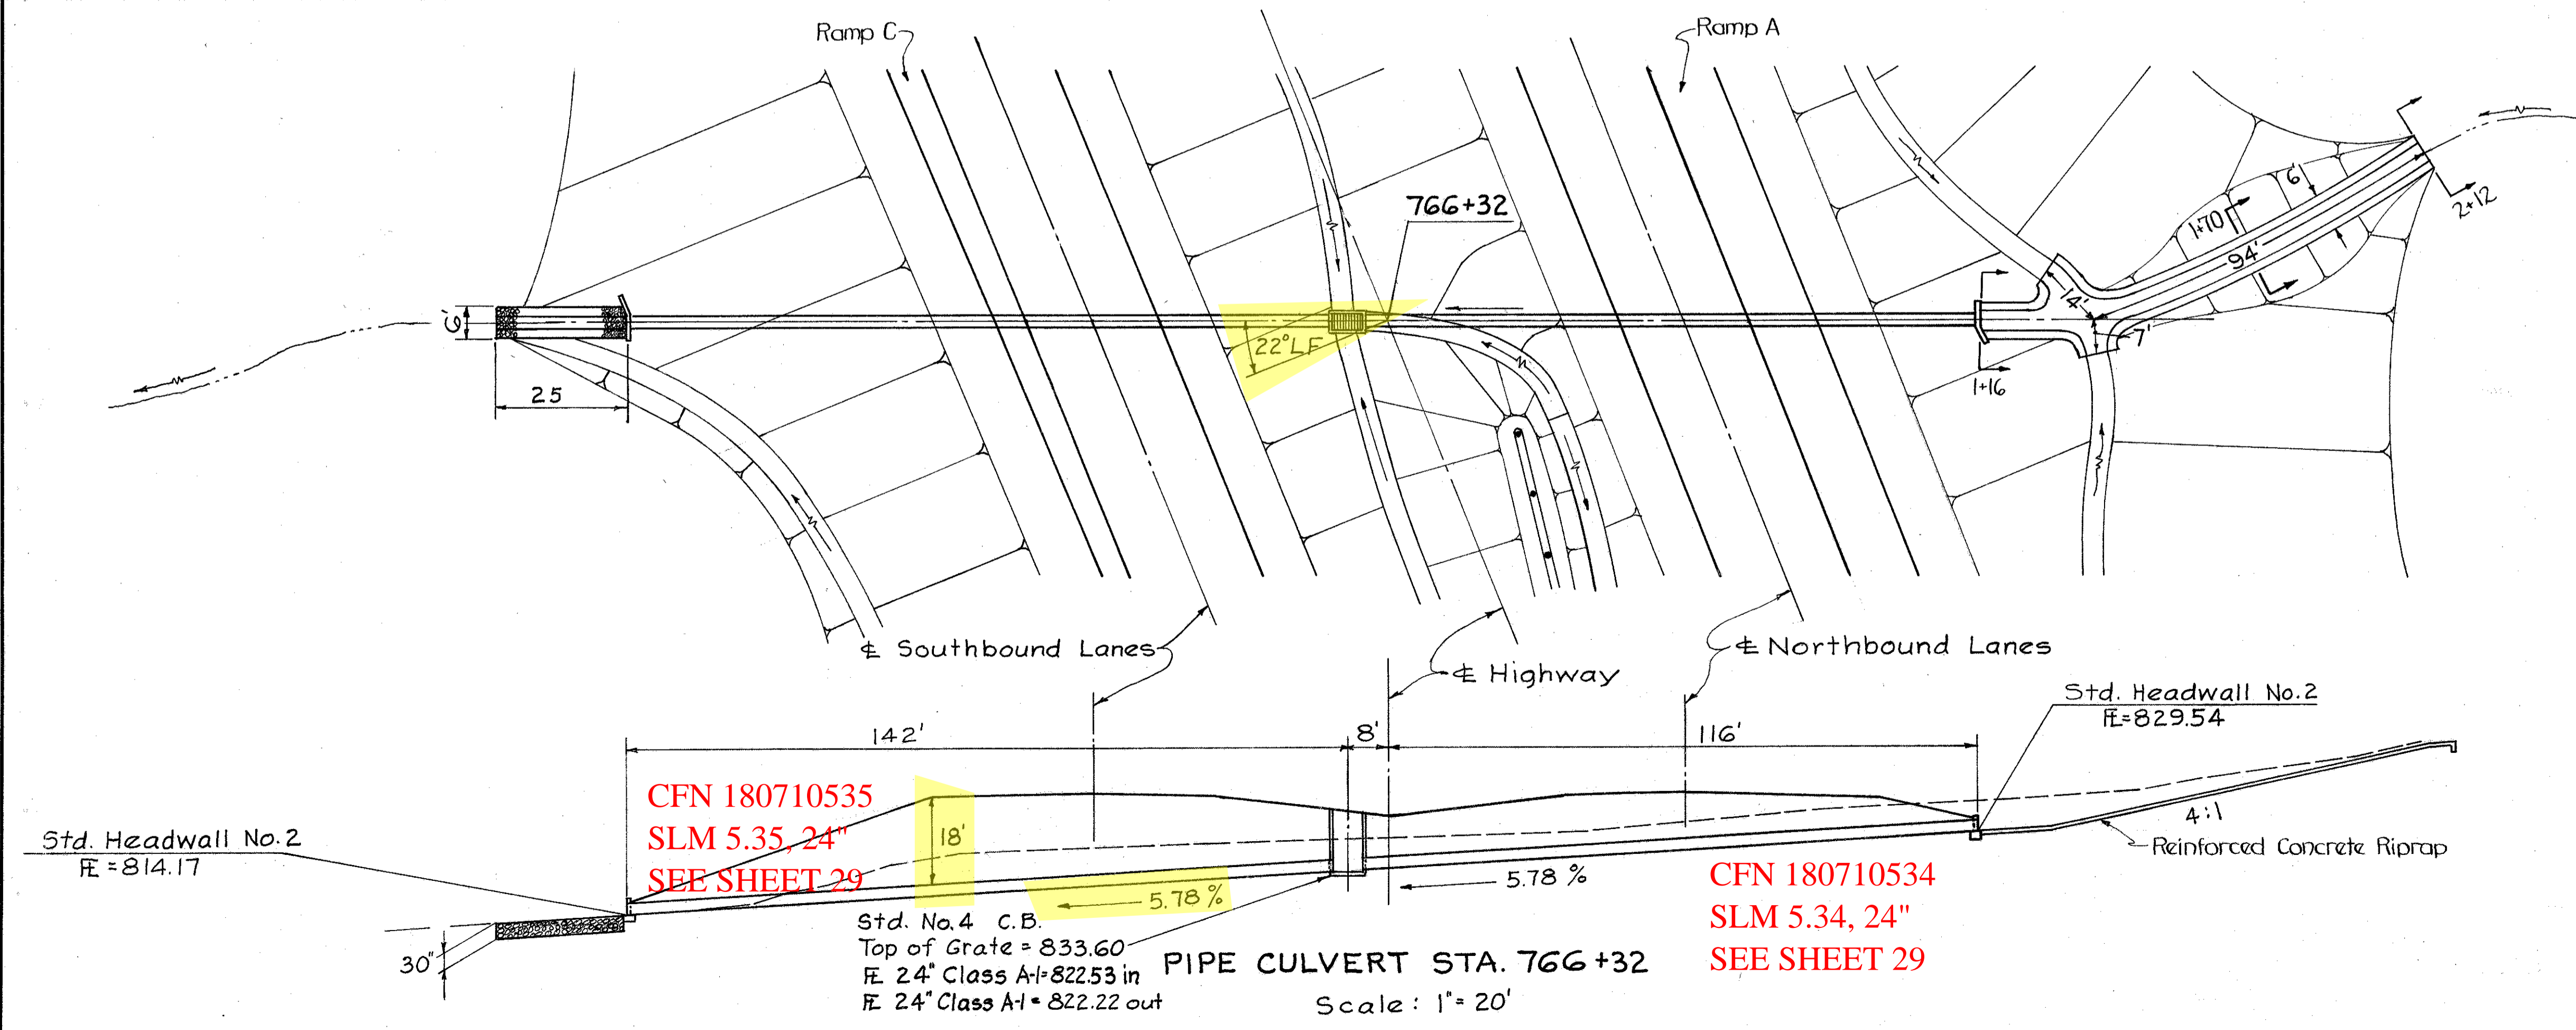

ESTIMATED QUANTITIES

I-1	24" Class A-1 Sec. M.G.6(c)	266	L.F.
I-2	Masonry	5.6	C.Y.
I-10	Dumped Rock Channel Protection	14	C.Y.
I-10	Reinforced Concrete Riprap	93	S.Y.
L-10	Sodding	6	S.Y.
E-3	Channel Excavation	27	C.Y.
I-8	Std. No. 4 C.B.	1	Ea.

Drainage Area = 5.2 Ac.  
Q50 = 24 CFS

CFN 180710535  
SLM 5.35, 24"  
SEE SHEET 29

CFN 180710534  
SLM 5.34, 24"  
SEE SHEET 29

Std. No. 4 C.B.  
Top of Grate = 833.60  
E 24" Class A-1 = 822.53 in  
E 24" Class A-1 = 822.22 out  
PIPE CULVERT STA. 766+32  
Scale: 1" = 20'

