


SEEDING  
END SQ.  
WIDTH YDS.

2 OHIO I-71-5(11)236

51  
263

CUYAHOGA COUNTY  
CUY-42-3.38

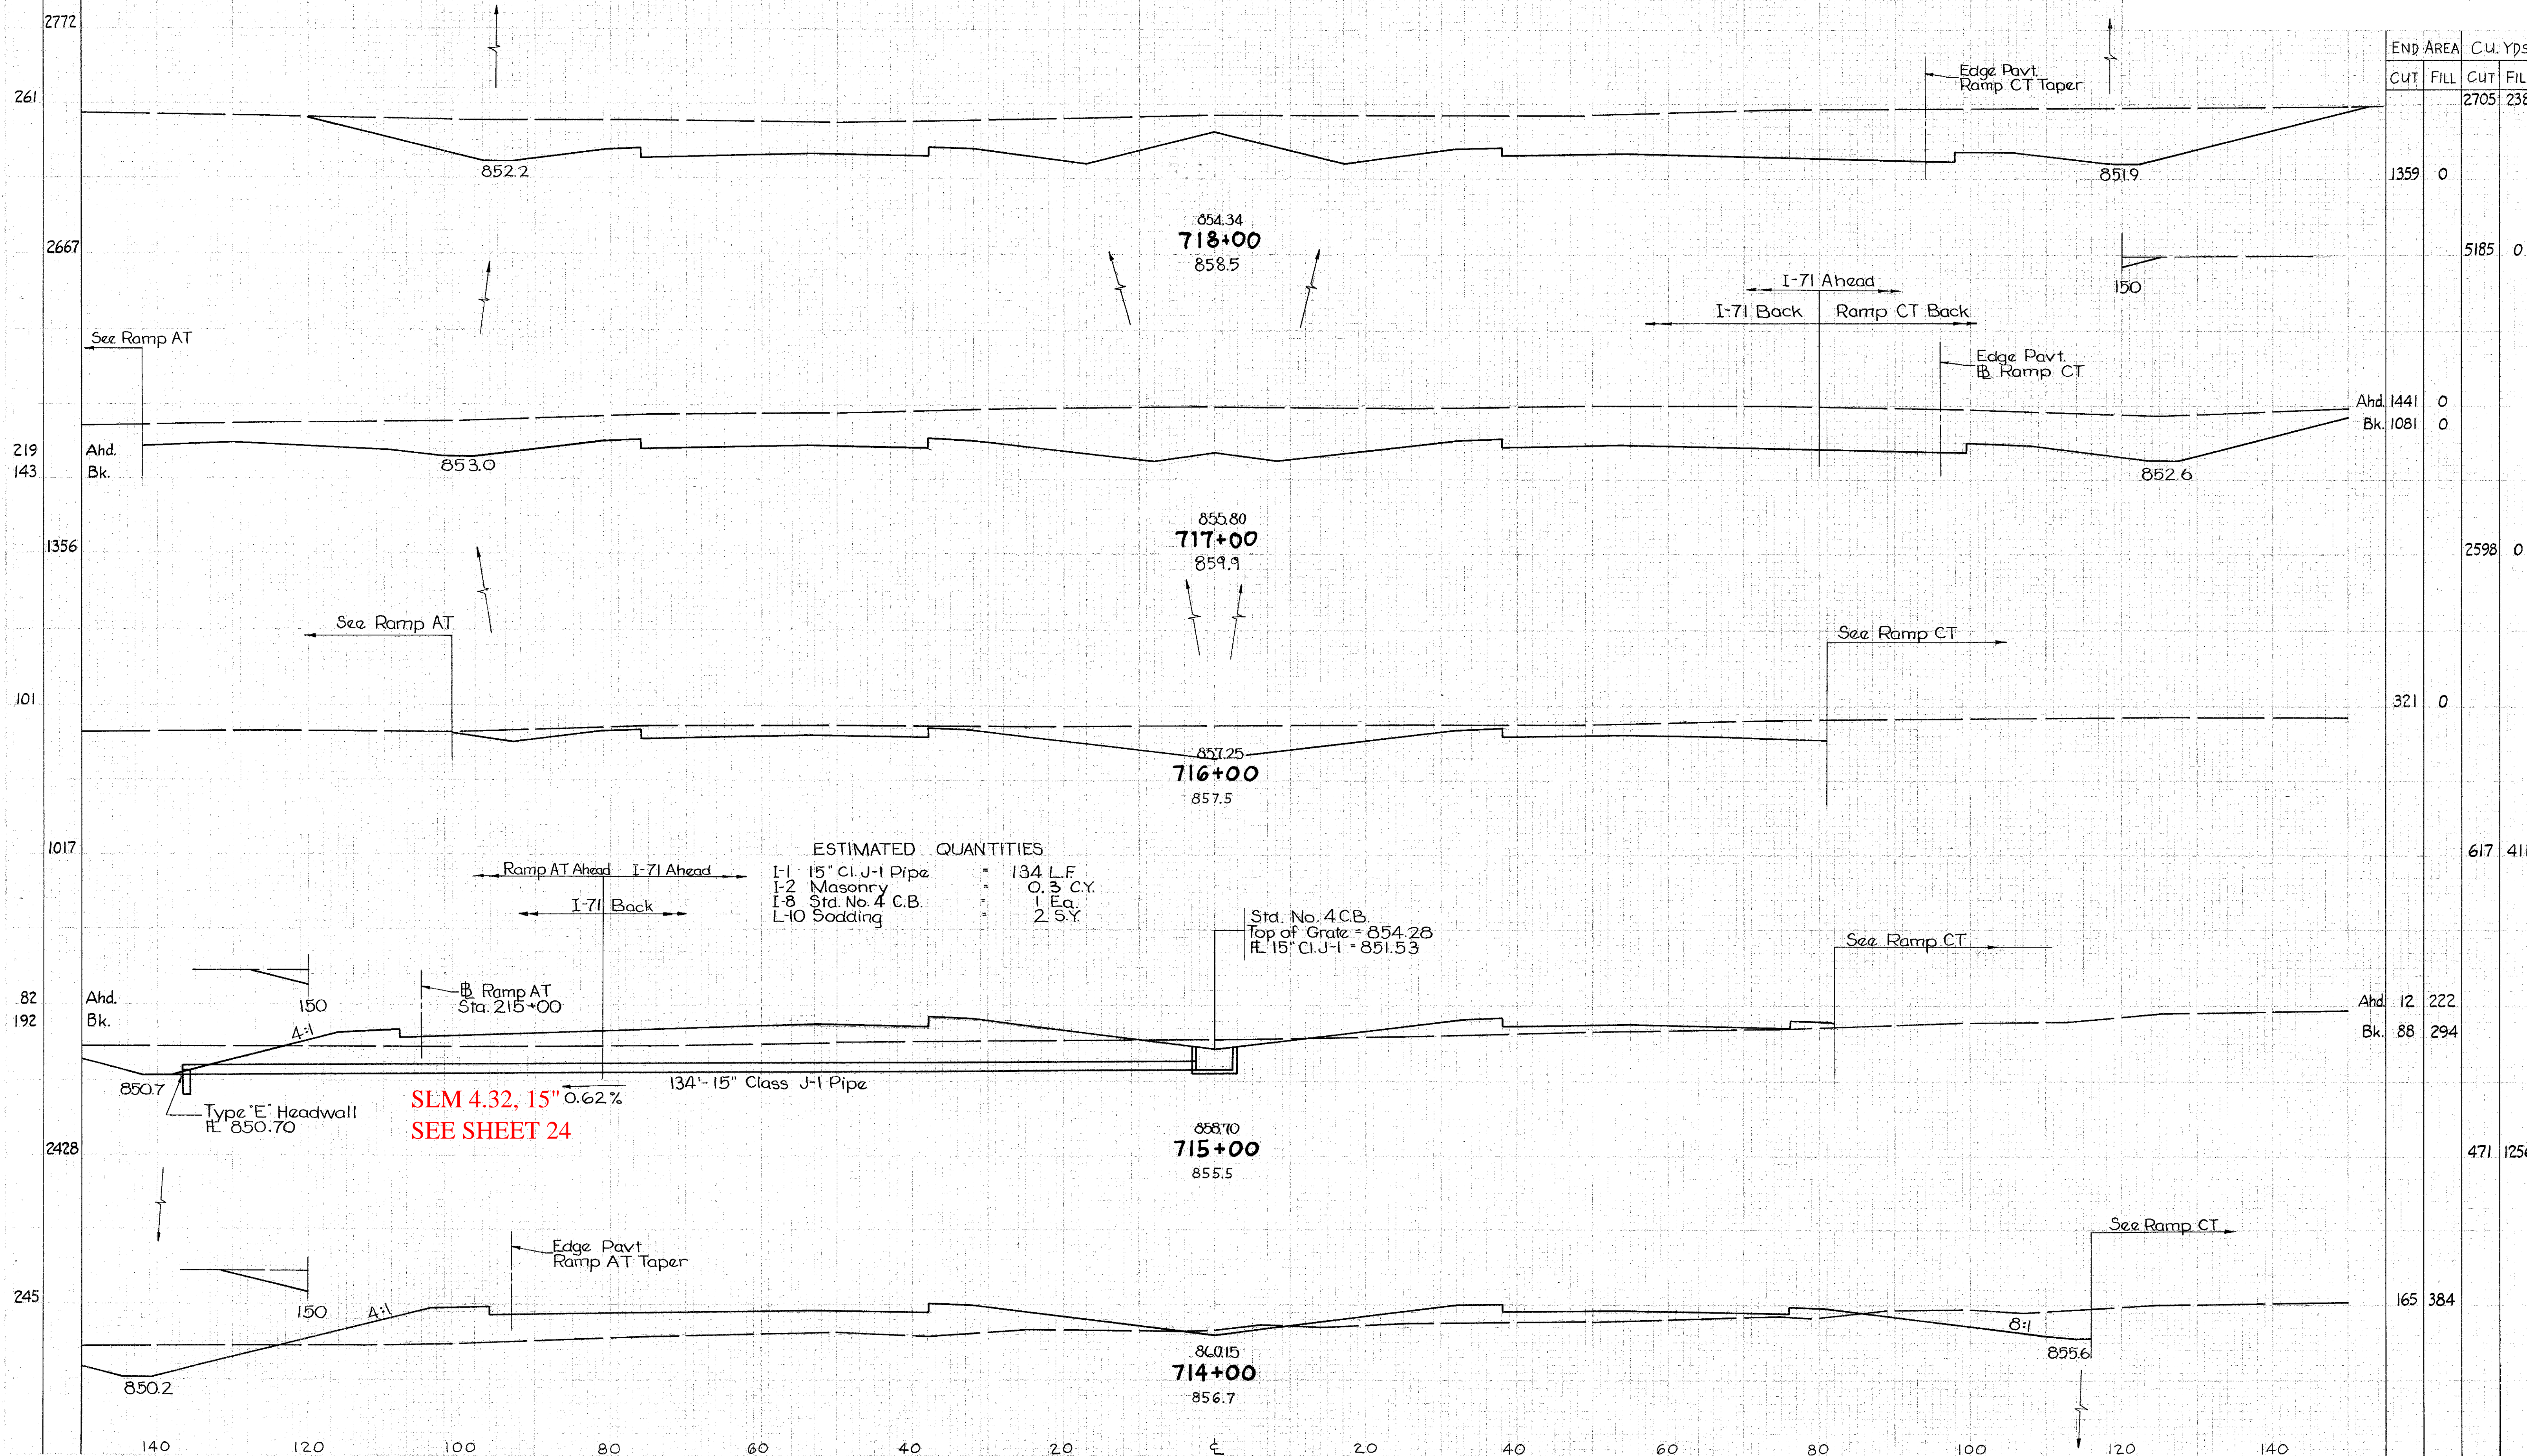

ESTIMATED QUANTITIES

I-1	15" C.I. J-1 Pipe	=	134 L.F.
I-2	Masonry	=	0.3 C.Y.
I-8	Std. No. 4 C.B.	=	1 Ea.
L-10	Soading	=	2 S.Y.

**SLM 4.32, 15"**  
**SEE SHEET 24**

Sta. 714+00 to 718+00