


SEEDING  
END Sta.  
WIDTH Yds.

ESTIMATED QUANTITIES

- I-1 18" Cl. J-1 Pipe = 92 L.F.
- I-1 24" Cl. J-1 Pipe = 92 L.F.
- I-1 24" Cl. F-4 Pipe = 64 L.F.
- I-8 Std. No. 4 C.B. = 1 Ea.
- I-8 Std. No. 5 C.B. = 3 Ea.
- I-10 Dumped Rock Channel Protection = 2 CY.

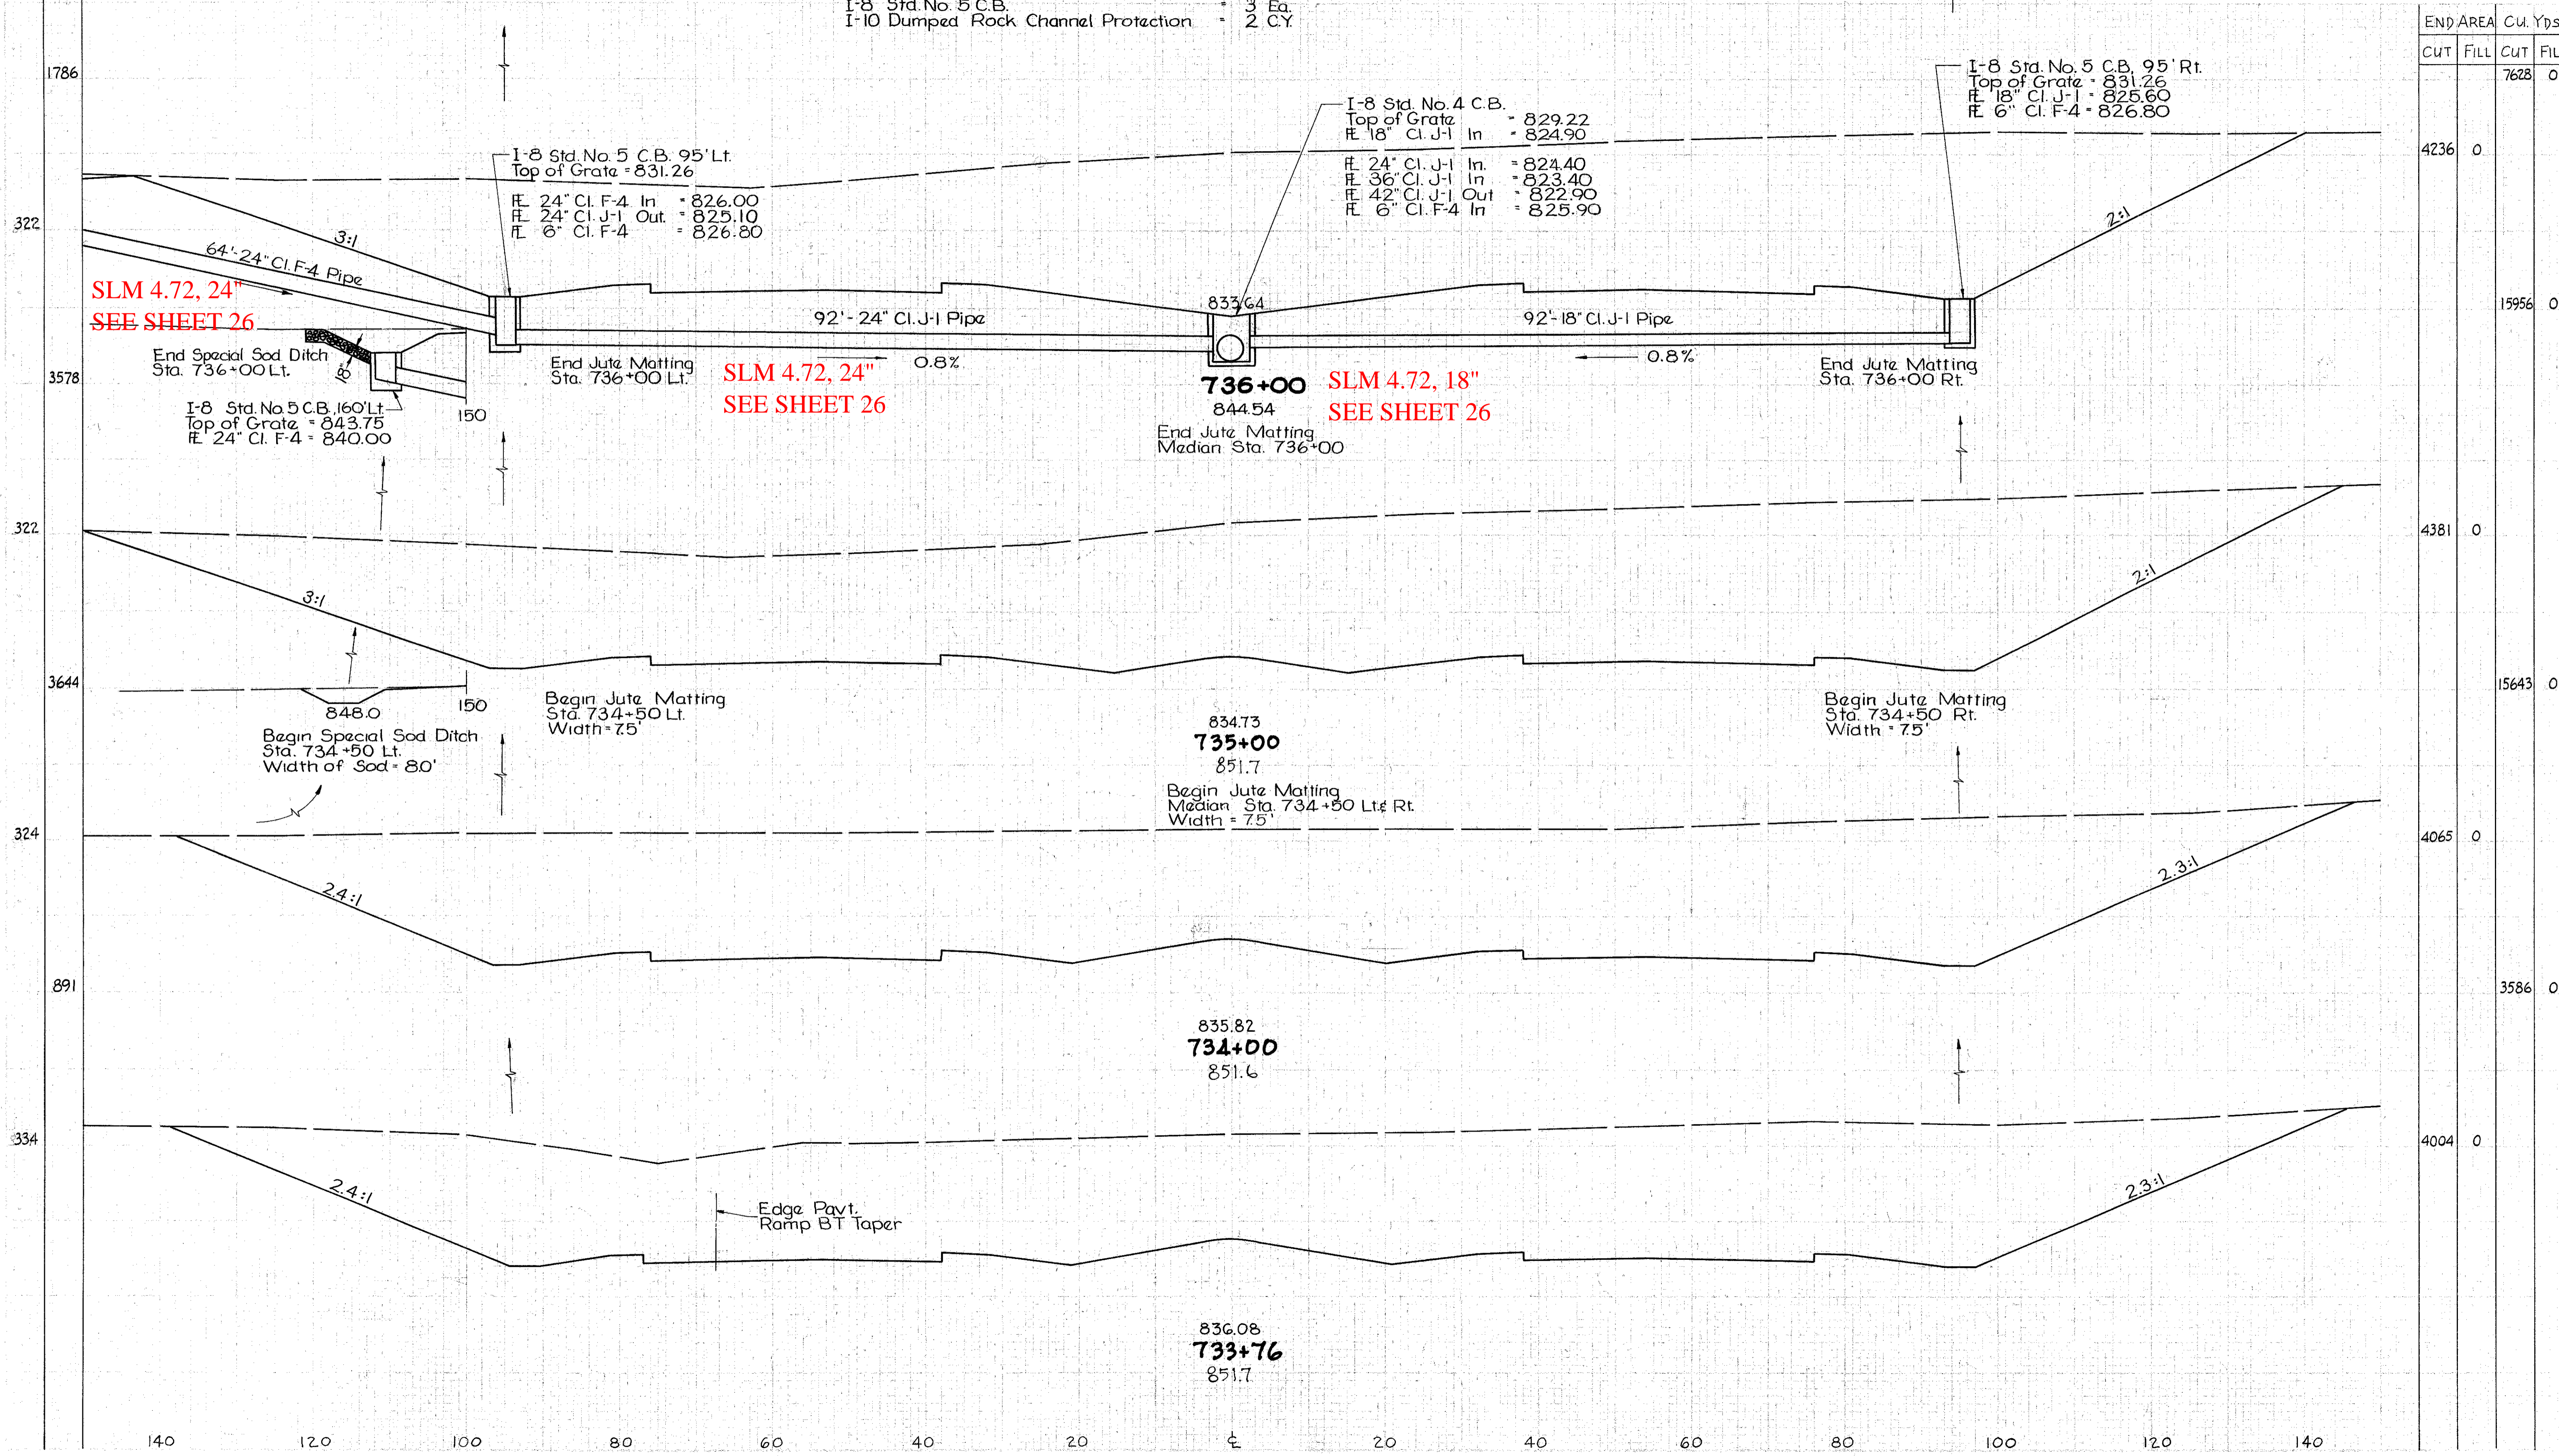

END AREA		Cu. Yds.	
CUT	FILL	CUT	FILL
		7628	0
4236	0		
		15956	0
4381	0		
		15643	0
4065	0		
		3586	0
4004	0		