


SEEDING  
END Sq.  
WIDTH Yds.

CUYAHOGA COUNTY  
CUY-42-3.38

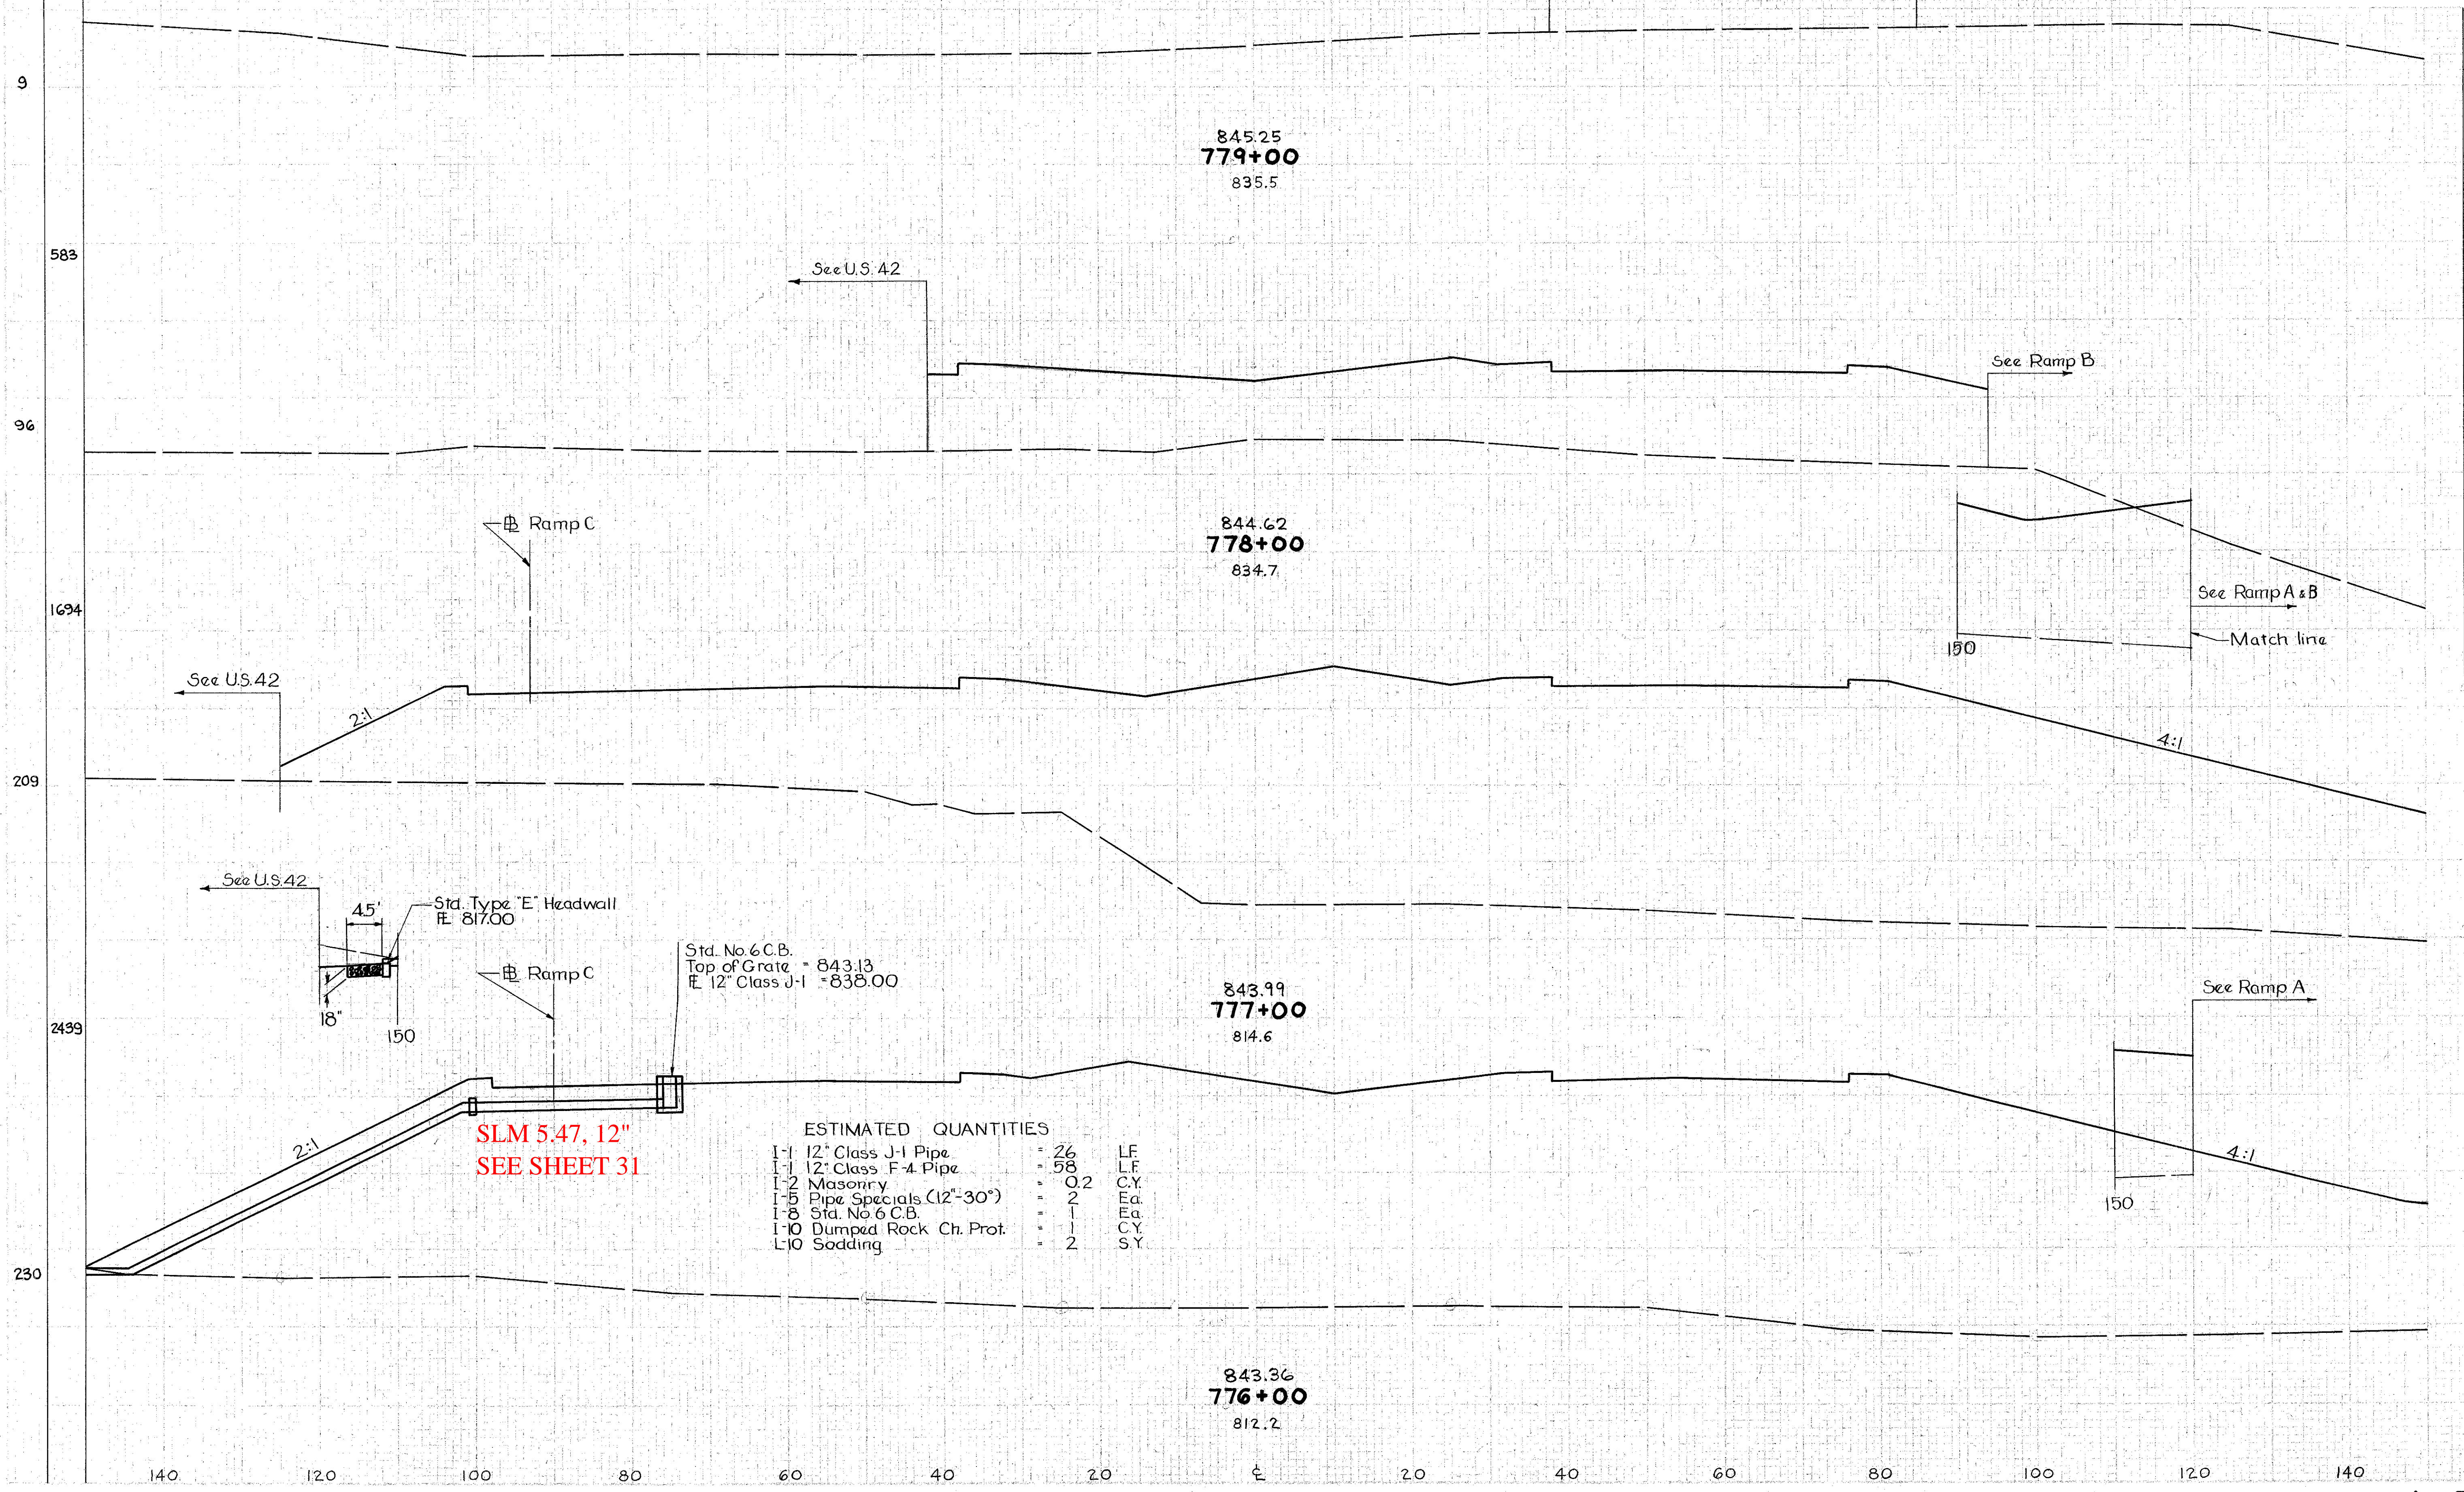

END AREA		CU. YDS.	
CUT	FILL	CUT	FILL
		0	304
0	309		
		0	3095
0	1362		
		0	1414
0	6260		
		22	26236
12	7907		

See US 42

2:1

Ramp C

See U.S. 42

See US 42

See Ramp B

See Ramp B

See Ramp A & B

Match line

See US 42

45°

Std. Type "E" Headwall  
E. 817.00

Ramp C

Std. No 6 C.B.  
Top of Grate = 843.13  
E. 12" Class J-1 = 838.00

843.99  
777+00  
814.6

See Ramp A

2:1

SLM 5.47, 12"  
SEE SHEET 31

ESTIMATED QUANTITIES

1-1 12" Class J-1 Pipe	= 26	LF
1-1 12" Class F-4 Pipe	= 58	LF
1-2 Masonry	= 02	C.Y.
1-5 Pipe Specials (12"-30°)	= 2	Ea.
1-8 Std. No 6 C.B.	= 1	Ea.
1-10 Dumped Rock Ch. Prot.	= 1	C.Y.
1-10 Sodding	= 2	S.Y.

843.36  
776+00  
812.2

150

4:1

140

120

100

80

60

40

20

±

20

40

60

80

100

120

140