


FED. RD. DIVISION	STATE	PROJECT
2	OHIO	

286  
646  
35  
54

CUYAHOGA COUNTY  
CUY-71-17.83  
CUY-176-12.76  
G

R.D.L. 9-23-64  
 L.M.A. 10-12-68

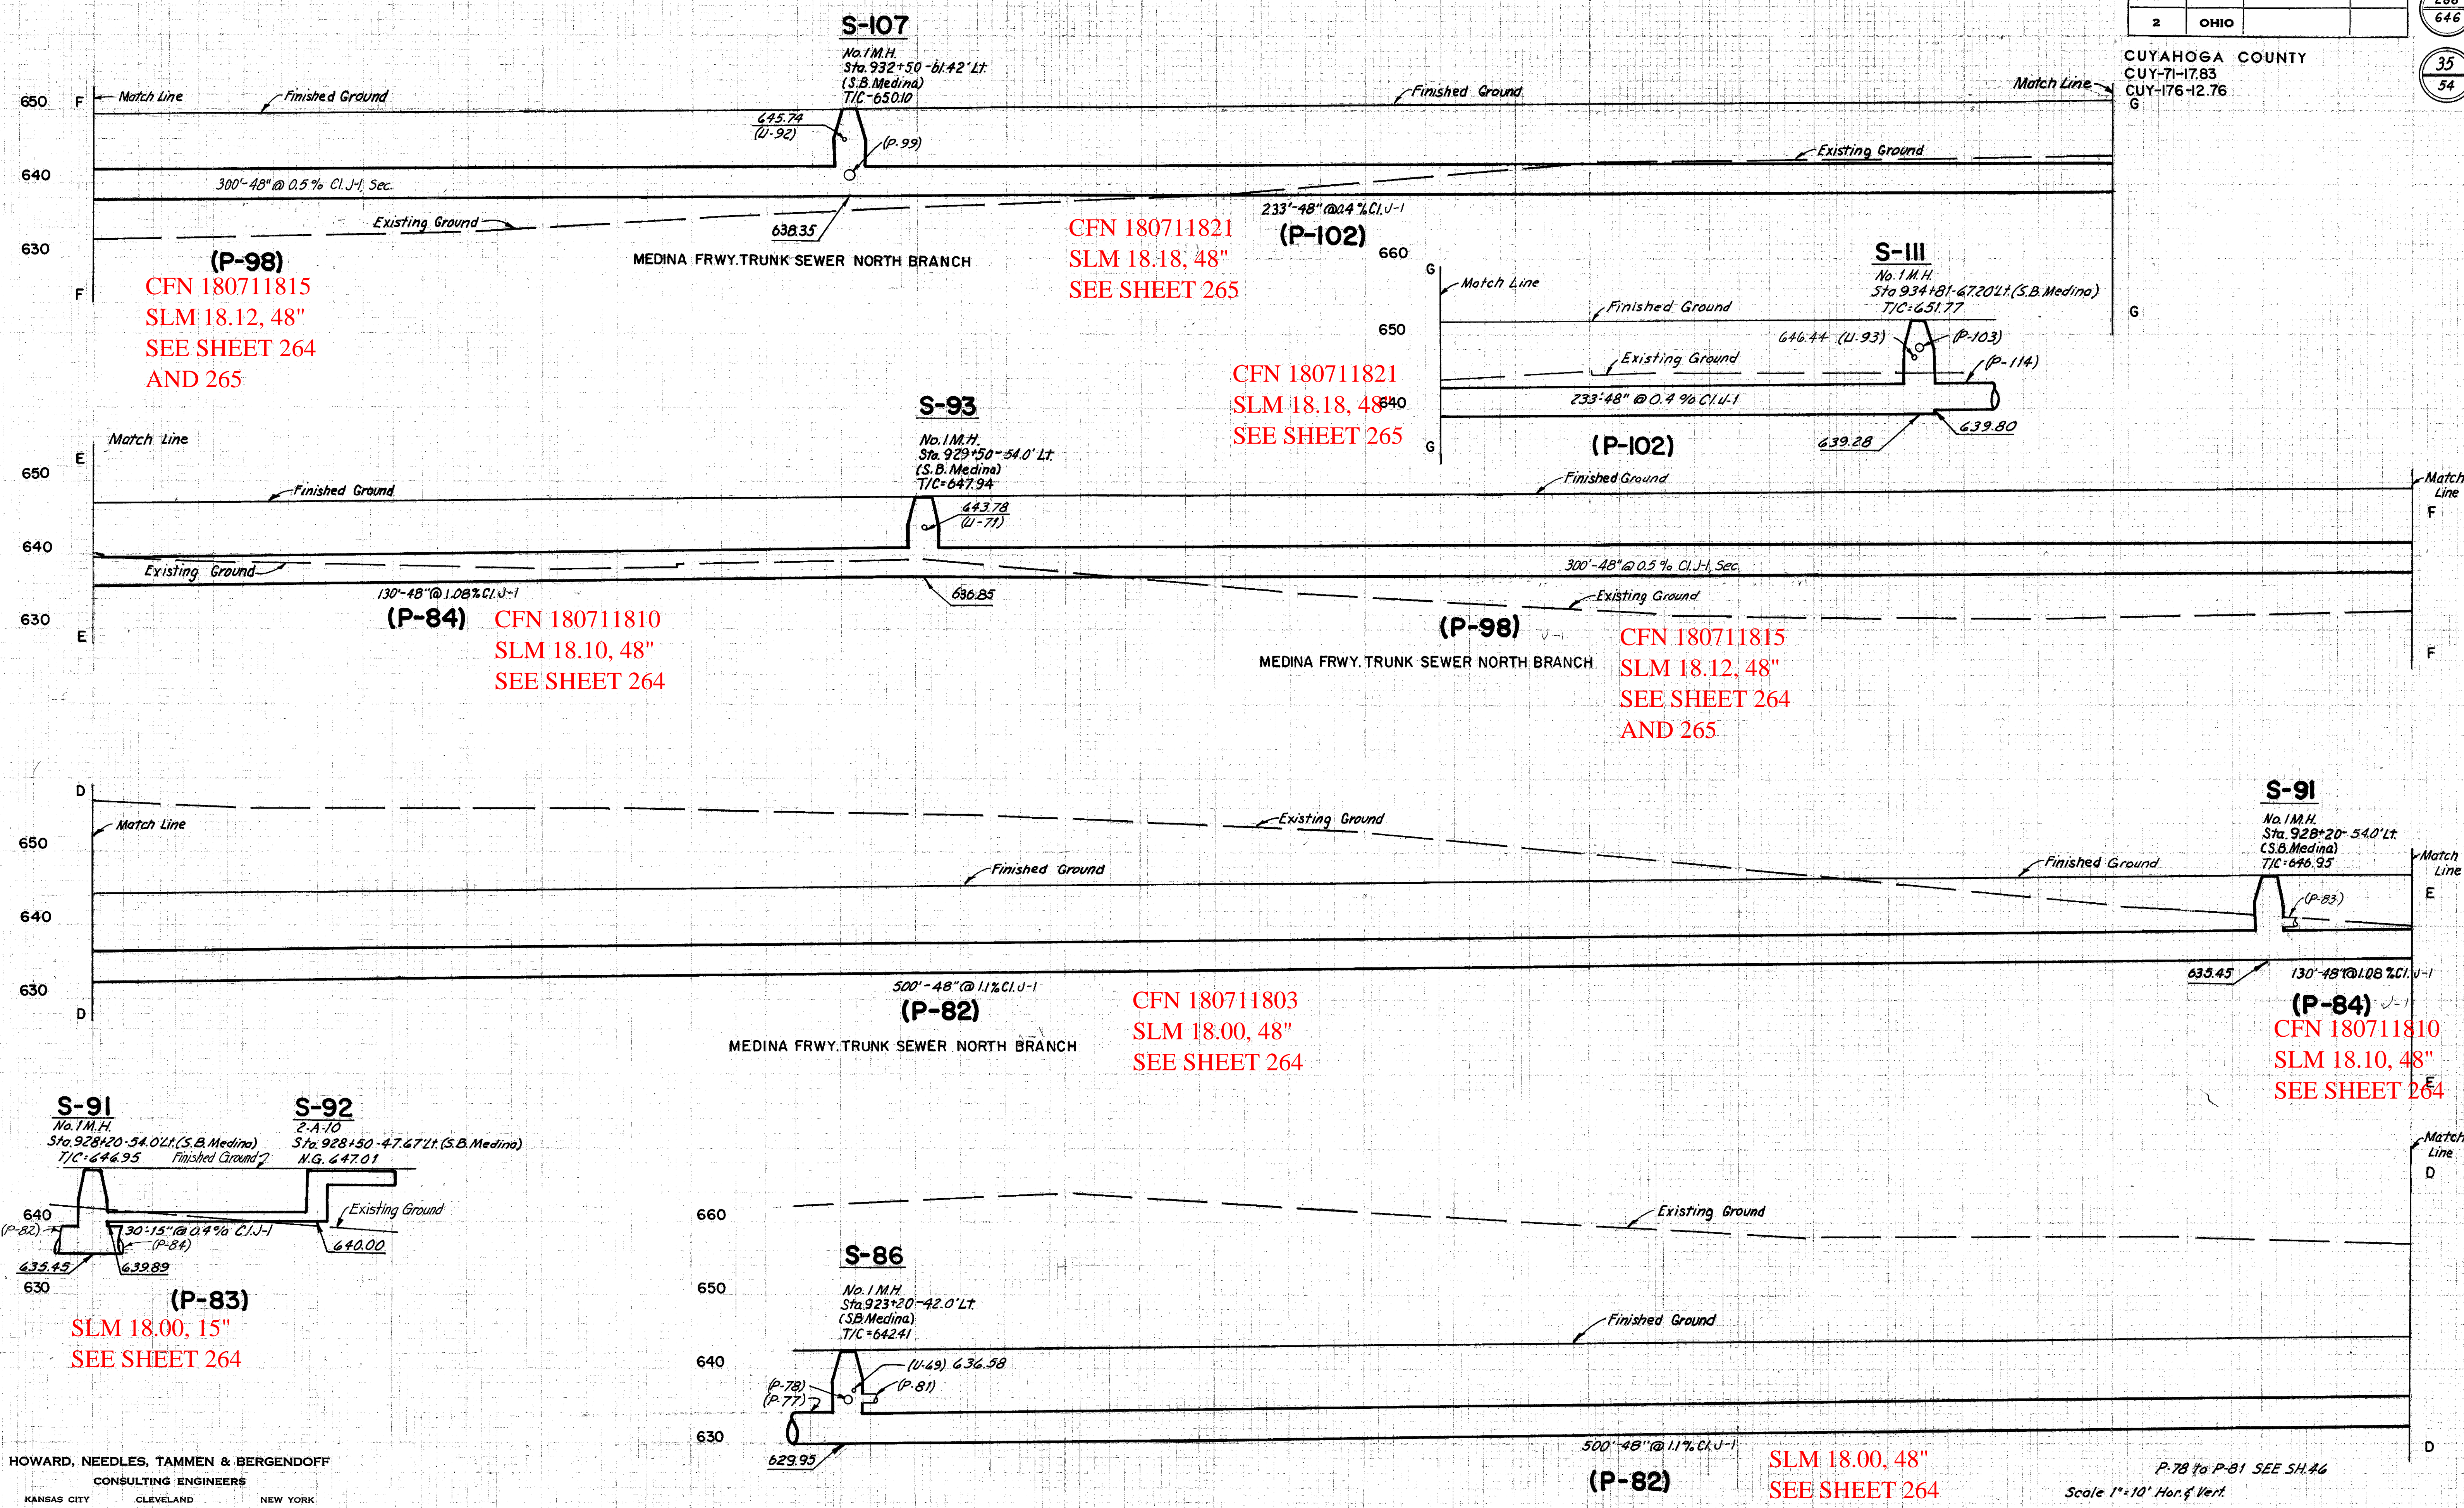

HOWARD, NEEDLES, TAMMEN & BERGENDOFF  
CONSULTING ENGINEERS  
KANSAS CITY CLEVELAND NEW YORK

P. 78 to P. 81 SEE SH. 46  
Scale 1" = 10' Hor. & Vert.