

SEEDING  
END STA.  
WIDTH YDS.

CALC BY ALM  
DATE 10/92  
CHKD BY JJB  
DATE 10/92

CUY-271-6.41

OHIO  
FHWA REGION 5  
65  
145

END AREA  
CUT FILL  
VOLUME  
CUT FILL

51

284

51

142

51 AH BK +25

63

126

63

MATCH LINE 80' LT.  
SEE SHEET 82

MATCH LINE 80' LT.  
SEE SHEET 82

MATCH LINE 80' LT.  
SEE SHEET 82

MATCH LINE 80' LT.  
SEE SHEET 82

MATCH LINE 110' RT.  
SEE SHEET 80

MATCH LINE 80' RT.  
SEE SHEET 79

MATCH LINE 80' RT.  
SEE SHEET 79

REMOVE 117'~18" S

REMOVE CB  
STA. 399+81, 69.6' LT.  
GRATE EL. 1183.46  
15" INV 1178.31  
18" INV N 1178.16  
18" INV W 1178.11  
8" INV 1180.4

PLUG 6" TEMPORARY ABUTMENT  
DRAIN OUTLET PER NOTE ON  
SHT. 39B - TYPICAL


EXIST. APPROX.  
SHEETING LINE  
BY OTHERS

APPROX. BENCH LEVEL  
(AHEAD OF ABUTMENT)  
ELEV 1177.0± BY  
OTHERS

EXIST.  
APPROX. SHEETING  
LINE BY OTHERS

REMOVE  
6" TYPE F  
SEWER

REMOVE CB  
STA. 400+02, 72.3' RT.  
GRATE EL. 1184.37  
15" INV 1180.22  
8" INV 1180.7

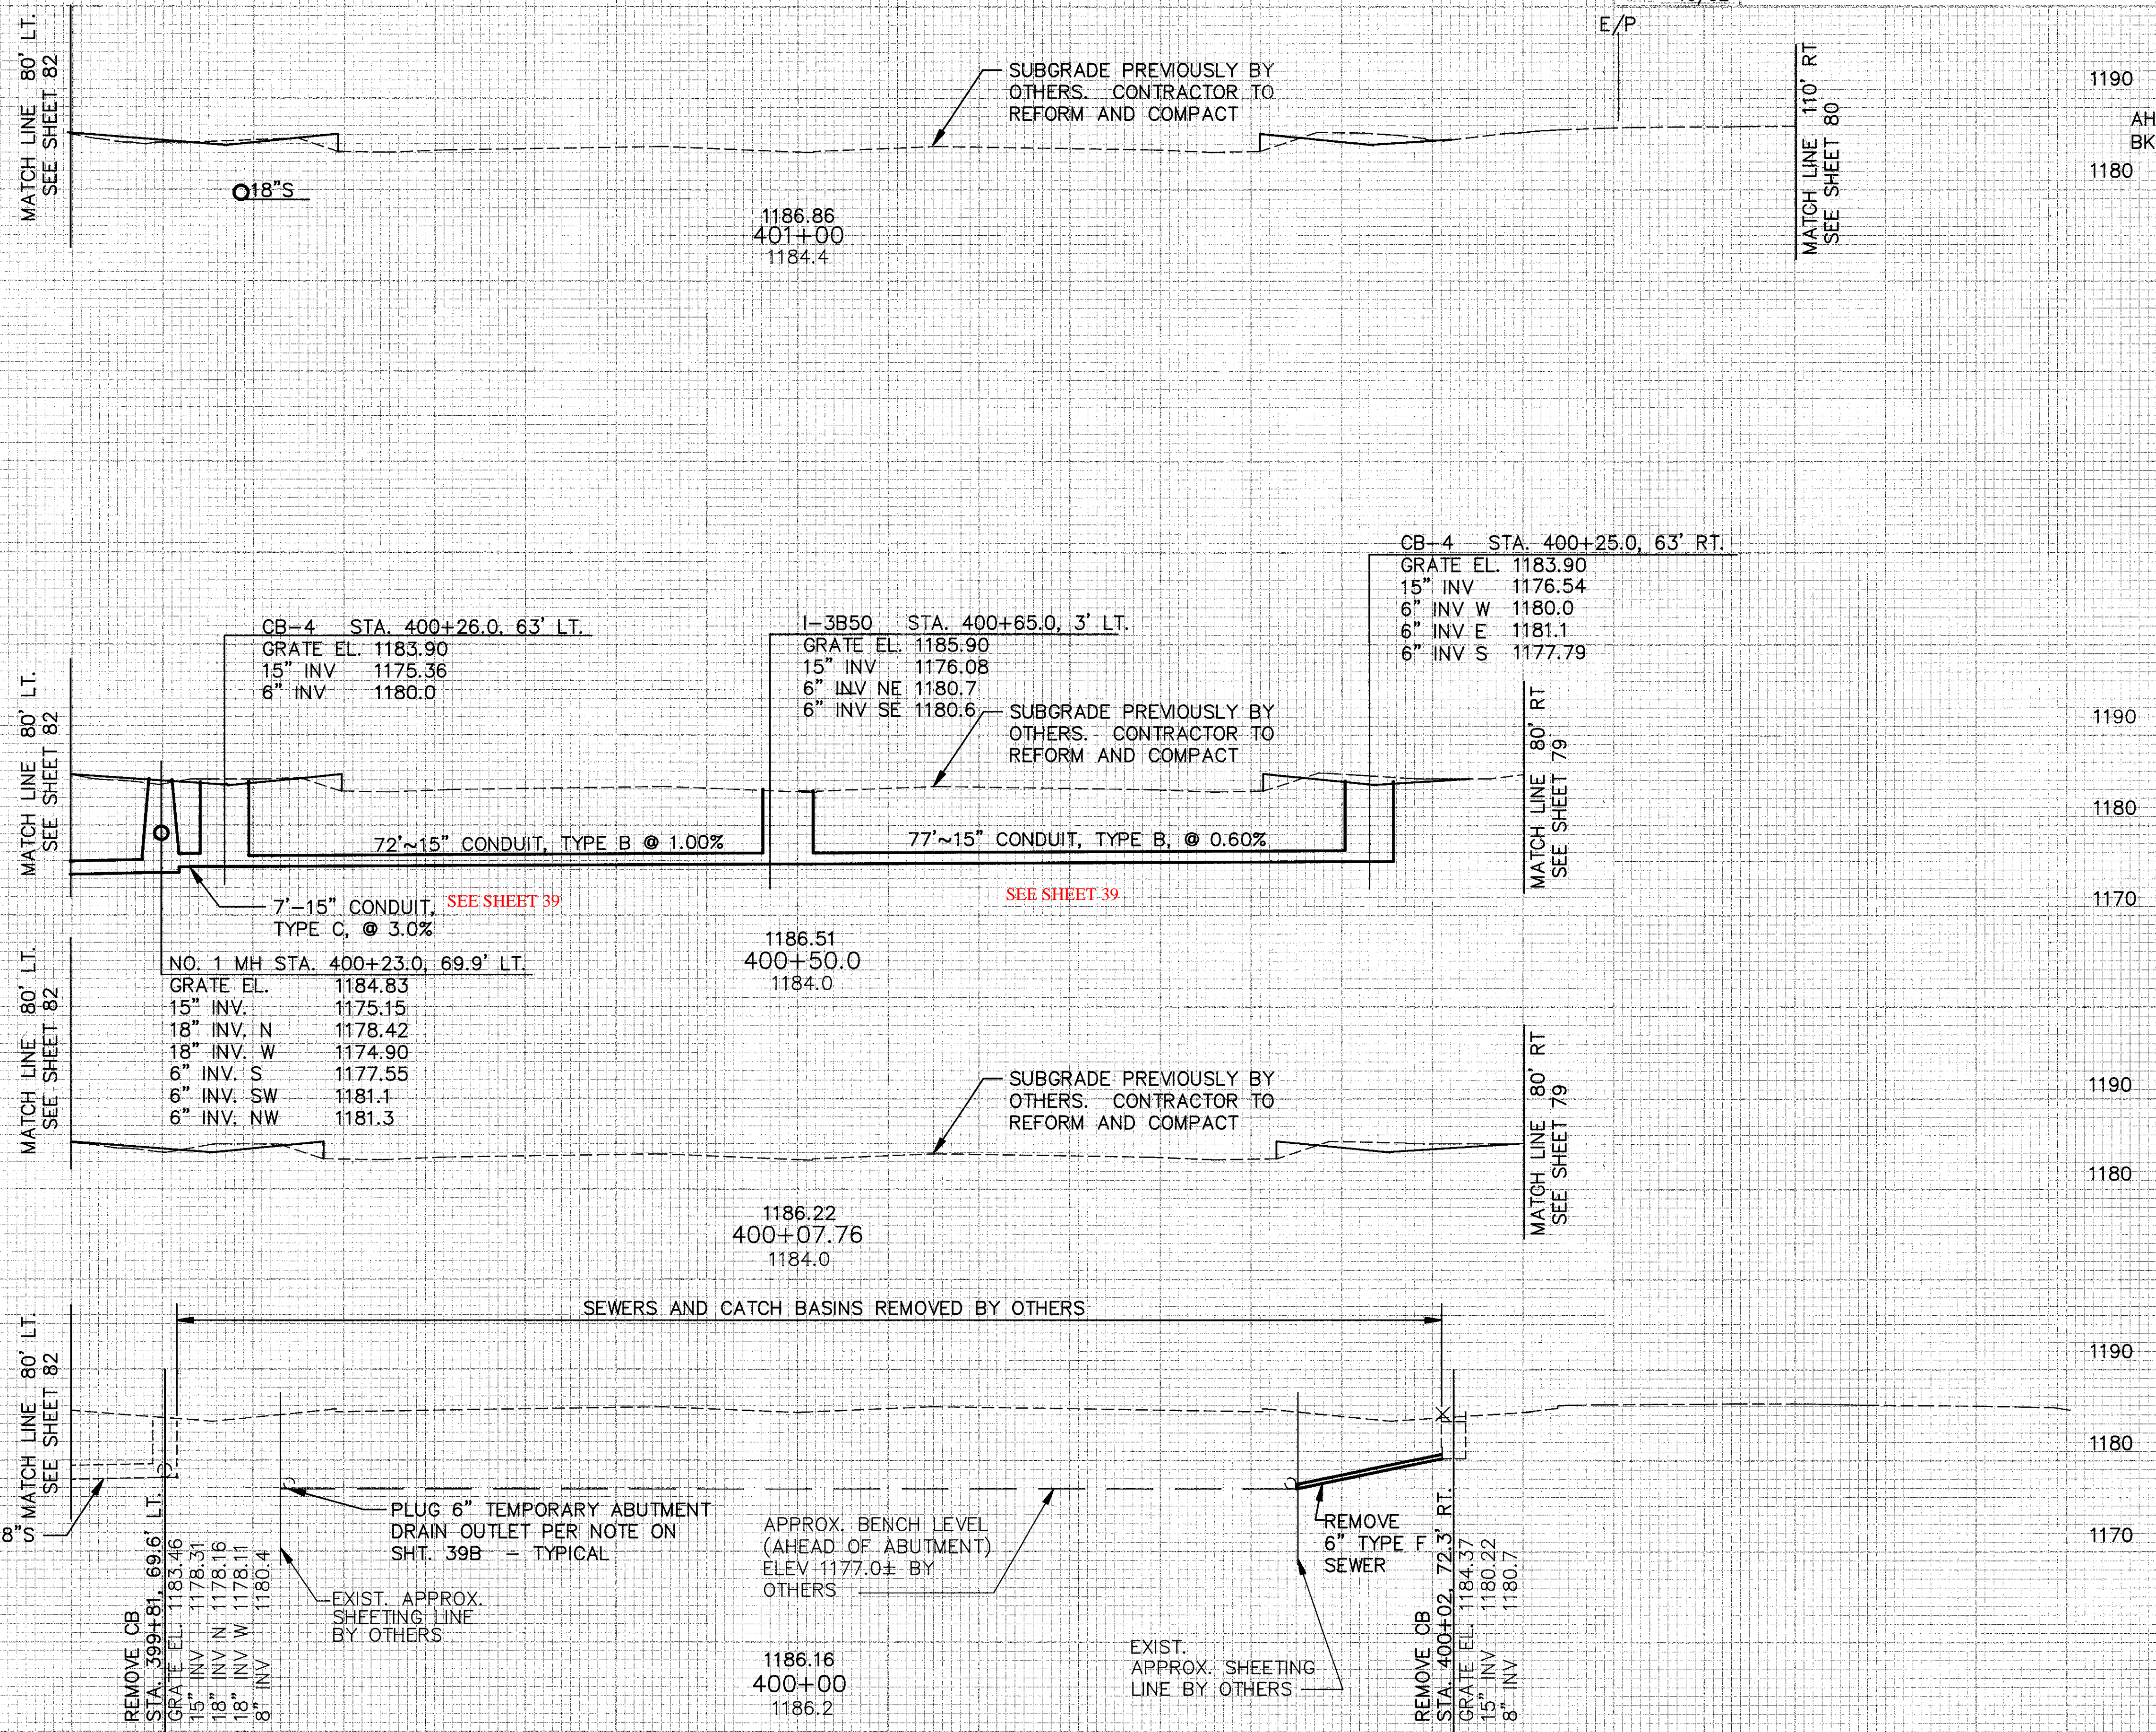

1190  
1180

1190  
1180

1170  
1184.0

1190  
1180

1190  
1180

1170

AH 136.4  
BK 15.13

29 20

16 12

27 18

19 11

55 38