


FED. RD. DIVISION	STATE	PROJECT	
2	OHIO		

82
410

CUYAHOGA COUNTY
CUY-77-8.69
CUY-80-17.37

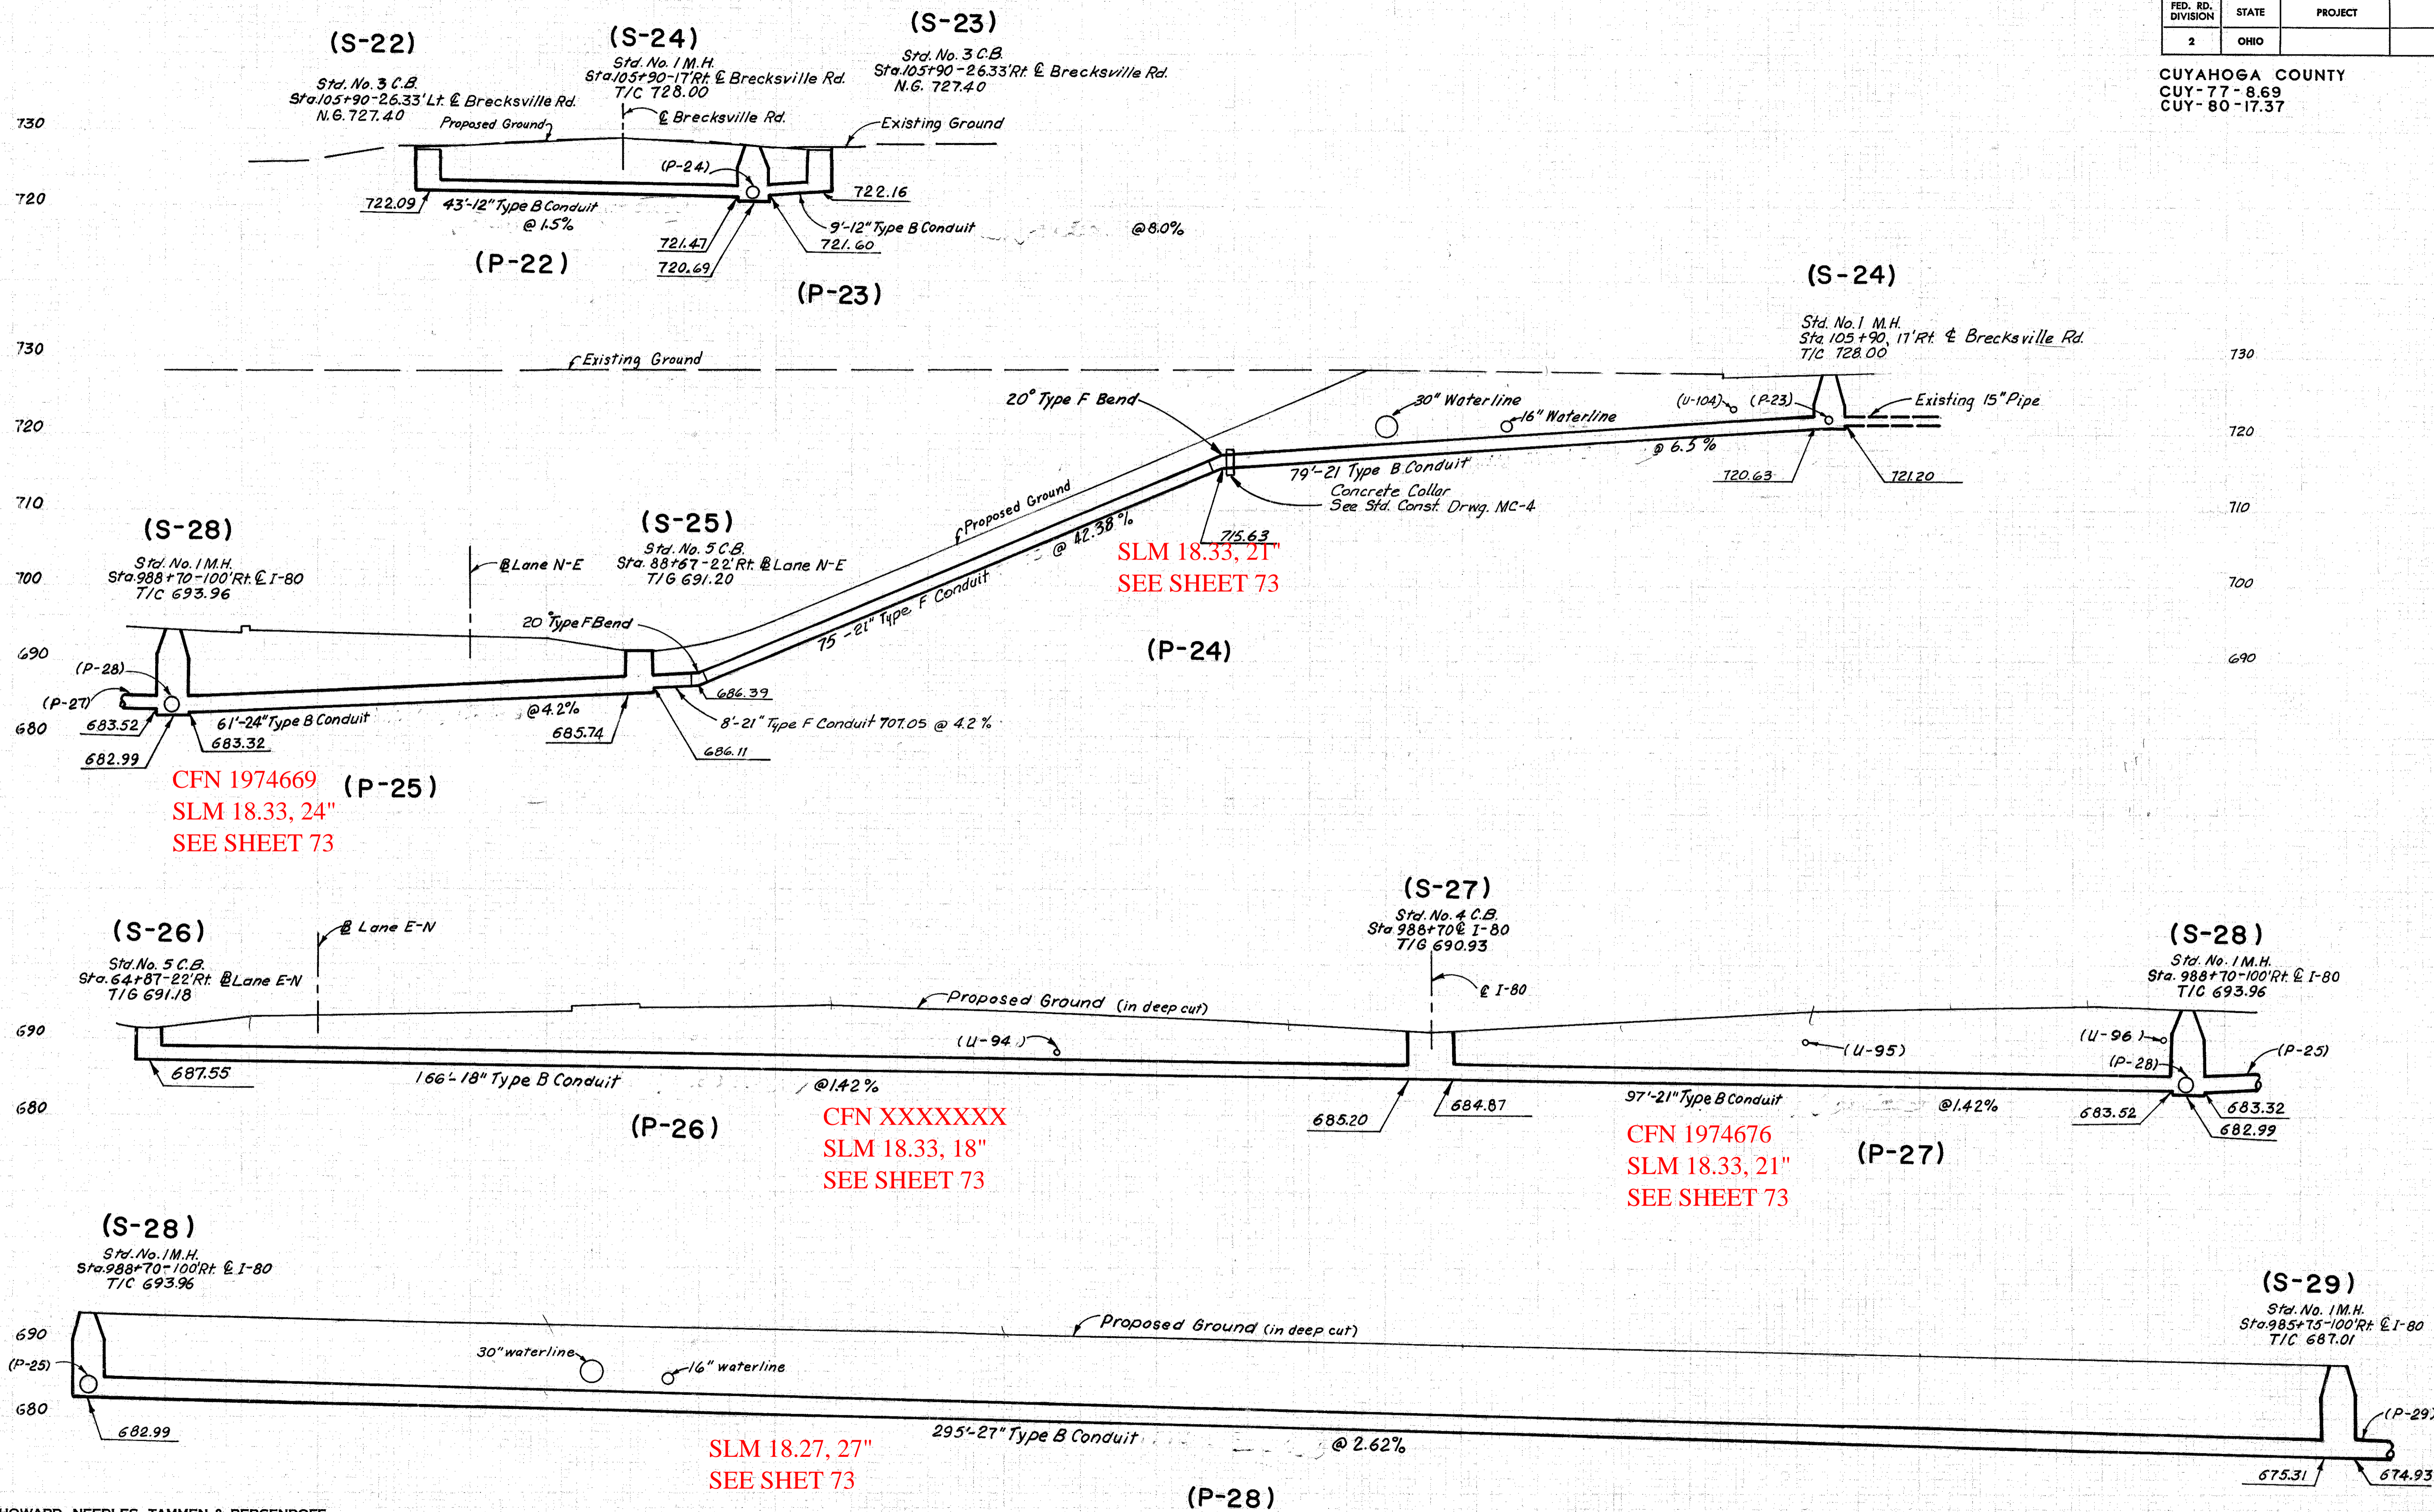

HOWARD, NEEDLES, TAMMEN & BERGENDOFF
CONSULTING ENGINEERS
KANSAS CITY CLEVELAND NEW YORK